

Addendum

Distribution	<input type="checkbox"/> Owner	<input type="checkbox"/> Consultant(s)	<input checked="" type="checkbox"/> Bidders	<input type="checkbox"/> Other ..
From	Wendy Heger, AIA Page Southerland Page, Inc. 1100 Louisiana Street Suite One Houston, TX 77002	Owner	Galveston County 722 Moody Avenue 6 th Floor Galveston, TX 77550	
Project	Galveston County Road & Bridge Department Facilities 5115 TX-3 Dickinson, TX 77573	Architect's Project No.	418198	
Date of Issue	7-October-2020	Addendum No.	003	
Contract For	General Construction	For Bids Due	22-October-2020	

Seals



Description	<p>This Addendum includes the following changes to the Work:</p> <ol style="list-style-type: none"> 1. Civil drawings have been revised to show the three phases of the project. 2. G-100 – Revised drawing index. 3. G-110 – Revised exterior finish schedule 4. C4.0-PH1 – Revised expansion joint layout. 5. C5.0-PH1 – Revised junction box locations. 6. C5.0-PH1 – Revised storm drain inlet location. 7. C6.0-PH1 – Revised junction box elevation. 8. C7.0-PH1 – Revised junction box and storm drain inlets. 9. C7.1-PH1 – Revised sanitary sewer manholes. 10. C10.0-PH1 – Added “ParkUSA Type-A Grate Inlet” detail No. CB4880-1 11. C13.0-PH1 – Revised inlet protection barrier. 12. C13.0-PH1 – Added inlet protection barrier callout. 13. C5.0-PH2 – Revised phase of junction boxes and inlets. 14. C7.1-PH2 – Revised phase of sanitary sewer manholes. 15. A-201O – Revised brick masonry finish tags; Added Masonry Legend. 16. A-110M – Revised dimensions at Restroom M5. 17. A-111M – Revised dimensions at Restroom M5 interior elevation.
--------------------	---

Revised Documents This Addendum includes specification sections or drawing sheets that have been added or revised as of the date noted above. Please replace any documents from the original issue set with those below marked “R” and ADD sheets marked “A” to your bidding documents.

Drawings

Sheet No.	Revision Date	Status	Sheet Title
G-100	10/07/2020	R	GENERAL - PROJECT DATA
G-110	10/07/2020	R	GENERAL – SCHEDULES
C1.0-PH1	10/07/2020	A	COVER SHEET

C2.0-PH1	10/07/2020	A	TOPOGRAPHIC SURVEY
C3.0-PH1	10/07/2020	A	DEMOLITION PLAN
C4.0-PH1	10/07/2020	A	PAVING PLAN
C5.0-PH1	10/07/2020	A	LAYOUT PLAN
C6.0-PH1	10/07/2020	A	GRADING PLAN
C7.0-PH1	10/07/2020	A	UTILITY PLAN
C7.1-PH1	10/07/2020	A	UTILITY PLAN
C8.0-PH1	10/07/2020	A	GENERAL NOTES
C9.0-PH1	10/07/2020	A	PAVEMENT DETAILS
C10.0-PH1	10/07/2020	A	STORM DRAIN DETAILS
C11.0-PH1	10/07/2020	A	WATER DETAILS
C12.0-PH1	10/07/2020	A	SANITARY SEWER DETAILS
C13.0-PH1	10/07/2020	A	SWPPP PLAN
C14.0-PH1	10/07/2020	A	SWPPP DETAILS
C15.0-PH1	10/07/2020	A	DETENTION POND CROSS SECTIONS
C16.0-PH1	10/07/2020	A	STORM DRAIN PLAN AND PROFILE
C17.0-PH1	10/07/2020	A	WATER LINE PLAN AND PROFILE
C1.0-PH2	10/07/2020	A	COVER SHEET
C2.0-PH2	10/07/2020	A	TOPOGRAPHIC SURVEY
C3.0-PH2	10/07/2020	A	DEMOLITION PLAN
C4.0-PH2	10/07/2020	A	PAVING PLAN
C5.0-PH2	10/07/2020	A	LAYOUT PLAN
C6.0-PH2	10/07/2020	A	GRADING PLAN
C7.0-PH2	10/07/2020	A	UTILITY PLAN
C7.1-PH2	10/07/2020	A	UTILITY PLAN
C8.0-PH2	10/07/2020	A	GENERAL NOTES
C9.0-PH2	10/07/2020	A	PAVEMENT DETAILS
C10.0-PH2	10/07/2020	A	STORM DRAIN DETAILS
C11.0-PH2	10/07/2020	A	WATER DETAILS
C12.0-PH2	10/07/2020	A	SANITARY SEWER DETAILS
C13.0-PH2	10/07/2020	A	SWPPP PLAN
C14.0-PH2	10/07/2020	A	SWPPP DETAILS
C1.0-PH3	10/07/2020	A	COVER SHEET
C2.0-PH3	10/07/2020	A	TOPOGRAPHIC SURVEY

C3.0-PH3	10/07/2020	A	DEMOLITION PLAN
C4.0-PH3	10/07/2020	A	PAVING PLAN
C5.0-PH3	10/07/2020	A	LAYOUT PLAN
C6.0-PH3	10/07/2020	A	GRADING PLAN
C7.0-PH3	10/07/2020	A	GENERAL NOTES
C8.0-PH3	10/07/2020	A	PAVEMENT DETAILS
C9.0-PH3	10/07/2020	A	SWPPP PLAN
C10.0-PH3	10/07/2020	A	SWPPP DETAILS
A-201O	10/07/2020	R	ARCHITECTURAL – EXTERIOR ELEVATIONS
A-110M	10/07/2020	R	ARCHITECTURAL - ENLARGED PLANS
A-111M	10/07/2020	R	ARCHITECTURAL - INTERIOR ELEVATIONS

Technical Specifications – (Project Manual)

Section No.	Revision Date	Status	Specification Title
n/a			

Additional Documents

Responses to Bidders Questions

Bid Form

This Addendum is hereby incorporated into the Contract Documents for the Project referenced above, modifying and superseding any previously issued Contract Documents. Bidders must acknowledge receipt of **Addendum 003** in the bid form.



THE COUNTY OF GALVESTON

RUFUS G. CROWDER, CPPO, CPPB
PURCHASING AGENT

GWEN MCLAREN, CPPB
ASST. PURCHASING AGENT

COUNTY COURTHOUSE
722 Moody (21st Street)
Fifth (5th) Floor
GALVESTON, TEXAS 77550

October 7, 2020

PROJECT NAME: Galveston County Road & Bridge Facility Rebuild Project

SOLICITATION NO: B201044

RE: ADDENDUM #3

To All Prospective Bidders:

The following information is being provided to aid in preparation of your bid submittal(s):

Question #1: *I have not seen anything in the documents that the documents that discusses HUB and I wanted to know if HUB will be a requirement on this project?*

Response: **There is no HUB participation requirement on this project.**

Question #2: *I'm having trouble locating the bid proposal form to list our proposing bid amount. I've searched the specs and all I see the proposal form located within the specs beginning on page 96. Could you please direct me where we are to list the proposed amount?*

Response: **The Bid Form is included within this addendum.**

Question #3: *I have some questions about the Insulated Translucent Sandwich Panel Assemblies – Section 084500.*

1) Is Texas Department of Insurance – Windstorm compliance required for this project?

2) The thermal performance has conflicting information. 1.2.H. A U-factor of 0.53 will not result in 0.28 SHGC.

a) With Crystal over Crystal face sheets, thermally broken system, U-factor of 0.51 will result in SHGC of 0.50. Other FPR combinations will yield different result.

b) U-factor with 0.27 U-factor will result in 0.23 SHGC.

1. Please advise which thermal performance is required from above values. I have attached the thermal performance chart with available information.

Response: **1. Windstorm compliance is required.
2. U-factor of 0.51 and SHGC of 0.50 will be acceptable for this installation.**

Question #4: *Is the Maintenance Shop building conditioned?*

Response: **The vehicle bay areas are not conditioned. Th interior spaces at plan-West are conditioned (Restroom, Break Room, Fleet Shop Admin, Fleet Shop Manager, Shop Foreman, IT/Storage, Open Area)**

Question #5: *Is the Maintenance Shop building sprinklered?*

Response: **Yes, the Maintenance Shop building is sprinklered.**

Question #6: *What Interior Finish Class is required at Maintenance Shop building (A, B, or C)?*

Response: **The Interior Finish Class is Class C in the admin side and Class B in the vehicle bays.**

Question #7: *The specification indicates a missile impact rating which requires the .052" thick exterior face sheet when installed below 30'-0" from grade. Will the currently specified .070" exterior face sheet be updated to the .052" thick exterior face sheet to meet IBC code requirements?*

Response: **The 0.52" face sheet is a minimum thickness for this assembly. The 0.70" face sheet will exceed the specifications and is to remain.**

Question #8: *Kalwall does not warranty an anodized finish. They do offer a superior KCRF coating, which can meet the warranty specifications. Are you open to a KCRF coating?*

Response: **KCRF coating is acceptable. Contractor shall provide sample of #79 Aluminum and #80 Gray.**

Question #9: *On the drawing the translucent panels appear to have a trapezoidal shape. By changing them to a rectangular shape, you can incur cost savings. Are you open to changing the shape? Are you open to reducing the quantity of battens by maximizing panel lengths?*

Response: **The overall geometry of the panel assembly must remain. Changing them to rectangular shape is not acceptable. If the cost of the assembly can be reduced by reducing the number of battens, this will be acceptable.**

As a reminder, all questions regarding this bid must be submitted in writing to:

Rufus G. Crowder, CPPO CPPB
Galveston County Purchasing Agent
722 Moody, Fifth (5th) Floor
Galveston, Texas 77550
E-mail: purchasing.bids@co.galveston.tx.us

If you have any further questions regarding this bid, please address them to Rufus Crowder, CPPO CPPB, Purchasing Agent, via e-mail at purchasing.bids@co.galveston.tx.us, or contact the Purchasing Department at (409) 770-5371.

Please excuse us for any inconvenience that this may have caused.

Sincerely,

Rufus G. Crowder, CPPO CPPB
Purchasing Agent
Galveston County

Bid Form

Galveston County Road & Bridge Facility Rebuild Project

1. Instructions

- a. The Bidder shall furnish necessary resources and services required to complete the project, in accordance with the scope of work and project specifications and drawings hereby incorporated and made a part of this RFP and the contract documents, for the prices listed below.
- b. Having examined Proposal and Contract Documents, and having reviewed site conditions, the undersigned proposes to furnish all labor, equipment and materials and perform all work for the completion of the above-named project for the sum indicated below.

2. Base Bid

The Undersigned agrees to complete the work for the lump sum amount of:

_____ Dollars (words)

\$_____ (numbers)

The above represents a Total Proposed Price reflecting all project costs to successfully complete the project.

3. Contract Duration

The Undersigned proposes to commence work upon Notice to Proceed and be substantially complete within _____ calendar days.

4. Owner/Client References who can attest to the Bidder's capability to carry out the requirements set for the in this RFP:

a. Reference #1

i. Name and Title: _____

ii. Organization: _____

iii. Phone: _____

iv. Email: _____

b. Reference #2

i. Name and Title: _____

ii. Organization: _____

iii. Phone: _____

iv. Email: _____

- c. Reference #3
 - i. Name and Title: _____
 - ii. Organization: _____
 - iii. Phone: _____
 - iv. Email: _____

5. **Subcontractor/Supplier References** who can attest to the Bidder's capability to carry out the requirements set for the in this RFP:

- a. Reference #1
 - i. Name and Title: _____
 - ii. Organization: _____
 - iii. Phone: _____
 - iv. Email: _____
- b. Reference #2
 - i. Name and Title: _____
 - ii. Organization: _____
 - iii. Phone: _____
 - iv. Email: _____
- c. Reference #3
 - i. Name and Title: _____
 - ii. Organization: _____
 - iii. Phone: _____
 - iv. Email: _____

6. **Relevant Experience:** Completed projects with similarities to this project.

- a. Project #1:
 - i. Project Name: _____
 - ii. Location: _____
 - iii. Year completed: _____
 - iv. Similarity to this project: _____

- b. Reference #2:
- i. Project Name: _____
 - ii. Location: _____
 - iii. Year completed: _____
 - iv. Similarity to this project: _____

- c. Reference #3:
- i. Project Name: _____
 - ii. Location: _____
 - iii. Year completed: _____
 - iv. Similarity to this project: _____

7. Bid Signature

By signing here, the firm attests that it has fully read the instructions, conditions and general provisions and understands them.

The information in this RFP is to be utilized solely for preparing the proposal response to this RFP and does not constitute a commitment by Galveston County to procure any product or service in any volume.

Name: _____

Title: _____

Company: _____

Company Address: _____

Company FEIN (TAX ID): _____

Phone Number: _____

Signature: _____

Date: _____












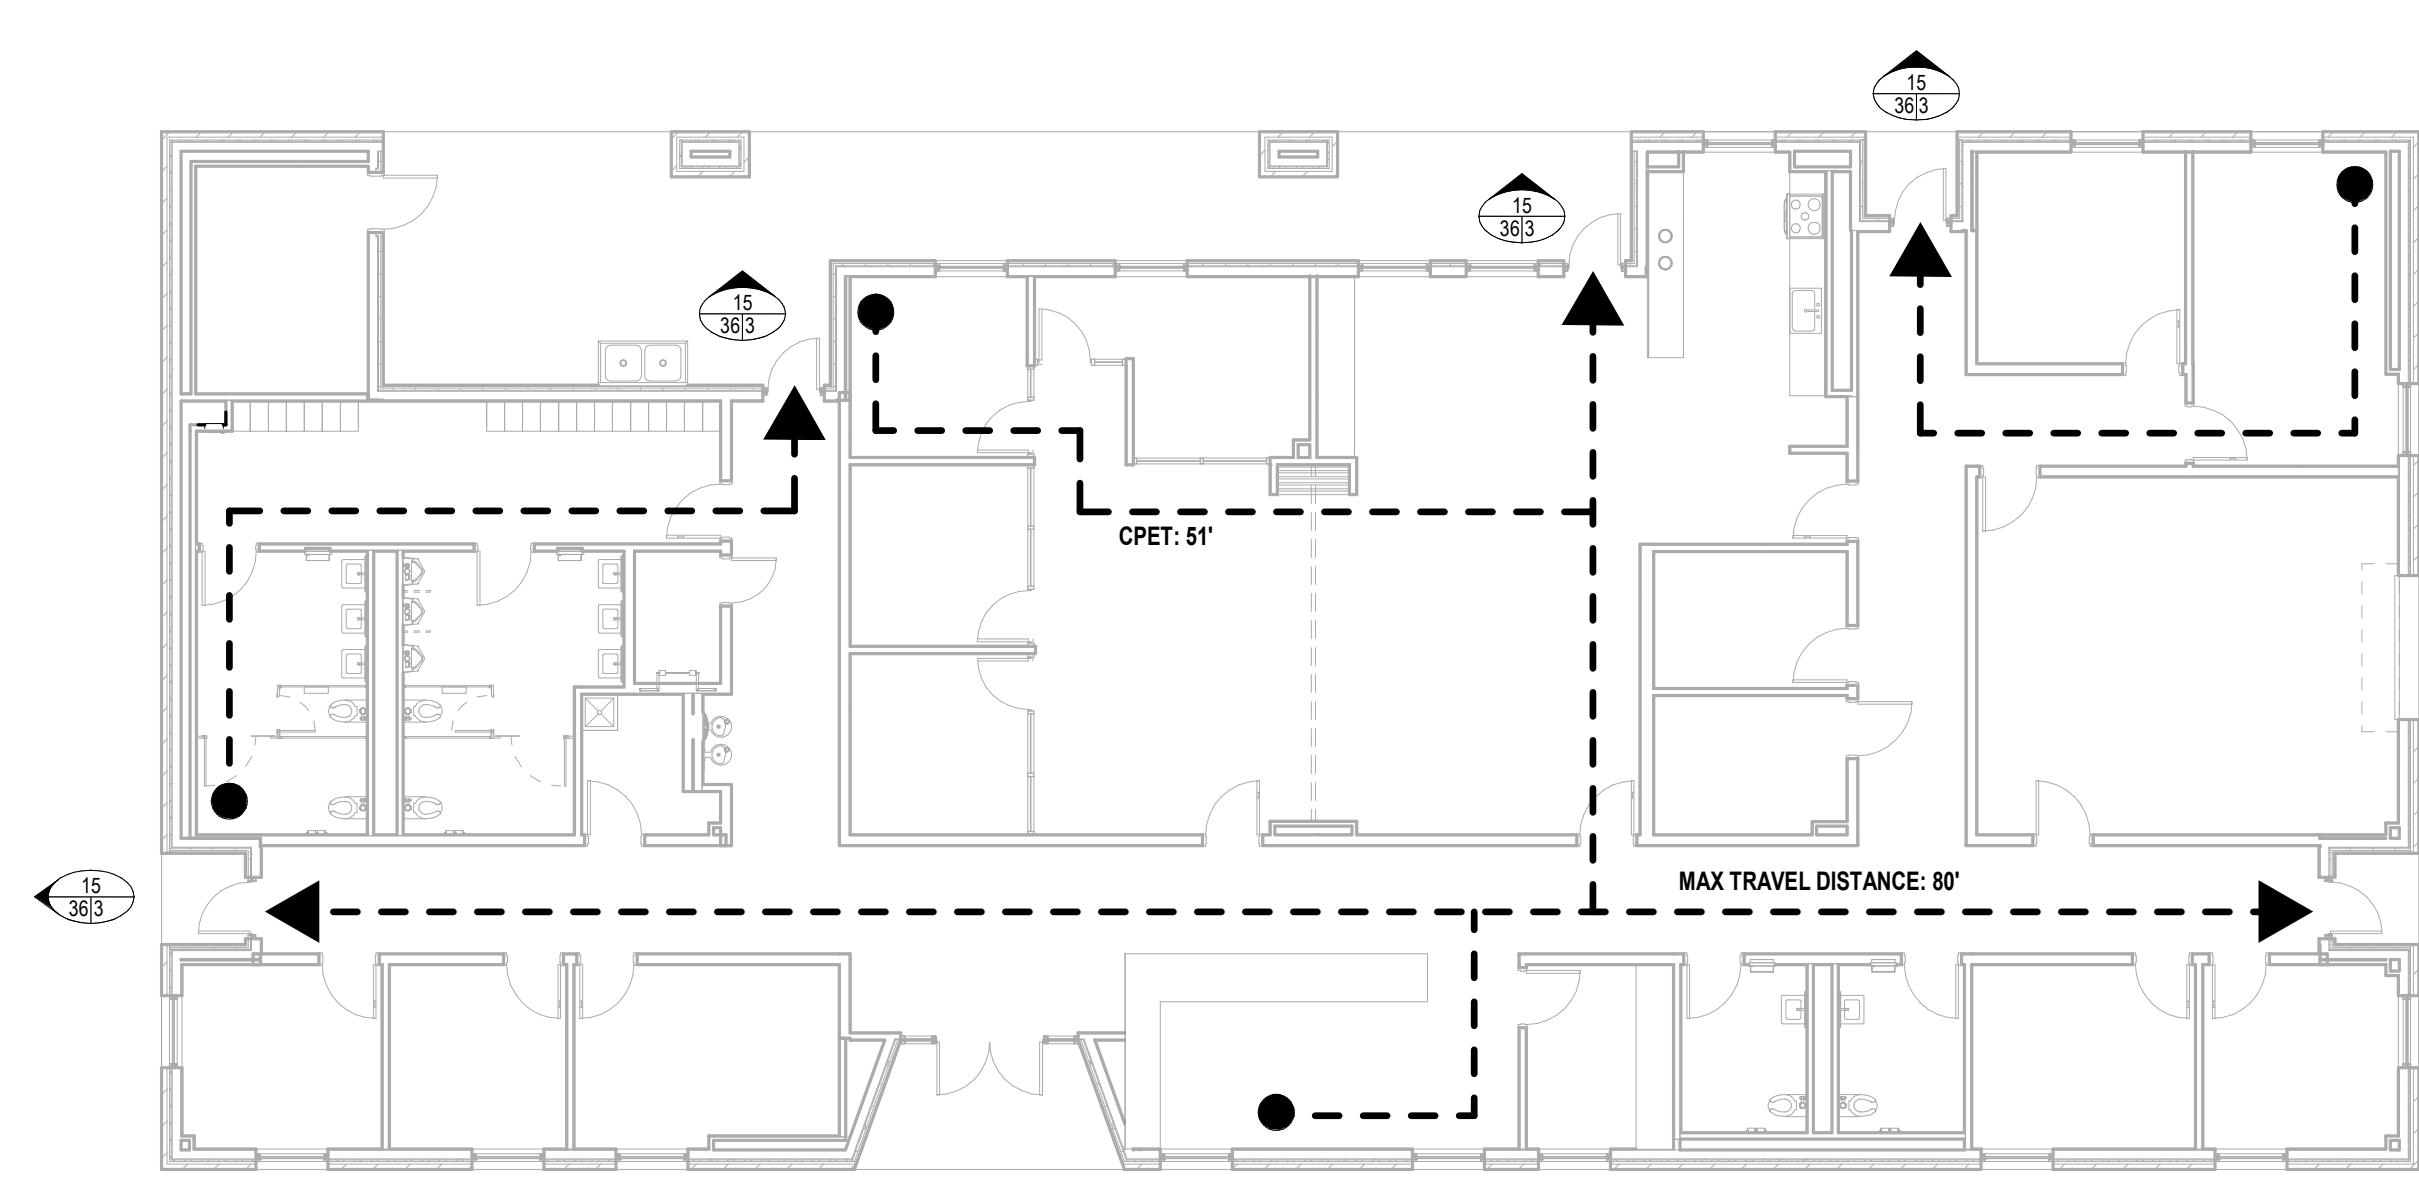


LIFE-SAFETY ANALYSIS - OFFICE BUILDING. NET FLOOR AREA: 6,430 SF. GROSS FLOOR AREA: 7,230 SF. OCCUPANT LOAD: 100 PERSONS PER SF = 73 OCCUPANTS.

1 LIFE-SAFETY PLAN - OFFICE SCALE: 3/32" = 1'-0"

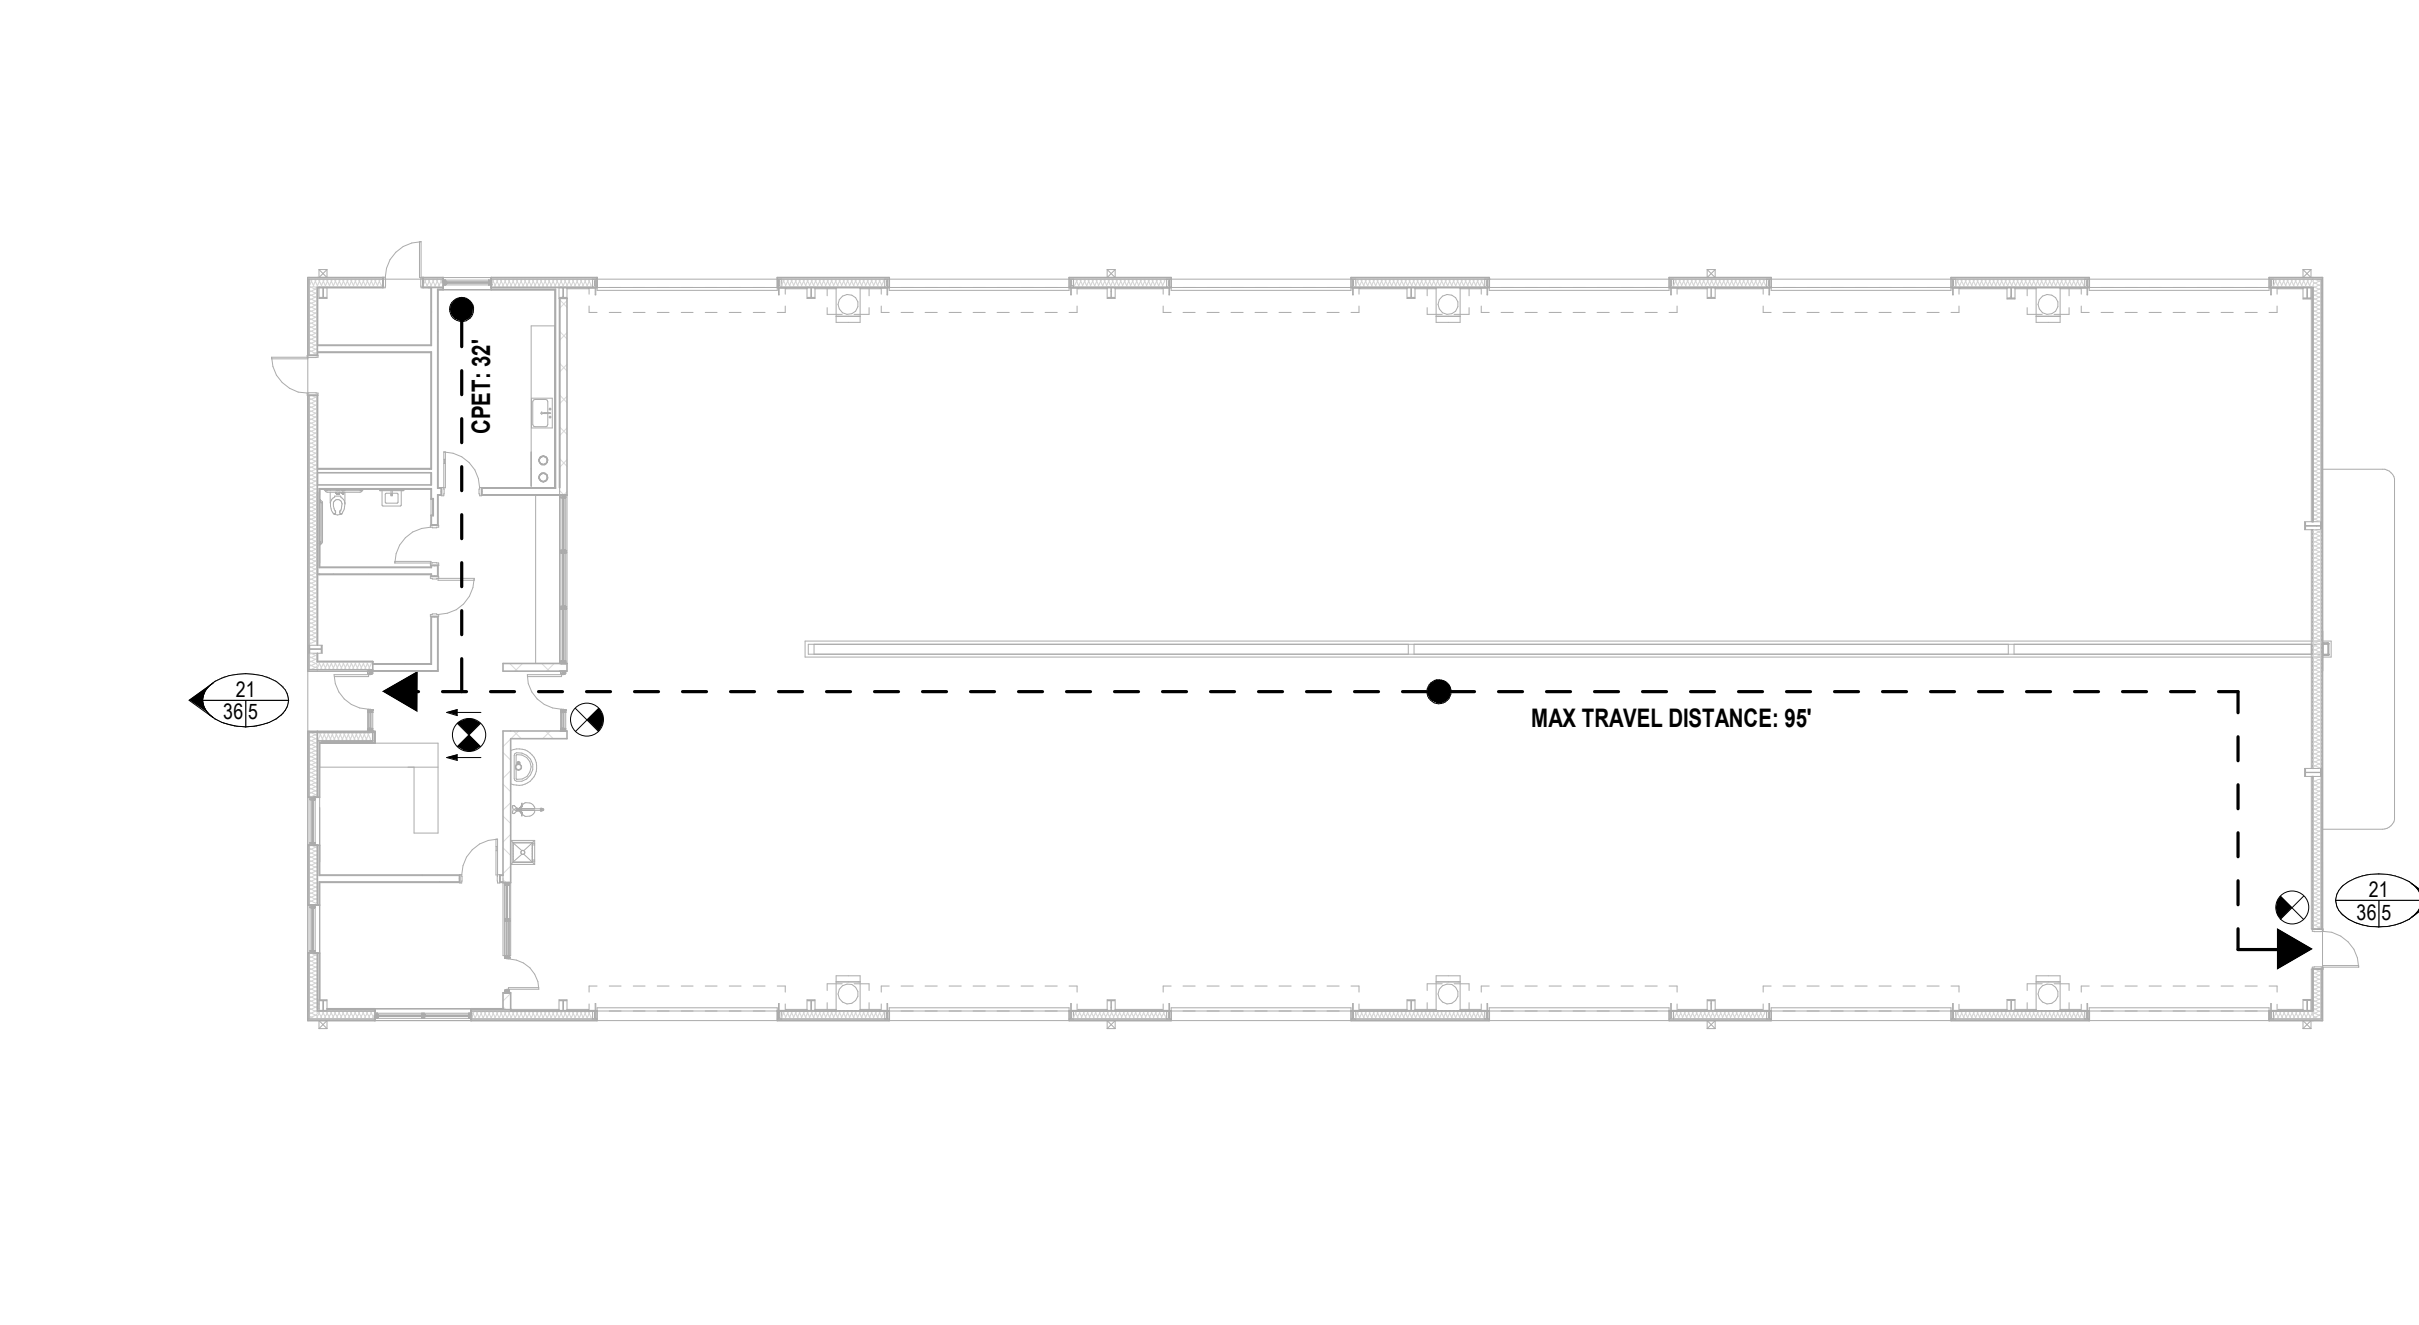

LIFE-SAFETY ANALYSIS - MAINTENANCE SHOP. GROSS FLOOR AREA: 10,400 SF. ADMIN OFFICE AREA: 1,230 SF - OCCUPANCY CLASSIFICATION: B.

2 LIFE-SAFETY PLAN - MAINTENANCE SHOP SCALE: 1/16" = 1'-0"

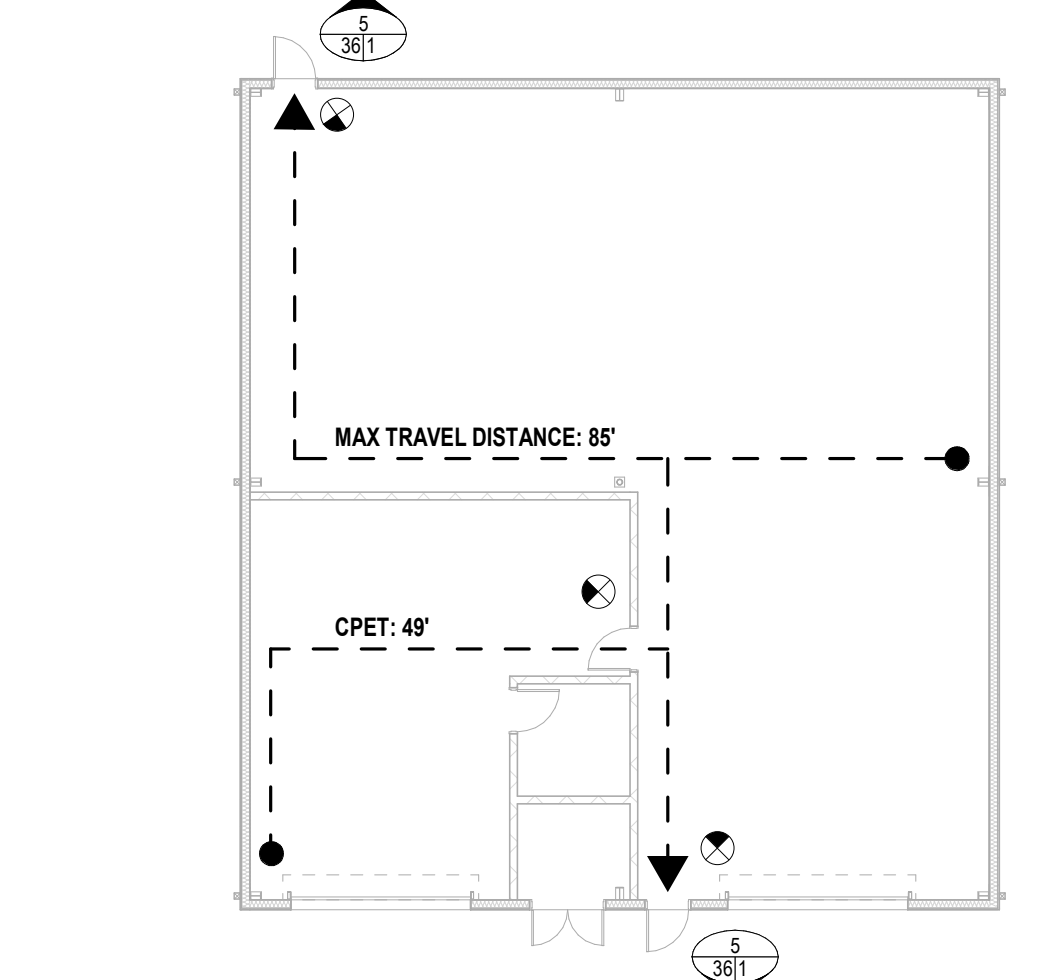

LIFE-SAFETY ANALYSIS - WAREHOUSE. GROSS FLOOR AREA: 4,380 SF. OCCUPANT LOAD: 100 PERSONS PER SF = 9 OCCUPANTS.

3 LIFE-SAFETY PLAN - WAREHOUSE SCALE: 1/16" = 1'-0"

LIFE-SAFETY LEGEND table defining symbols for direction of travel, exits, and fire extinguishers.

PROJECT DESCRIPTION table containing project name, address, owner, and applicable building codes.

Vertical text on the left margin: C:\Users\vgandhi\Documents\418198-A-R19-CENTRAL-SITE_gandhi\VP3P.vnc

DOOR SCHEDULE - OFFICE. Table with columns: Door Number, Door Type, Overall Width, Height, Door Thickness, Material, Finish, Material, Frame Jamb, Head, Fire Rating, Hardware Set, Comments.

Galveston Road and Bridge Fueling Overview. Two aboveground storage tanks (AST) will store diesel and gasoline products. Gasoline and diesel will be transferred to a fuel island where two dispensers will be installed in order to dispense gasoline and diesel from each dispenser.










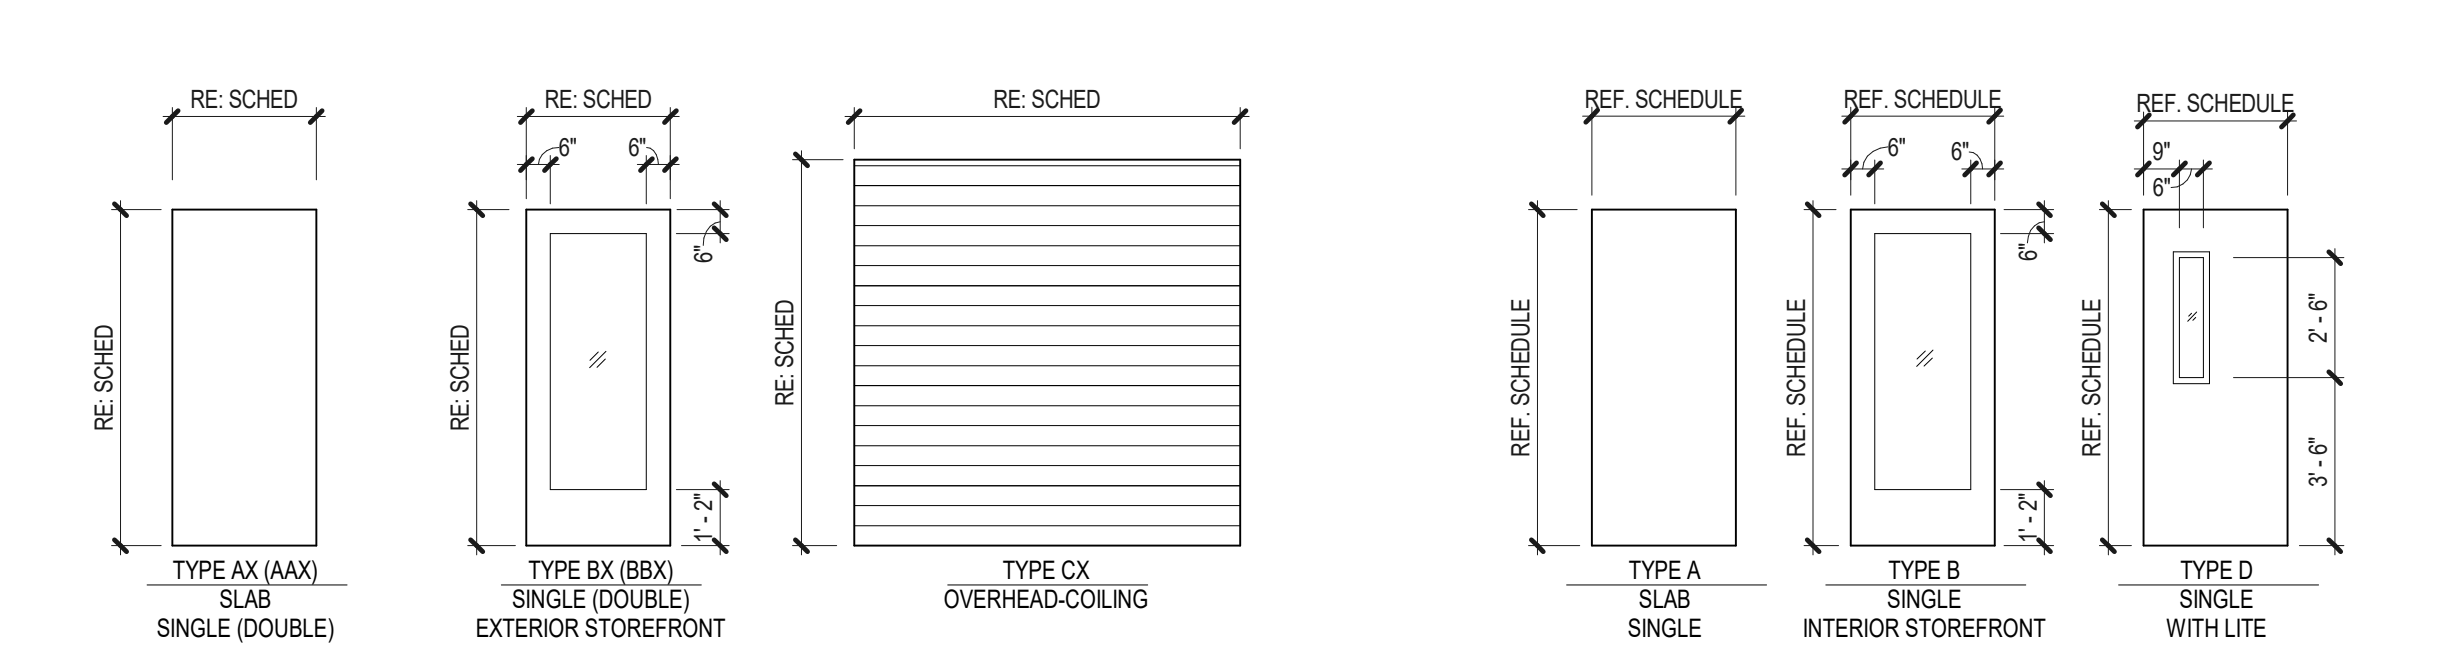

1 EXTERIOR DOOR TYPES SCALE: 1/4" = 1'-0" 2 INTERIOR DOOR TYPES SCALE: 1/4" = 1'-0"

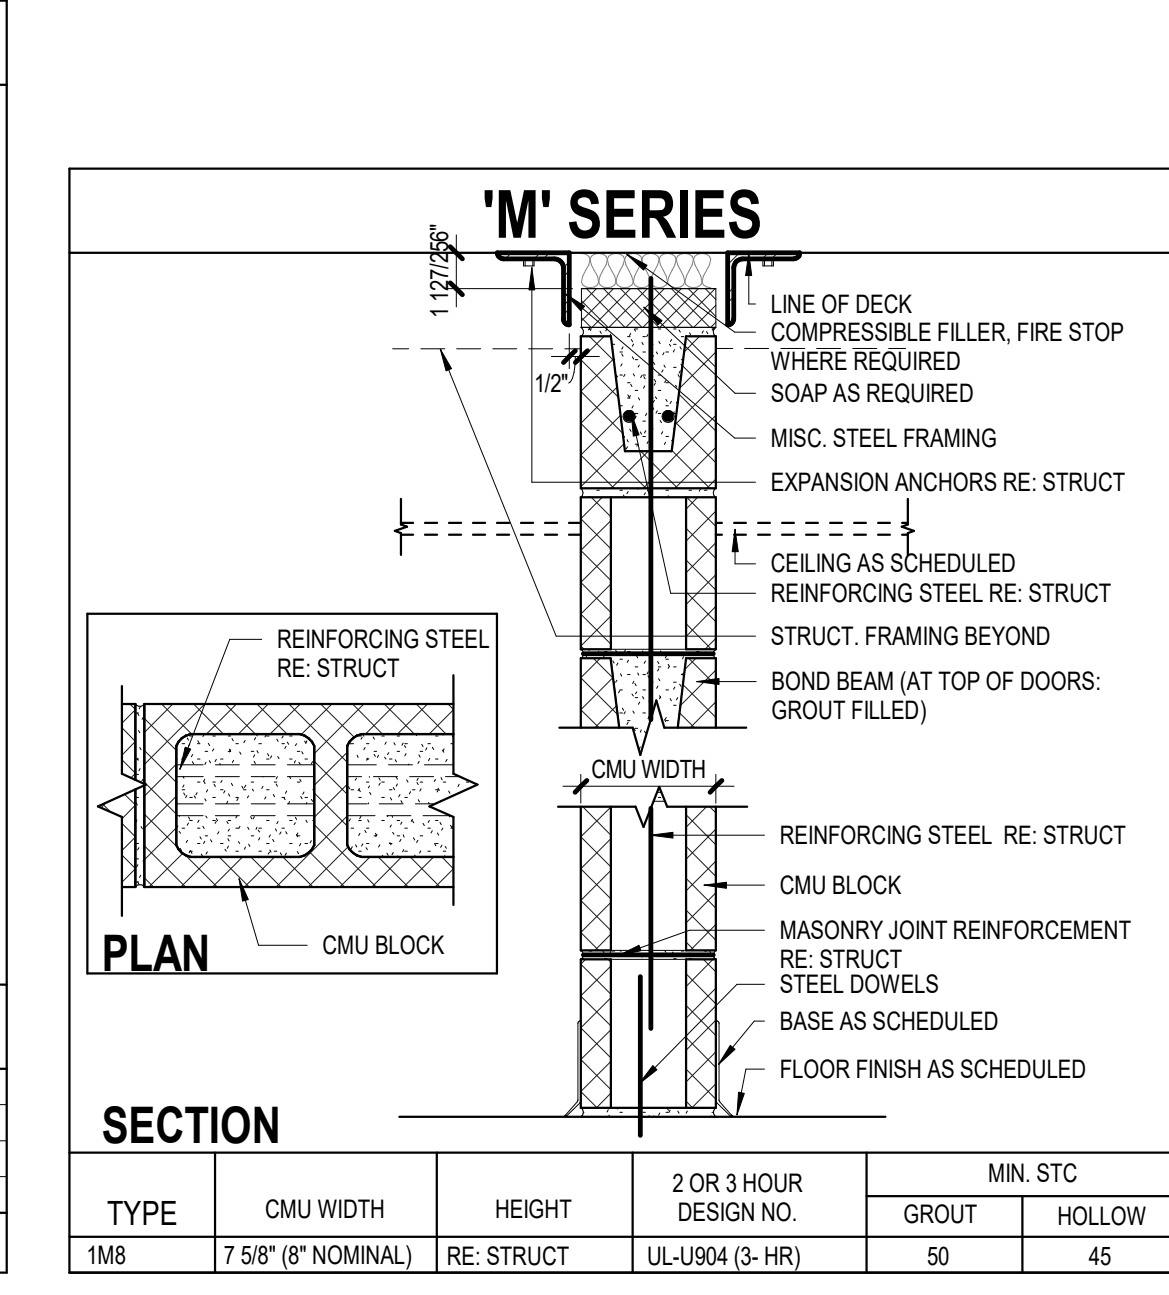
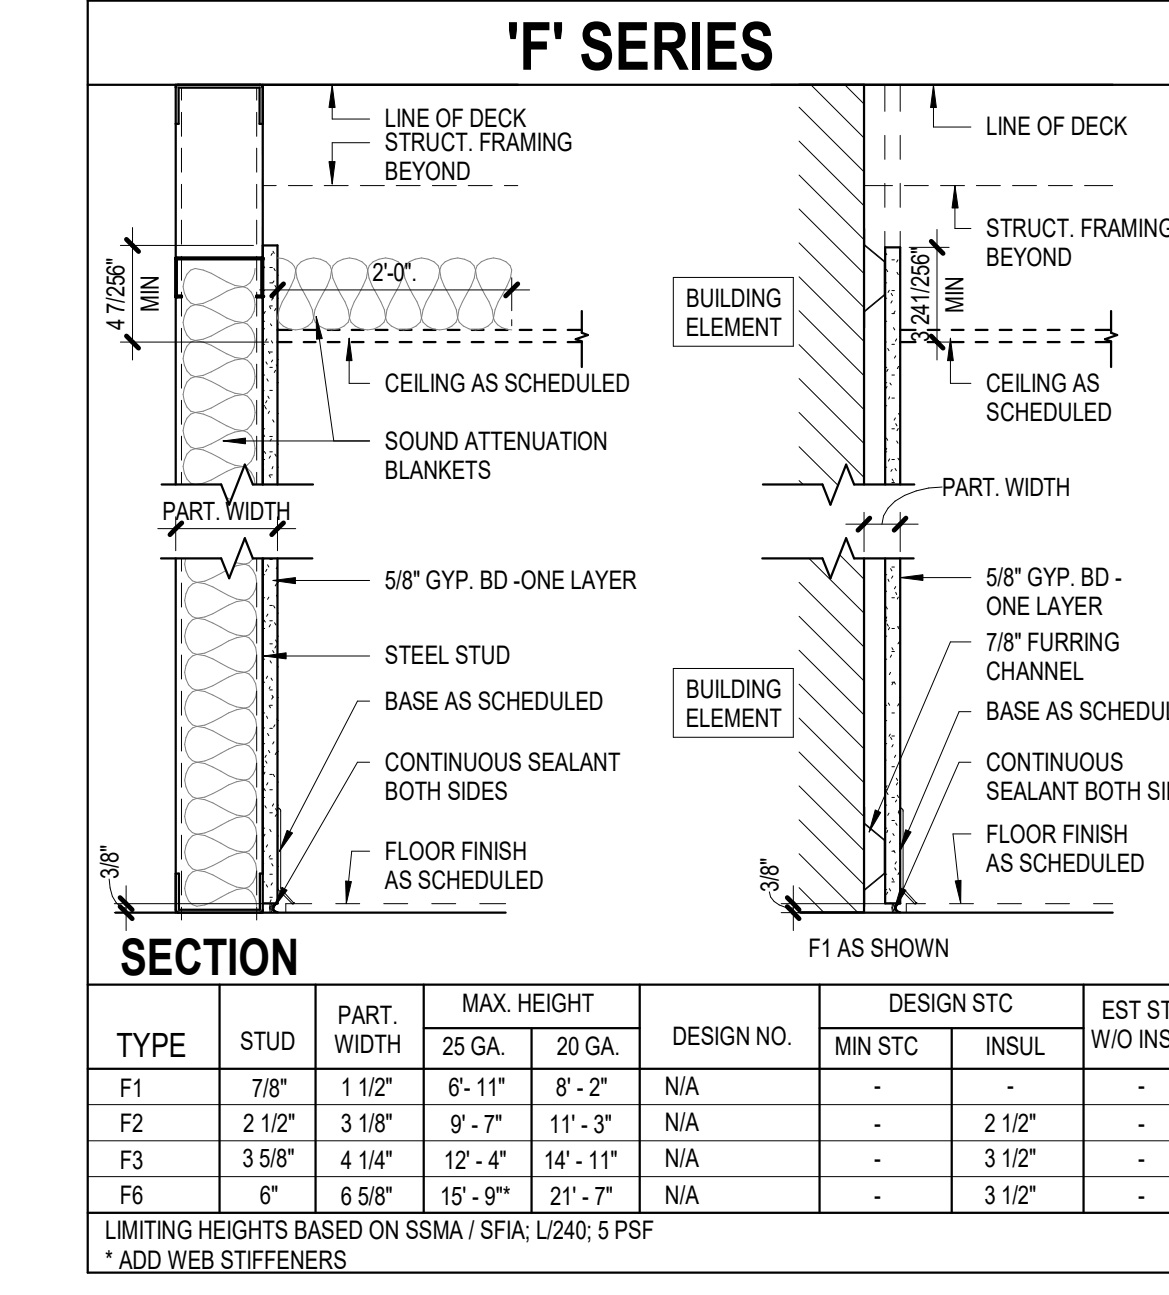
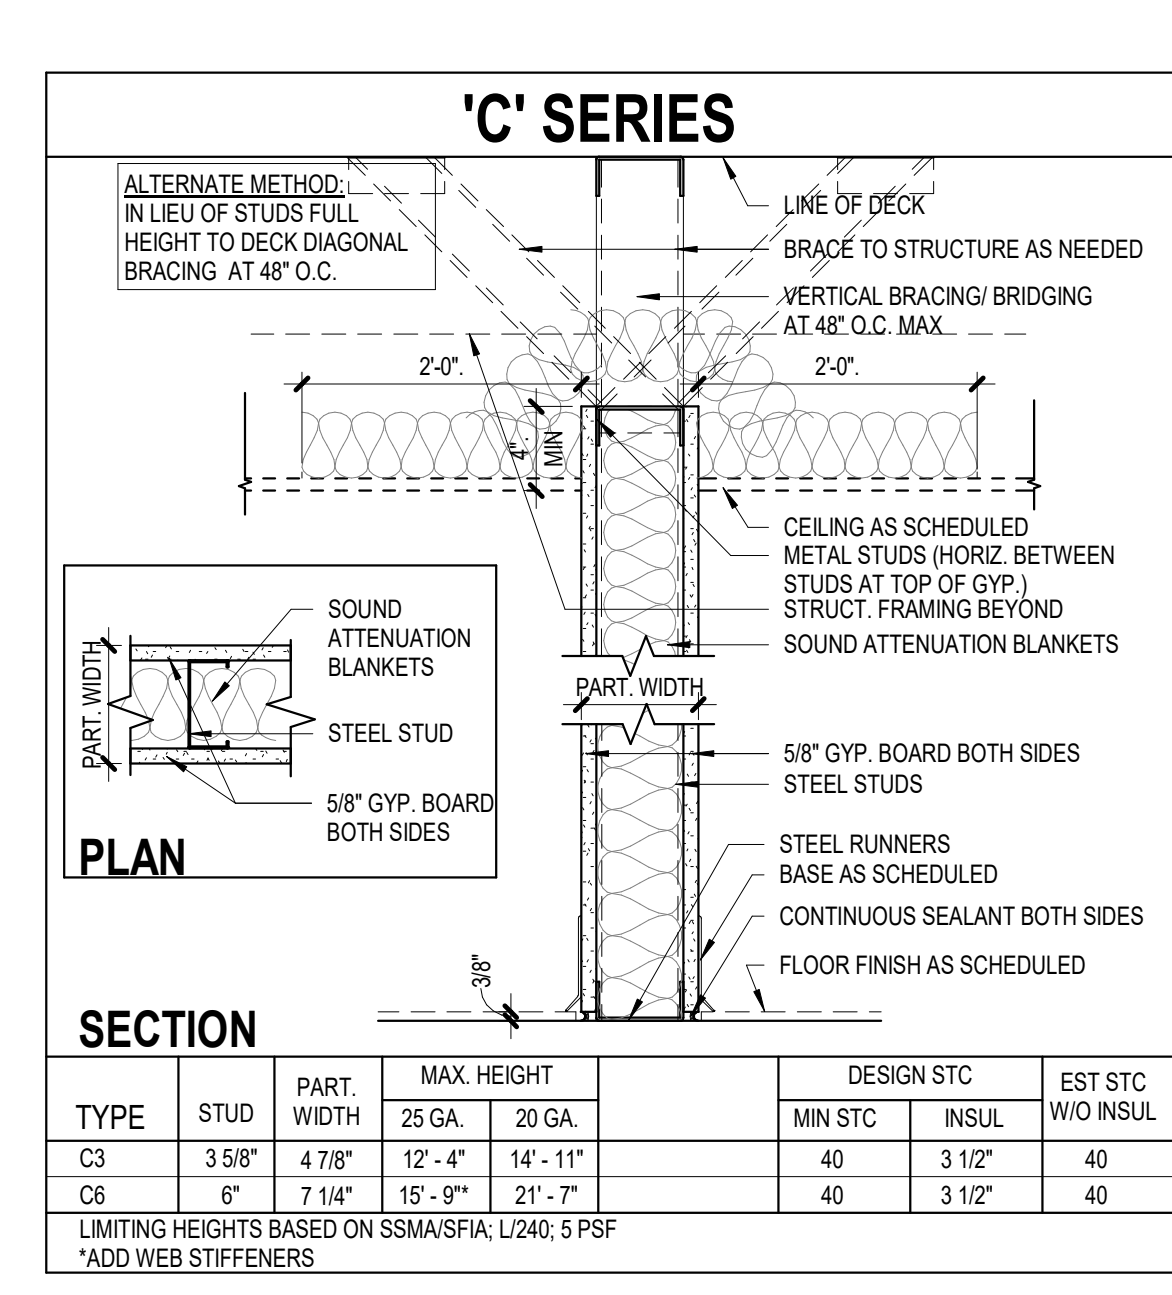
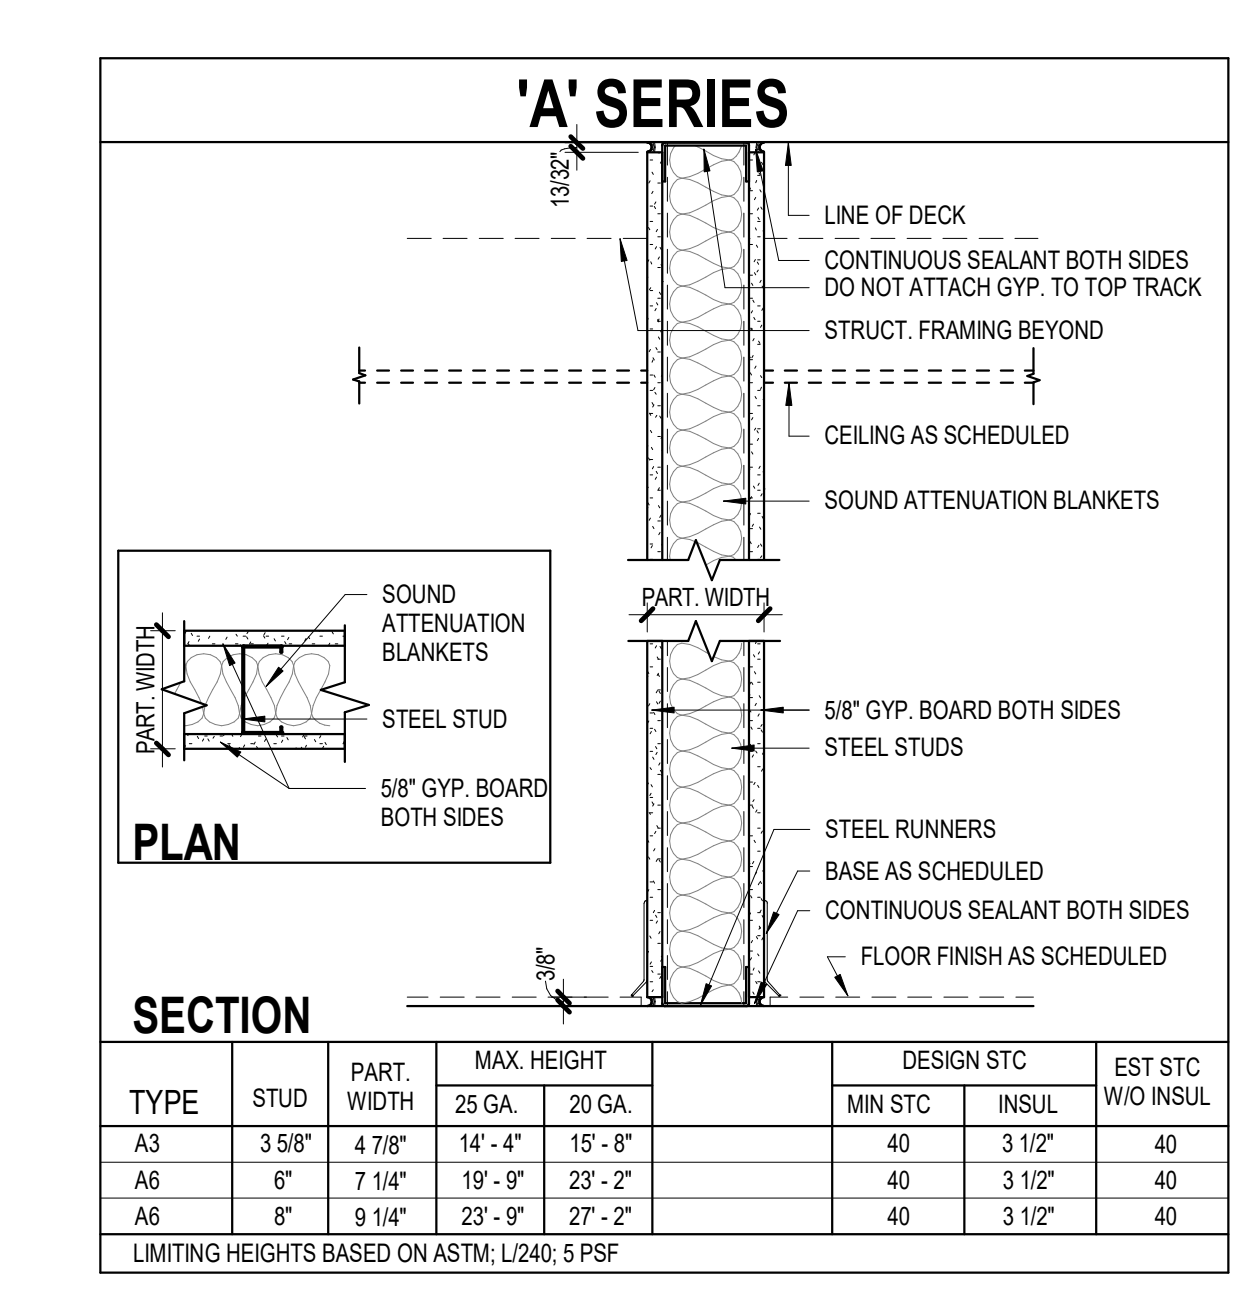


Table with columns: TYPE, STUD, PART WIDTH, MAX HEIGHT, DESIGN STC, EST STC, W/O INSUL, W/INSUL.

SECTION TYPE STUD PART WIDTH MAX HEIGHT DESIGN STC EST STC W/O INSUL W/INSUL

SECTION TYPE CMU WIDTH HEIGHT DESIGN NO. MM STC HOLLOW

PARTITION GENERAL NOTES

- 1. ALL NEW INTERIOR PARTITIONS SHOWN ON THE FLOOR PLANS ARE TYPE 'A2', UNLESS NOTED OTHERWISE.
2. PARTITION TYPE REFERENCES ARE INDICATED ON THE FLOOR PLANS.
3. PARTITION TYPES DO NOT DETERMINE EXTERIOR WALL CONSTRUCTION. REFER TO WALL SECTIONS FOR EXTERIOR WALL CONSTRUCTION.
4. ALL PARTITIONS THAT EXTEND FROM FLOOR TO THE UNDERSIDE OF DECK ABOVE SHALL HAVE THEIR FRONT AND ALL PENETRATIONS SEALED SMOKE/TIGHT WITH ACOUSTICAL SEALANT, AS APPLICABLE.
5. WHERE CERAMIC TILE, PORCELAIN PAVERS, QUARRY TILE, TERRAZZO OR CEMENT ARE SCHEDULED, PARTITION TYPES DO NOT DETERMINE EXTERIOR WALL CONSTRUCTION. REPLACE THE GWB WITH 5/8\"/>


PARTITION REFERENCES

- 1. SSMA - STEEL STUD MANUFACTURERS ASSOCIATION, "PRODUCT TECHNICAL INFORMATION," COPYRIGHT 2010.
2. SFA - STEEL FRAMING INDUSTRY ASSOCIATION, "TECHNICAL GUIDE FOR COLD-FORMED STEEL FRAMING," COPYRIGHT 2011.
3. ASTM - ASTM INTERNATIONAL DESIGNATION C754-08, "STANDARD SPECIFICATION FOR INSTALLATION OF STEEL FRAMING MEMBERS TO RECEIVE SCREW-ATTACHED GYPSUM PANEL PRODUCTS".
4. GA - GYPSUM ASSOCIATION, "FIRE RESISTIVE DESIGN MANUAL," 10TH EDITION GA-600-2009.
5. UL - UNDERWRITERS LABORATORIES, "BUILDING MATERIALS, FIRE PROTECTION, ROOMING MATERIALS AND SYSTEMS AND FIRE RESISTANCE DIRECTORIES (4 VOLUMES)," 2011 EDITION.
6. WHI-WARNOCK HERSEY MARK DIRECTORY
7. CSO - CSO EVALUATION REPORT NO. 3579
8. S&B- MANUFACTURER THERMAFIBER PRODUCT, SOUND ATTENUATION FIRE BLANKET.

GENERAL NOTES

- 1. RE. SPEC SECTION 08 71 00 (DOOR HARDWARE) FOR DOOR HARDWARE SETS.
2. FOR MAINTENANCE SHOP EQUIPMENT CONTACT THE FOLLOWING REP FOR PRICING: JON THORNTON VSA MANUFACTURER'S REPRESENTATIVE JTHORNTON@VSAEPS.COM 281.744.8223
3. FOR WASHRACK EQUIPMENT CONTACT THE FOLLOWING REP FOR PRICING: PETE BULLMORE ALLEMAN INDUSTRIES, INC PETEBULL@ALLEMAN.COM 713.818.2728
4. FOR FUELAIR EQUIPMENT CONTACT THE FOLLOWING REP FOR PRICING: DON DEANGELO ERLING SALES & SERVICE DONANGELO@ERLINGSALES.COM 214-505-2900

KEY PLAN (NOT TO SCALE)

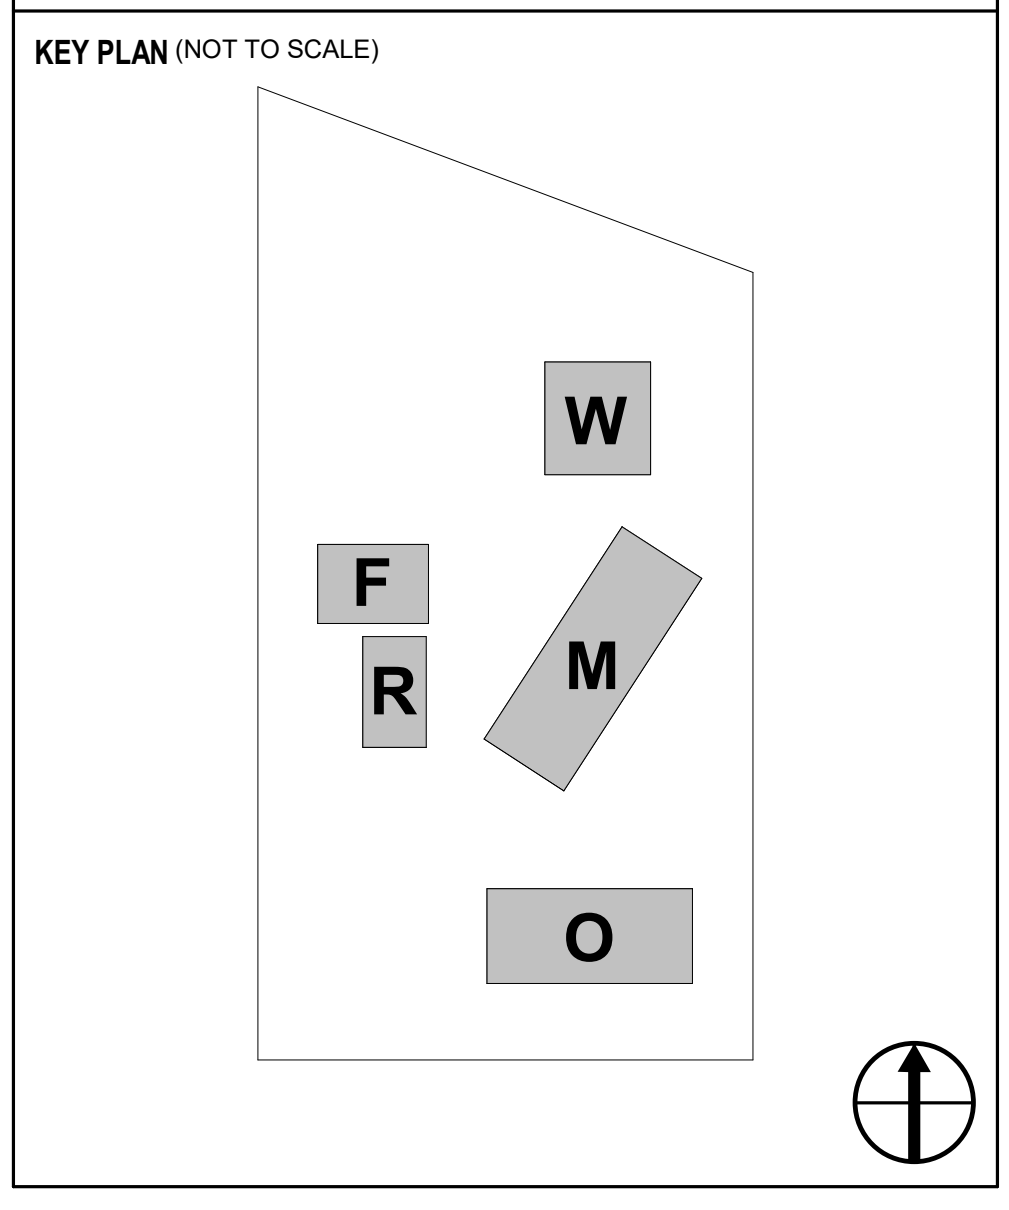

REVISION HISTORY table with columns: NO., DATE, DESCRIPTION.


Professional seal and registration information for Page Southerland Page, Inc., including Firm Registration No. 15868, State of Texas, and Project Information: G-110, SHEET NUMBER.

GALVESTON COUNTY ROAD & BRIDGE DEPARTMENT FACILITIES-PHASE 1


5115 TX- 3
DICKINSON, TX 77539

ISSUE FOR PERMIT

ADDENDUM NO.3 10-07-2020

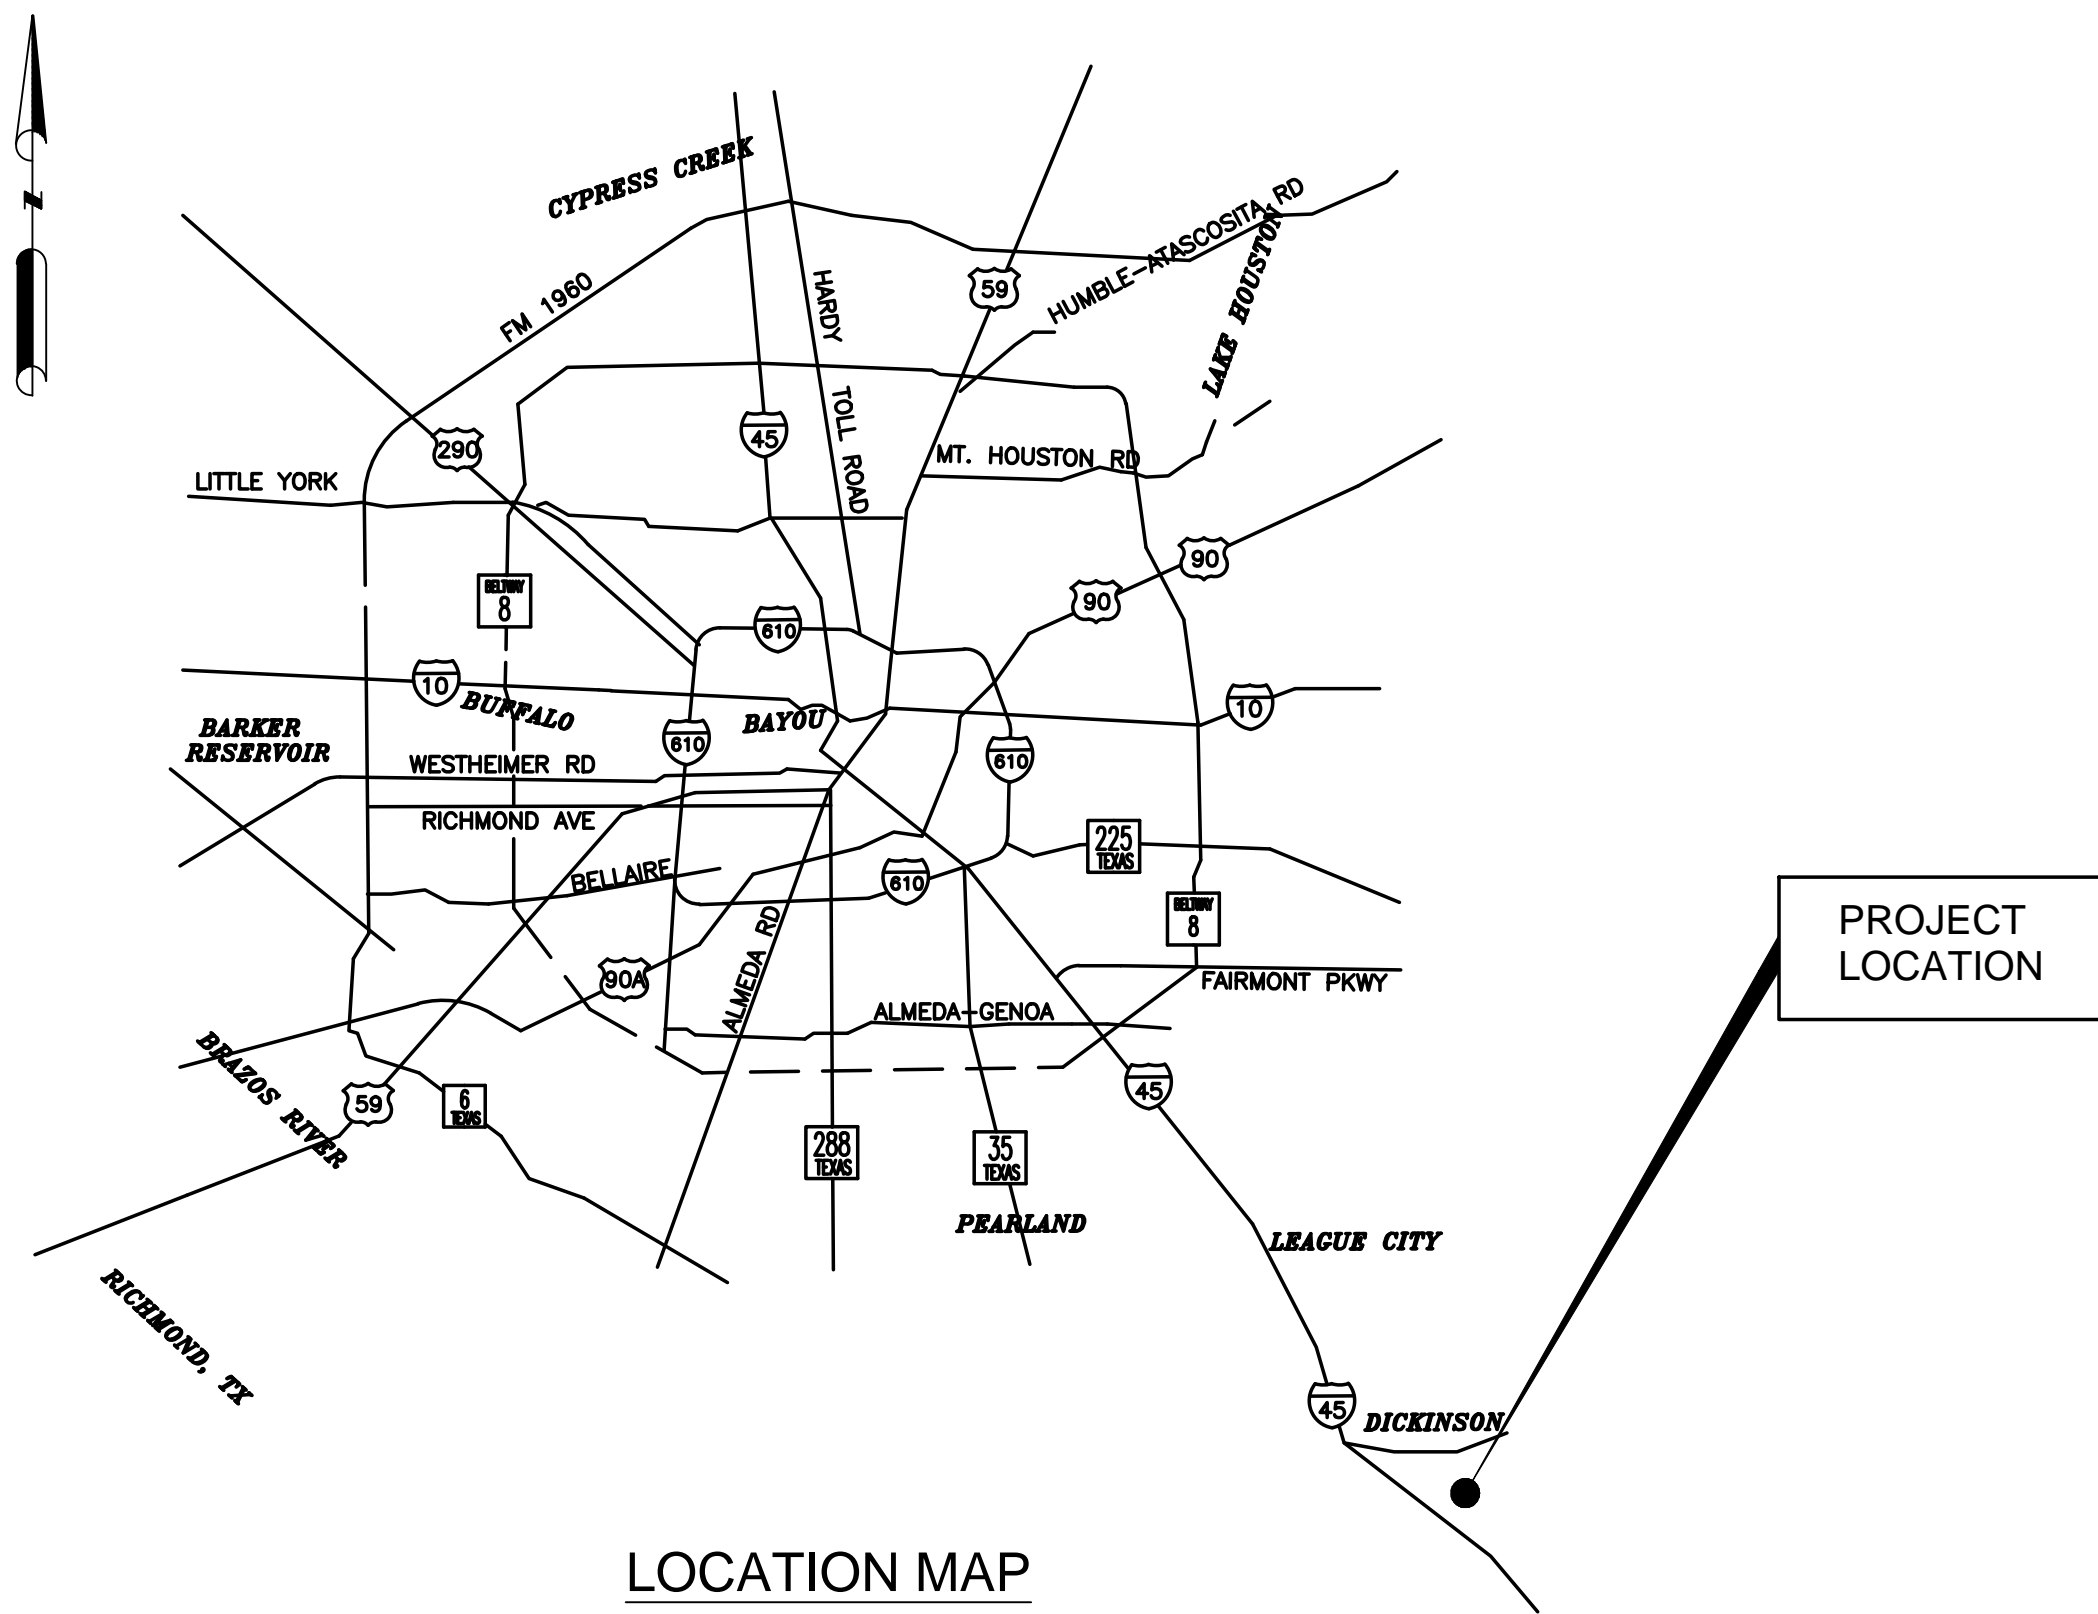

LOCATION MAP

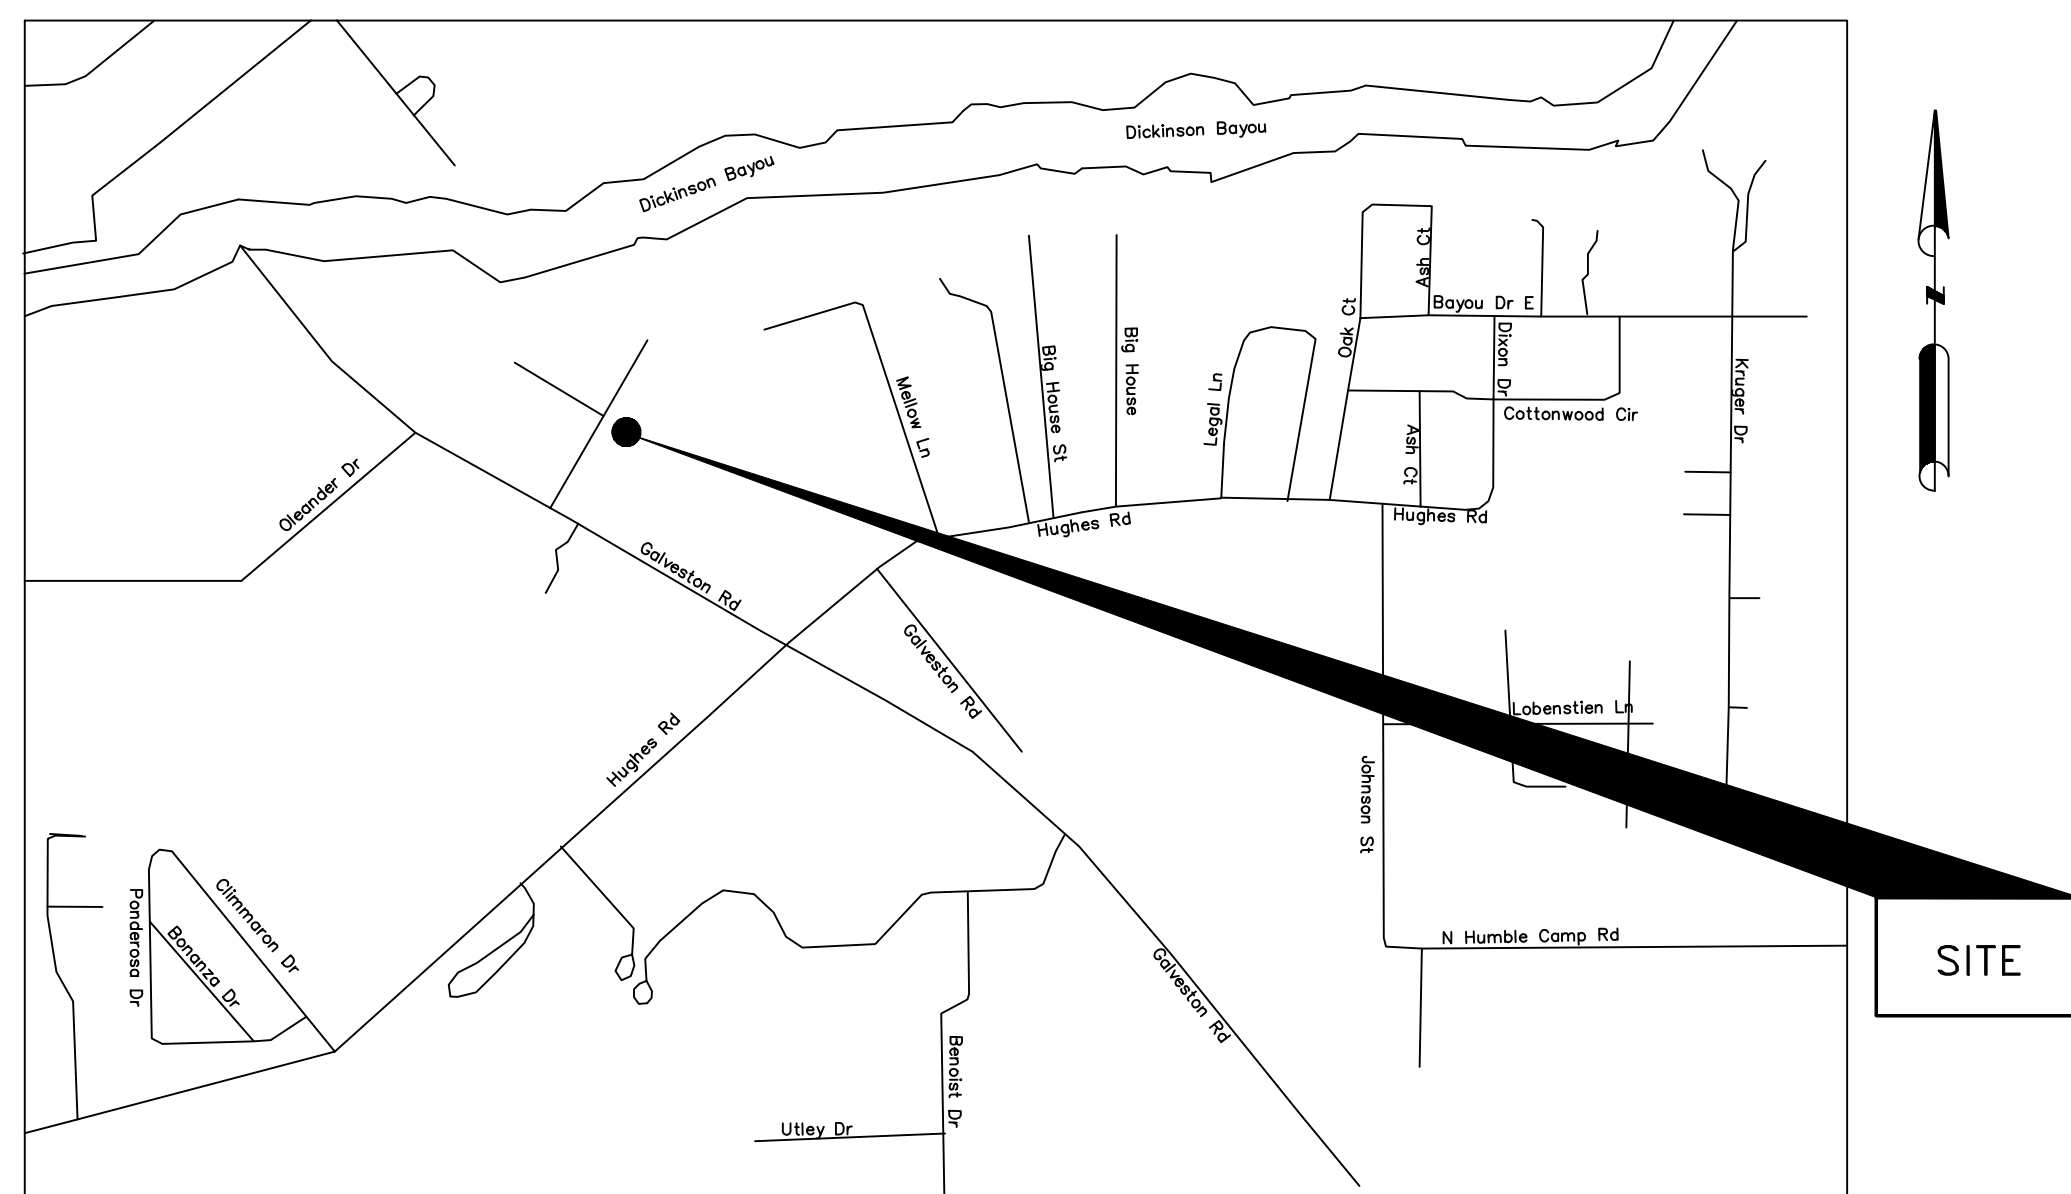

VICINITY MAP
N.T.S.
KEY MAP: 190-A

CIVIL ENGINEER:

DALLY+ASSOCIATES, INC.

TBPE FIRM REGISTRATION #3426

9800 RICHMOND AVENUE, SUITE 460
HOUSTON, TX 77042
(713) 337 8881
www.dallyassociates.com

Project Manager: Jose Diego Monroy, CFM
Project Engineer: Fred Dally, P.E.

OCTOBER 07, 2020

CIVIL SHEET INDEX

SHEET #	SHEET NAME
C1.0-PH1	COVER SHEET
C2.0-PH1	TOPOGRAPHIC SURVEY
C3.0-PH1	DEMOLITION PLAN
C4.0-PH1	PAVING PLAN
C5.0-PH1	LAYOUT PLAN
C6.0-PH1	GRADING PLAN
C7.0-PH1	UTILITY PLAN
C7.1-PH1	UTILITY PLAN
C8.0-PH1	GENERAL NOTES
C9.0-PH1	PAVEMENT DETAILS
C10.0-PH1	STORM DRAIN DETAILS
C11.0-PH1	WATER DETAILS
C12.0-PH1	SANITARY SEWER DETAILS
C13.0-PH1	STORM WATER POLLUTION PREVENTION PLAN
C14.0-PH1	SWPPP DETAILS
C15.0-PH1	DETENTION POND CROSS SECTION
C16.0-PH1	STORM DRAIN PLAN & PROFILE
C17.0-PH1	WATER LINE PLAN & PROFILE

ONE- CALL NOTIFICATION SYSTEM
CALL BEFORE YOU DIG!!!
(713) 223-4567 (in Houston, TX)
(New Statewide Number Outside Houston)
1-800-545-6005

GALVESTON COUNTY
ROAD & BRIDGE
DEPARTMENT FACILITIES PH 1
5115 TX-3
DICKINSON, TX 77539

COVER SHEET

TBPE FIRM REGISTRATION #3426

DRAWING SCALE

DESIGNED BY: JDM
CHECKED BY: JDM

DATE: 10/07/20

C1.0-PH1




10/07/2020

NO.	DATE	REVISIONS
3	10/07/20	ADDENDUM NO. 3

GENERAL NOTES:


1. According to the Federal Emergency Management Agency (FEMA) Flood Insurance Rate Map (FIRM) for Galveston County, Texas, Map No. 485470095 C dated May 2, 1983 This properties lies within "Zone C" of the flood insurance rate map and does not lie within a special flood hazard zone.
This flood statement does not imply that the property or structures thereon will be free from flooding or flood damage. On rare occasions floods can and will occur in areas not shown on the flood insurance rate map. The actual location, as determined by elevation contours, may differ. Intertek Surveying & Services assumes no liability as to the accuracy of the location of the flood hazard limits. This flood statement shall not create liability on the part of KM Surveying, LLC.
2. This survey has been prepared for the sole purpose of the transaction described in the above mentioned Commitment for title insurance and the parties listed therein. This survey is not to be used for any subsequent transactions.
3. This survey does not determine the location of wetlands, fault lines, toxic waste, cemeteries, landfills, dumps or any other environmental issues.
4. Intertek Surveying & Services has not been provided with construction plans showing the location of underground utilities. Underground utilities may exist which are not shown hereon.
5. Readily visible improvements/utilities were located with this survey, no subsurface probing, excavation or exploration was performed Intertek Surveying & Services.
6. This exhibit has been prepared without benefit of current title report. There may be easements, setbacks, and other matters of record not shown hereon, the surveyor has not abstract the property.
7. Reference is made to a Survey of a 3.193-acre (139,093 sq. ft.) Tract situated in Galveston County, Texas, dated 12/12/2018. Prepared by Weisser Engineering Co. Job. No. GD404 and in the field book 3510.

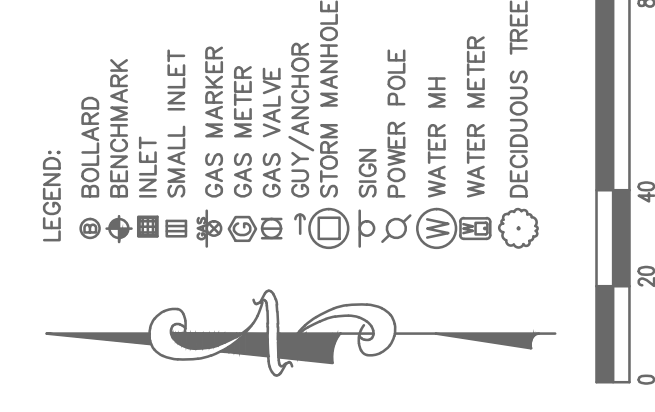

- LEGEND:
- ⊙ BOLLARD
 - ⊕ BENCHMARK
 - ⊙ INLET
 - ⊙ GAS METER
 - ⊙ GAS VALVE
 - ⊙ GUY/ANCHOR
 - ⊙ STORM MANHOLE
 - ⊙ SIGN
 - ⊙ POWER POLE
 - ⊙ WATER MH
 - ⊙ WATER METER
 - ⊙ DECIDUOUS TREE

PROJECT SITE
AP.png

Vehicle Map
N.T.S.

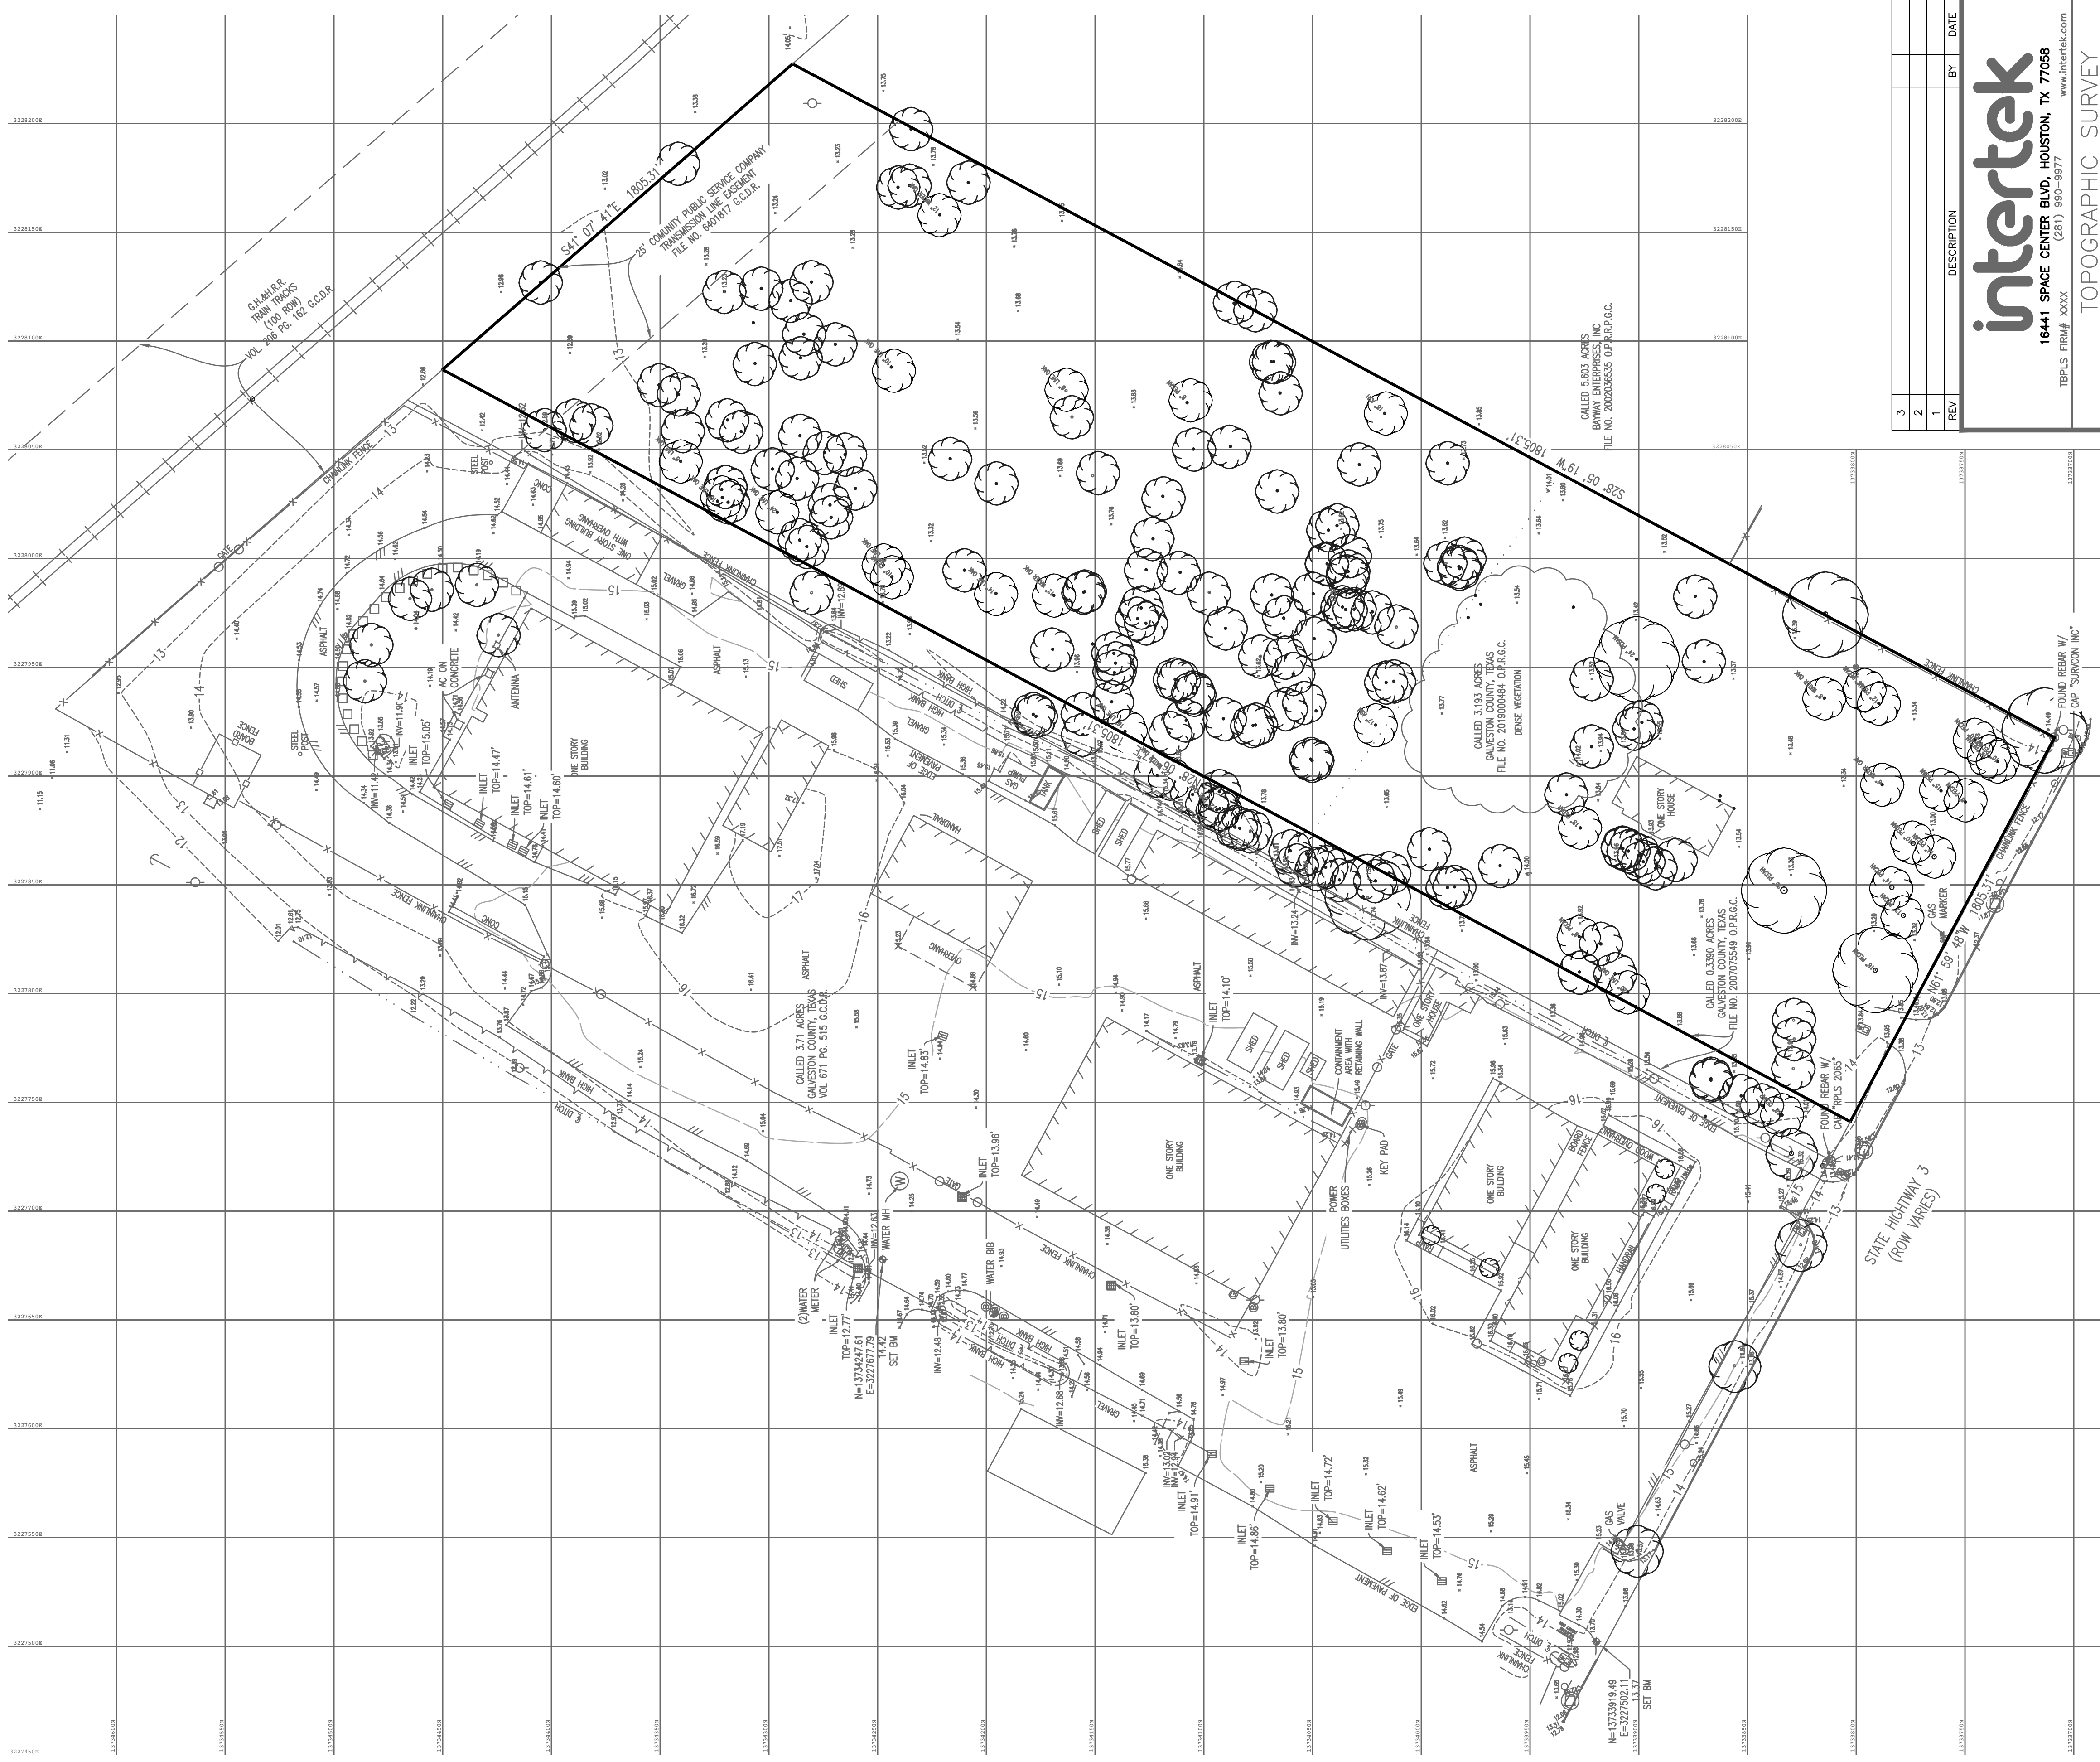

REV	DESCRIPTION	BY	DATE
3			
2			
1			



intertek
16441 SPACE CENTER BLVD., HOUSTON, TX 77068
TBPLS FIRM# XXXX www.intertek.com

TOPOGRAPHIC SURVEY
TRACT OF LAND SITUATED IN THE
ALEXANDER FARMER LEAGUE, A-11 &
THE W.K. WILSON SURVEY, A-205
GALVESTON COUNTY, TEXAS

SURVEYED: MR JOB NO.: 19113
DRAWN: MR SCALE: 1"= 40'
DWG.: psi - Iss - 19113 topo 071720 BAREGRED T&E SHEET NO.: 1 OF 1

C2.0-PH1

**Galveston County
Road & Bridge Department Facilities PH1**
5115 Texas Highway 3
Dickinson, TX

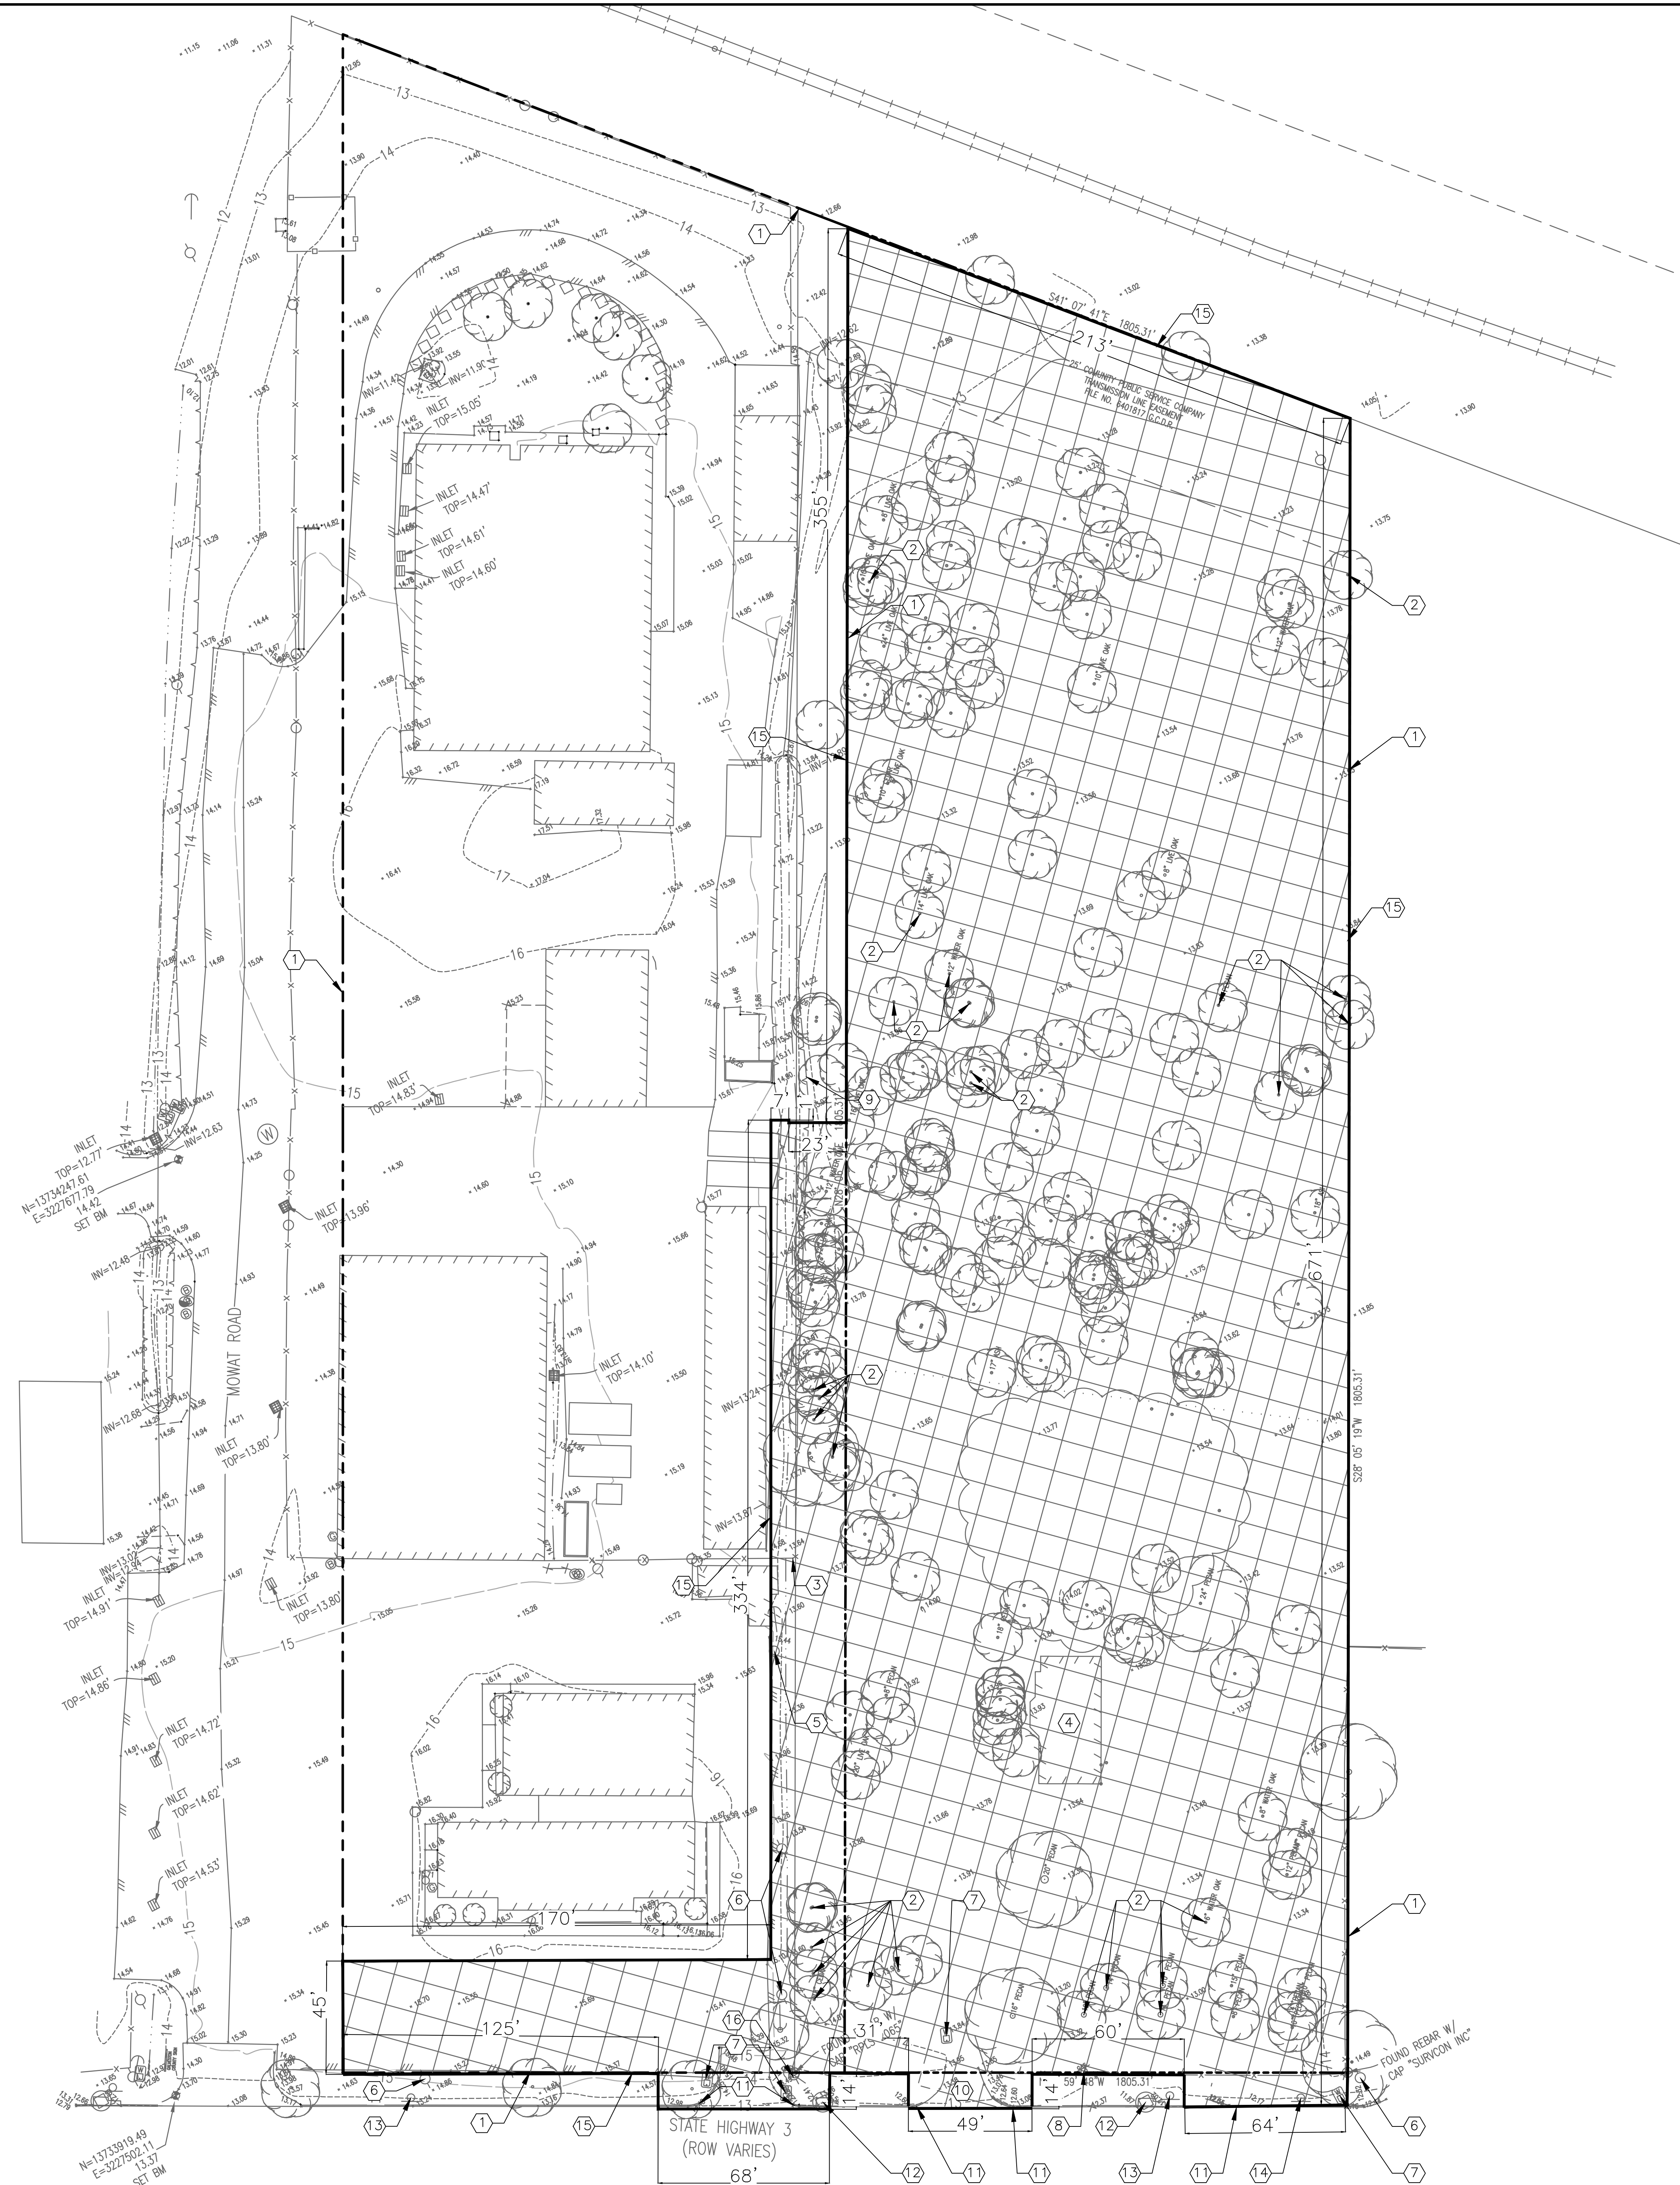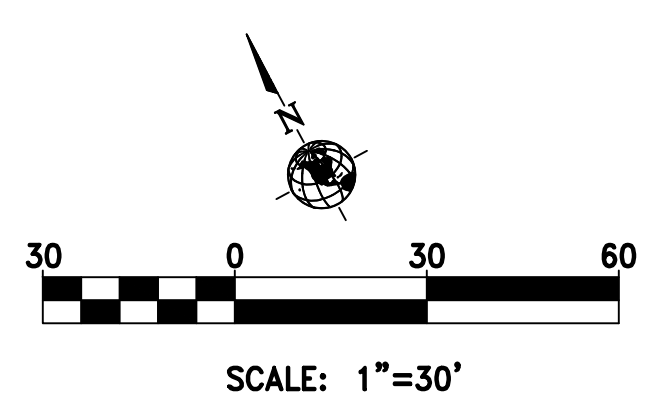

DEMOLITION NOTES TO CONTRACTOR

1. ALL ITEMS DESIGNATED TO BE REMOVE SHALL BECOME THE PROPERTY OF THE CONTRACTOR.
2. THE CONTRACTOR AND OWNER SHALL COORDINATE WITH CENTERPOINT FOR TERMINATION OF POWER AND GAS SERVICES TO THE SITE OR NEW SERVICES. THIS WORK WILL BE PROVIDED BY CENTERPOINT AND SHALL BE SCHEDULE AS ONE OF THE FIRST ITEMS OF BUSINESS.
3. THE CONTRACTOR SHALL BE PROVIDE AN APPROVED TRAFFIC CONTROL PLAN TO PERFORM ANY WORK PROPER SIGNAGE.
4. WHEN EXISTING SIDEWALK IS CLOSED FOR CONSTRUCTION, CONTRACTOR SHALL BARRICADE THAT AREA AND PROVIDE SAFE ALTERNATE PATH FOR PEDESTRIAN WITH PROPER SIGNAGE.
5. ALL TRAFFIC SIGNAGE WITHIN THE ROW SHALL BE PROTECTED INPLACE AT ALL TIMES. ANY DAMAGE TO THEN SHALL BE REPAIRED IMMEDIATELY. DURING THE CONSTRUCTION, SAFE OPERATION OF PEDESTRIAN OR VEHICULAR TRAFFIC, CONTRACTOR SHALL PROVIDE A CERTIFIED FLAGGER OR PEACE OFFICER UNTIL THAT SIGN IS RESTORED TO EXISTING CONDITION.
6. CONTRACTOR SHALL REPAIR ANY ITEMS DAMAGE DURING CONSTRUCTION TO ITS EXISTING CONDITION.
7. PRIOR TO ANY DEMOLITION WORK, THE CONTRACTOR SHALL LOCATED AS WELL CAPPED. ALL UTILITIES THAT ARE SHOWN SHALL BE LOCATED AS WELL AND CAPPED. ALL UTILITIES NOT SHOW SHALL BE LOCATED AS WELL CAPPED. UTILITIES THAT ARE SHOWN ON PLANS ARE APPROXIMATE LOCATION ONLY.
8. THE CONTRACTOR SHALL BE RESPONSIBLE FOR PROVIDING POSITIVE DRAINAGE ON SITE DURING ALL CONSTRUCTION ACTIVITIES.
9. THE CONTRACTOR SHALL ENTER & EXIT THE SITE THROUGH EXISTING DRIVEWAY.
10. CAUTION. THERE ARE OVERHEAD POWERLINES WITH IN THE WORK AREA. CONTRACTOR SHALL FOLLOW CITY, STATE, AND FEDERAL GUIDELINES WHEN WORKING AROUND EXISTING POWER LINES.
11. THE DEMOLITION AND REMAIN OF THE TREES WILL BE UNDER THE INDICATIONS OF THE PLANS OF LANDSCAPE. PLEASE CONFIRM WITH THE CITY.

DEMOLITION KEY NOTES


- ① PROPERTY LINE.
- ② EXISTING TREE TO REMAIN. PROTECT IN-PLACE.
- ③ EXISTING CHAINLINK FENCE TO BE REMOVED.
- ④ EXISTING BUILDING TO BE REMOVED.
- ⑤ EXISTING POWER POLE TO BE REMOVED.
- ⑥ EXISTING POWER POLE TO REMAIN. PROTECT IN-PLACE.
- ⑦ EXISTING WATER METER TO REMAIN OR TO BE REMOVED. PROTECT IN-PLACE. IN ACCORDING WITH OWNER/CITY FOR FURTHER INSTRUCTION.
- ⑧ EXISTING GAS MARKER TO REMAIN. PROTECT IN-PLACE.
- ⑨ EXISTING DITCH TO BE REMOVED.
- ⑩ EXISTING DRIVEWAY TO BE REMOVED.
- ⑪ EXISTING CURB TO BE REMOVED.
- ⑫ EXISTING INLET BB TO REMAIN. PROTECT IN-PLACE.
- ⑬ EXISTING TRAFFIC SIGN TO REMAIN. PROTECT IN-PLACE.
- ⑭ EXISTING TRAFFIC SIGN TO BE RELOCATED.
- ⑮ LIMITS OF DEMOLITION.
- ⑯ EXISTING POWER POLE TO BE RELOCATED.

DEMOLITION HATCH LEGEND



**ONE- CALL NOTIFICATION SYSTM
CALL BEFORE YOU DIG!!!**
(713) 223-4567 (in Houston, Tx)
(New Statwide Number Outside Houston)
1-800-545-6005

KEY PLAN (NOT TO SCALE)

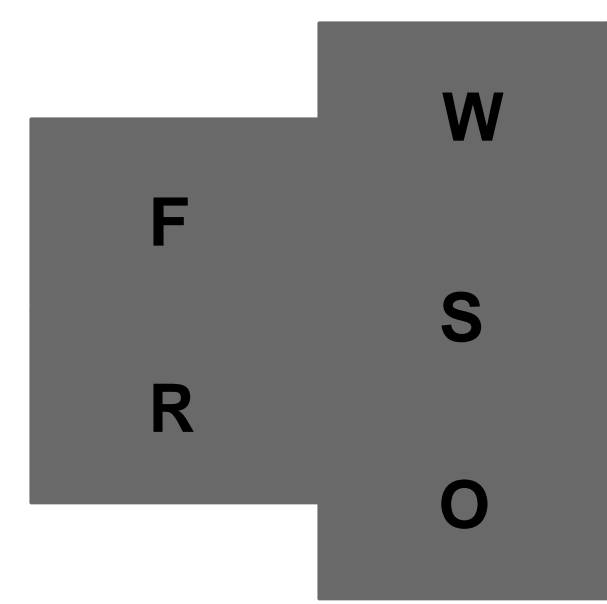

REVISION HISTORY		
ADDENDUM NO. 3	10-07-2020	



PROFESSIONAL SEAL

DEMOLITION PLAN


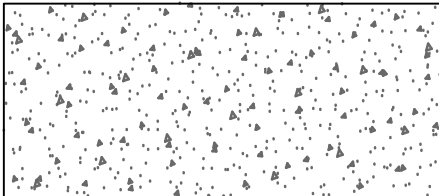
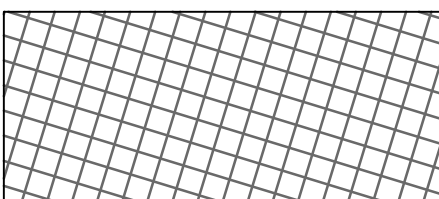
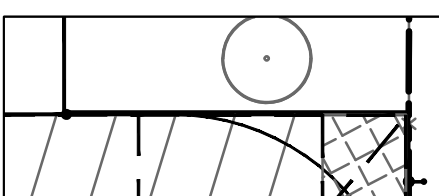

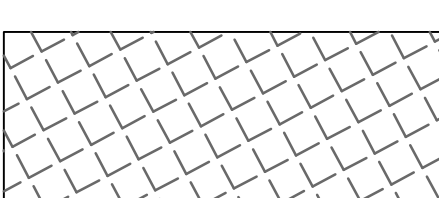

DRAWN BY JDM	CHECKED BY JDM
PROJECT NUMBER 478198	PROJECT ABBREVIATION GC_REB
ORIGINAL ISSUE DATE	DATE 07 OCT 2020

C3.0-PH1

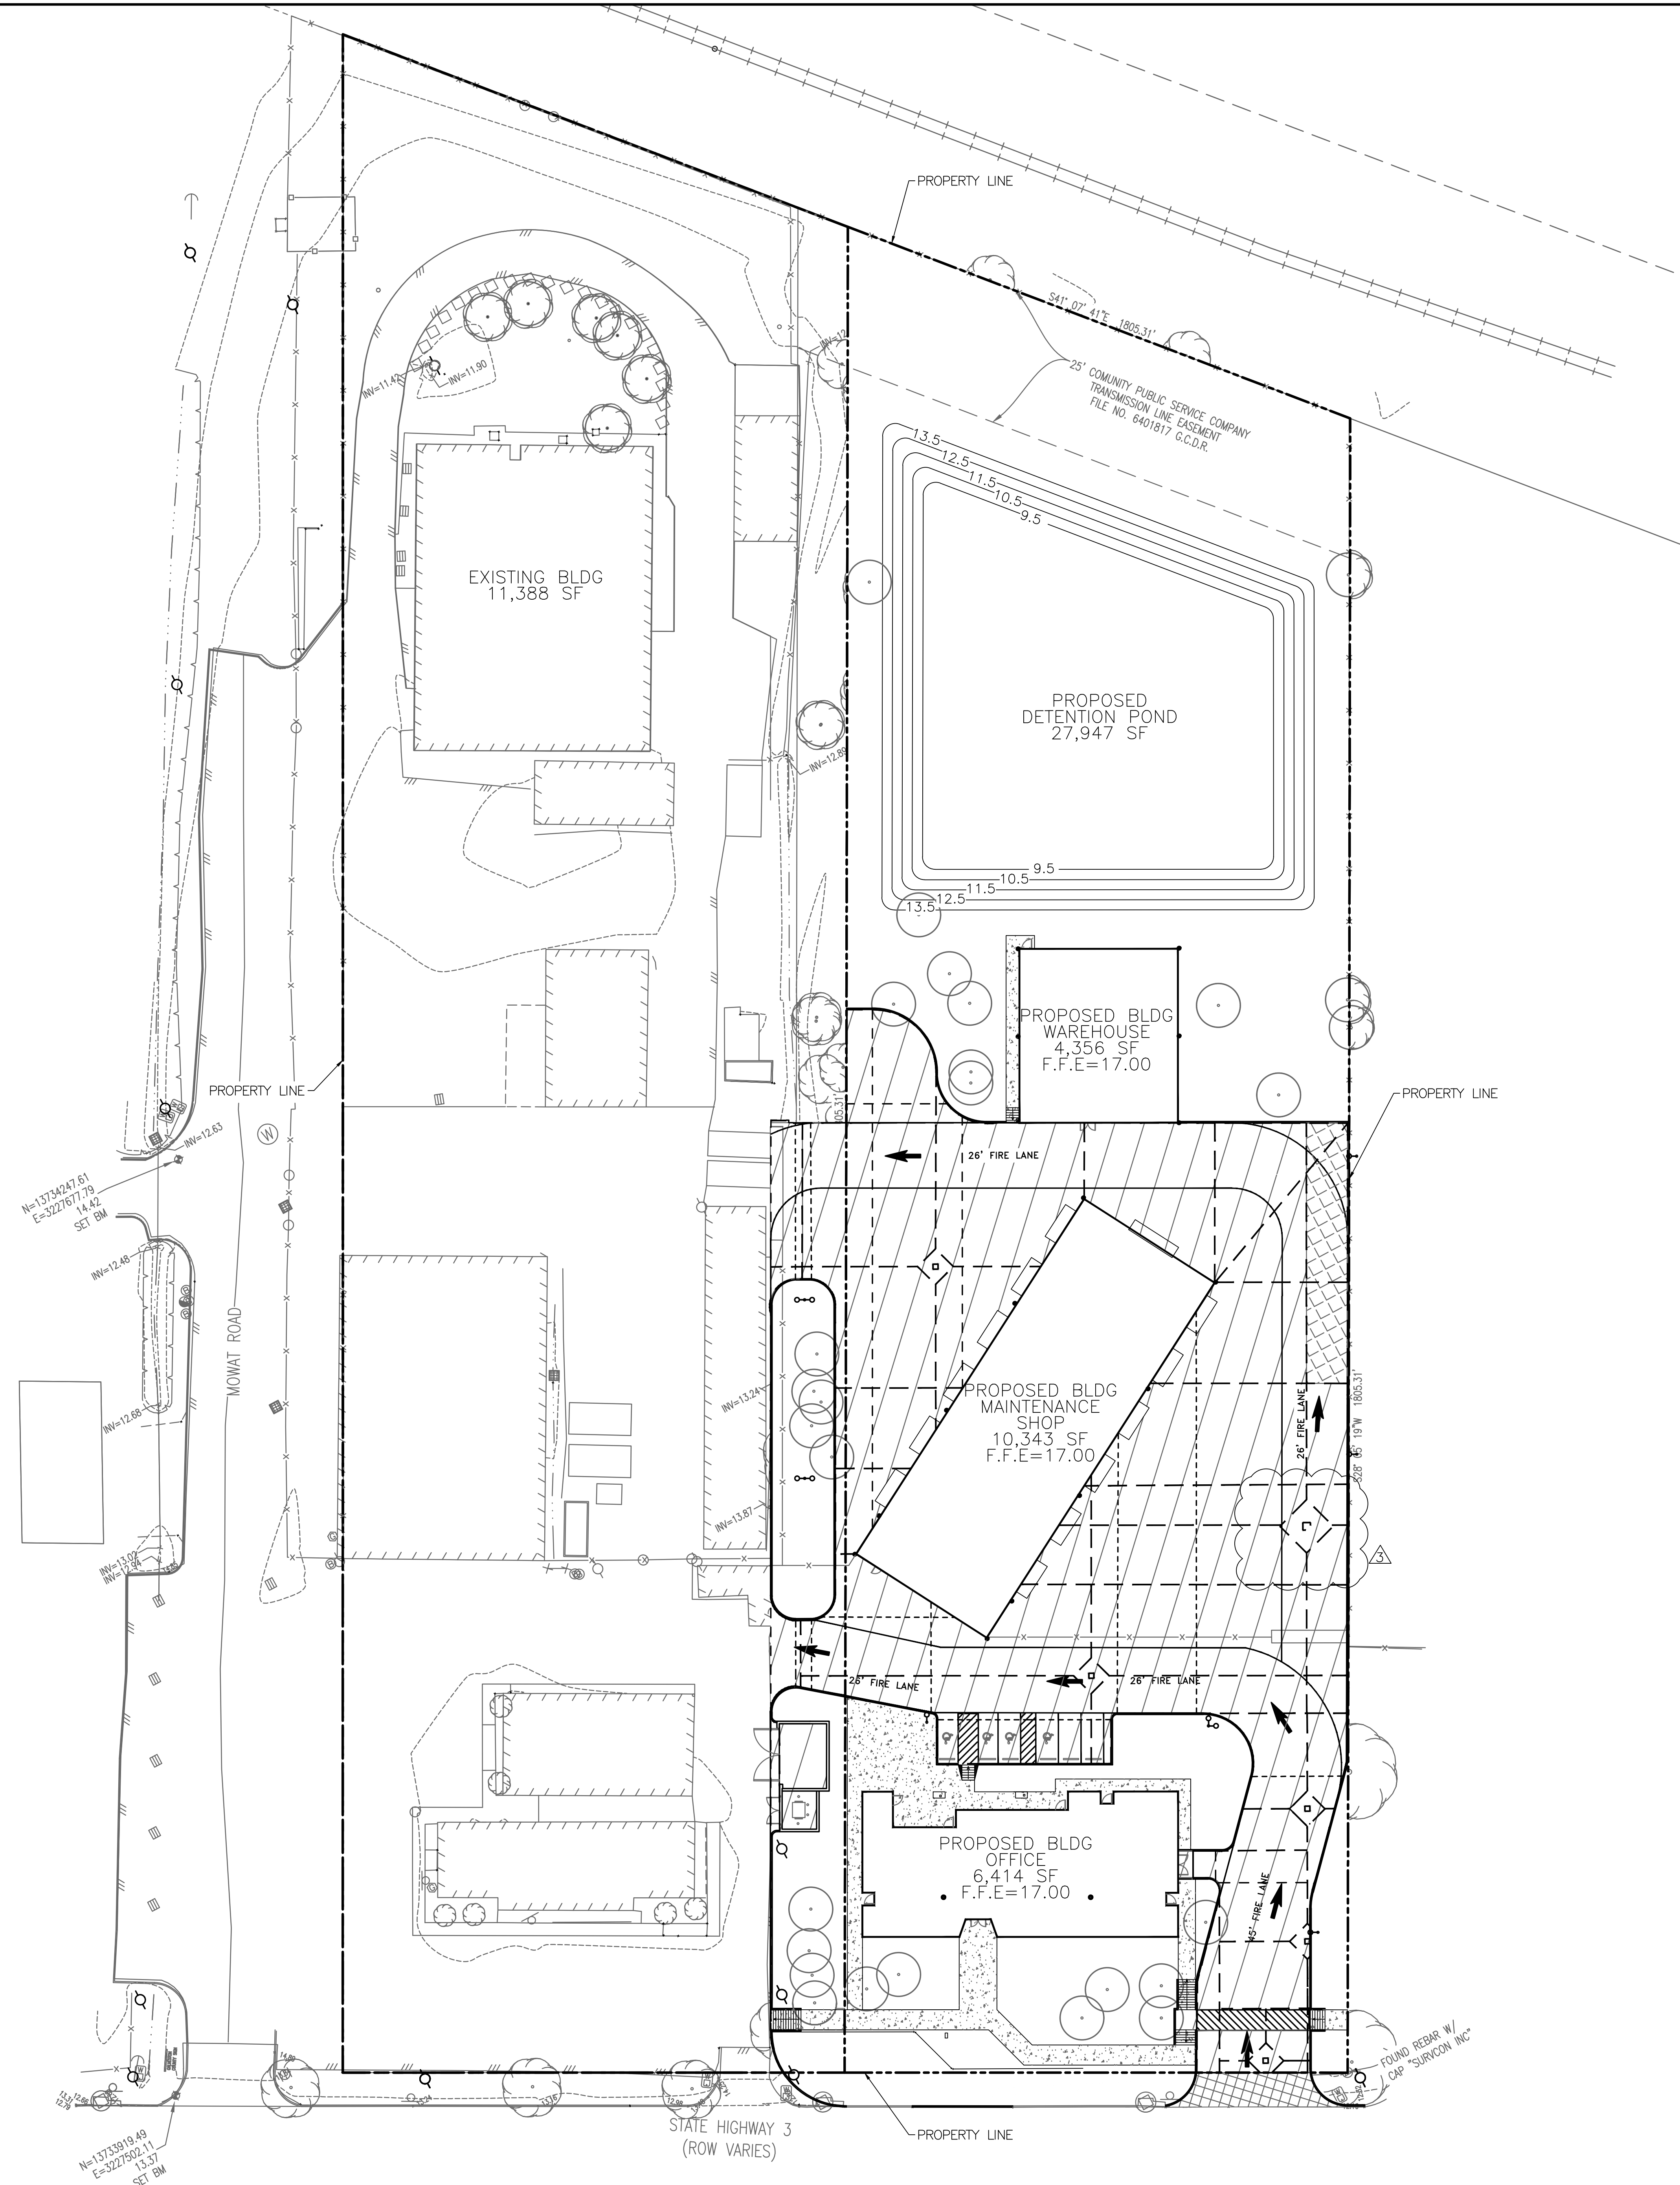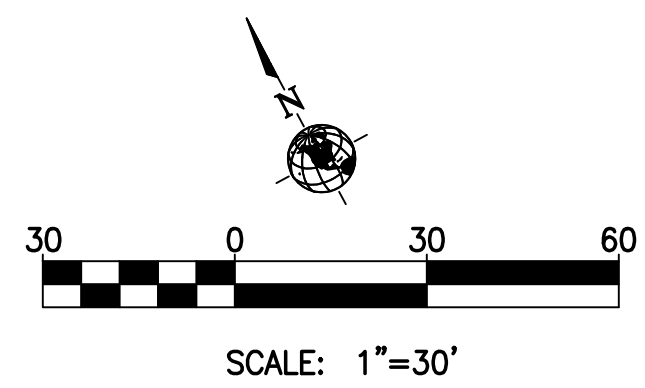



**Galveston County
Road & Bridge Department Facilities PH1**
5115 Texas Highway 3
Dickinson, TX



HATCH LEGEND:


-  6" THICK CONCRETE PAVING APPROX: 46,728 SQFT
RE: C-9.0 PAVEMENT DETAILS
-  4.5" THICK CONCRETE FOR SIDEWALK APPROX: 5,762 SQFT
RE: C-9.0 PAVEMENT DETAILS
-  6" THICK CONCRETE FOR DRIVEWAY APPROX: 707 SQFT
RE: C-9.0 PAVEMENT DETAILS
-  6" TALL CURB REF. SECTION
-  PROPOSED BUILDING LAYOUT
-  7" THICK CONCRETE PAVING APPROX: 1,699 SQFT
RE: C-9.0 PAVEMENT DETAILS
-  EXISTING PAVEMENT APPROX: 64,995 SQFT

LEGEND:

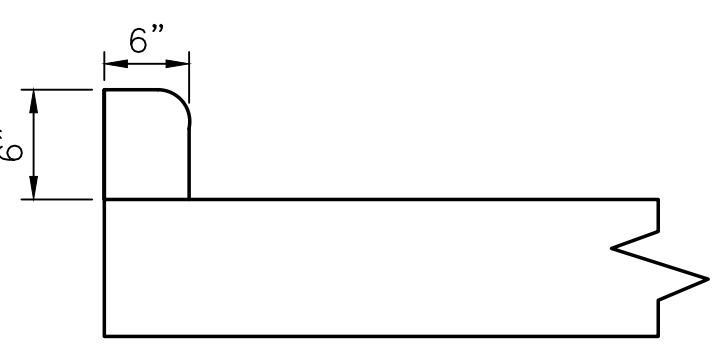-  PROPOSED SAWCUTTING JOINT
-  PROPOSED EXPANSION JOINT
-  *NOTE: SEE PAVING DETAILS FOR JOINT SECTIONS
-  6" CONCRETE CURB APPROX: 1,516 LF

**ONE - CALL NOTIFICATION SYSTM
CALL BEFORE YOU DIG!!!**
(713) 223-4567 (in Houston, Tx)
(New Statewide Number Outside Houston)
1-800-545-6005

KEY PLAN (NOT TO SCALE)

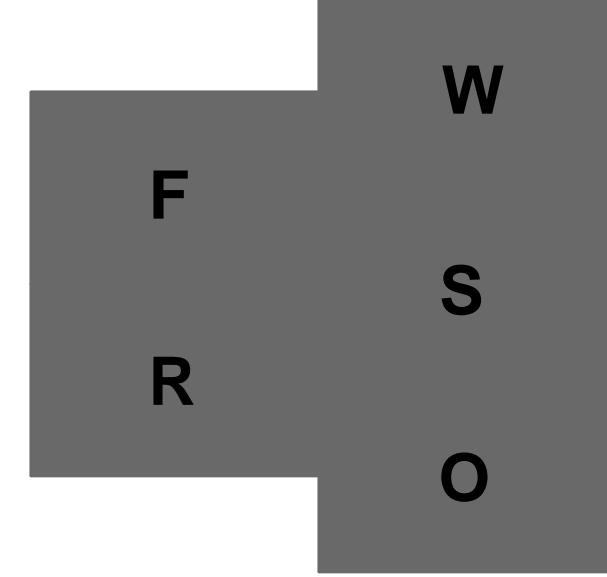


REVISION HISTORY		
ADDENDUM NO. 3	10-07-2020	

PROFESSIONAL SEAL

PAVING PLAN	
DRAWN BY JDM	CHECKED BY JDM
PROJECT NUMBER 418198	PROJECT ABBREVIATION GC_RBB
ORIGINAL ISSUE ISSUE FOR PERMIT	DATE 07 OCT 2020

C4.0-PH1
SHEET NUMBER

Galveston County
Road & Bridge Department Facilities PH1
5115 Texas Highway 3
Dickinson, TX

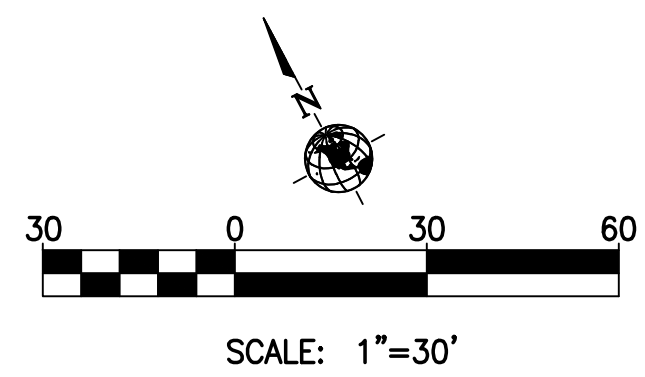

SITE LAYOUT NOTES

1. THE HORIZONTAL AND VERTICAL LOCATION OF EXISTING SUBSURFACE UTILITIES HAVE BEEN DETERMINED FROM DATA PROVIDED BY OTHERS. IT WILL BE THE RESPONSIBILITY OF THE CONTRACTOR TO PROTECT ALL EXISTING UTILITIES WITHIN THE AREA OF CONSTRUCTION THAT ARE TO REMAIN IN SERVICE. CONTRACTOR SHALL VERIFY SIZE AND LOCATION OF ALL UTILITIES PRIOR TO CONSTRUCTION.
2. ALL DIMENSIONS ARE FROM FACE OF CURB UNLESS OTHERWISE NOTED.
3. ALL DIMENSIONS ARE TO FACE OF BUILDING. REFER TO ARCHITECTURAL PLANS FOR BUILDING DIMENSIONS.
4. REFER TO ARCHITECTURAL PLANS FOR ALL STAIRS, HANDICAPPED RAMP AND RETAINING WALL DETAILS.
5. REFER TO LANDSCAPE ARCHITECT PLANS FOR DETAILS AND DIMENSIONS OF LANDSCAPE AND HARDSCAPE AREAS.

LAYOUT KEY NOTES

- ① PROPERTY LINE.
- ② PROPOSED 5" THICK CONCRETE SIDEWALK PER PAVEMENT DETAILS.
- ③ PROPOSED BUILDING PER STRUCTURAL AND ARCHITECTURAL DRAWINGS.
- ④ PROPOSED GATE BY OTHERS.
- ⑤ PROPOSED 4" YELLOW STRIPING PER PAVEMENT DETAILS TYP.
- ⑥ PROPOSED STORM DRAIN INLET TYPE "A" PER STORM DRAIN DETAILS.
- ⑦ PROPOSED JUNCTION BOX PER STORM DRAIN DETAILS.
- ⑧ PROPOSED ADA SYMBOL PER PAVEMENT DETAILS.
- ⑨ PROPOSED ADA RAMP PER PAVEMENT DETAILS.
- ⑩ PROPOSED LIGHT POLE; REFER TO MEP DRAWINGS FOR LAYOUT AND SPECIFICATIONS.
- ⑪ PROPOSED DETENTION POND. REFER TO DETENTION POND CROSS SECTIONS.
- ⑫ EXISTING TRAFFIC SIGN TO REMAIN. PROTECT IN-PLACE.
- ⑬ PROPOSED WHEEL STOP.
- ⑭ EXISTING POWER POLE TO REMAIN. PROTECT IN-PLACE.
- ⑮ PROPOSED DOOR PER PROPOSED BUILDING.
- ⑯ PROPOSED CHAIN - LINK FENCE
- ⑰ PROPOSED ACCESS RAMP
- ⑱ PROPOSED GENERATOR ENCLOSURE
- ⑲ PROPOSED DUMPSTER ENCLOSURE
- ⑳ PROPOSED 8" SQUARE DOWNSPOUT. REFER TO MEP DRAWINGS.
- ㉑ PROPOSED 8" SQUARE PREFINISHED METAL DOWNSPOUT. REFER TO ARCHITECTURAL DRAWINGS.
- ㉒ PROPOSED 7" THICK CONCRETE PAVING PER PAVEMENT DETAILS.
- ㉓ PROPOSED 6" CONCRETE CURB PER PAVEMENT DETAILS.


HATCH LEGEND

- CONSTRUCT 5" CONCRETE SIDEWALK ON PRIVATE AND PUBLIC PROPERTY OVER COMPACTED SUB-GRADE PER GEOTECHNICAL ENGINEER'S RECOMMENDATIONS
- PROPOSED BUILDING LAYOUT. CONTRACTOR SHALL REFER TO STRUCTURAL/ARCHITECTURAL PLANS TO BUILDING DIMENSIONS AND SPECIFICATIONS
- AREA NOT IN SCOPE
- CONSTRUCT 7" CONCRETE PAVEMENT ON PRIVATE AND PUBLIC PROPERTY OVER COMPACTED SUB-GRADE PER GEOTECHNICAL ENGINEER'S RECOMMENDATIONS

BUILDING CONTROL POINT		
Point	Northing	Eastng
A	13733982.67	3227842.01
B	13734064.71	3227988.32
C	13734010.92	3228018.47
D	13733928.85	3227872.18

**ONE- CALL NOTIFICATION SYSTM
CALL BEFORE YOU DIG!!!**
(713) 223-4567 (in Houston, Tx)
(New Statewide Number Outside Houston)
1-800-545-6005

KEY PLAN (NOT TO SCALE)

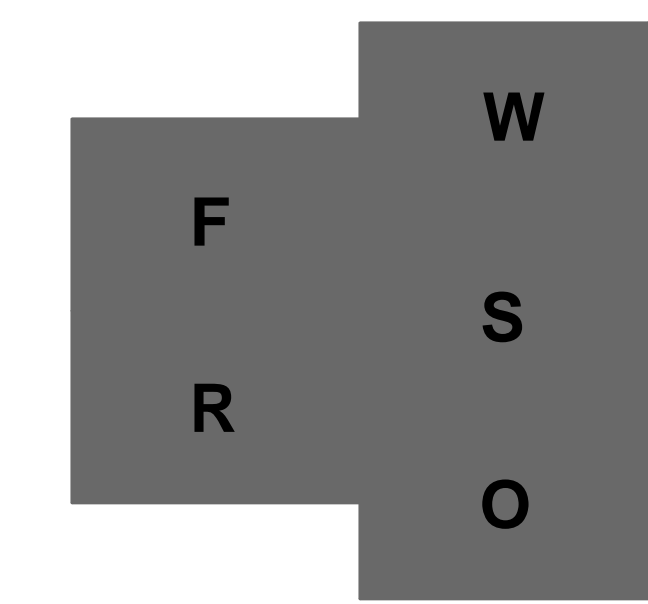


REVISION HISTORY		
REVISION	DESCRIPTION	DATE
ADDENDUM NO. 3		10-07-2020


PROFESSIONAL SEAL

LAYOUT PLAN

DRAWN BY JDM	CHECKED BY JDM
PROJECT NUMBER 418198	PROJECT ABBREVIATION GC_RBB
ORIGINAL ISSUE ISSUE FOR PERMIT	DATE 07 OCT 2020

C5.0-PH1
SHEET NUMBER

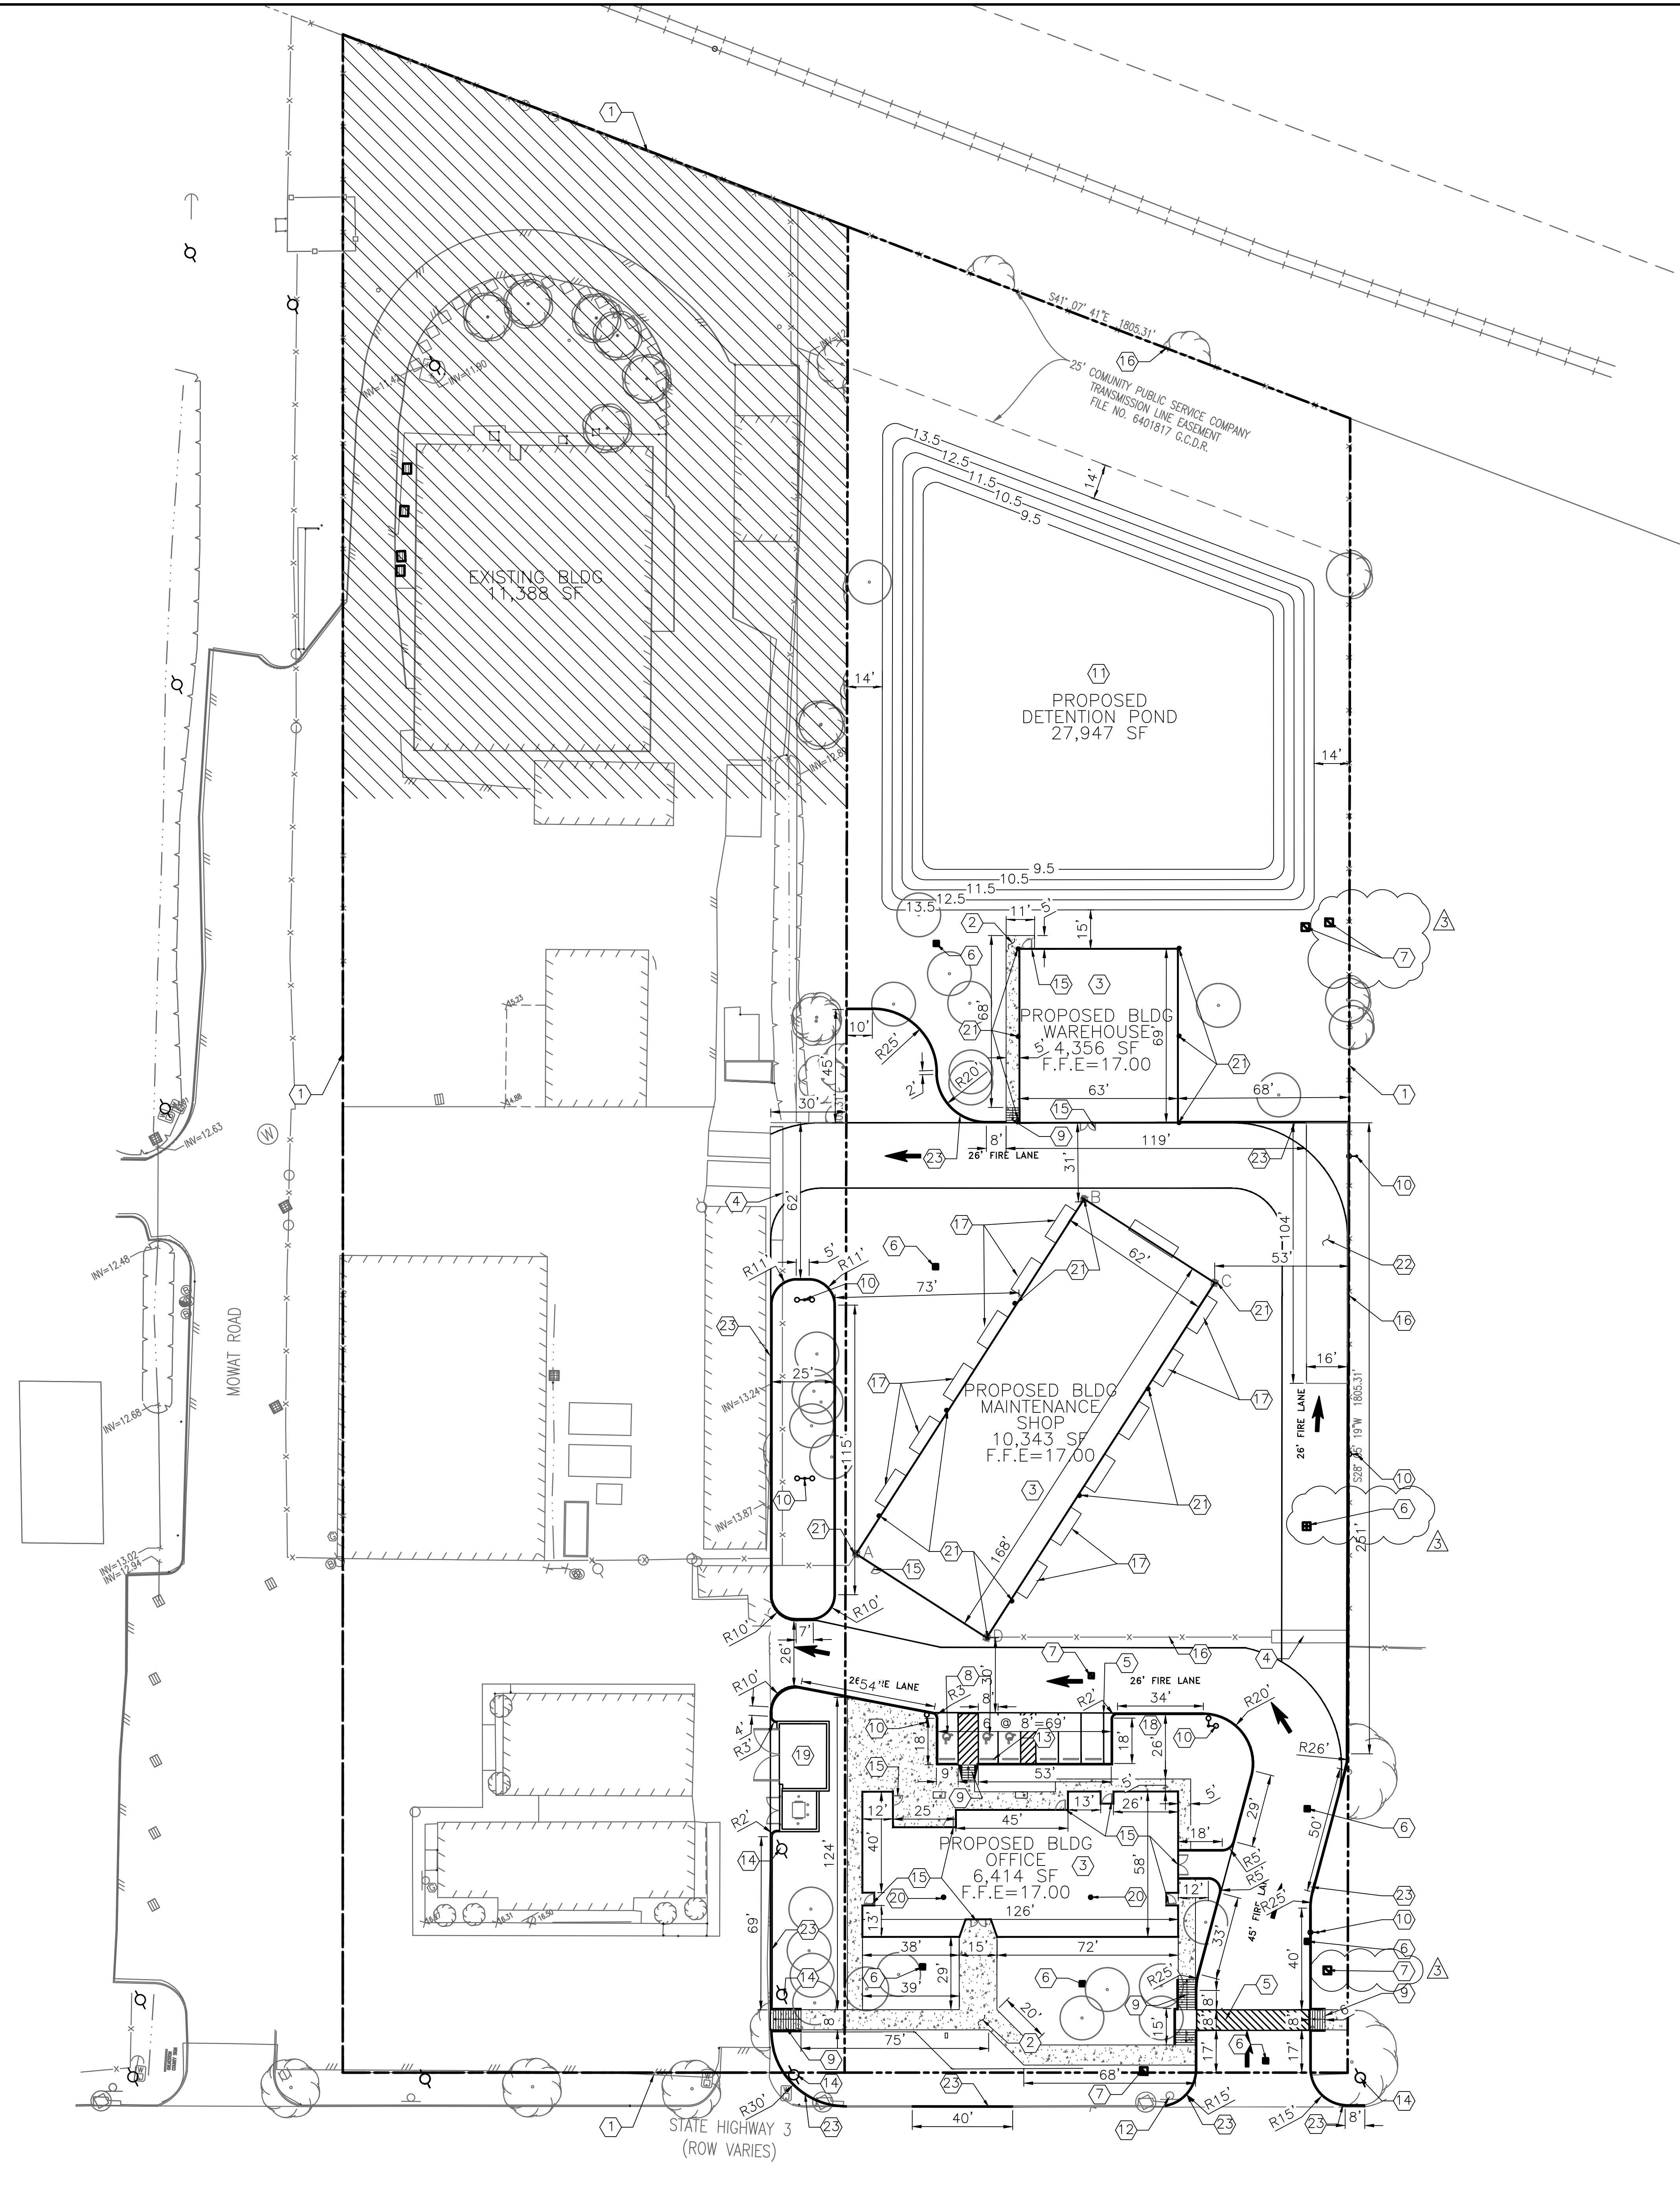

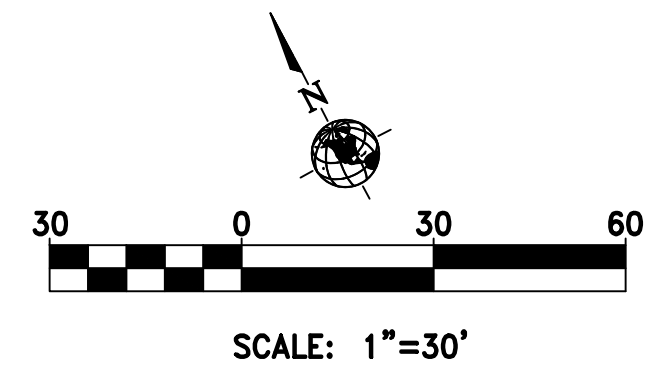

Page Southerland Page, Inc.
1100 Louisiana, Suite One
Houston, TX 77002
pagesp@pspi.com
TEL: 713.871.8484
FAX: 713.871.8440
ARCHITECTURE / ENGINEERING / INTERIORS / PLANNING / CONSULTING
Austin / Dallas / Denver / Dubai / Houston / Mexico City /
San Francisco / Washington DC / International Affiliate Offices

Civil Engineering Dally & Associates 9800 Richmond Avenue Suite 400 Houston, TX 77042 713.337.8881	Structural Engineering Dally & Associates 9800 Richmond Avenue Suite 400 Houston, TX 77042 713.337.8881
MEP Engineering Page 1100 Louisiana Suite One Houston, TX 77002 713.871.8484	Low Voltage & Security 4b Technology Group, LLC 390 Glenborough Dr. Suite 290 Houston, TX 77007 832.249.9379
Landscape Architecture Knudson, LP 8588 Katy Freeway Suite 441 Houston, TX 77024 713.463.8200	

Galveston County Road & Bridge Department Facilities PH1 5115 Texas Highway 3 Dickinson, TX

GRADING PLAN NOTES


1. REFER TO GEOTECHNICAL REPORT FOR ALL COMPACTION AND MOISTURE CONTENT REQUIREMENTS.
2. IT WILL BE THE RESPONSIBILITY OF THE CONTRACTOR TO PROTECT ALL MANHOLES, CLEANOUTS, VALVE BOXES, FIRE HYDRANTS, ECT. WITHIN THE AREA OF CONSTRUCTION THAT ARE TO REMAIN. THEY MUST BE ADJUSTED TO PROPER LINE AND GRADE BY THE CONTRACTOR PRIOR TO AND AFTER THE PLACING OF PAVING AND GRADING. AT NO ADDITIONAL COST TO THE OWNER.
- 3.
4. ALL INLETS AND MANHOLES SHALL MEET THE REQUIREMENTS OF THE LOCAL GOVERNING AGENCY.
5. SIDEWALKS SHALL HAVE A SLOPE NO GRATER THAN 5% AND A CROSS SLOPE NOT GRATER THAN 2%, UNLESS OTHERWISE.

ABBREVIATIONS

- TW TOP OF WALL
TP TOP OF PAVEMENT ELEVATION
TC TOP OF CURB ELEVATION
TG TOP OF GRATE ELEVATION (STORM DRAIN INLET)
FG FINISHED GRADE ELEVATION
FFE FINISHED FLOOR ELEVATION
BFE BASE FLOOD ELEVATION
FL FLOWLINE ELEVATION

HATCH LEGEND



- CONSTRUCT 5" CONCRETE SIDEWALK OVER COMPACTED SUB-GRADE PER GEOTECHNICAL ENGINEER'S RECOMMENDATIONS
- PROPOSED BUILDING LAYOUT.
- AREA NOT IN SCOPE

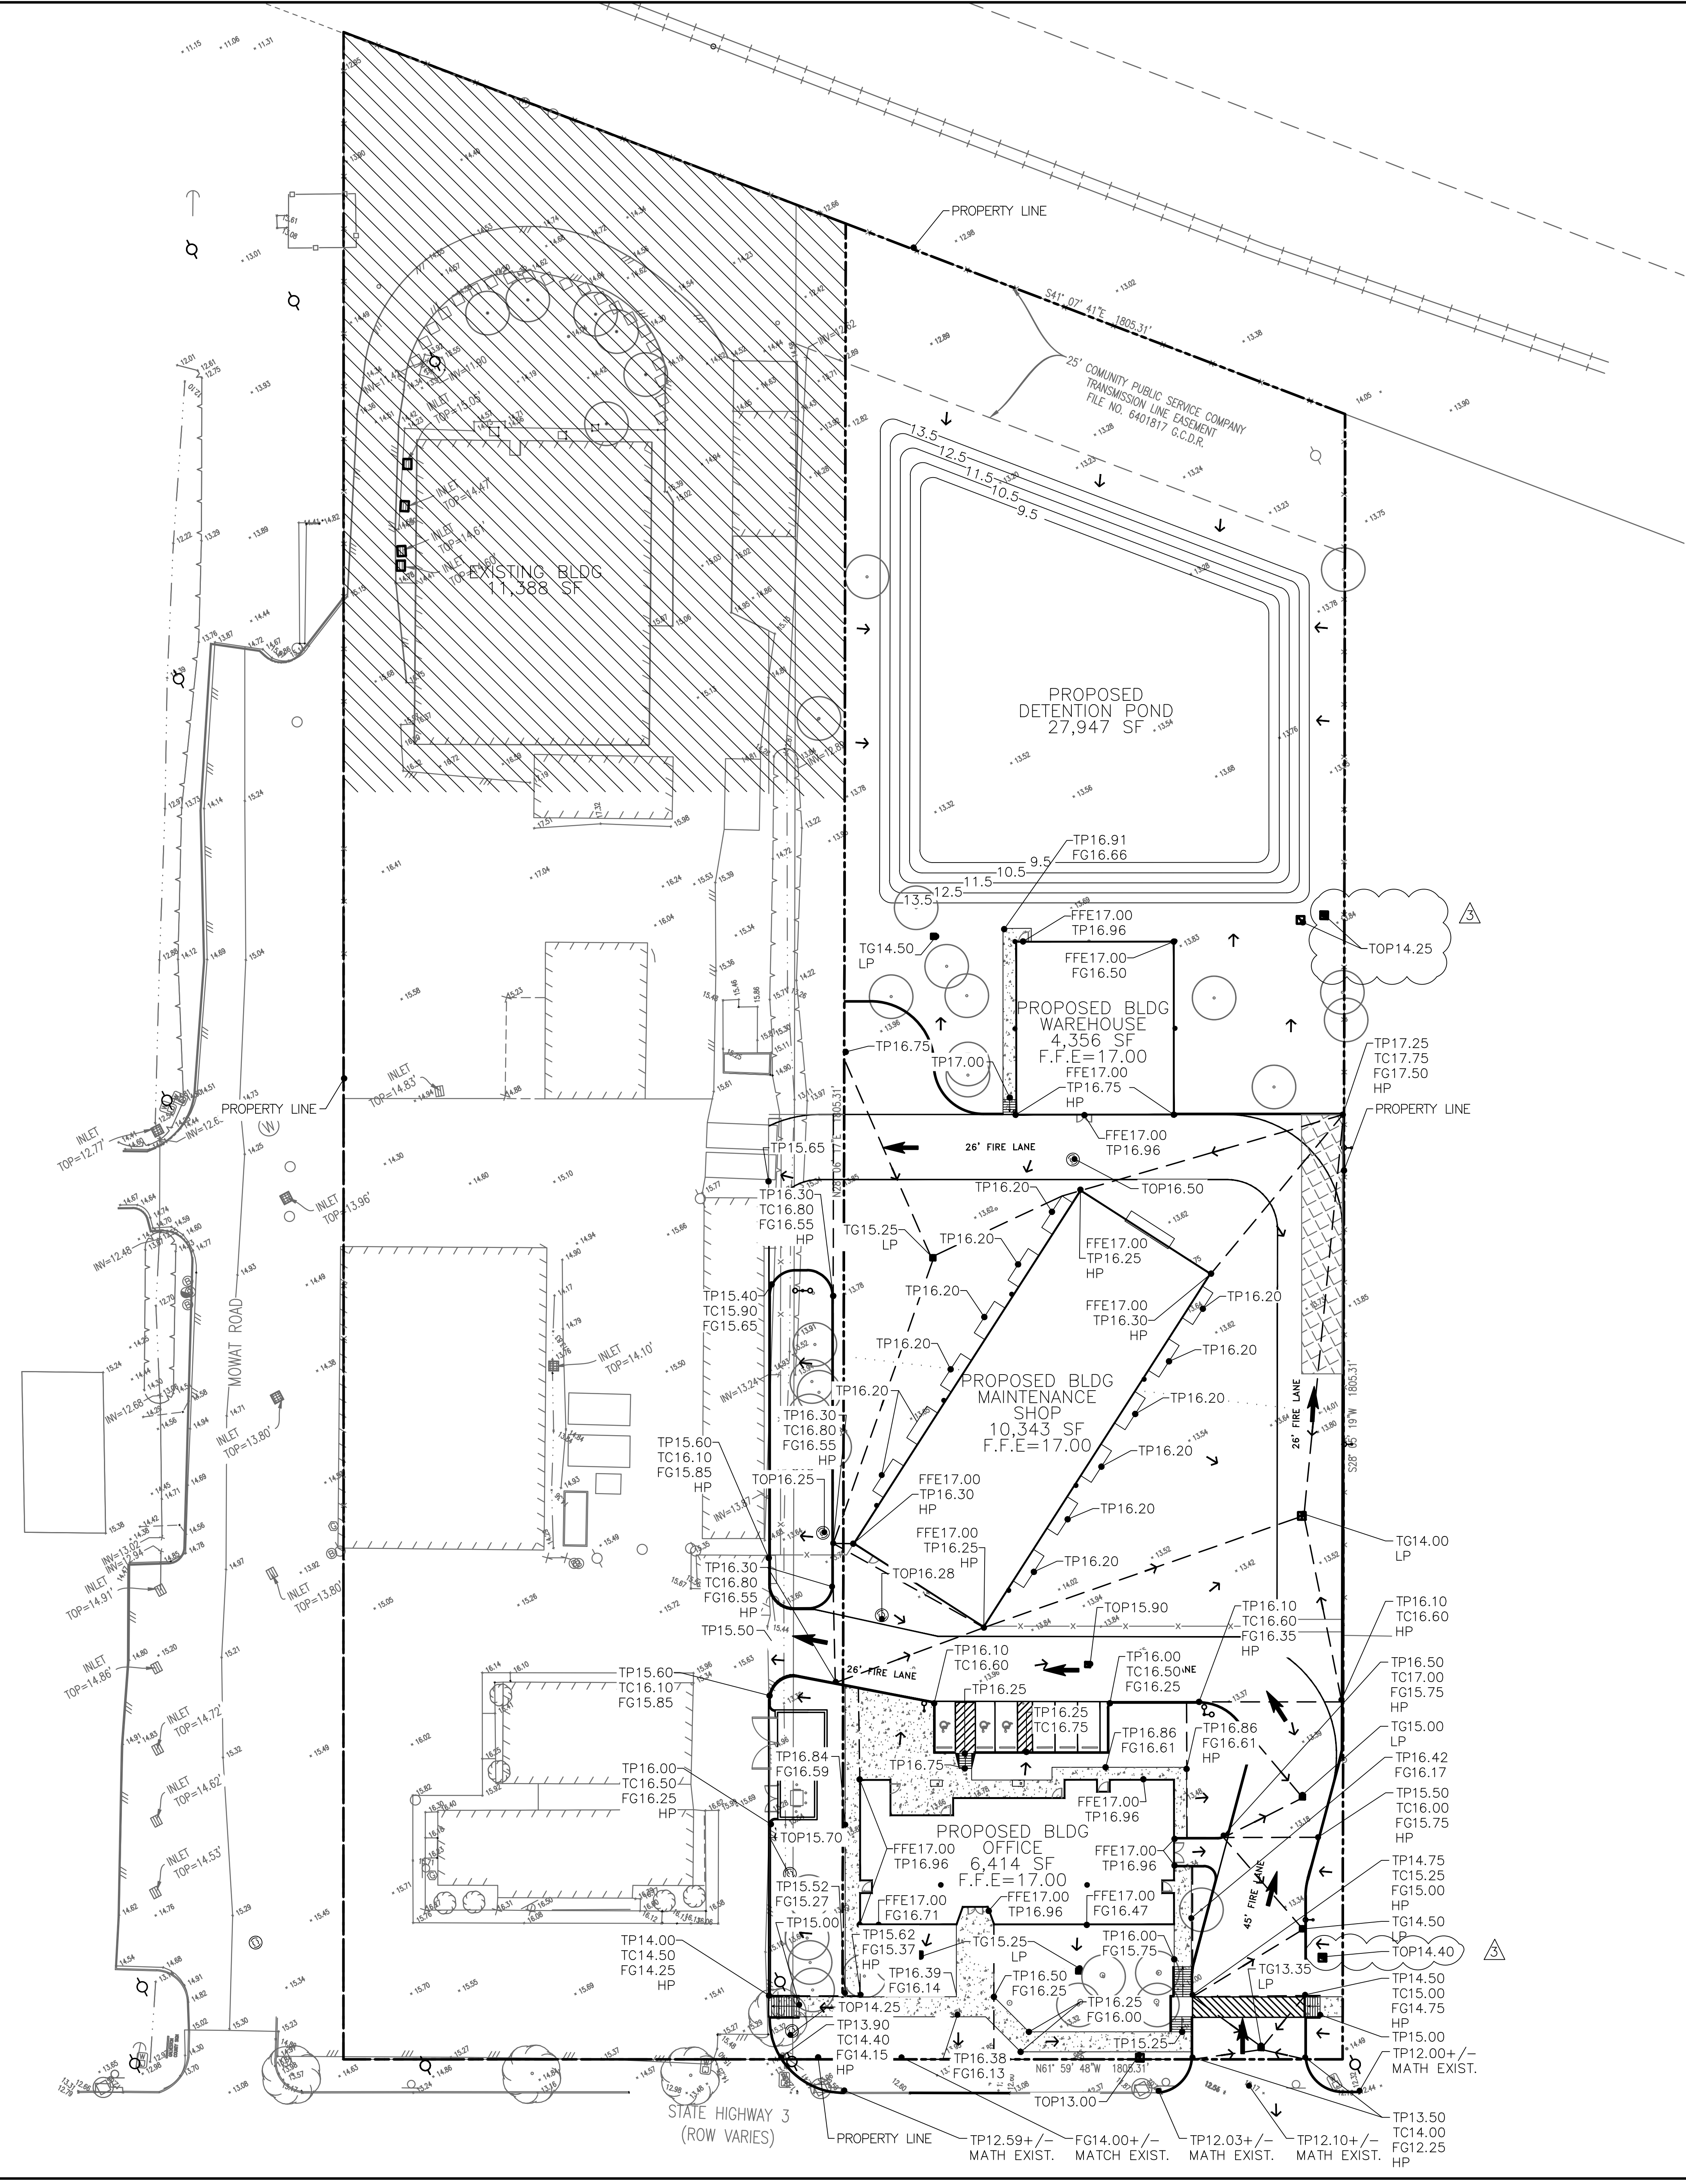


REVISION HISTORY		
NO.	DESCRIPTION	DATE
1	ADDENDUM NO. 3	10-07-2020

**ONE- CALL NOTIFICATION SYSTEM
CALL BEFORE YOU DIG!!!**
(713) 223-4567 (In Houston, TX)
(New Statewide Number Outside Houston)
1-800-545-6005

KEY PLAN (NOT TO SCALE)

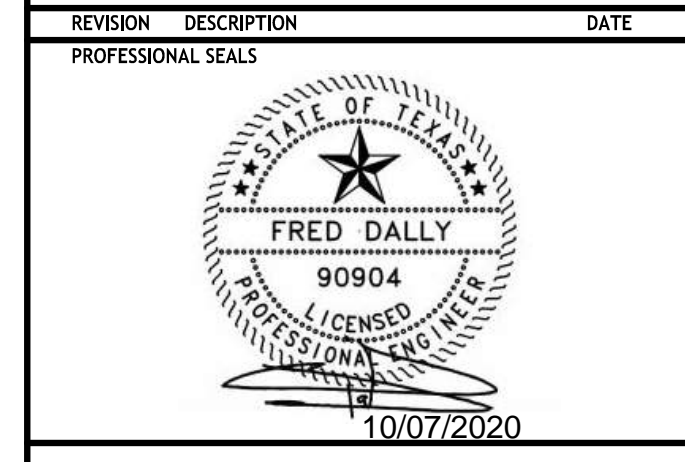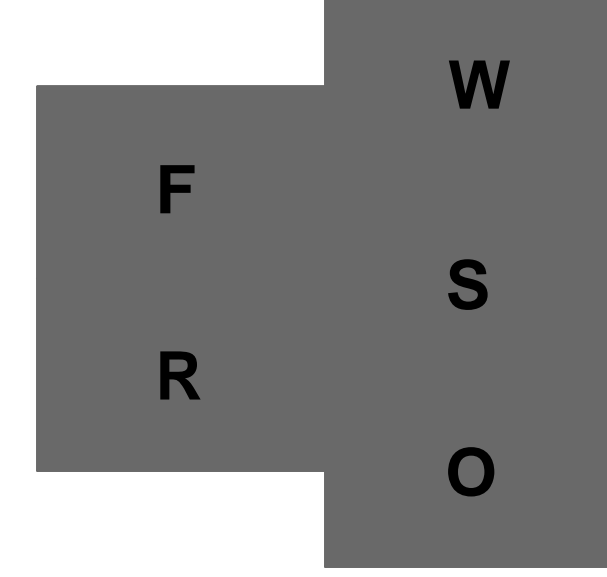

DRAWN BY JDM		CHECKED BY JDM	
PROJECT NUMBER 418198	PROJECT ABBREVIATION GC_R&B	DATE 07 OCT 2020	
ORIGINAL ISSUE	ISSUE FOR PERMIT		
<div style="border: 2px solid black; padding: 5px; display: inline-block;">C6.0-PH1</div>			
SHEET NUMBER			

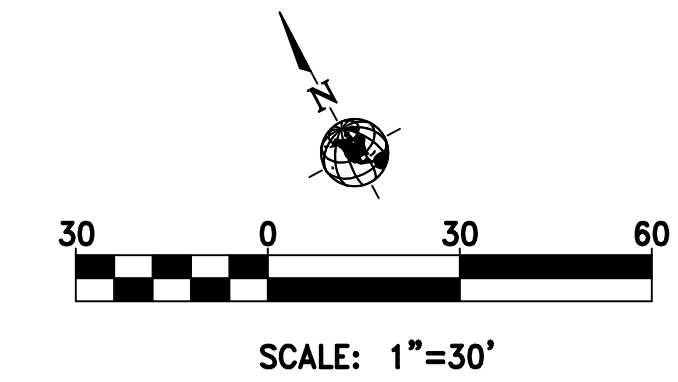

Page Southerland Page, Inc.
1100 Louisiana, Suite One
Houston, TX 77002
page@psp.com
Tel: 713.871.8484
Fax: 713.871.8440

ARCHITECTURE / ENGINEERING / INTERIORS / PLANNING / CONSULTING
Austin / Dallas / Denver / Dubai / Houston / Mexico City /
San Francisco / Washington DC / International Affiliate Offices

Civil Engineering
Daily & Associates
9800 Richmond Avenue
Suite 400
Houston, TX 77042
713.337.8881

Structural Engineering
Daily & Associates
9800 Richmond Avenue
Suite 400
Houston, TX 77042
713.337.8881

MEP Engineering
Page
1100 Louisiana
Suite One
Houston, TX 77002
713.871.8484

Low Voltage & Security
4b Technology Group, LLC
390 Glenborough Dr.
Suite 200
Houston, TX 77067
832.249.9379

Landscape Architecture
Knudson, LP
6588 Katy Freeway
Suite 441
Houston, TX 77024
713.463.8200


Galveston County
Road & Bridge Department Facilities PH1
5115 Texas Highway 3
Dickinson, TX

UTILITY PLAN NOTES

- REFER TO GEOTECHNICAL REPORT FOR ALL COMPACTION AND MOISTURE CONTENT REQUIREMENTS.
- IT WILL BE THE RESPONSIBILITY OF THE CONTRACTOR TO PROTECT ALL MANHOLES, CLEANOUTS, VALVE BOXES, FIRE HYDRANTS, ECT. WITHIN THE AREA OF CONSTRUCTION THAT ARE TO REMAIN. THEY MUST BE ADJUSTED TO PROPER LINE AND GRADE BY THE CONTRACTOR PRIOR TO AND AFTER THE PLACING OF PAVING AND GRADING. AT NO ADDITIONAL COST TO THE OWNER.
- ALL INLETS AND MANHOLES SHALL MEET THE REQUIREMENTS OF THE LOCAL GOVERNING AGENCY.
- ALL ROOF DRAINS ARE 4" TYP. REFER TO ARCHITECTURAL DRAWINGS FOR DETAILS.
- SIDEWALKS SHALL HAVE A SLOPE NO GRATER THAN 5% AND A CROSS SLOPE NOT GRATER THAN 2%, UNLESS OTHERWISE NOTED.


HATCH LEGEND

- CONSTRUCT 5" CONCRETE SIDEWALK OVER COMPACTED SUB-GRADE PER GEOTECHNICAL ENGINEER'S RECOMMENDATIONS
- PROPOSED BUILDING LAYOUT.
- AREA NOT IN SCOPE

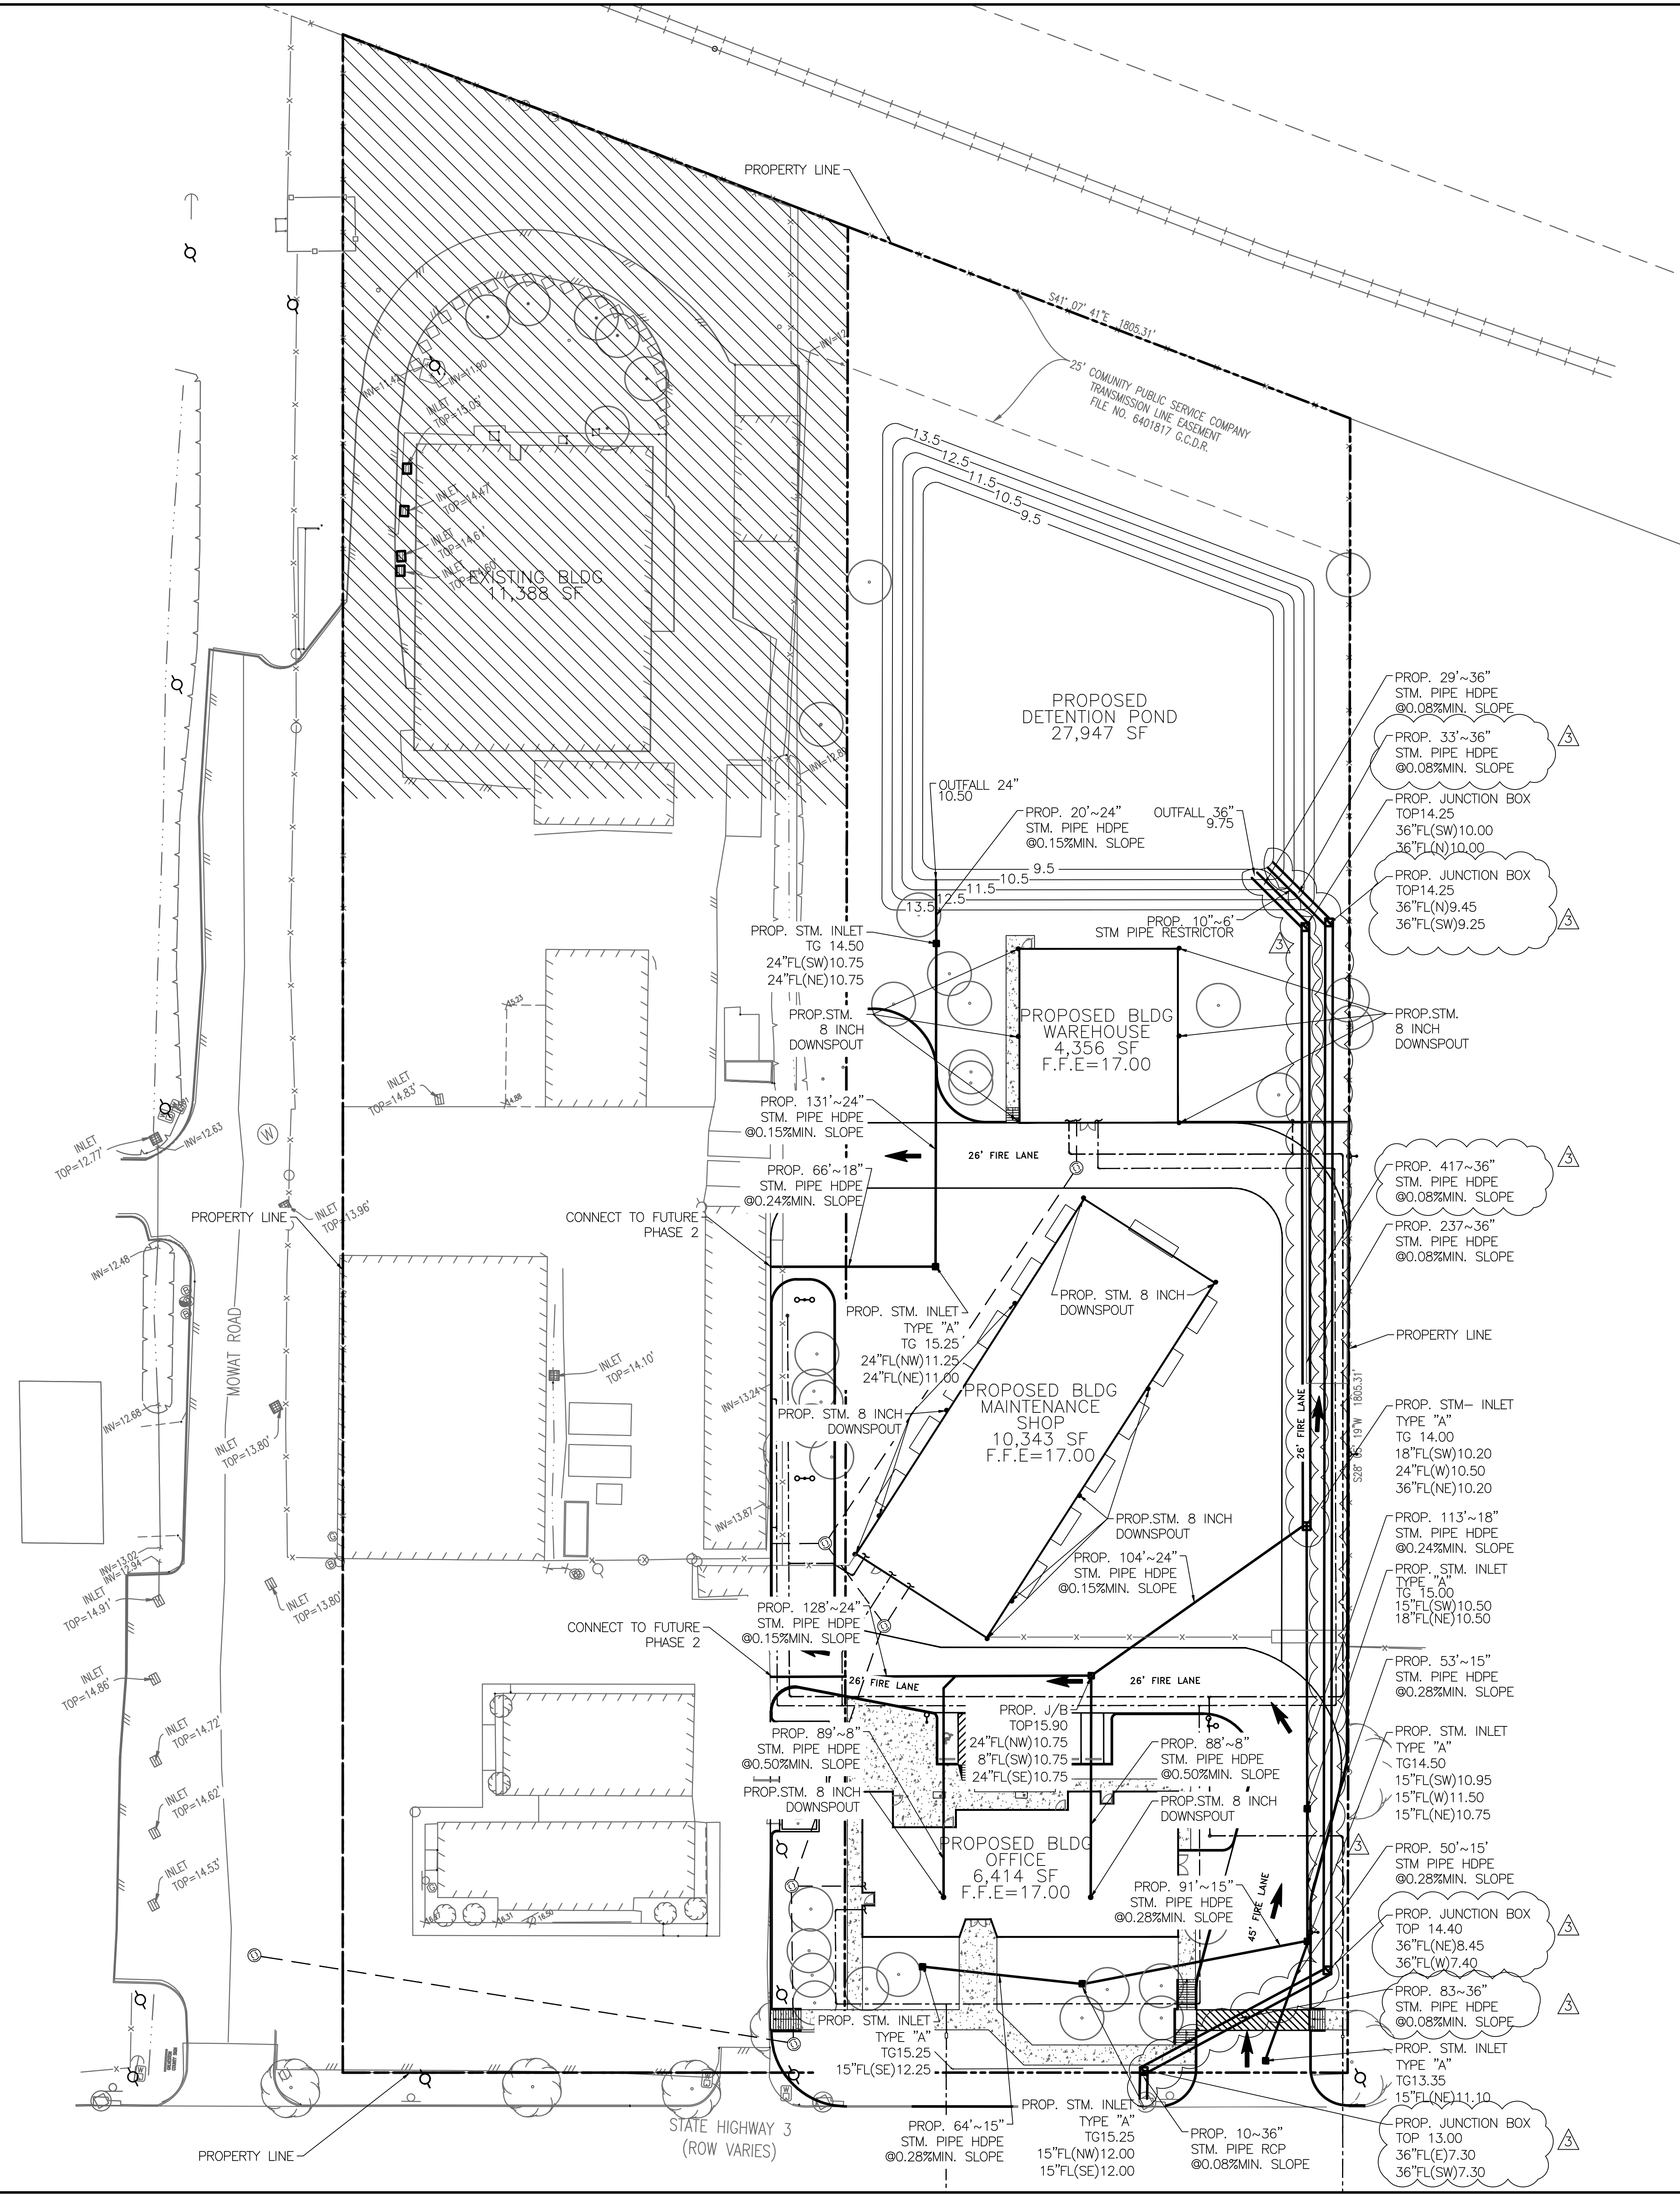

ONE - CALL NOTIFICATION SYSTM
CALL BEFORE YOU DIG!!!
(713) 223-4567 (in Houston, Tx)
(New Statewide Number Outside Houston)
1-800-545-6005


KEY PLAN (NOT TO SCALE)

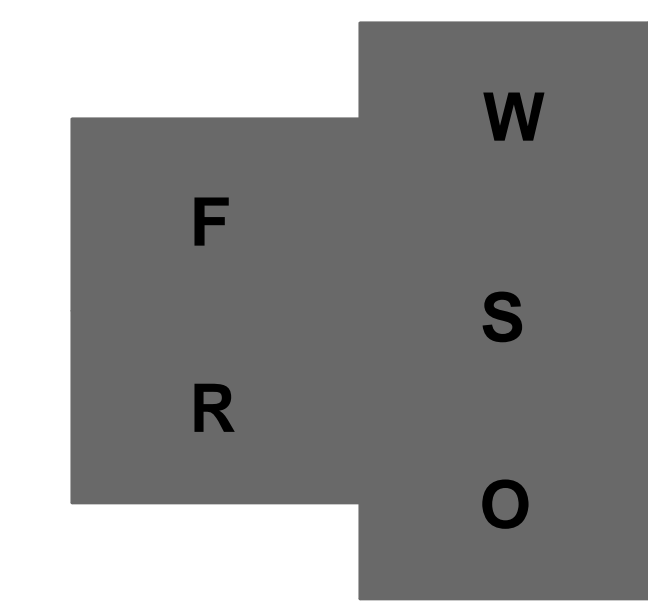

REVISION HISTORY		
ADDENDUM NO. 3	10-07-2020	

PROFESSIONAL SEAL

UTILITY PLAN	
DRAWN BY JDM	CHECKED BY JDM
PROJECT NUMBER 418198	PROJECT ABBREVIATION GC_RBB
ORIGINAL ISSUE ISSUE FOR PERMIT	DATE 07 OCT 2020
C7.0-PH1	
SHEET NUMBER	

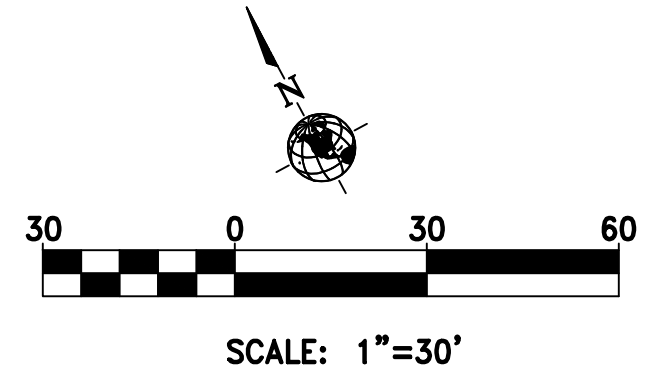


Galveston County
Road & Bridge Department Facilities PH1
5115 Texas Highway 3
Dickinson, TX

UTILITY PLAN NOTES

1. REFER TO GEOTECHNICAL REPORT FOR ALL COMPACTION AND MOISTURE CONTENT REQUIREMENTS.
2. IT WILL BE THE RESPONSIBILITY OF THE CONTRACTOR TO PROTECT ALL MANHOLES, CLEANOUTS, VALVE BOXES, FIRE HYDRANTS, ECT. WITHIN THE AREA OF CONSTRUCTION THAT ARE TO REMAIN. THEY MUST BE ADJUSTED TO PROPER LINE AND GRADE BY THE CONTRACTOR PRIOR TO AND AFTER THE PLACING OF PAVING AND GRADING. AT NO ADDITIONAL COST TO THE OWNER.
3. ALL INLETS AND MANHOLES SHALL MEET THE REQUIREMENTS OF THE LOCAL GOVERNING AGENCY.
4. ALL ROOF DRAINS ARE 4" TYP. REFER TO ARCHITECTURAL DRAWINGS FOR DETAILS.
5. SIDEWALKS SHALL HAVE A SLOPE NO GRATER THAN 5% AND A CROSS SLOPE NOT GRATER THAN 2%, UNLESS OTHERWISE NOTED.


HATCH LEGEND

- CONSTRUCT 5" CONCRETE SIDEWALK OVER COMPACTED SUB-GRADE PER GEOTECHNICAL ENGINEER'S RECOMMENDATIONS
- PROPOSED BUILDING LAYOUT.
- AREA NOT IN SCOPE

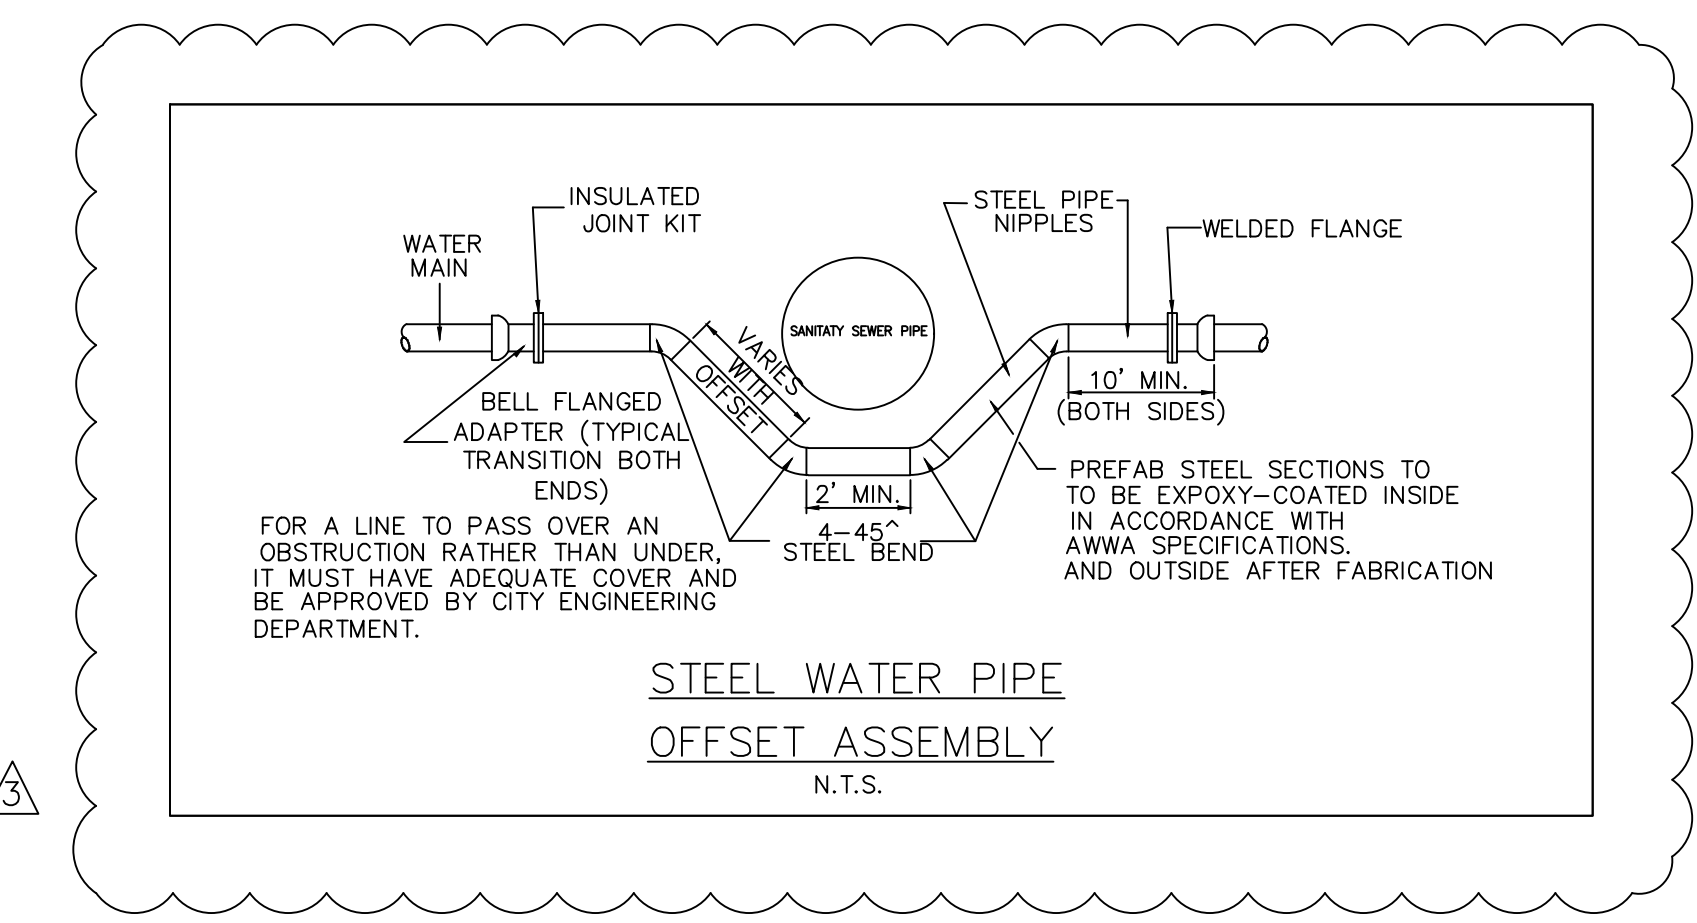

ONE - CALL NOTIFICATION SYSTM
CALL BEFORE YOU DIG!!!
(713) 223-4567 (in Houston, Tx)
(New Statewide Number Outside Houston)
1-800-545-6005

KEY PLAN (NOT TO SCALE)

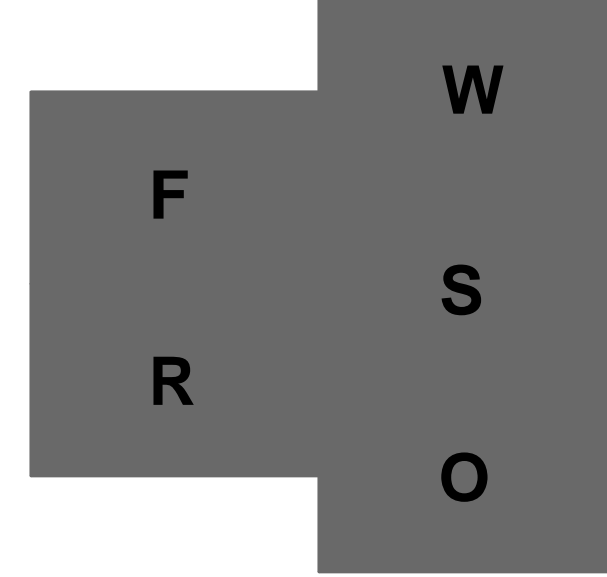

REVISION HISTORY	
NO.	DESCRIPTION
1	ADDENDUM NO. 3 10-07-2020

PROFESSIONAL SEAL

FRED DALLY
90904
10/07/2020

UTILITY PLAN	
DRAWN BY	CHECKED BY
JDM	JDM
PROJECT NUMBER 418198	PROJECT ABBREVIATION GC_RBB
ORIGINAL ISSUE DATE 07 OCT 2020	DATE

C7.1-PH1
SHEET NUMBER

FILE PATH
C:\Users\jdm\OneDrive\Documents\418198\07-2020\08-2020\PH1\PH1-01.dwg
DATE PLOTTED: 07/26/2020 2:02:08 PM

Page Southerland Page, Inc.
1100 Louisiana, Suite One
Houston, TX 77002
page@hik.com

Tel: 713 871 8484
Fax: 713 871 8440

ARCHITECTURE / INTERIORS / RESTORATION / PLANNING / CONSULTING
Austin / Dallas / Denver / Dubai / Houston / Mexico City /
San Francisco / Washington DC / International Affiliate Offices

Civil Engineering
Daily & Associates
9800 Richmond Avenue
Suite 400
Houston, TX 77042
713 337 8881

Structural Engineering
Daily & Associates
9800 Richmond Avenue
Suite 400
Houston, TX 77042
713 337 8881

MEP Engineering
Page
1100 Louisiana
Suite One
Houston, TX 77002
713 871 8484

Low Voltage & Security
4b Technology Group, LLC
390 Glenborough Dr.
Suite 290
Houston, TX 77067
832 249 9379

Landscape Architecture
Knudson, LP
6588 Katy Freeway
Suite 411
Houston, TX 77024
713 463 8200

Galveston County
Road & Bridge Department Facilities PH1
5115 Texas Highway 3
Dickinson, TX

A. GENERAL CONSTRUCTION NOTES:

- 1. CONTRACTOR SHALL FIELD VERIFY EXISTING CONDITIONS BEFORE BEGINNING CONSTRUCTION.
2. CONTRACTOR SHALL BE RESPONSIBLE FOR PROVIDING REQUIRED SECURITY TO PROTECT HIS OWN PROPERTY, EQUIPMENT AND WORK IN PROGRESS.
3. CONTRACTOR IS RESPONSIBLE FOR CLEANING OF STREETS CAUSED BY ASSOCIATED CONSTRUCTION AT CLOSE OF EACH WORK DAY.
4. PAVED SURFACES SHALL BE PROTECTED FROM DAMAGE BY TRACKED EQUIPMENT.
5. CONTRACTOR WILL PAY ALL COST TO REPLACE IRON RODS OR OTHER LAND BOUNDARY MARKERS DISTURBED DURING CONSTRUCTION. A REGISTERED LAND SURVEYOR WILL BE USED TO RESET DISTURBED BOUNDARY MARKERS.
6. THE CONTRACTOR SHALL BE RESPONSIBLE FOR MAINTAINING AN UPDATE REDLINED "RECORD" SET OF CONSTRUCTION DRAWINGS ON SITE FOR INSPECTION BY THE ENGINEER.
7. CONTRACTOR SHALL PROVIDE ORANGE FENCING OR BARRICADES TO PROTECT PEDESTRIANS FROM ENTERING WORK AREAS.
8. CONTRACTOR MUST PROVIDE FENCING AROUND OPEN EXCAVATIONS AREA AT ALL TIMES.
9. REFER TO THE SWPPP GENERAL NOTES FOR PROPER MEASURES AND CONTROLS.

B. PAVEMENT

- 1. EXISTING PAVEMENTS, CURBS, SIDEWALKS, AND DRIVEWAYS DAMAGE OR REMOVED DURING CONSTRUCTION SHALL BE REPLACED TO ORIGINAL CONDITION OR BETTER, IN ACCORDANCE WITH THE GOVERNMENT AGENCY HAVING JURISDICTION.
2. THE SUBGRADE SHALL BE BROUGHT TO THE LINES AND GRADES AS SHOWN ON THE DRAWINGS.
3. WHENEVER UNSUITABLE MATERIAL IS ENCOUNTERED AND CANNOT BE HANDLED BY THE EXCAVATION OR EMBANKMENT REQUIREMENTS, THEN THE UNSUITABLE MATERIAL SHALL BE EXCAVATED TO A DEPTH DEEMED SUFFICIENT BY THE ENGINEER AND THE EXCAVATED MATERIAL SHALL BE DISPOSED OF OFF THE JOB SITE. THE EXCAVATED AREA SHALL BE FILLED WITH SELECT FILL PER STANDARDS OF THE GOVERNMENT AGENCY HAVING JURISDICTION.
4. SURPLUS EXCAVATED EARTHEN MATERIAL BECOMES THE PROPERTY OF THE CONTRACTOR AND SHALL BE REMOVED AND DISPOSED OF OFF-SITE. INCLUDE COST OF REMOVAL AND DISPOSAL IN OTHER ITEMS OF WHICH THIS WORK IS A COMPONENT PART. NO SEPARATE PAY. THE MATERIAL MUST BE DISPOSED OF IN A SAFE AND LEGAL MANNER.
5. EXISTING WATER VALVES AND MANHOLES SHALL BE ADJUSTED, AS NECESSARY TO MATCH TOP OF PROPOSED PAVEMENT ELEVATION.

C. SANITARY SEWER, STORM SEWER & DRAINAGE

- 1. ADEQUATE DRAINAGE SHALL BE MAINTAINED AT ALL TIMES DURING CONSTRUCTION.
2. ANY CURB DISTURBED DURING CONSTRUCTION SHALL BE RESTORED TO THE SATISFACTION OF THE ENGINEER OR OWNING AUTHORITY.
3. CONTRACTOR'S ACTIVITIES SHALL HAVE NO EFFECT TO FLOWS TO AND FROM OFF SITE AREAS EXISTING SHEET DRAINAGE SHALL NOT BE IMPEDED BY PROPOSED CONSTRUCTION.
4. WHERE MANHOLES ARE LOCATED WITHIN PAVED AREAS, CONTRACTOR SHALL SET RIM ELEVATIONS TO MATCH FINISHED GRADE ELEVATIONS. OUTSIDE OF PAVED AREAS, SET MANHOLE RIMS 3 INCHES (MINIMUM) TO 6 INCHES (MAXIMUM) ABOVE FINISHED GRADE. ADD SLOPE FILL AROUND MANHOLES, SLOPED AWAY AND DOWN FROM MANHOLE RING.
5. NO DUMPING OF EXCAVATION MATERIALS WILL BE ALLOWED ON PAVED AREAS. CONTRACTOR MUST DETERMINE A LOCATION TO TEMPORARILY STOCKPILE STORM SEWER EXCAVATION TO BE USED AS BACK FILL, AS APPROVED.
6. THE CONTRACTOR SHALL USE HDPE PLASTIC PIPE OR RCP PIPE AS SHOWN ON PLANS.

D. STANDARD NOTES FOR CONSTRUCTION DRAWINGS:

- 1. CONTRACTOR SHALL BE RESPONSIBLE FOR PROTECTING, MAINTAINING, AND RESTORING BACKSLOPE DRAINAGE SYSTEMS.
2. ALL DISTURBED AREAS WITHIN THE SUBDIVISION, EXCEPT THE CHANNEL BOTTOM, SHALL BE FERTILIZED SEED.
3. ALL BACKFILL SHALL BE STRICTLY ACCORDING TO DETAILS, SPECIFICATION OR GEOTECHNICAL RECOMMENDATIONS, AS APPROVED BY ENGINEER.
4. CONTRACTOR SHALL BE RESPONSIBLE FOR EXCAVATING CHANNEL FLOWLINE TO DESIGN ELEVATIONS AS SHOWN ON PLANS AND DOWNSTREAM AS NECESSARY TO ENSURE NO WATER IN STORM SEWER DURING "DRY" CONDITIONS.
5. CONTRACTOR SHALL BE RESPONSIBLE FOR MAINTAINING FLOW IN CHANNEL DURING CONSTRUCTION AND RESTORING CHANNEL TO ORIGINAL CONDITION.

E. UTILITIES

1. CENTERPOINT ENERGY

WARNING: OVERHEAD ELECTRICAL FACILITIES

A. OVERHEAD LINES MAY EXIST ON THE PROPERTY. WE HAVE ATTEMPTED TO MARK THOSE LINES SINCE THEY ARE CLEARLY VISIBLE, BUT YOU SHOULD LOCATED THEM PRIOR TO BEGINNING ANY CONSTRUCTION. TEXAS LAW, SECTION 752, HEALTH & SAFETY CODE, FORBIDS ALL ACTIVITIES IN WHICH PERSONS OR THINGS MAY COME WITHIN SIX (6) FEET OF LIVE OVERHEAD HIGH VOLTAGE LINES. PARTIES RESPONSIBLE FOR THE WORK, INCLUDING CONTRACTORS, ARE LEGALLY RESPONSIBLE FOR THE SAFETY OF CONSTRUCTION WORKERS UNDER THIS LAW. THIS LAW CARRIES BOTH CRIMINAL AND CIVIL LIABILITY. TO ARRANGE FOR LINES TO BE TURNED OFF OR REMOVED, CALL CENTERPOINT ENERGY, AT (713) 207-7777.

CAUTION: UNDERGROUND GAS FACILITIES

- A. LOCATIONS OF CENTERPOINT ENERGY MAIN LINES, (TO INCLUDE GAS TRANSMISSION, AND/OR INDUSTRIAL GAS SUPPLY CORP. WHERE APPLICABLE), ARE SHOWN IN AN APPROXIMATE LOCATION ONLY. SERVICE LINES ARE USUALLY NOT SHOWN. THE CONTRACTOR SHALL CONTACT THE UTILITY COORDINATING COMMITTEE AT (713) 223-4567 OR 1-800-669-8344 A MINIMUM OF 48 HOURS PRIOR TO CONSTRUCTION TO HAVE MAIN AND SERVICE LINES FIELD LOCATED.
B. WHEN CENTERPOINT ENERGY PIPE LINE MARKINGS ARE NOT VISIBLE, CALL (713)-967-8037 FROM 7:00 AM TO 4:30 PM FOR STATUS OF LINE LOCATION REQUEST BEFORE EXCAVATION BEGINS.
C. WHEN EXCAVATING WITHIN EIGHTEEN INCHES (18") OF THE INDICATED LOCATION OF CENTERPOINT ENERGY FACILITIES, ALL EXCAVATION MUST BE ACCOMPLISHED USING NON-MECHANIZED EXCAVATION PROCEDURES.
D. WHEN CENTERPOINT ENERGY FACILITIES ARE EXPOSED, SUFFICIENT SUPPORT MUST BE PROVIDED TO FACILITIES TO PREVENT EXCESSIVE STRESS ON THE PIPING.
E. THE CONTRACTOR IS FULLY RESPONSIBLE FOR ANY DAMAGES CAUSED BY HIS FAILURE TO EXACTLY LOCATE AND PRESERVE THESE UNDERGROUND FACILITIES.

F. OTHER:

- 1. LOCATION OF ALL EXISTING UNDERGROUND UTILITIES SHOWN ON PLANS IS NOT GUARANTEED TO BE COMPLETE OR DEFINITE. THE APPROXIMATE LOCATIONS OF KNOWN EXISTING UTILITIES ARE SHOWN. CONTRACTOR SHALL DETERMINE THE EXACT SIZE AND HORIZONTAL AND VERTICAL LOCATIONS IN THE FIELD. THE CONTRACTOR SHALL NOTIFY ALL OF THE PROPER GOVERNING AUTHORITIES, (STATE, COUNTY OR CITY) AT LEAST 48 HOURS PRIOR TO COMMENCING WORK.
2. ANY PERMANENT RELOCATION OF AN EXISTING UTILITY NOT SHOWN ON THE DRAWINGS SHALL BE APPROVED BY THE ENGINEER PRIOR TO RELOCATION AND SHALL CONFORM TO THE APPLICABLE STANDARDS OF GOVERNING AUTHORITIES.
3. CONTRACTOR SHALL PROTECT EXISTING UNDERGROUND FACILITIES DURING INSTALLATION OF PROPOSED WORK.
4. IN THE EVENT THAT ANY CONTAMINATED MATERIALS OF SUSPECT CONTAMINATED MATERIALS ARE ENCOUNTERED DURING CONSTRUCTION ACTIVITIES, THE CONTRACTOR SHALL CEASE OPERATIONS IN THAT AREA AND IMMEDIATELY NOTIFY THE ENGINEER.
5. ALL CONSTRUCTION SHALL CONFORM TO THE STANDARDS OF THE GOVERNMENTAL AGENCY HAVING JURISDICTION.
6. ALL PAVEMENT SHALL CONFORM WITH THE STANDARDS OF THE GOVERNMENTAL AGENCY HAVING JURISDICTION.
7. ALL STORM SEWERS SHALL BE CONSTRUCTED OF REINFORCED CONCRETE PIPE (RCP) ASTM C-76, CLASS III, EXCEPT FOR ALUMINIZED STEEL PIPE FOR OUTFALLS. (SEE DETAILS FOR BEDDING).
8. STEEL METAL PIPE SHALL BE ALUMINIZED STEEL AASHTO M274 TYPE 2 MIN. 0.052 THICKNESS.
9. ALL GRAVITY SANITARY SEWERS SHALL BE CONSTRUCTED OF PVC PIPE (ASTM D-3034, SDR 26), UNLESS OTHERWISE NOTED ON THE DRAWINGS.
10. ALL FORCE MAIN SANITARY SEWERS SHALL BE CONSTRUCTED OF PVC PIPE (ASTM D-3034, SDR 26), UNLESS OTHERWISE NOTED ON THE DRAWINGS.
11. ALL SANITARY SEWERS AND WATER MAINS SHALL HAVE SIX (6) INCHES OF SAND BACKFILL BOTH UNDER AND OVER PIPE WITH DETECTOR TAPE (METALLIC) INSTALLED 1.5' BELOW FINISH GRADE.
12. BACKFILL WITH CEMENT STABILIZED SAND WHEN SANITARY SEWER CROSSES OVER STORM SEWER (SPACE BETWEEN STORM AND SANITARY SEWERS).
13. ALL SEWERS UNDER OR WITHIN ONE (1) FOOT OF PROPOSED OR FUTURE PAVEMENT SHALL BE BACKFILLED WITH 1 1/2 SACK CEMENT STABILIZED SAND TO WITHIN ONE (1) FOOT OF SUBGRADE.
14. COST OF SPECIAL BACKFILL AND BEDDING IS INCIDENTAL TO THE UNIT PRICE BID PER LINEAR FOOT, NO EXTRA PAY.
15. WATER MAINS SHALL BE C-900 PVC PIPE BEARING THE NSF-PWSEL AND FITTINGS SHALL BE DUCTILE IRON MECHANICAL JOINT WITH NON-CORRODING HARDWARE INCLUDING MEGA-LUG RESTRAINTS CONFORMING TO AWWA CL-110 OR C-153.
16. FIRE HYDRANTS SHALL BE "MUELLER IMPROVED" OR APPROVED EQUAL.
17. MINIMUM OF SIX (6) INCHES OF CLEARANCE SHALL BE MAINTAINED BETWEEN WATER MAIN CROSSING OF OTHER UTILITIES.
18. ALL PROPOSED PIPE STUB-OUTS FROM STORM MANHOLES OR INLETS ARE TO BE PLUGGED WITH EIGHT (8) INCH BRICK WALLS UNLESS OTHERWISE NOTED.
19. THE CONTRACTOR SHALL NOTIFY THE CITY OR GOVERNMENTAL AGENCY HAVING JURISDICTION, 48 HOURS IN ADVANCE OF COMMENCING CONSTRUCTION.
20. GUIDELINES SET FORTH IN THE MANUAL ON UNIFORM TRAFFIC CONTROL DEVICES SHALL BE OBSERVED.
21. ALL SANITARY SEWERS SHALL BE CONSTRUCTED IN ACCORDANCE WITH TCEQ "RULES AND REGULATIONS FOR PUBLIC WATER SYSTEMS".
22. CONTRACTOR SHALL OBTAIN ALL CONSTRUCTION PERMITS REQUIRED TO THE STANDARDS OF THE GOVERNMENTAL AGENCY HAVING JURISDICTION.
23. SANITARY MANHOLES WITHIN THE FLOOD PLAIN SHALL BE WATERPROOFED AND VENTED WITH RISER ABOVE FLOOD PLAIN OR RIMS SET ABOVE THE 100 YEAR FLOOD ELEVATION.
24. WHERE A NEW POTABLE WATERLINE CROSSES A NEW, NON-PRESSURE RATED WASTEWATER MAIN OR LATERAL AND A STANDARD LENGTH OF THE WASTEWATER PIPE IS LESS THAN 18 FEET IN LENGTH, THE POTABLE WATER PIPE SEGMENT SHALL BE CENTERED OVER THE WASTEWATER LINE. THE MATERIALS AND METHOD OF INSTALLATION SHALL CONFORM WITH ONE OF THE FOLLOWING OPTIONS.

- (I) WITHIN NINE FEET HORIZONTALLY OF EITHER SIDE OF THE WATERLINE, THE WASTEWATER PIPE AND JOINTS SHALL BE CONSTRUCTED WITH PIPE MATERIAL HAVING A MINIMUM PRESSURE RATING OF AT LEAST 150 PSI. AN ABSOLUTE MINIMUM VERTICAL SEPARATION DISTANCE OF TWO FEET SHALL BE PROVIDED. THE WASTEWATER MAIN OR LATERAL SHALL BE LOCATED BELOW THE WATERLINE.
(II) ALL SECTIONS OF WASTEWATER MAIN OR LATERAL WITHIN NINE FEET HORIZONTALLY OF THE WATERLINE SHALL BE ENCASED IN AN 18-FOOT (OR LONGER) SECTION OF PIPE. FLEXIBLE ENCASING PIPE SHALL HAVE A MINIMUM PIPE STIFFNESS OF 115 PSI AT 5.0% DEFLECTION. THE ENCASING PIPE SHALL BE CENTERED ON THE WATERLINE AND SHALL BE AT LEAST TWO NOMINAL PIPE DIAMETERS LARGER THAN THE WASTEWATER MAIN OR LATERAL. THE SPACE AROUND THE CARRIER PIPE SHALL BE SUPPORTED AT FIVE-FOOT (OR LESS) INTERVALS WITH SPACERS OR BE FILLED TO THE SPRINGLINE WITH WASHED SAND. EACH END OF THE CASING SHALL BE SEALED WITH WATERTIGHT NON-SHRINK CEMENT GROUT OR A MANUFACTURED WATERTIGHT SEAL. AN ABSOLUTE MINIMUM SEPARATION DISTANCE OF SIX INCHES BETWEEN THE ENCASEMENT PIPE AND THE WATERLINE SHALL BE PROVIDED. THE WASTEWATER LINE SHALL BE LOCATED BELOW THE WATERLINE.

(III) WHEN A NEW WATERLINE CROSSES UNDER A WASTEWATER MAIN OR LATERAL, THE WATERLINE SHALL BE ENCASED AS DESCRIBED FOR WASTEWATER MAINS OR LATERALS IN SUBCLASS (II) OF THIS CLAUSE OR CONSTRUCTED OF DUCTILE IRON OR STEEL PIPE WITH MECHANICAL OR WELDED JOINTS AS APPROPRIATE. AN ABSOLUTE MINIMUM SEPARATION DISTANCE OF ONE FOOT BETWEEN THE WATERLINE AND THE WASTEWATER MAIN OR LATERAL SHALL BE PROVIDED. BOTH THE WATERLINE AND WASTEWATER MAIN OR LATERAL MUST PASS A PRESSURE AND LEAKAGE TEST AS SPECIFIED IN AWWA C600 STANDARDS.

- 25. COST OF TRENCH SAFETY SYSTEMS AS REQUIRED BY OSHA FOR DEPTHS OVER FIVE (5) FEET IS INCIDENTAL TO THE PROJECT.
26. WATER LINES ARE TO BE CONSTRUCTED TYPICALLY 4 FEET DEEP TO THE TOP OF THE LINE FROM THE FINISHED CURB ELEVATION OR NATURAL GROUND. LINES MAY BE SAGGED OR RAISED WITHIN THE RANGE OF 3-6 FEET TO AVOID UTILITY CONFLICTS WATER LINE DEFLECTIONS SHALL NOT EXCEED THE PIPE MANUFACTURES RECOMMENDATIONS.
27. ALL SLEEVES TO BE FOUR (4) INCH SCHEDULE 40 PVC SLEEVES TO BE EIGHTEEN (18) INCHES BELOW THE BOTTOM OF THE PAVEMENT BASE MATERIAL. STUB OUT THREE (3) FEET BEYOND CURB AND MARK SLEEVES LOCATIONS ON CURB.
28. THERE SHALL BE A MINIMUM HORIZONTAL DISTANCE OF FOUR (4) FEET CLEARANCE BETWEEN ALL WATER LINES AND SANITARY SEWER LINES THAT ARE SDR 26, AND A NINE (9) FOOT CLEARANCE BETWEEN ALL WATER LINES AND SANITARY SEWER LINES THAT ARE SDR 35. (SEE DETAIL)
29. ALL JOINTS OF DUCTILE IRON PIPE BELOW GROUND WILL BE M.J. WITH PIPE RESTRAINTS.
30. ALL SIGNAGE AND/OR TRAFFIC CONTROL DEVICES SHALL BE APPROVED BY HARRIS COUNTY PRIOR TO CONSTRUCTION.

NOTE: IT SHALL BE THE RESPONSIBILITY OF THE CONTRACTOR TO LOCATE ALL UTILITIES IN THE ROAD R.O.W. PRIOR TO CONSTRUCTION. (TEXAS ONE CALL 1-800-545-6005)

NOTE: CONTRACTOR SHALL ADJUST ALL WATER VALVES AND STORM SEWER MANHOLES TO MATCH FINAL GRADES. SEE ALL GRADING PLANS SHEETS.

NOTE: CONTRACTOR SHALL VERIFY ALL WATER, SANITARY SEWER AND STORM SEWER LINES PRIOR TO WORKING IN ANY AREA. SEE TOPO MAP AND REFERENCE DRAWINGS.

NOTE: THIS DEVELOPMENT HAS BEEN DESIGNED TO NOT IMPEDE, IMPOUND, OR BLOCK THE NATURAL FLOW OF DRAINAGE FROM OR ACROSS ADJACENT AND CONTIGUOUS PROPERTIES.

NOTE: ALL FUTURE SITE AND BUILDINGS PROJECTS WILL REQUIRE CIVIL/SITE DRAWING APPROVAL AND CHANGES TO THE PLATS MAY BE REQUIRED AS A PART OF THE REVIEW PROCESS.


ALL PIPE PLACEMENT AND JOINTING WILL BE CONSTRUCTED STRICTLY IN ACCORDANCE WITH THE MANUFACTURES REQUIREMENTS AND SPECIFICATIONS.

STORM SEWER PIPE — HDPE N-12, PVC SDR35 OR RCP CLASS III (RUBBER GASKET)— EXCEPT IF NOTED OTHERWISE
POTABLE WATER — 3" AND SMALLER — SCH 80 PVC
4" AND LARGER — C-900, DR 18- 150 PSI
SANITARY SEWER — GRAVITY, PVC SDR 26
CULVERT PIPE — RCP CLASS IV T&G

THE OWNER WILL SET UP THE NECESSARY WATER ACCOUNTS AND PURCHASE THE WATER METERS AND METER BOXES. THE CONTRACTOR WILL PICK UP THE METERS AND BOXES AT THE CITY AND DELIVER THEM TO THE JOBSITE. THE CONTRACTOR WILL MAKE THE NECESSARY TAPS AND INSTALL THE METERS AS REQUIRED BY HARRIS COUNTY.

ONE- CALL NOTIFICATION SYSTM CALL BEFORE YOU DIG!!! (713) 223-4567 (in Houston, Tx) (New Statewide Number Outside Houston) 1-800-545-6005

KEY PLAN (NOT TO SCALE)

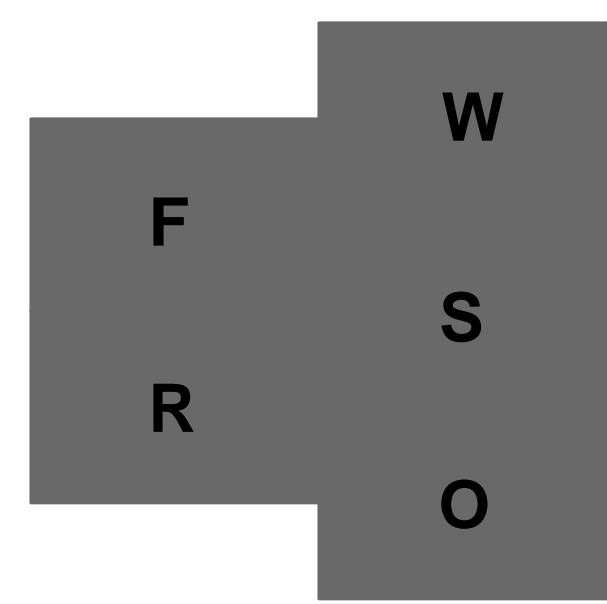


























REVISION HISTORY table with columns for REVISION, DESCRIPTION, and DATE. Row 1: ADDENDUM NO. 3, 10-07-2020.

PROFESSIONAL SEAL for FRED DALLY, LICENSED PROFESSIONAL ENGINEER, No. 90904, State of Texas, dated 10/07/2020.

GENERAL NOTES table with columns for DRAWN BY (JDM), CHECKED BY (JDM), PROJECT NUMBER (418198), PROJECT ABBREVIATION (GC_RBB), ORIGINAL ISSUE DATE (07 OCT 2020), and ISSUE FOR PERMIT.


C8.0-PH1 SHEET NUMBER

**Galveston County
Road & Bridge Department Facilities PH1**
5115 Texas Highway 3
Dickinson, TX

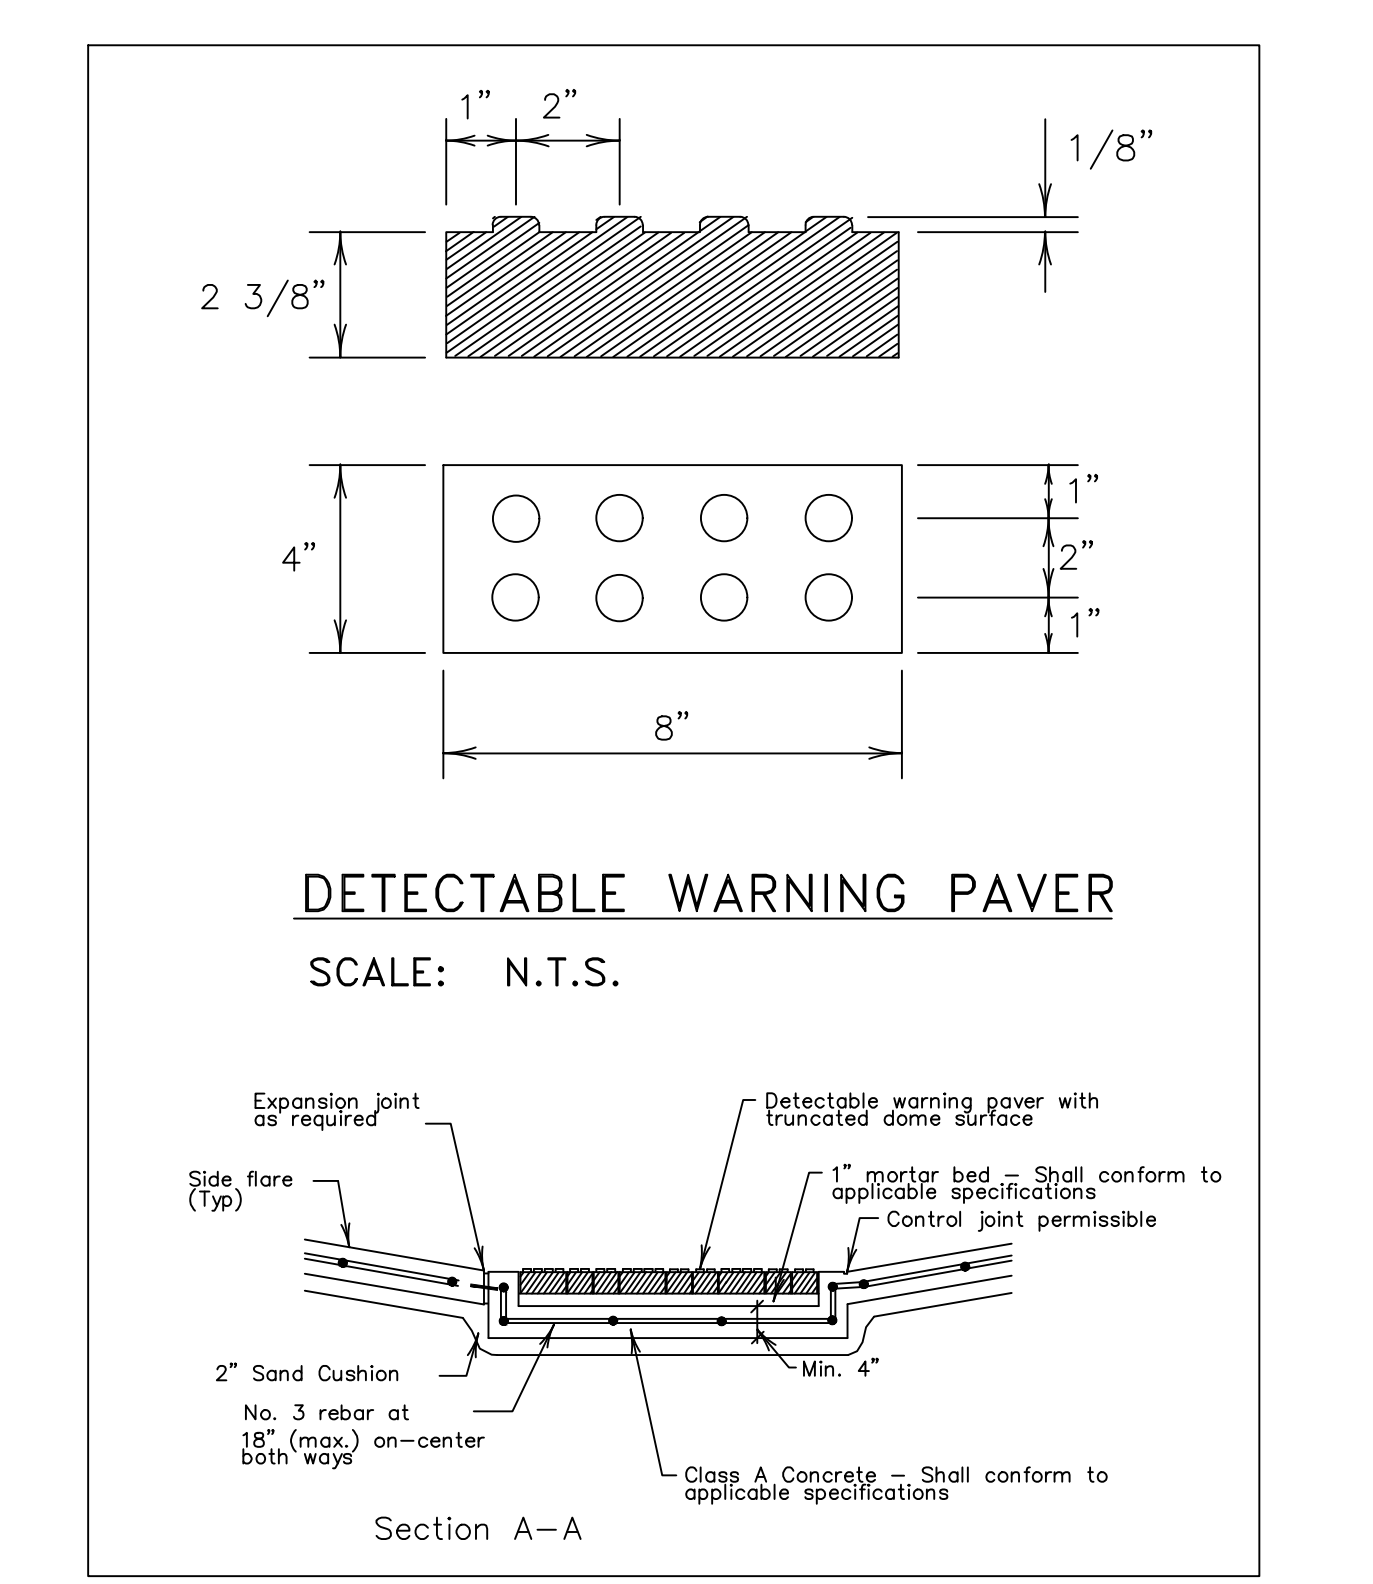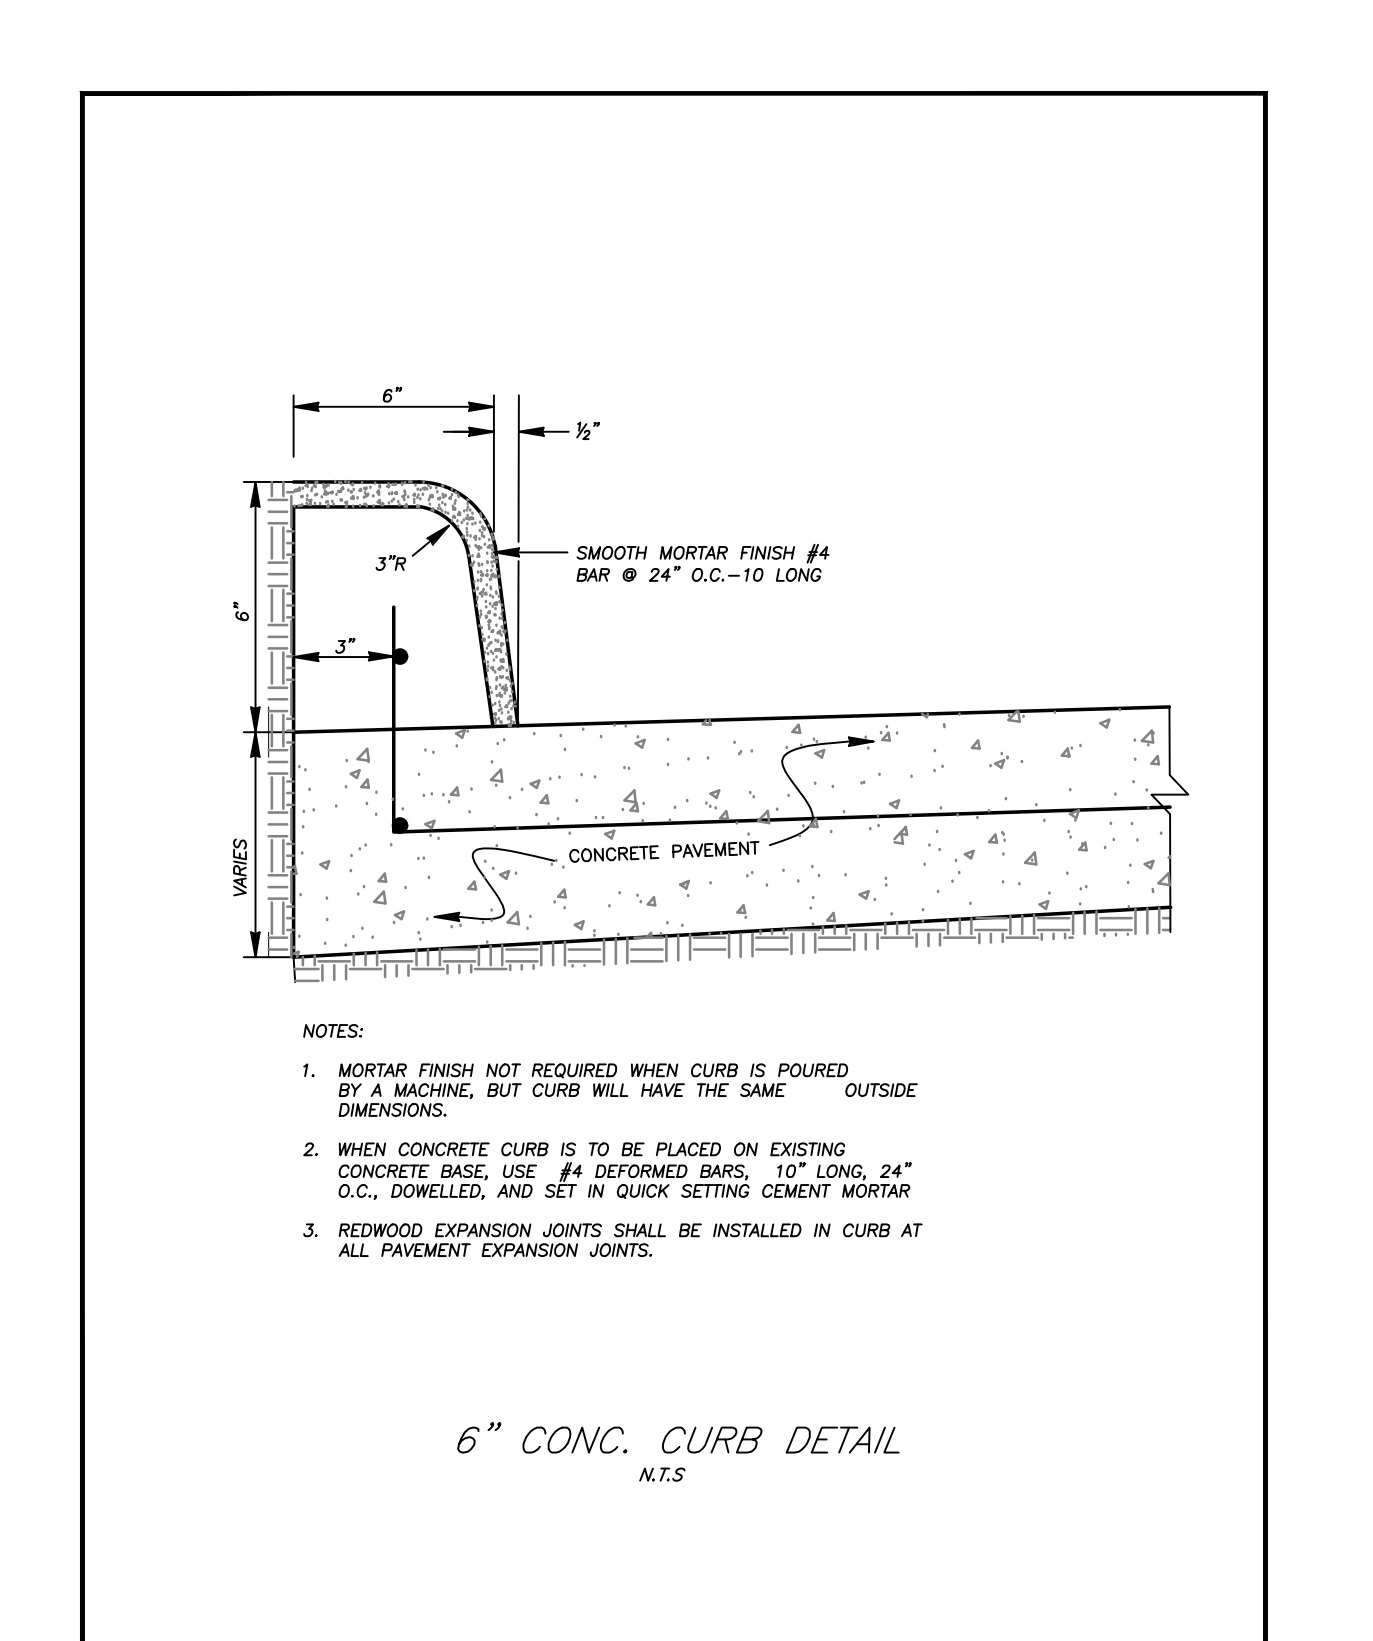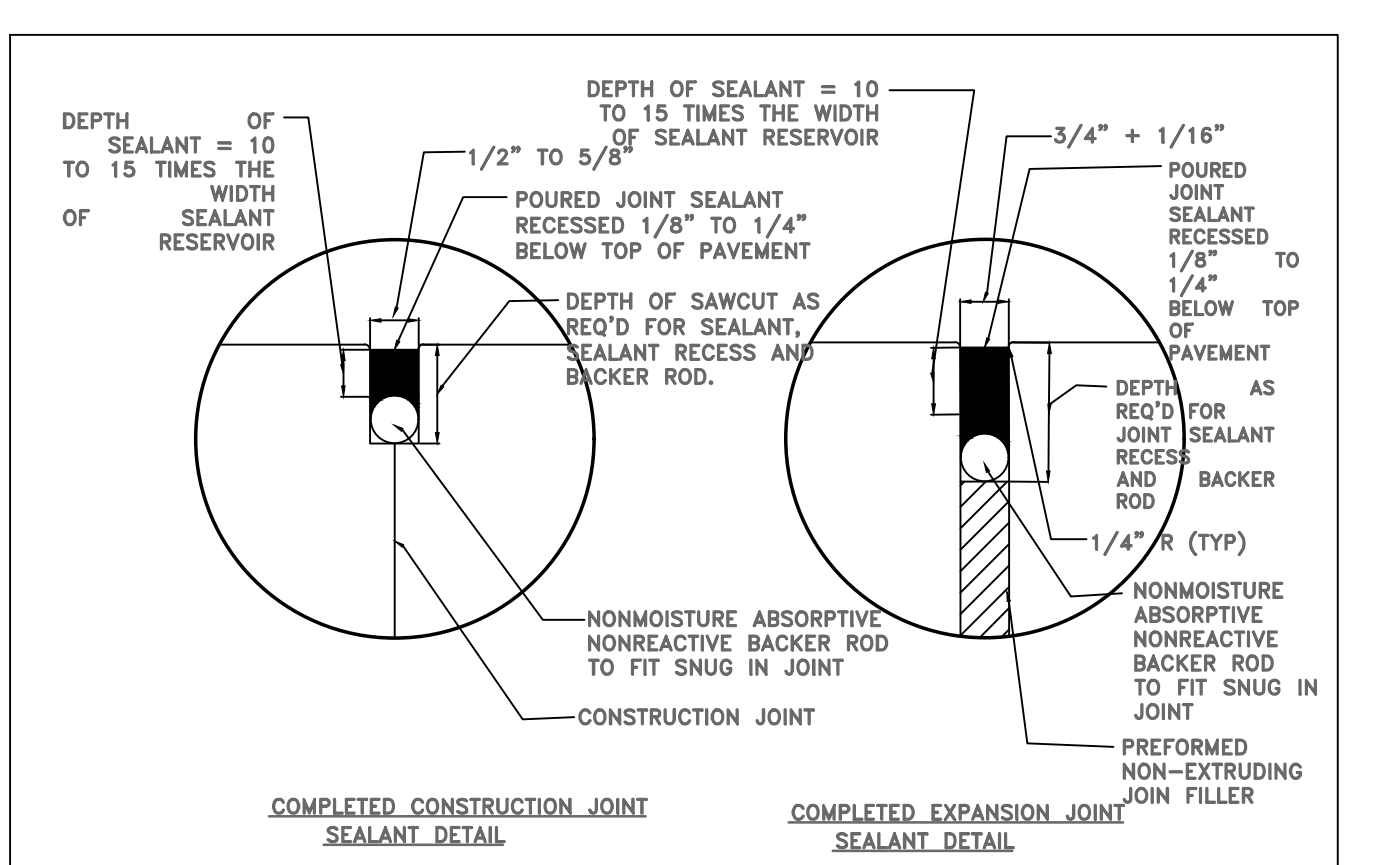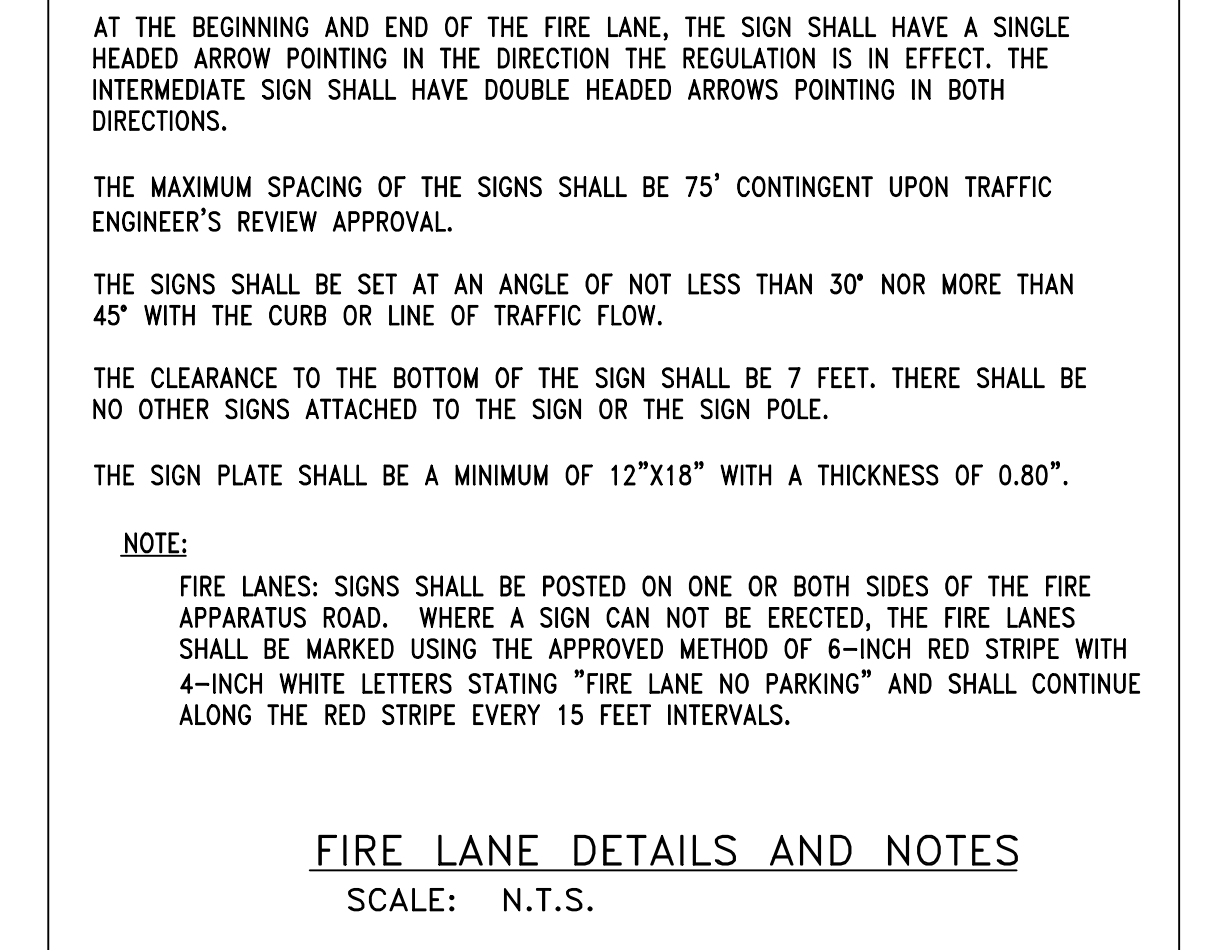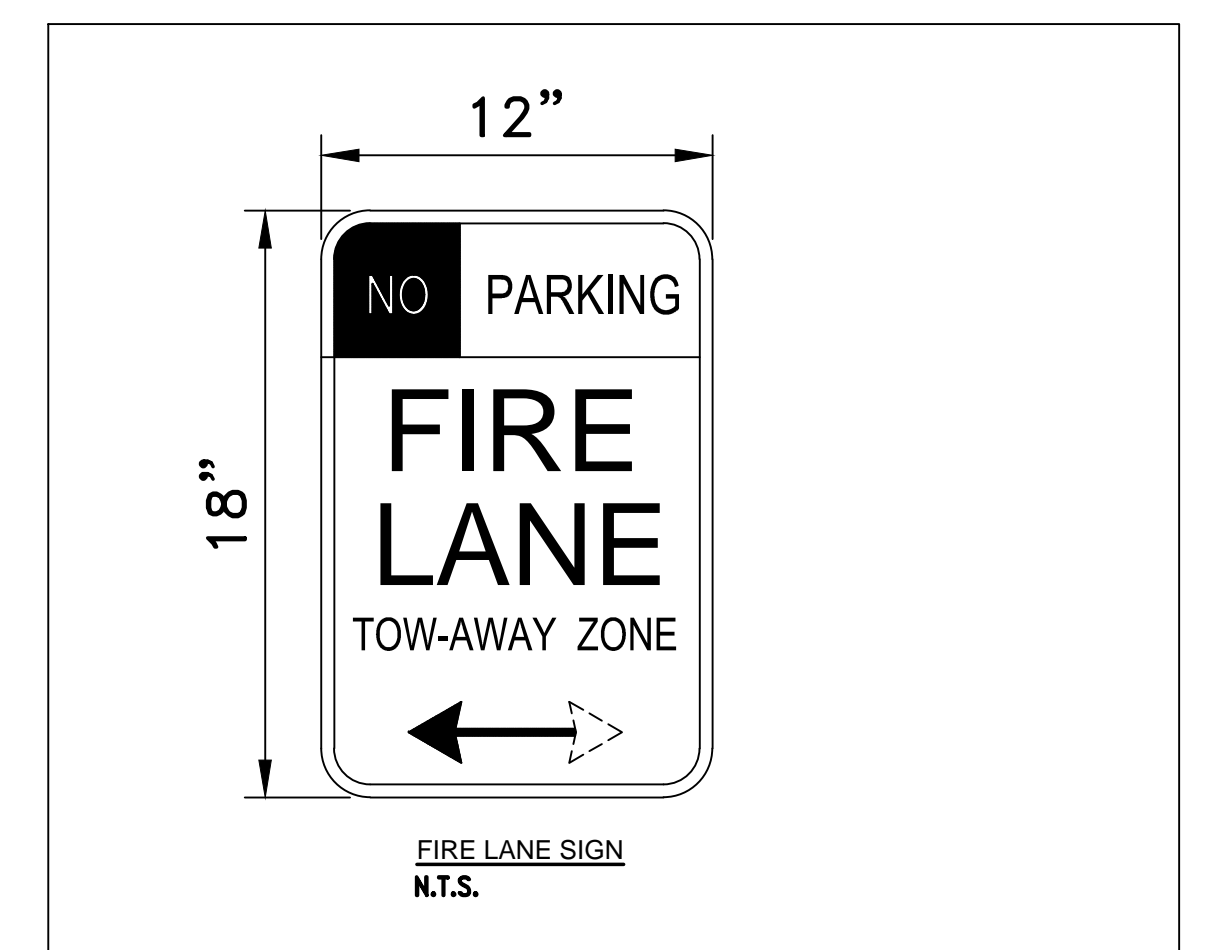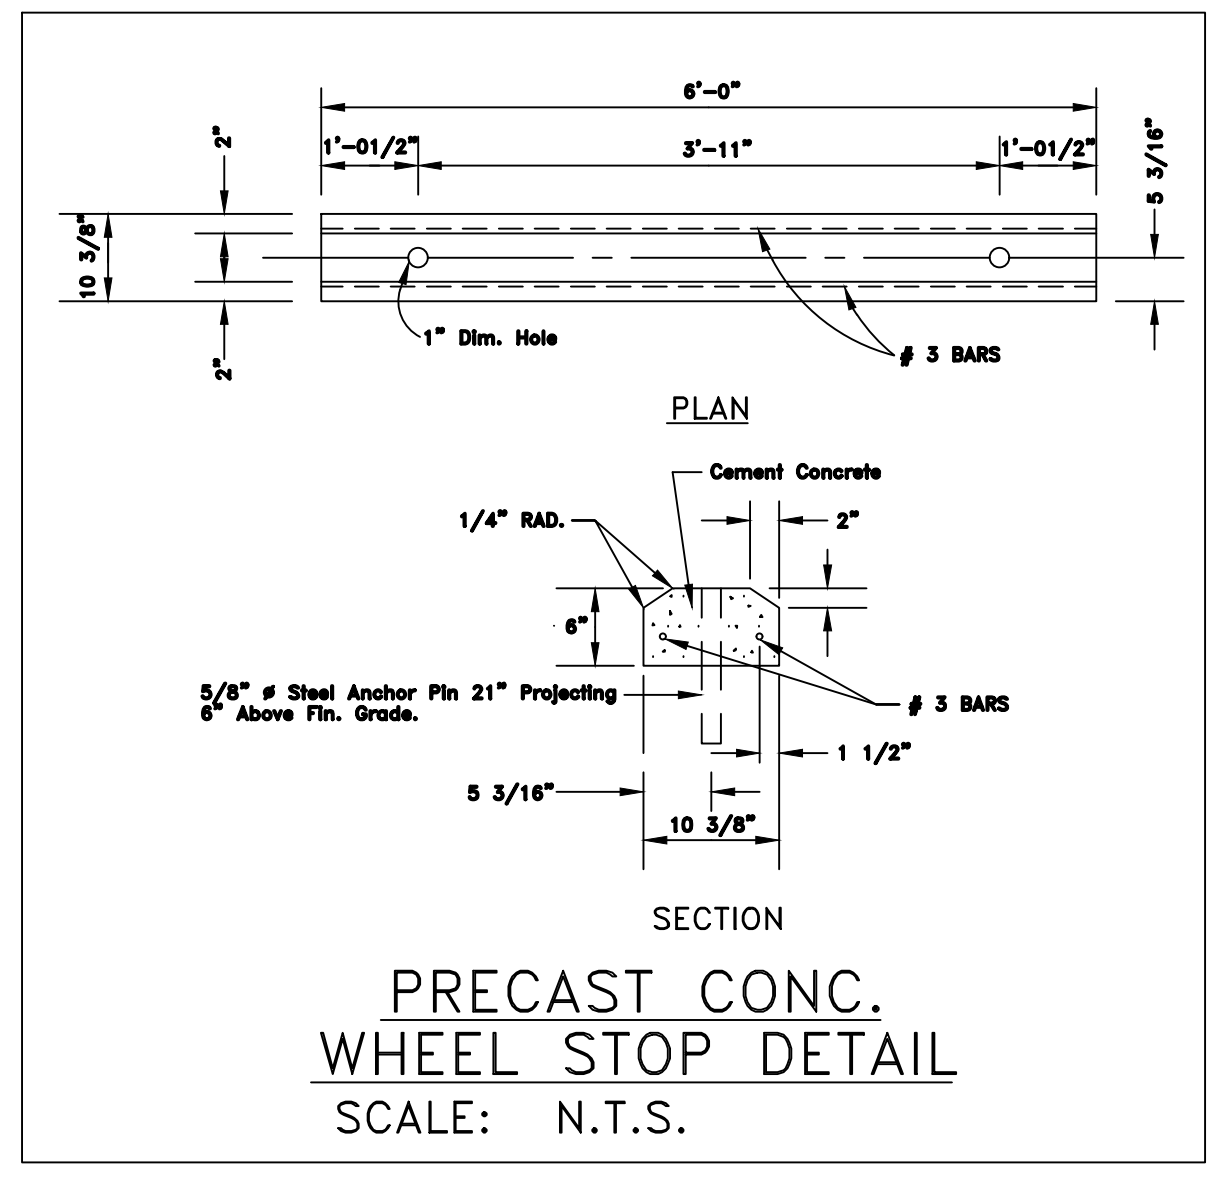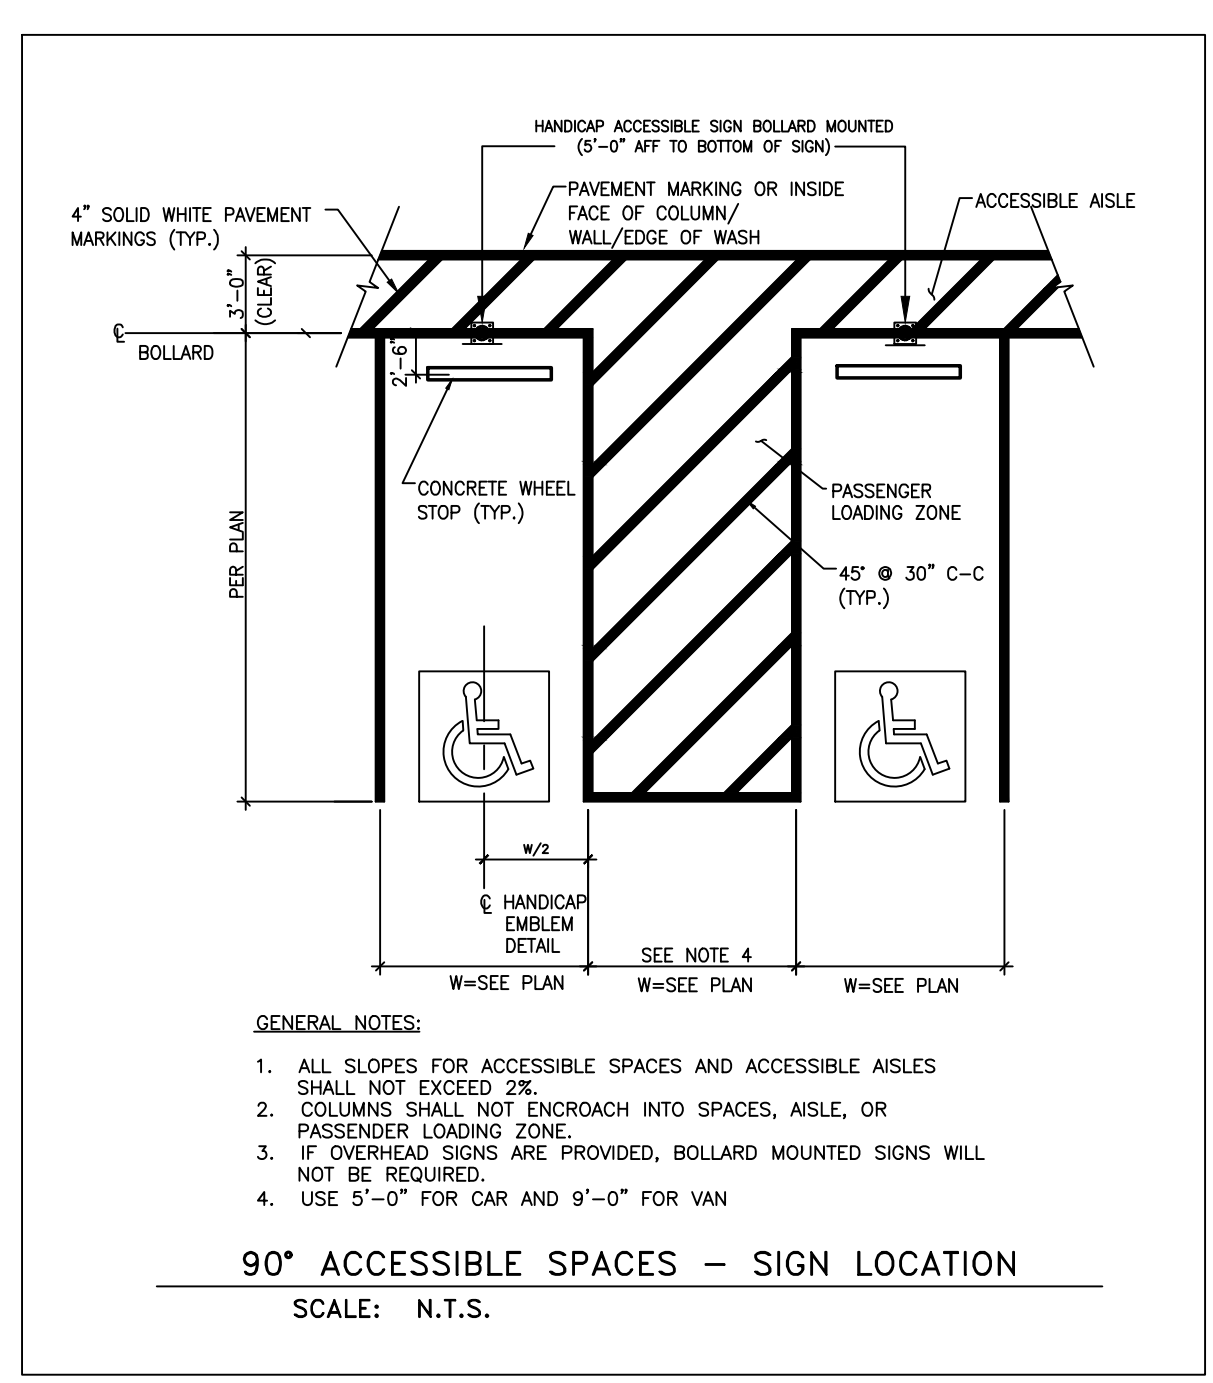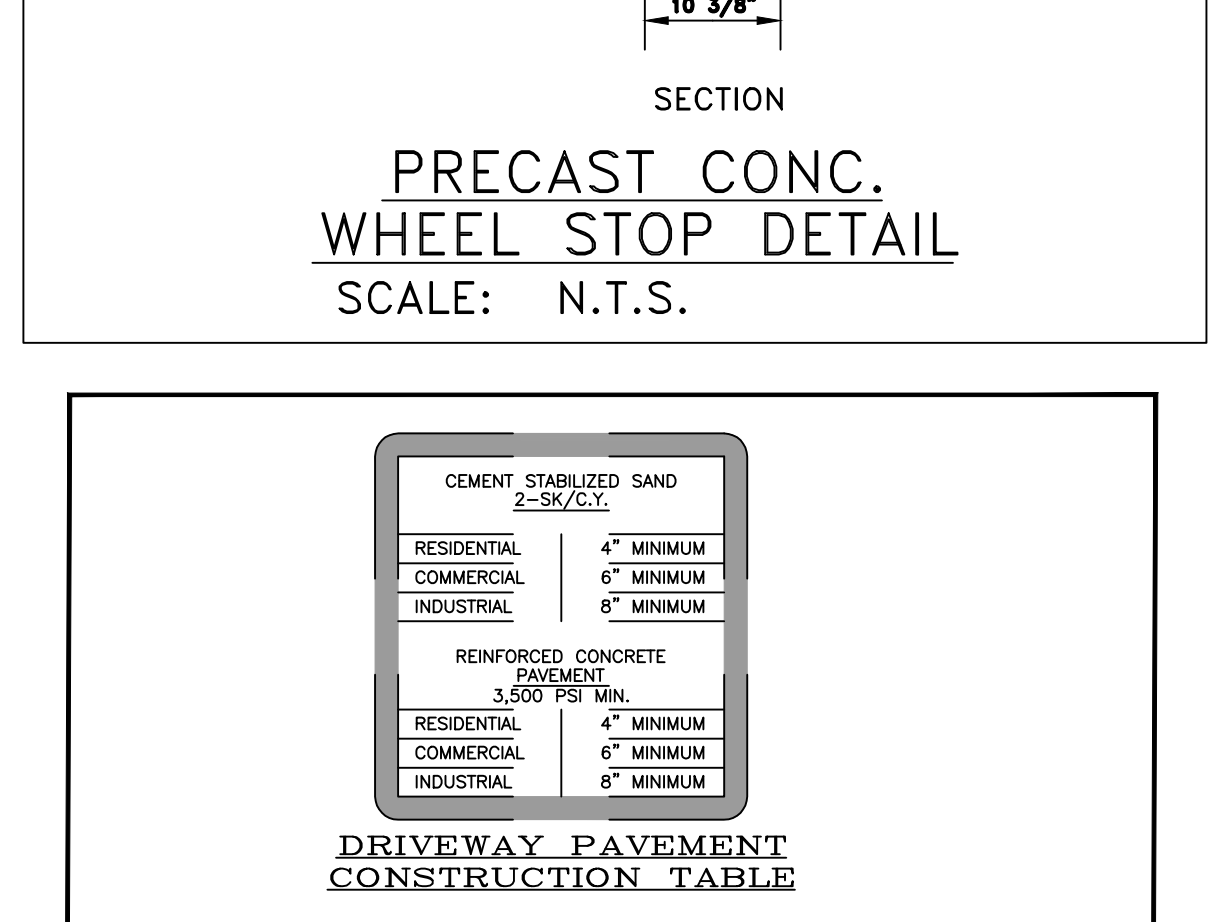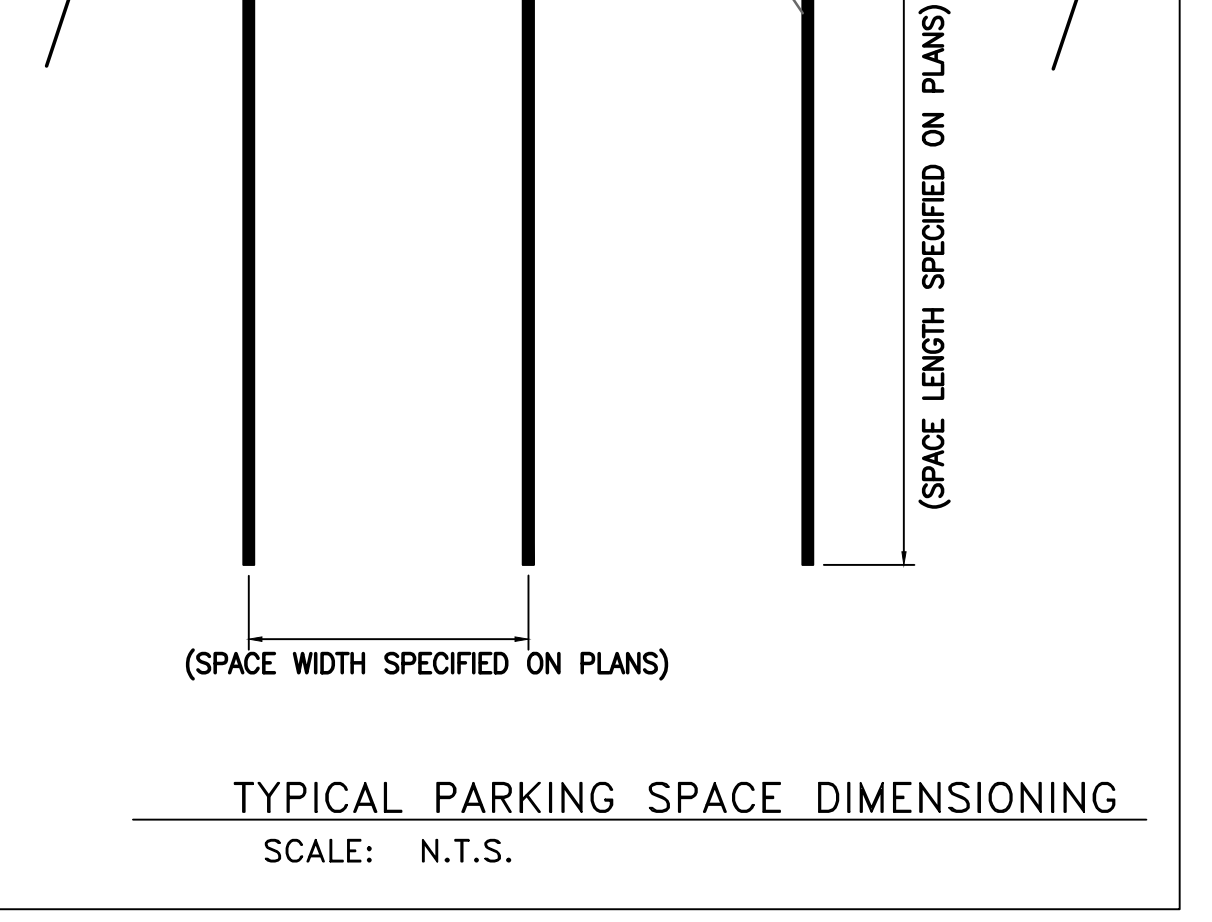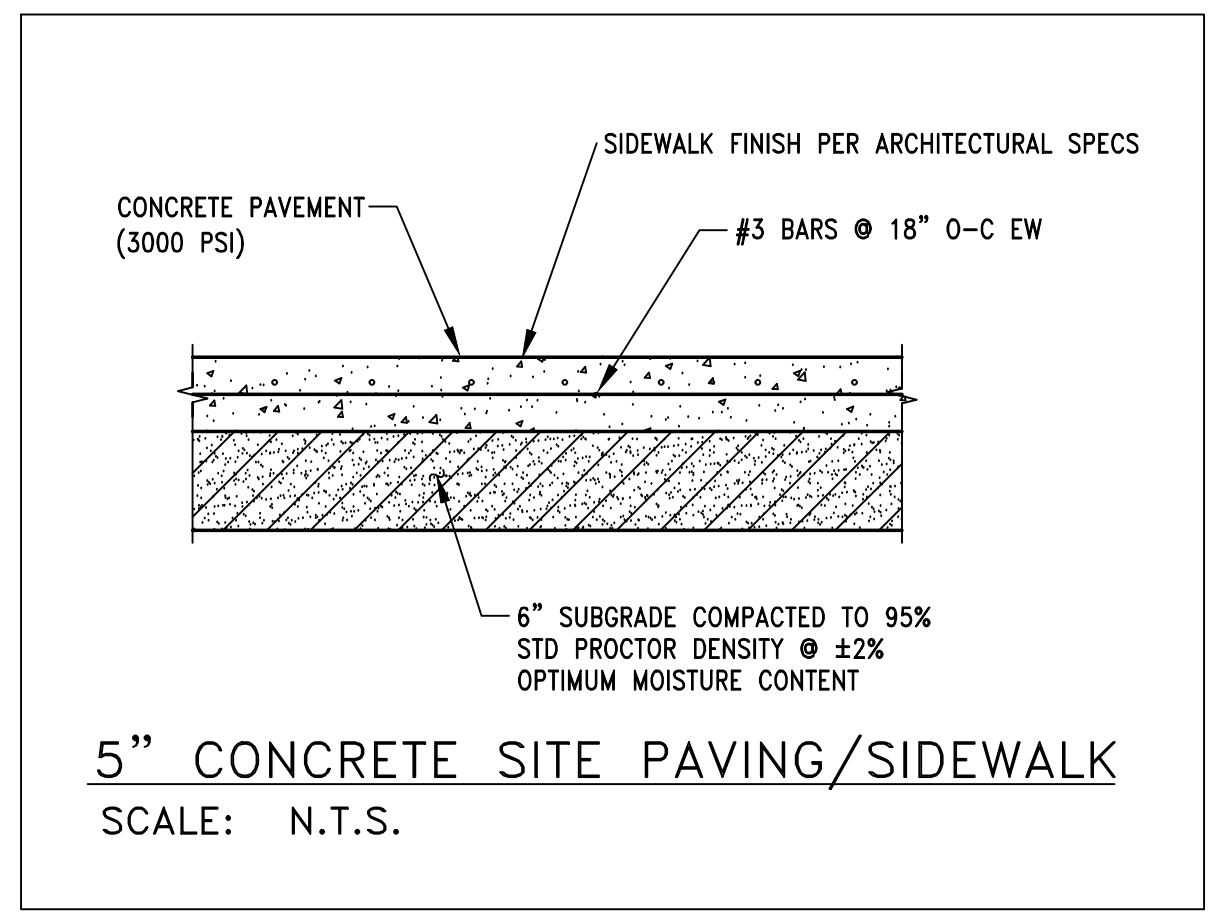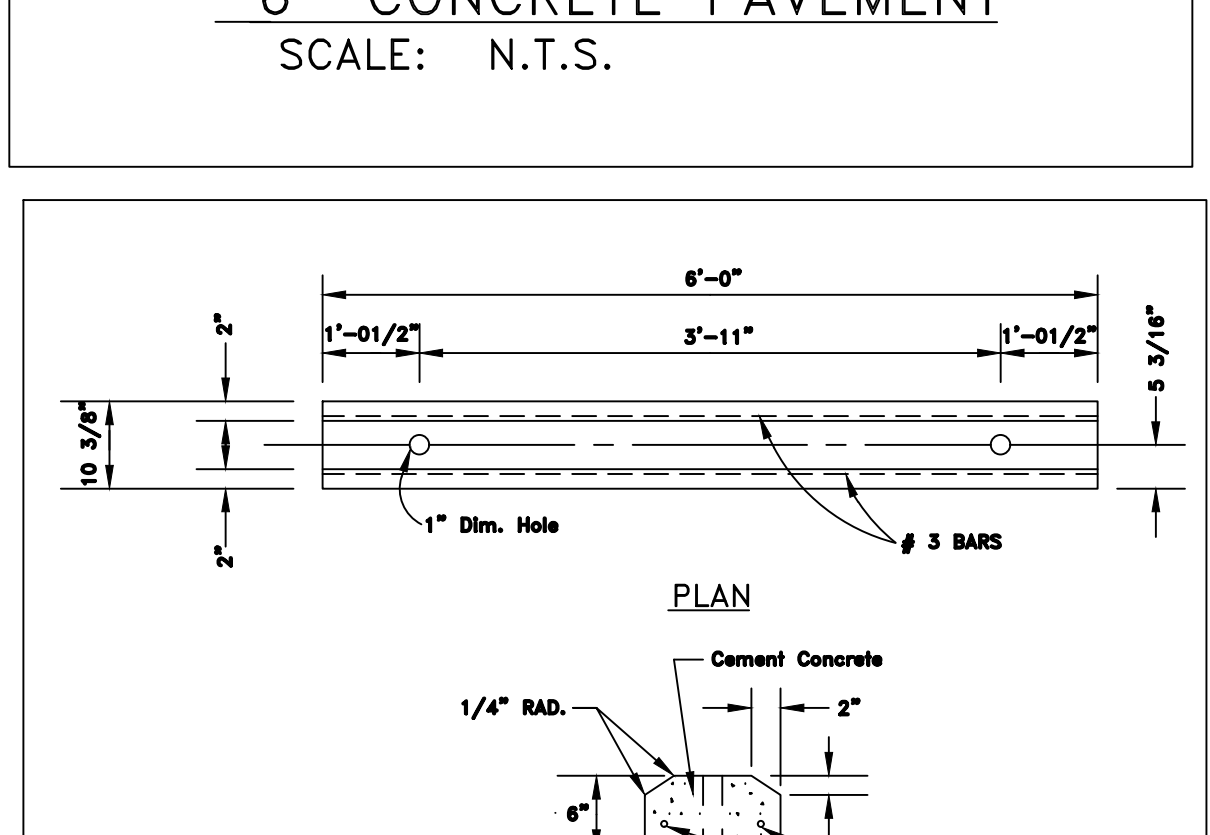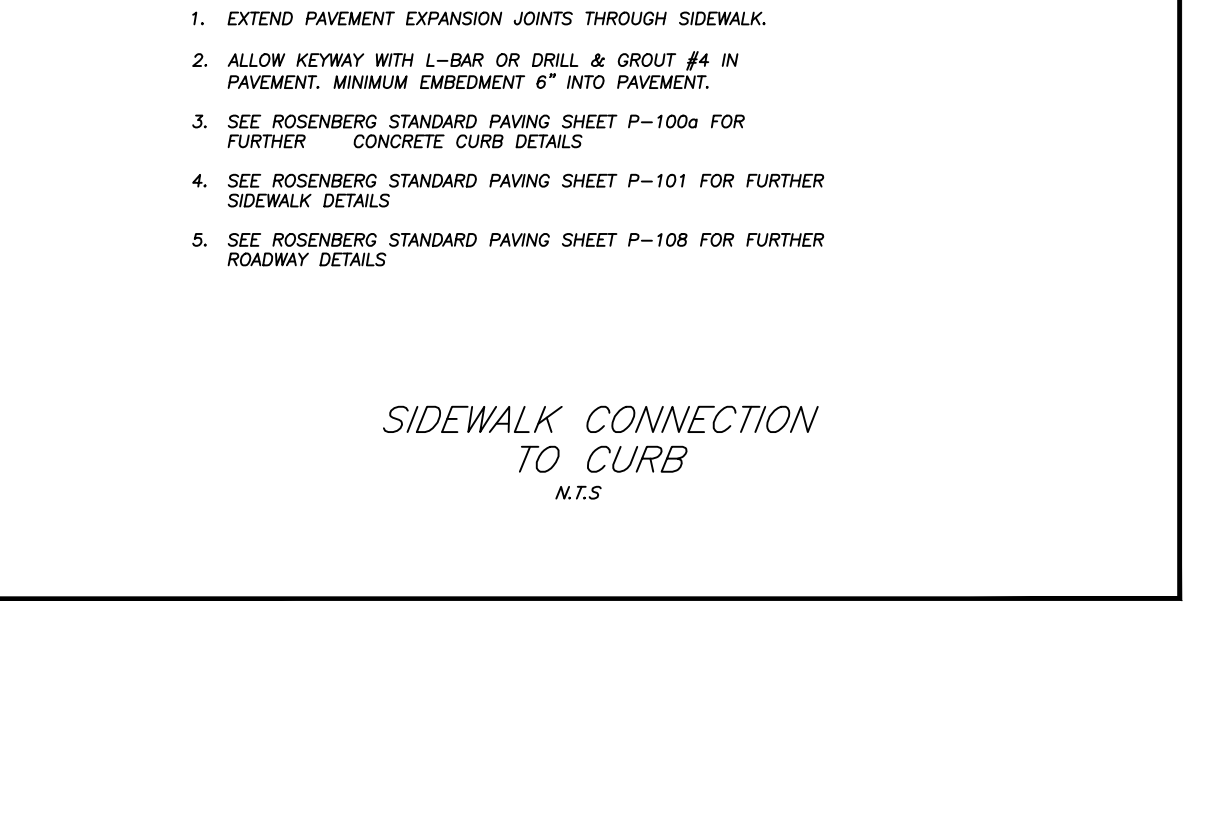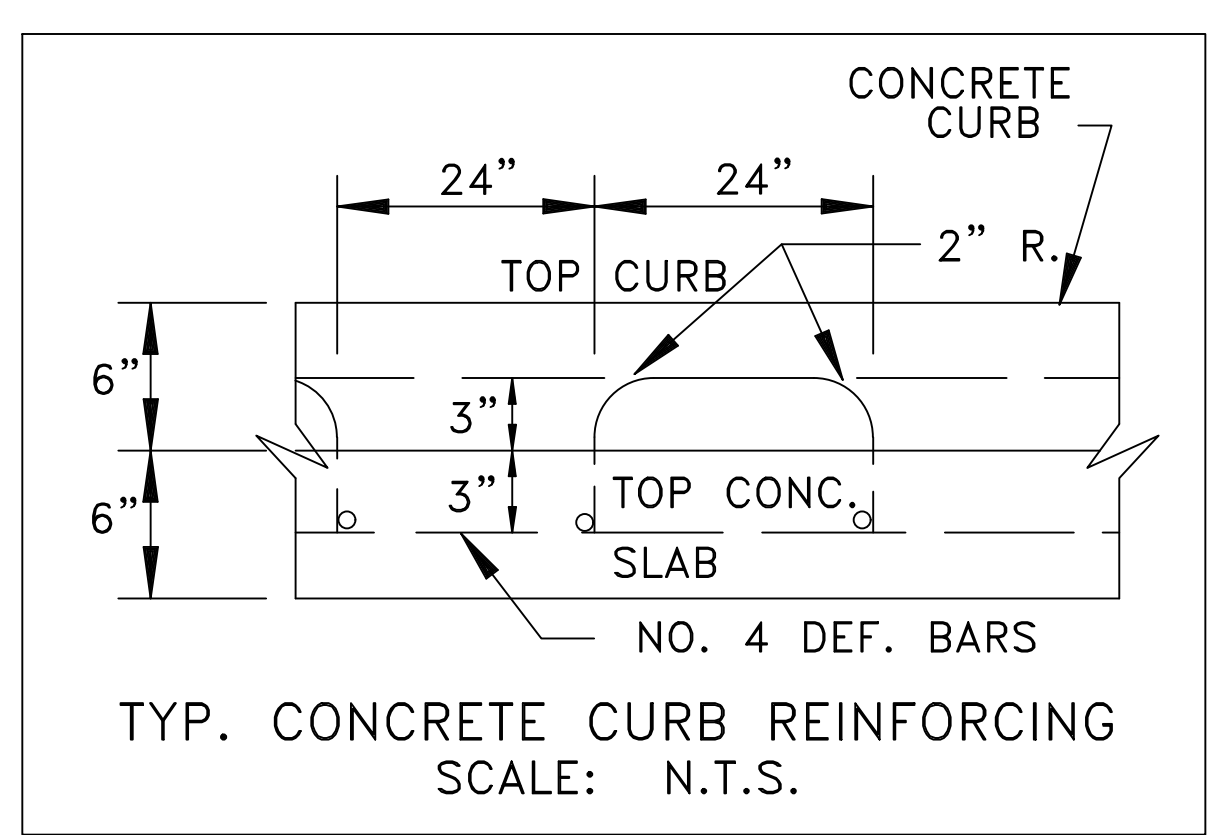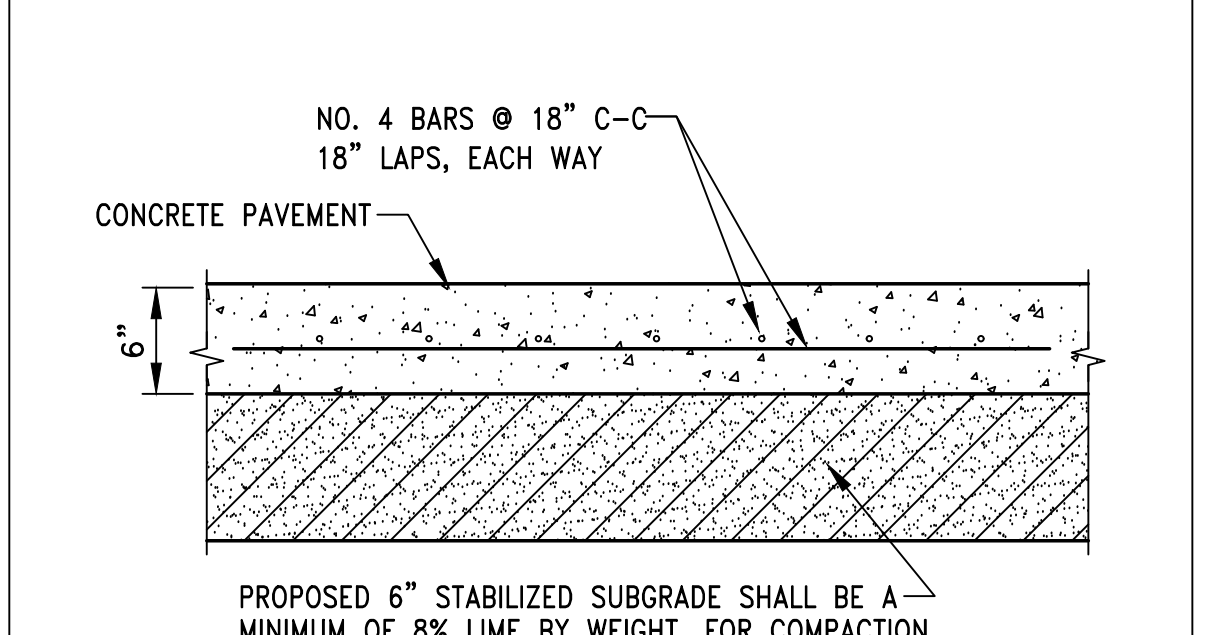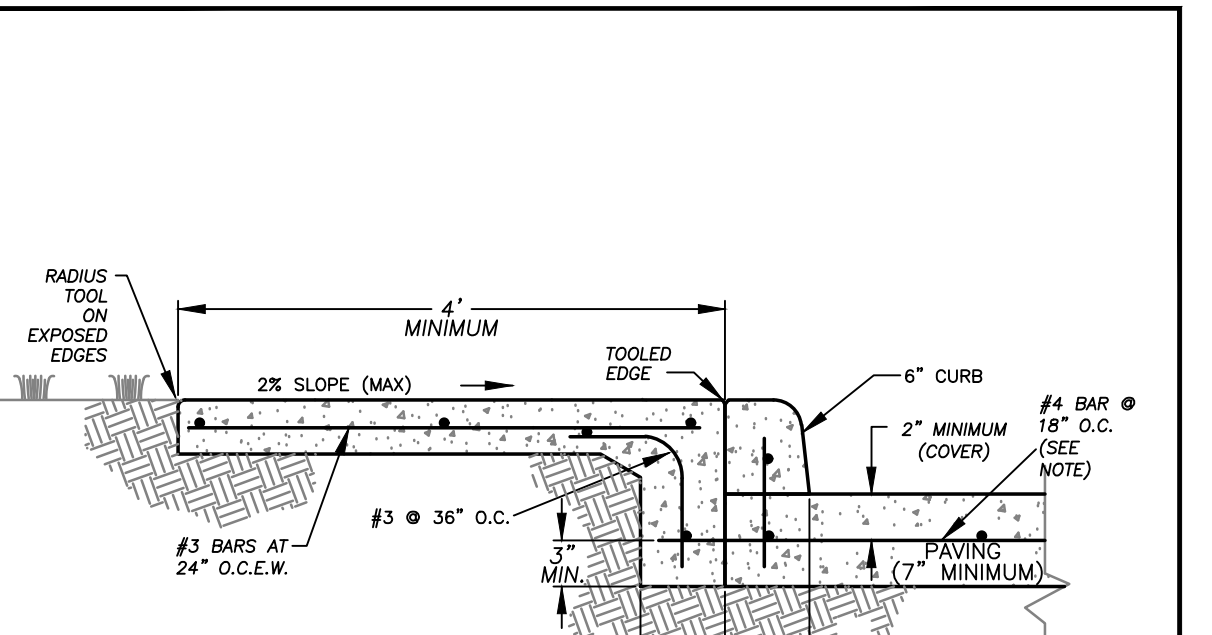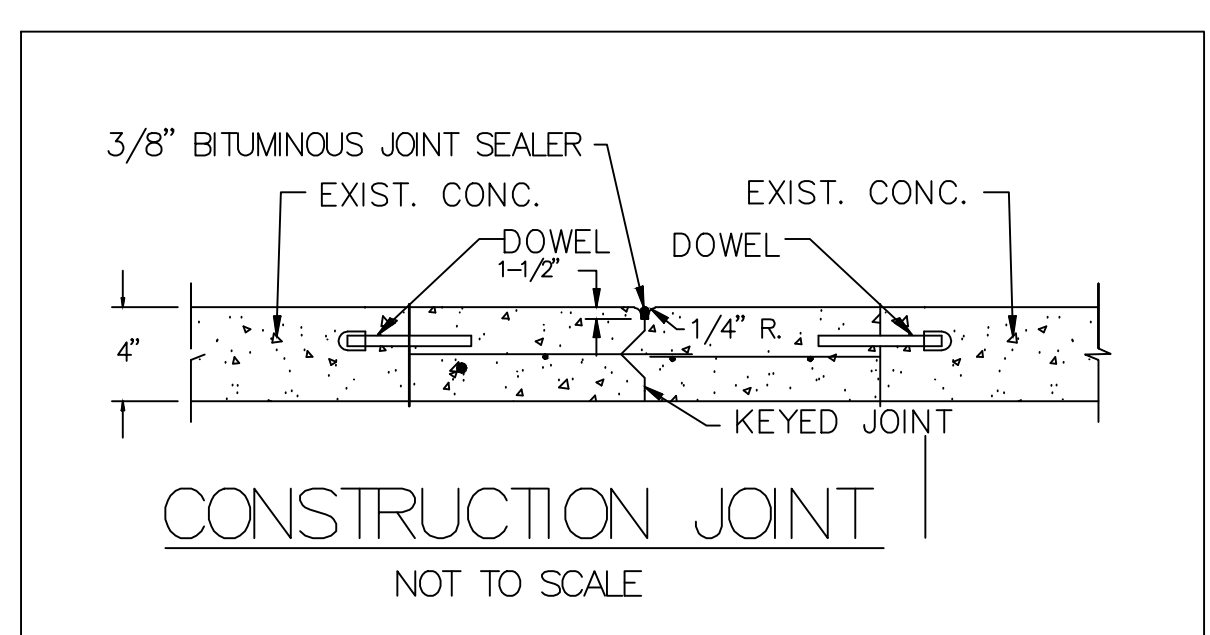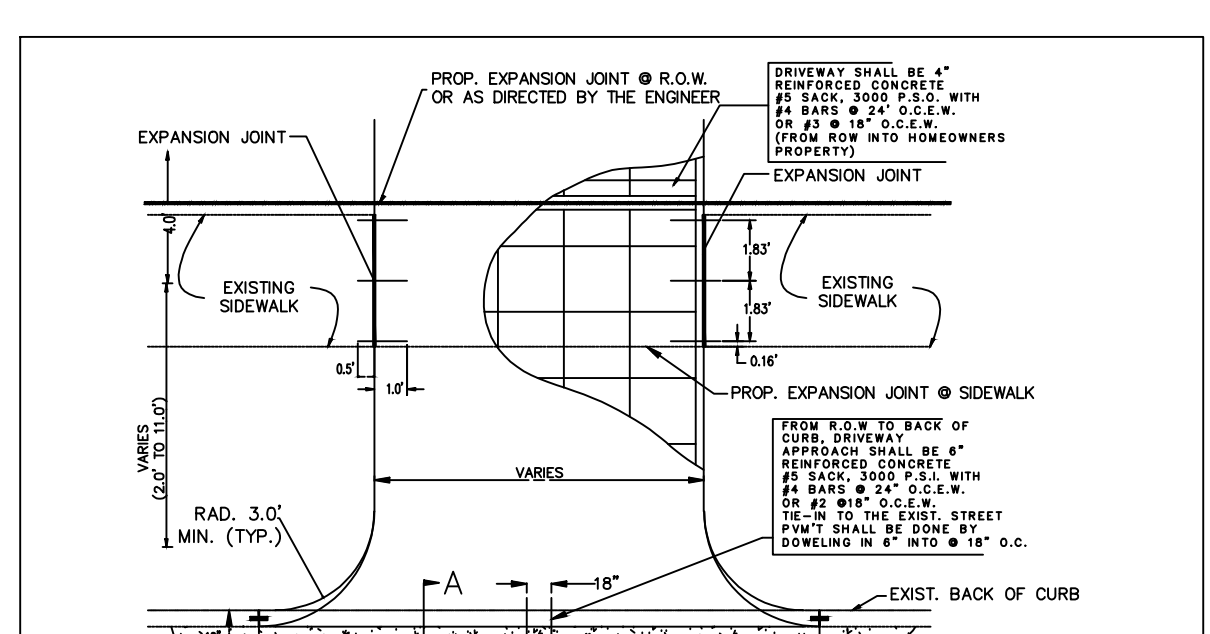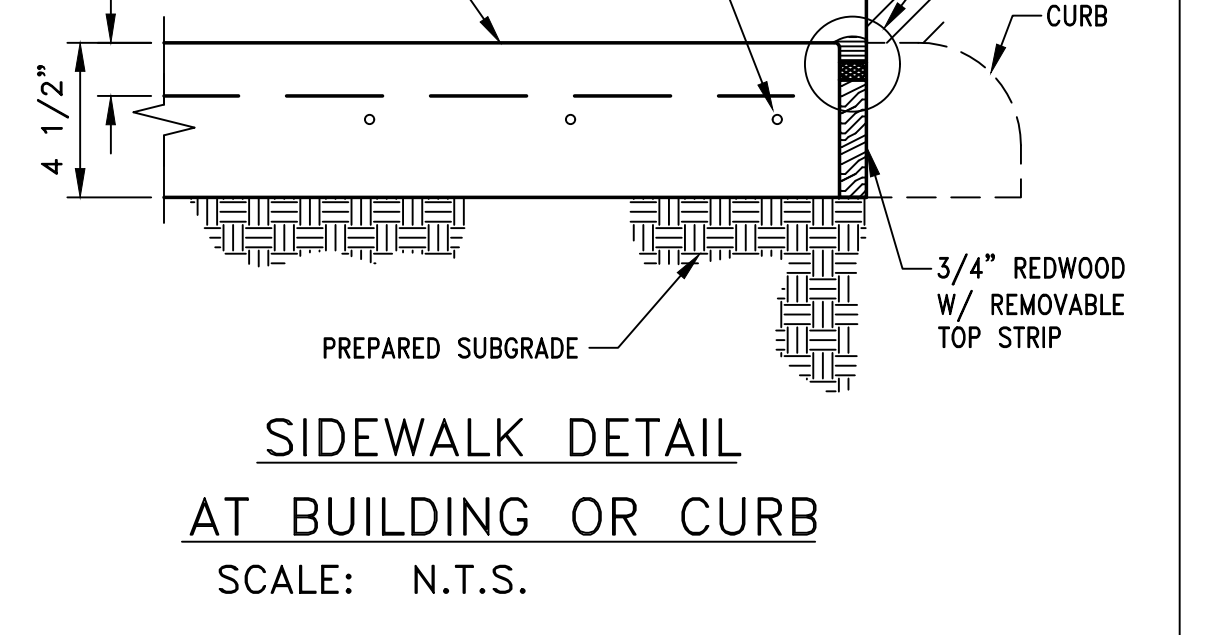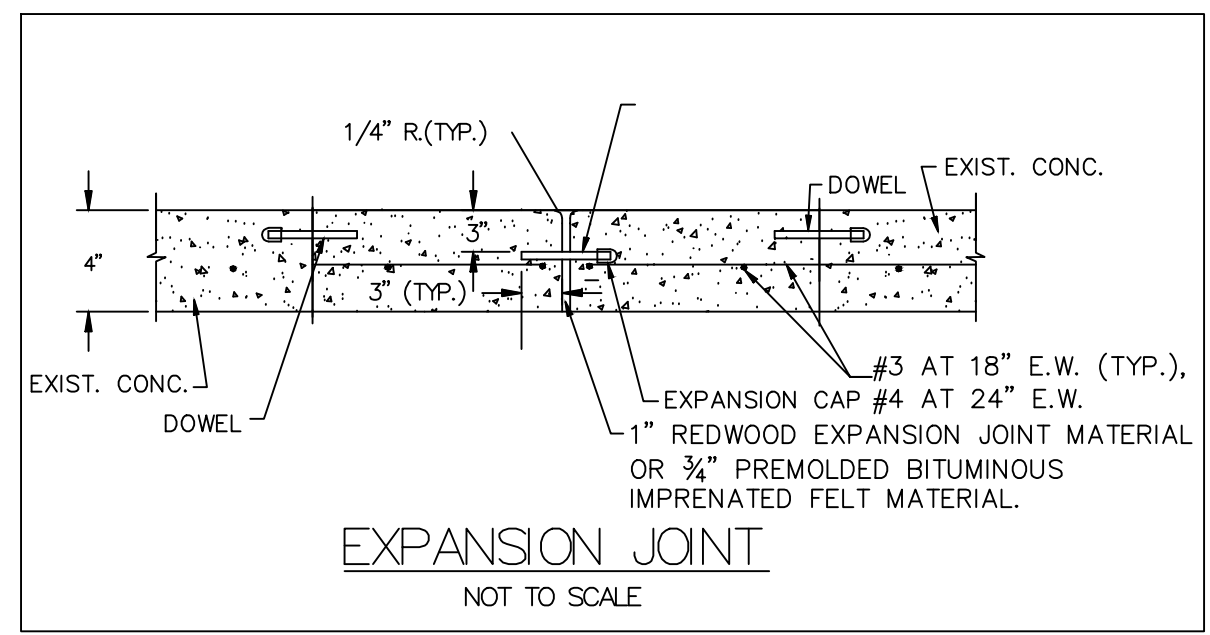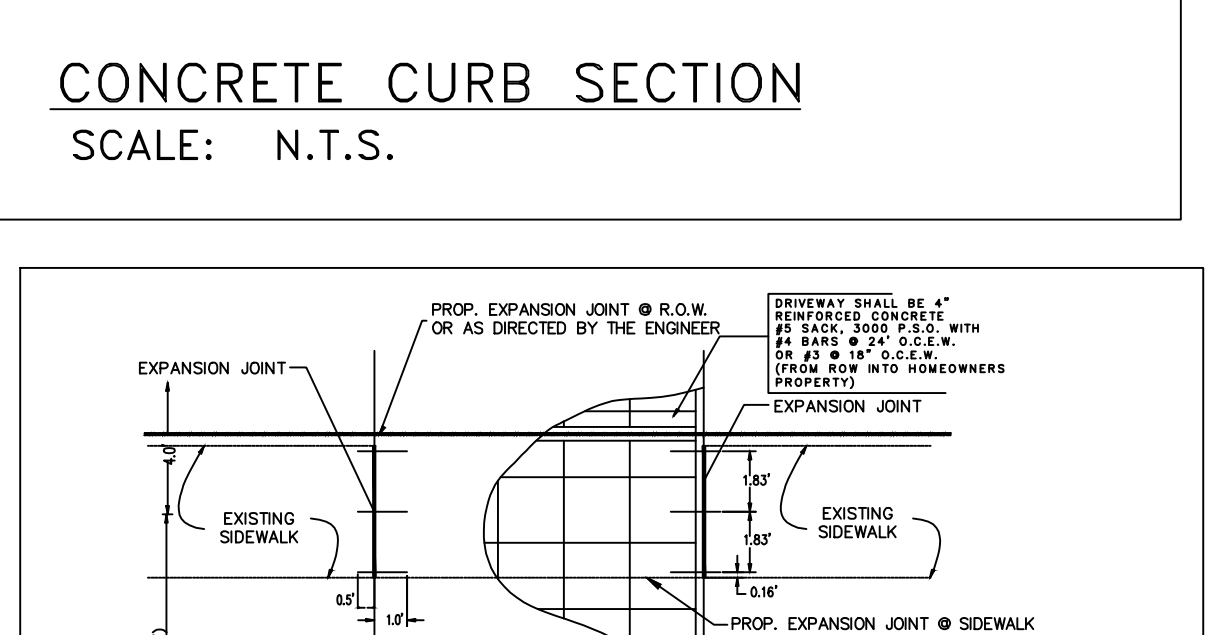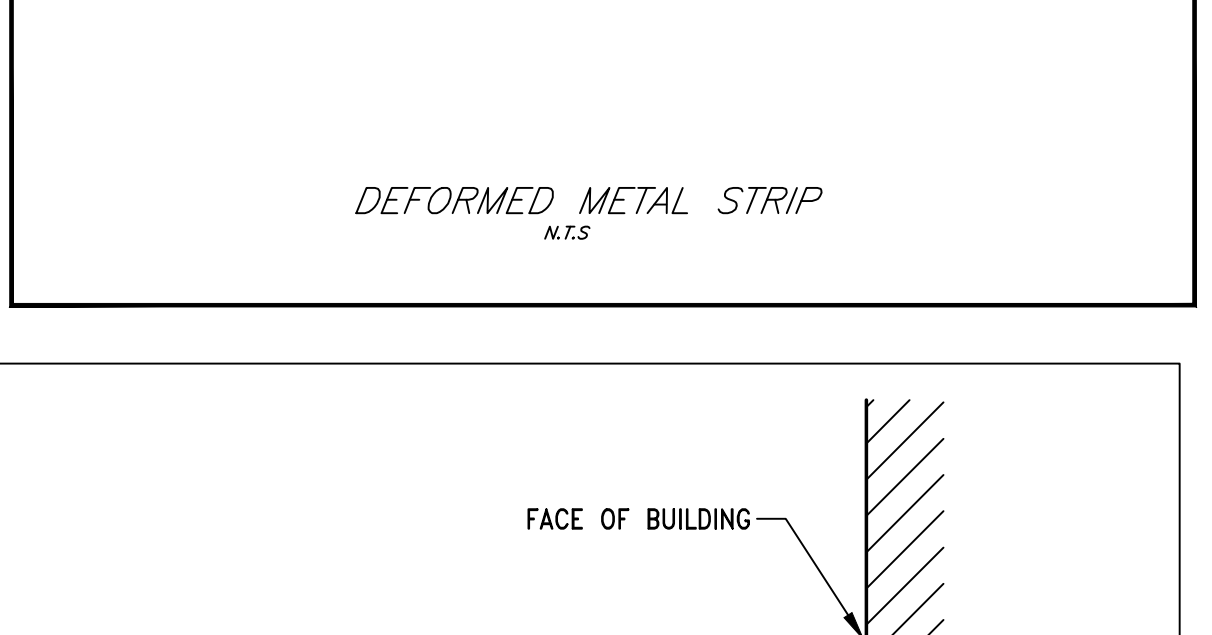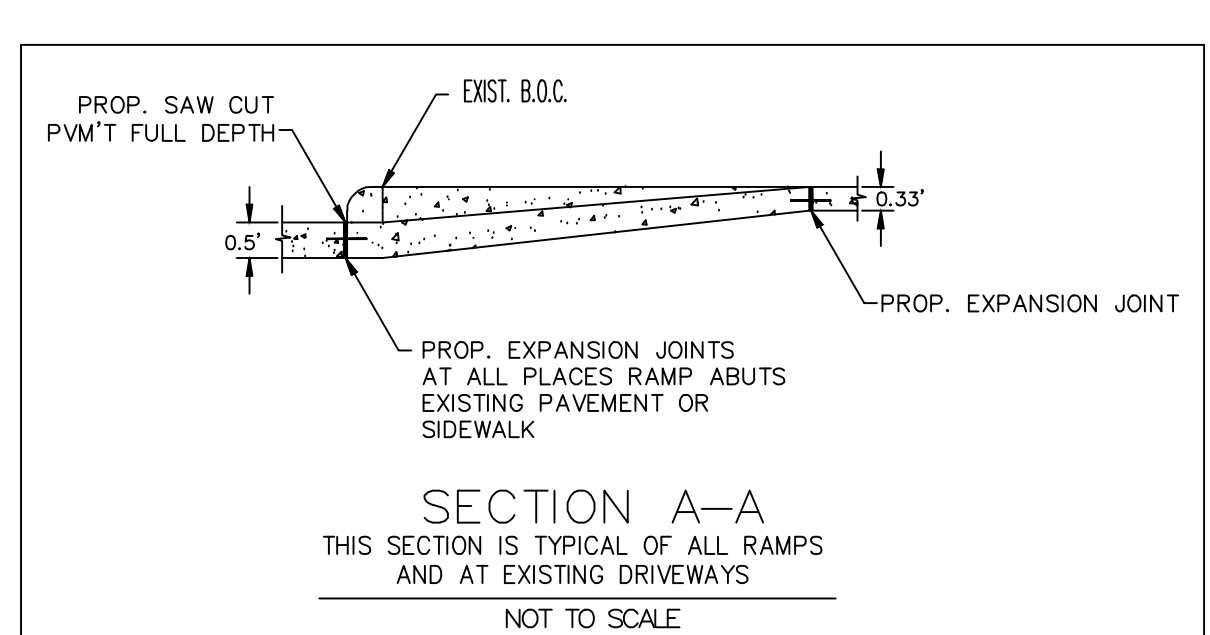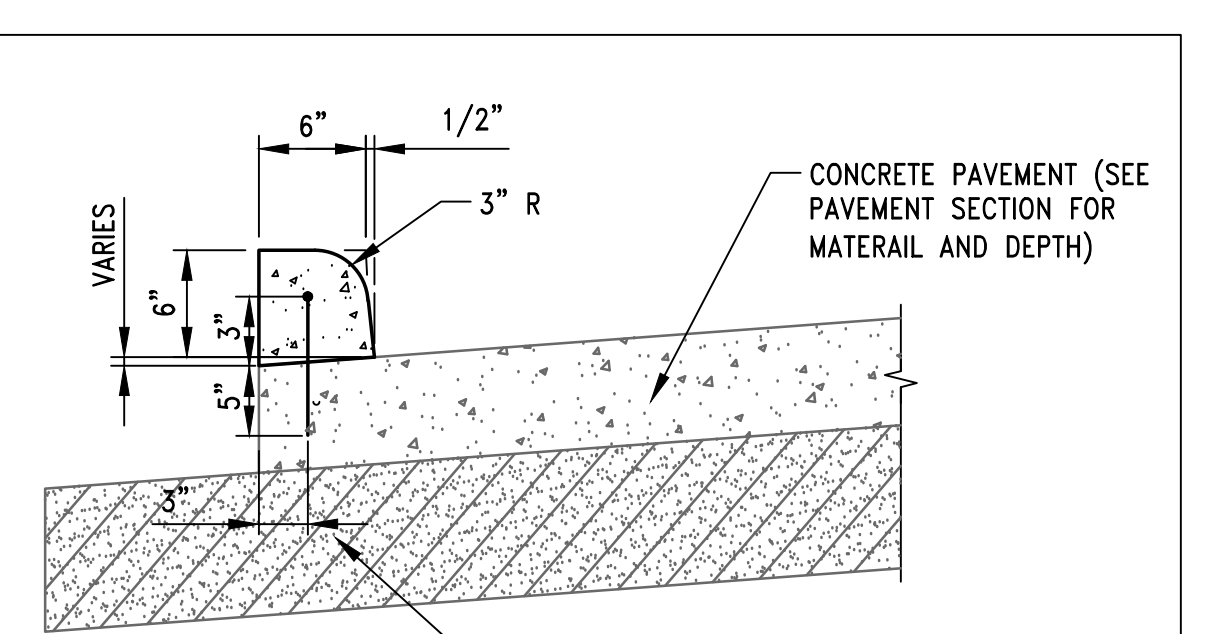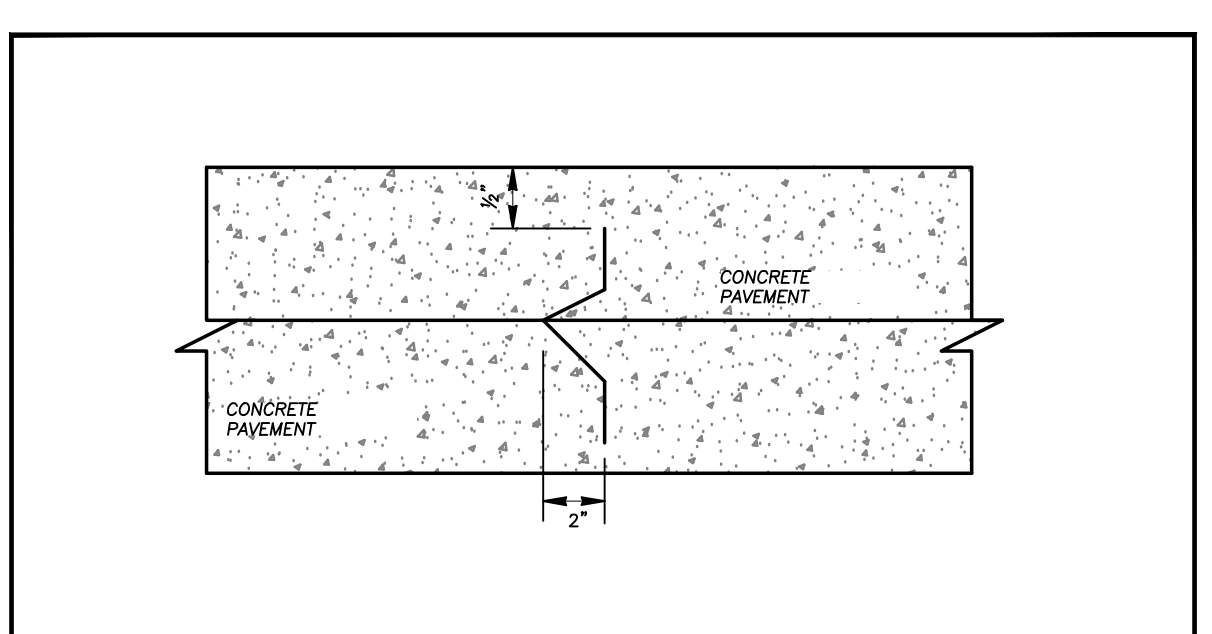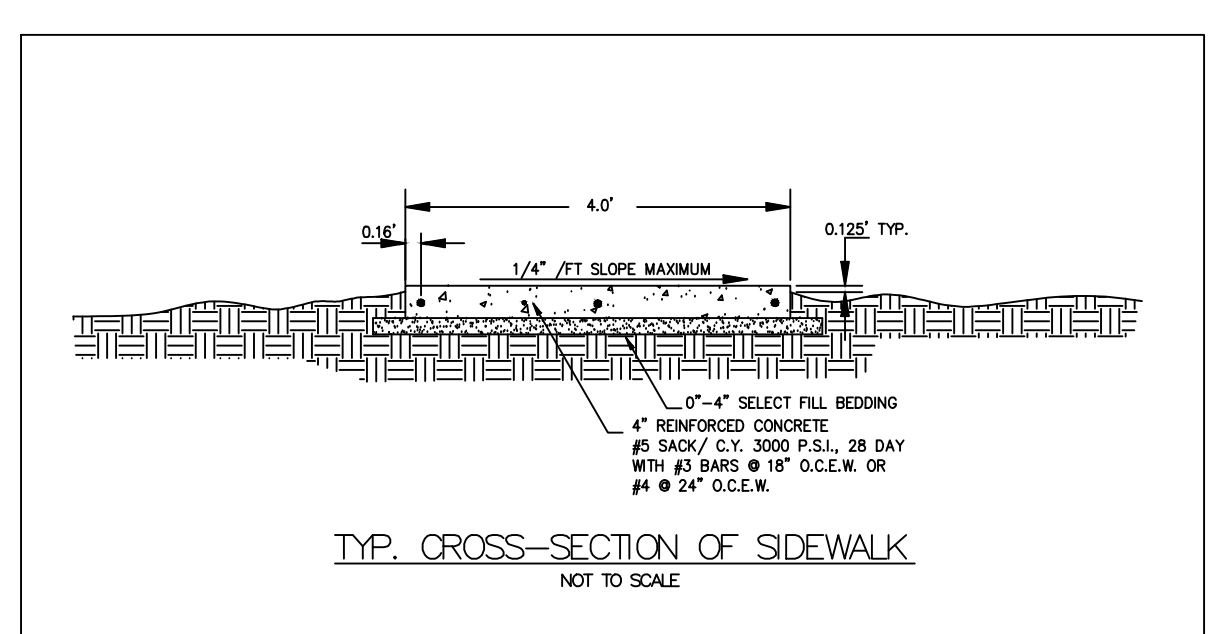


ONE - CALL NOTIFICATION SYSTM
CALL BEFORE YOU DIG!!!
(713) 223-4567 (in Houston, Tx)
(New Statewide Number Outside Houston)
1-800-545-6005

KEY PLAN (NOT TO SCALE)

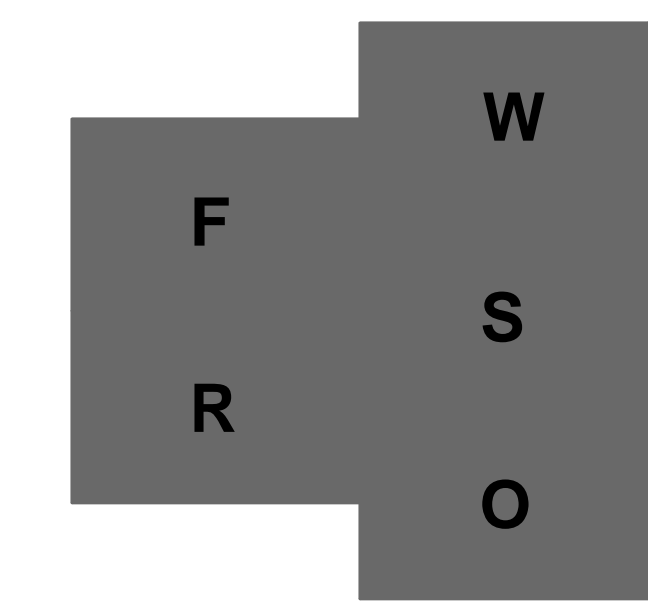

REVISION HISTORY

NO.	DESCRIPTION	DATE
1	ADDENDUM NO. 3	10-07-2020

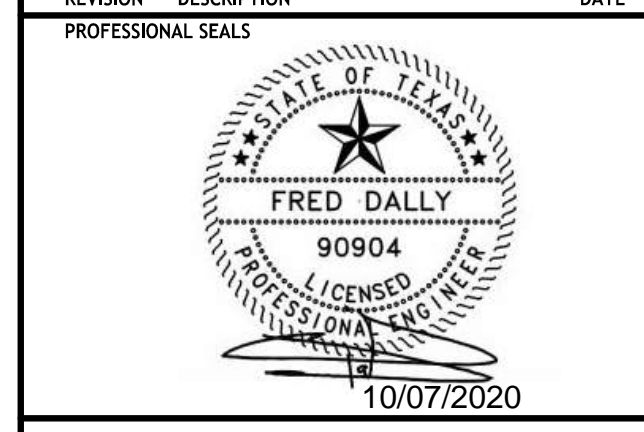

PAVEMENT DETAILS

DRAWN BY	CHECKED BY
JDM	JDM
PROJECT NUMBER	PROJECT ABBREVIATION
418198	GC_RBB
ORIGINAL ISSUE DATE	DATE
07/07/2020	07/07/2020

C9.0-PH1
SHEET NUMBER

Page Southerland Page, Inc.
1100 Louisiana, Suite One
Houston, TX 77002
page@psp.com

ARCHITECTURE / INTERIORS / PLANNING / CONSULTING
Austin / Dallas / Denver / Dubai / Houston / Mexico City /
San Francisco / Washington DC / International Affiliate Offices

Civil Engineering
Daily & Associates
9800 Richmond Avenue
Suite 400
Houston, TX 77042
713.337.8881

MEP Engineering
Page
1100 Louisiana
Suite One
Houston, TX 77002
713.871.8484

Structural Engineering
Daily & Associates
9800 Richmond Avenue
Suite 400
Houston, TX 77042
713.337.8881

Low Voltage & Security
4b Technology Group, LLC
390 Glenborough Dr.
Suite 200
Houston, TX 77067
832.249.9379

Landscape Architecture
Knudson, LP
6588 Katy Freeway
Suite 411
Houston, TX 77024
713.463.8200

Galveston County
Road & Bridge Department Facilities PH1
5115 Texas Highway 3
Dickinson, TX

GRATE SCHEDULE


SPECIFICATIONS

CONCRETE: Class 1 concrete with design strength of 4500 PSI at 28 days. Unit is of monolithic construction at floor and first stage of wall with sectional riser to required depth. Rated for H-20 Loading.

REINFORCEMENT: Grade 60 reinforced with steel rebar to conform to ASTM A615 on required centers or equal.

C.I. CASTINGS: CAST IRON FRAMES AND GRATES ARE MANUFACTURED OF GREY CAST IRON CONFORMING TO ASTM A48-76 CLASS 30.

DIMENSION SCHEDULE OF C-76 TONGUE & GROOVE PIPE

PIPE SIZE I.D.	O.D.	WT. / FT.	AVAILABLE LENGTHS	REINFORCEMENT	WALL THICKNESS WT	TONGUE LENGTH TL	GROOVE DEPTH GD	SLOT DIM A B	QUANTITY L.F.
12"	16"	100 LBS	4' OR 6'	W 2.0x2.5 3"x6"	2"	2"	2"	13x 14x	14x
15"	19 1/2"	125 LBS	4' OR 6'	W 2.0x2.5 3"x6"	2 1/2"	2 1/2"	2 1/2"	16x 16x	17x
18"	23"	160 LBS	4' OR 6'	W 2.0x2.5 3"x6"	3"	3"	3"	19x 19x	20x
24"	30"	260 LBS	4' OR 6'	W 2.0x2.5 3"x6"	3 1/2"	3 1/2"	3 1/2"	26x 26x	27x
30"	37 1/2"	395 LBS	6'	W 3.0x2.0 2"x6"	3 3/4"	3 3/4"	3 3/4"	31x 31x	33x
36"	44"	520 LBS	6'	W 3.5x2.0 2"x6"	4"	4"	4"	32x 32x	34x
42"	52"	743 LBS	6'	W 3.5x2.0 2"x6"	5"	4"	2 1/2"	52x 52x	52x
48"	58"	838 LBS	6'	W 3.5x2.0 2"x6"	5"	4 1/4"	4 1/4"	52x 52x	52x

SPECIFICATIONS

CONCRETE: CLASS 1 CONCRETE WITH DESIGN STRENGTH OF 4000 PSI AT 28 DAYS. UNIT IS OF MONOLITHIC CONSTRUCTION AND IS DESIGNED CONFORMING TO ASTM C-76 CLASS III, WALL B.

REINFORCEMENT: GRADE 60 REINFORCED, STEEL REBAR CONFORMING TO ASTM A615 ON REQUIRED CENTERS OR EQUAL.

C.I. CASTINGS: CAST IRON FRAMES AND GRATES ARE MANUFACTURED OF GREY CAST IRON CONFORMING TO ASTM A48-76 CLASS 30.

ISOMETRIC w/ OPTIONAL EXTENSIONS

KEYED NOTES

MARK/QT	DESCRIPTION
1	CAST IRON FRAME & COVER, FURNISHED LOOSE OR CAST-IN-PLACE PLATE (OPTIONAL)
2	OPTIONAL EXTENSION 6" OR 12"
3	PRECAST CONCRETE BASIN SECTION
4	RISER WALL KNOCKOUT ON ALL 4 SIDES. SEE KEY DIMENSION FOR MAXIMUM PIPE O.D. CASSETT
5	BRACKET FOR FLOAT SWITCH (OPTIONAL)
6	BRACKET FOR FLOAT SWITCH FOR PUMP SHUT-DOWN @ HIGH LEVEL
7	MANHOLE INDICATING: MFC: PARKUSA 888-611-PARK WWW.PARKUSA.COM MODEL: JBC-1 DATE MANUFACTURED
8	

SPECIFICATIONS

CONCRETE: CLASS 1/2 CONCRETE WITH DESIGN STRENGTH OF 4500 PSI AT 28 DAYS. UNIT IS OF MONOLITHIC CONSTRUCTION AT FLOOR AND FIRST STAGE OF WALL WITH SECTIONAL RISER TO REQUIRED DEPTH.

REINFORCEMENT: GRADE 60 REINFORCED, STEEL REBAR CONFORMING TO ASTM A615 ON REQUIRED CENTERS OR EQUAL.

C.I. CASTINGS: CAST IRON FRAMES AND GRATES ARE MANUFACTURED OF GREY CAST IRON CONFORMING TO ASTM A48-76 CLASS 30.

ISOMETRIC VIEW

SECTION VIEW

KEYED NOTES

MARK/QT	DESCRIPTION
1	CAST IRON FRAME & GRATE
2	PRECAST CONCRETE BASIN SECTION
3	RISER WALL KNOCKOUT ON ALL 4 SIDES. SEE KEY DIMENSION FOR MAXIMUM PIPE O.D.
4	MFC: PARKUSA 888-611-PARK WWW.PARKUSA.COM MODEL: JBC-1
5	

SPECIFICATIONS

CONCRETE: CLASS 1/2 CONCRETE WITH DESIGN STRENGTH OF 4500 PSI AT 28 DAYS. UNIT IS OF MONOLITHIC CONSTRUCTION AT FLOOR AND FIRST STAGE OF WALL WITH SECTIONAL RISER TO REQUIRED DEPTH. RATED FOR H-20 LOADING.

REINFORCEMENT: GRADE 60 REINFORCED WITH STEEL REBAR TO CONFORM TO ASTM A615 ON REQUIRED CENTERS OR EQUAL.

C.I. CASTINGS: CAST IRON FRAMES AND GRATES ARE MANUFACTURED OF GREY CAST IRON CONFORMING TO ASTM A48-76 CLASS 30.

ADS

ADS N-12® ST IB PIPE (PER AASHTO) SPECIFICATION

SCOPE
This specification describes 4- through 60-inch (100 to 1500 mm) ADS N-12 ST IB pipe (per AASHTO) for use in gravity flow drainage applications.

PIPE REQUIREMENTS
N-12 ST IB pipe (per AASHTO) shall have a smooth interior and annular exterior corrugations.
• 4- through 10-inch (100 to 250 mm) shall meet AASHTO M252, Type S
• 12- through 60-inch (300 to 1500 mm) shall meet AASHTO M294, Type S or ASTM F2306
• Manning's "n" value for use in design shall be 0.012

JOINT PERFORMANCE
Pipe shall be joined using a bell-and-spigot joint meeting AASHTO M252, AASHTO M294, or ASTM F2306. The joint shall be soil-tight and gaskets, when applicable, shall meet the requirements of ASTM F477. Gaskets shall be installed by the pipe manufacturer and covered with a removable wrap to ensure the gasket is free from debris. A joint lubricant supplied by the manufacturer shall be used on the gasket and bell during assembly.

FITTINGS
Fittings shall conform to AASHTO M252, AASHTO M294 or ASTM F2306. Bell and spigot connections shall utilize a grommet or welded bell and valve or saddle gasket meeting the soil-tight joint performance requirements of AASHTO M252, AASHTO M294 or ASTM F2306.

MATERIAL PROPERTIES
Virgin material for pipe and fitting production shall be high-density polyethylene conforming with the minimum requirements of cell classification 4244200 for 4- through 10-inch (100 to 250 mm) diameters, or 435400C for 12- through 60-inch (300 to 1500 mm) diameters, as defined and described in the latest version of ASTM D3350, except that carbon black content should not exceed 4%. The 12- through 60-inch (300 to 1500 mm) virgin pipe material shall comply with the notched constant ligament-stress (NCLS) test as specified in Sections 9.5 and 5.1 of AASHTO M294 and ASTM F2306, respectively.

INSTALLATION
Installation shall be in accordance with ASTM D2321 and ADS published installation guidelines, with the exception that minimum cover in trafficked areas for 4- through 48-inch (100 to 1200 mm) diameters shall be one foot (0.3 m) and for 54- and 60-inch (1350-1500 mm) diameters, the minimum cover shall be 2 feet (0.6 m) in single run applications. Backfill for minimum cover situations shall consist of Class 1, Class 2 (minimum 90% SPD) or Class 3 (minimum 90% SPD) material. Maximum fill heights depend on embedment material and compaction levels; please refer to Technical Note 2.01. Contact your local ADS representative or visit our website at www.ads-pipe.com for a copy of the latest installation guidelines.

PIPE DIMENSIONS

Normal Pipe I.D. x W. (mm)	4	6	8	10	12	15	18	24	30	36	42	48	54	60
Normal Pipe O.D. x H. (mm)	122	175	231	290	350	375	450	600	750	900	1050	1200	1350	1500

PERFORMANCE
All diameters available with or without perforations.

RECOMMENDED MINIMUM TRENCH WIDTHS

PIPE DIAM.	MIN. TRENCH WIDTH
4"	21"
6"	23"
8"	26"
10"	28"
12"	30"
15"	34"
18"	39"
24"	48"
30"	58"
36"	64"
42"	72"
48"	80"
54"	88"
60"	98"

MINIMUM RECOMMENDED COVER BASED ON SURFACE LIVE LOADING CONDITION (75% AXLE LOAD)*

PIPE DIAM.	COVER
12"-48"	12"
54"-60"	24"
60"	48"

MINIMUM RECOMMENDED COVER BASED ON RAILWAY LOADING CONDITION (E-80)**

PIPE DIAM.	COVER
UP TO 24"	24"
30"-36"	36"
42"-60"	48"

NOTES

- ALL PIPE SYSTEMS SHALL BE INSTALLED IN ACCORDANCE WITH ASTM D2321, "STANDARD PRACTICE FOR UNDERGROUND INSTALLATION OF THERMOPLASTIC PIPE FOR SEWERS AND OTHER GRAVITY FLOW APPLICATIONS"; LATEST EDITION.
- MEASURES SHOULD BE TAKEN TO PREVENT MIGRATION OF NATIVE FINES INTO BACKFILL MATERIAL, WHEN REQUIRED.
- FOUNDATION: WHERE THE TRENCH BOTTOM IS UNSTABLE, THE CONTRACTOR SHALL EXCAVATE TO A DEPTH REQUIRED BY THE ENGINEER AND REPLACE WITH SUITABLE MATERIAL AS SPECIFIED BY THE ENGINEER. AS AN ALTERNATIVE AND AT THE DISCRETION OF THE DESIGN ENGINEER, THE TRENCH BOTTOM MAY BE STABILIZED USING A GEOTEXTILE MATERIAL.
- BACKFILL: SUITABLE MATERIAL SHALL BE CLASS II OR III. THE CONTRACTOR SHALL PROVIDE DOCUMENTATION FOR MATERIAL SPECIFICATION TO ENGINEER, UNLESS OTHERWISE NOTED BY THE ENGINEER. MINIMUM BEDDING THICKNESS SHALL BE 4" (100mm) FOR 4"-24" (100mm-600mm), 6" (150mm) FOR 30"-60" (750mm-1500mm).
- INITIAL BACKFILL: SUITABLE MATERIAL SHALL BE CLASS II OR III IN THE PIPE ZONE EXTENDING NOT LESS THAN 8' ABOVE CROWN OF PIPE. THE CONTRACTOR SHALL PROVIDE DOCUMENTATION FOR MATERIAL SPECIFICATION TO ENGINEER. MATERIAL SHALL BE INSTALLED AS REQUIRED IN ASTM D2321, LATEST EDITION.
- MINIMUM COVER: MINIMUM COVER, H, IN NON-TRAFFIC APPLICATIONS (GRASS OR LANDSCAPE AREAS) IS 12" FROM THE TOP OF PIPE TO GROUND SURFACE. ADDITIONAL COVER MAY BE REQUIRED TO PREVENT FLOUTING. FOR TRAFFIC APPLICATIONS, MINIMUM COVER, H, IS 12" UP TO 48" DIAMETER PIPE AND 24" OF COVER FOR 54"-60" DIAMETER PIPE, MEASURED FROM TOP OF PIPE TO BOTTOM OF FLEXIBLE PAVEMENT OR TO TOP OF RIGID PAVEMENT.


NOTE
INJECTION MOLDED FITTINGS ARE AVAILABLE IN TEEL WYES, REDUCERS, 45° BENDS AND BELLBELL COUPLERS.
WATERTIGHT (WT) JOINTS SHOWN. SOIL-TIGHT (ST) FITTINGS ARE ALSO AVAILABLE.

KEY PLAN (NOT TO SCALE)

REVISION HISTORY

NO.	DATE	DESCRIPTION
1	10-07-2020	ADDENDUM NO. 3

ONE- CALL NOTIFICATION SYSTEM
CALL BEFORE YOU DIG!!!
(713) 223-4567 (in Houston, Tx)
(New Statelwide Number Outside Houston)
1-800-545-6005

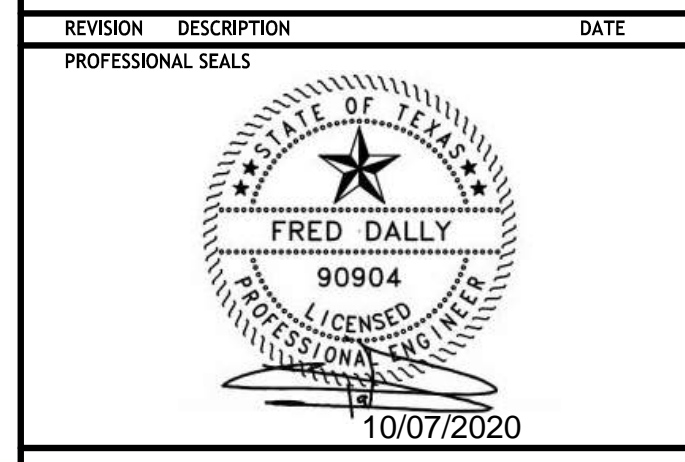

KEY PLAN (NOT TO SCALE)

W
F
S
R
O


STORM DRAIN DETAILS

DRAWN BY: JDM
PROJECT NUMBER: 478198
ISSUE FOR PERMIT: 07 OCT 2020


CHECKED BY: JDM
PROJECT ABBREVIATION: GC_RBB
DATE: 07 OCT 2020

C10.0-PH1
SHEET NUMBER


Galveston County
Road & Bridge Department Facilities PH1
5115 Texas Highway 3
Dickinson, TX

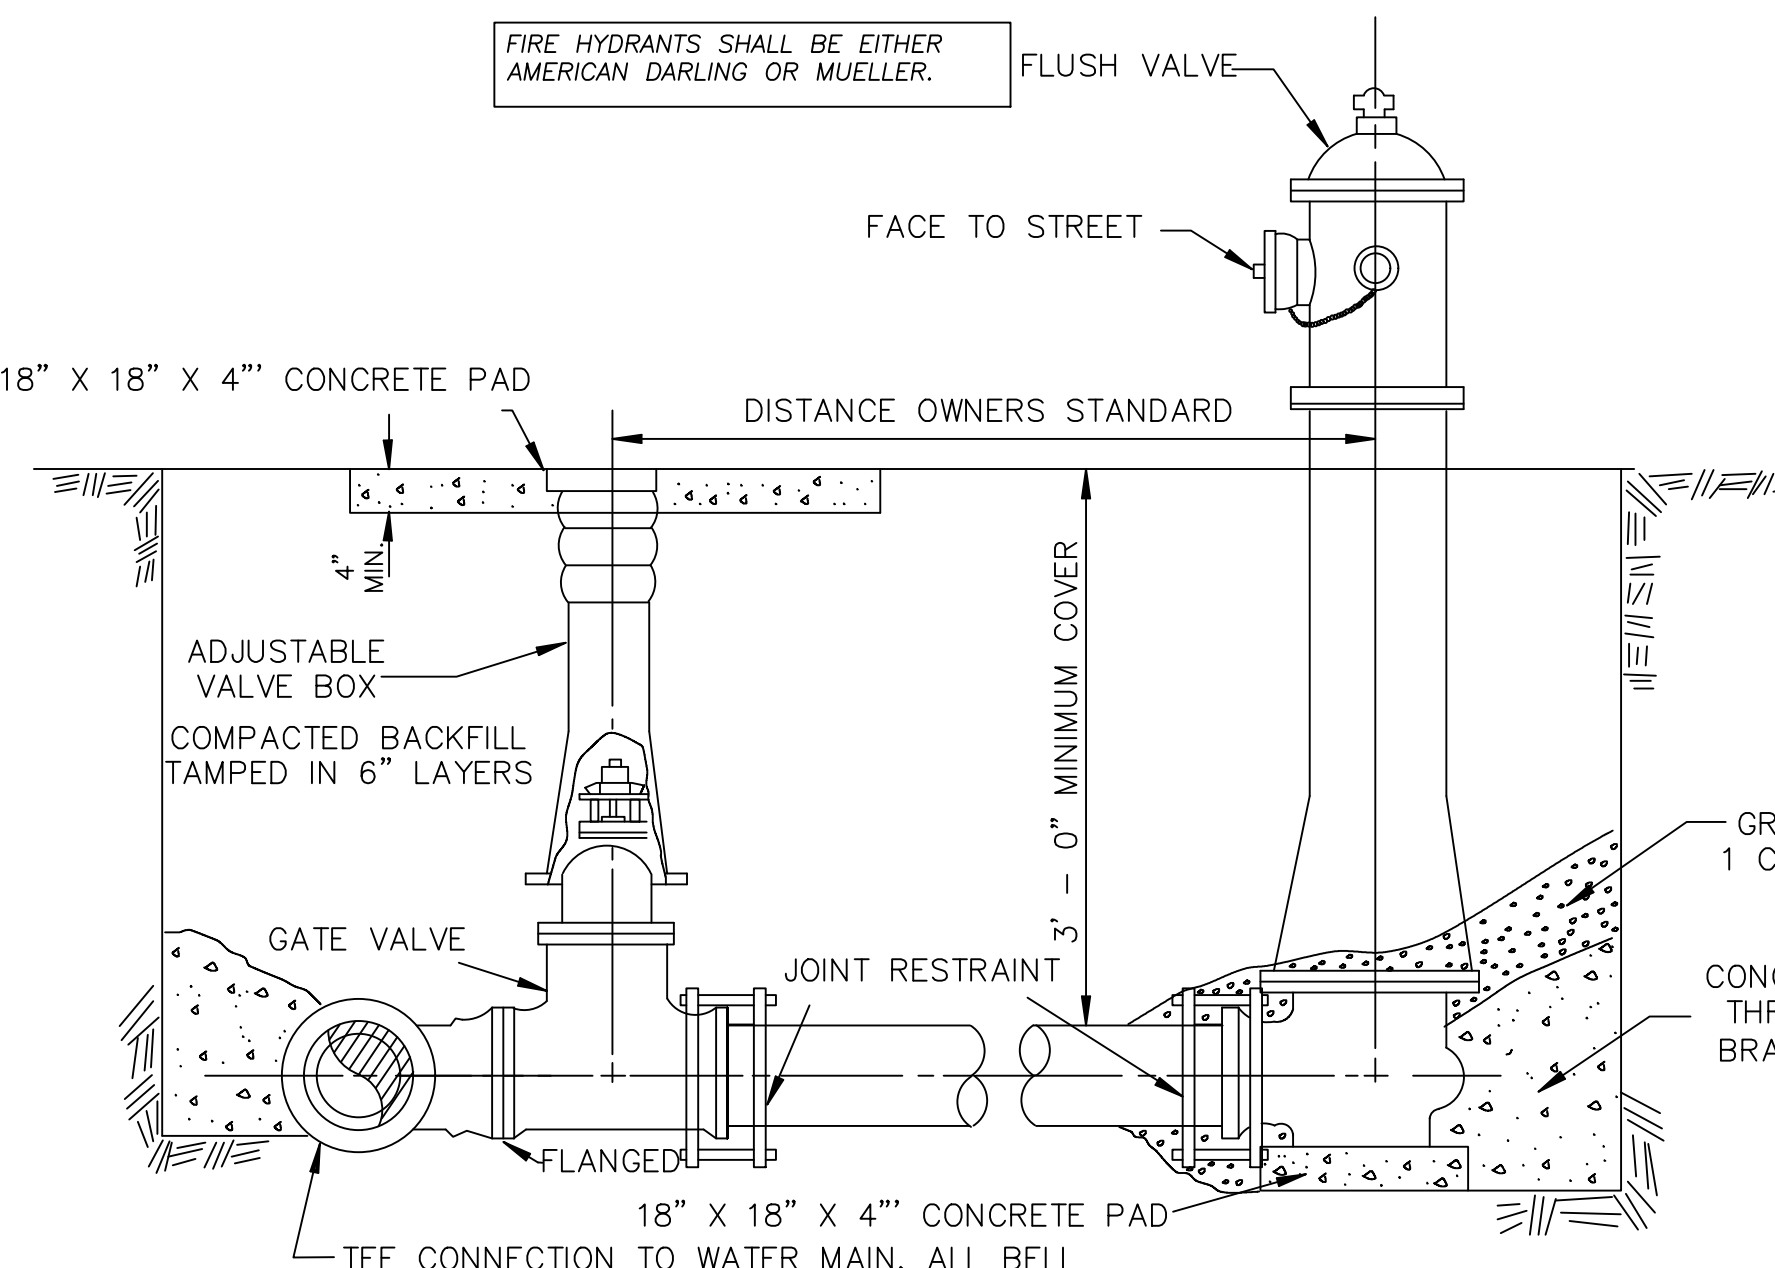


TYPICAL GATE VALVE AND FLUSH VALVE DETAILS

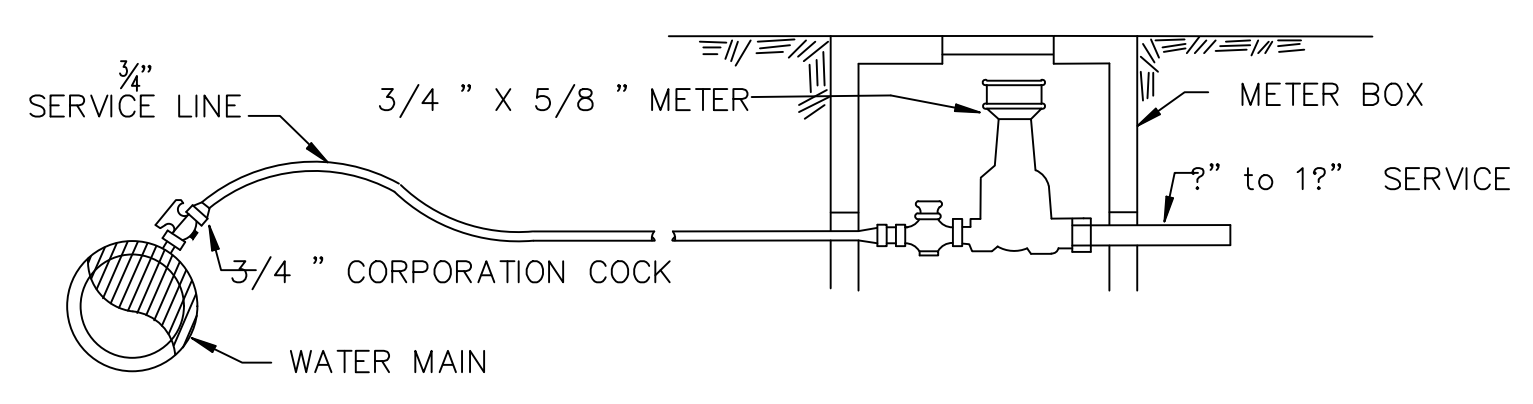


SMALL METER INSTALLATION (UP TO 1 1/2\"/>

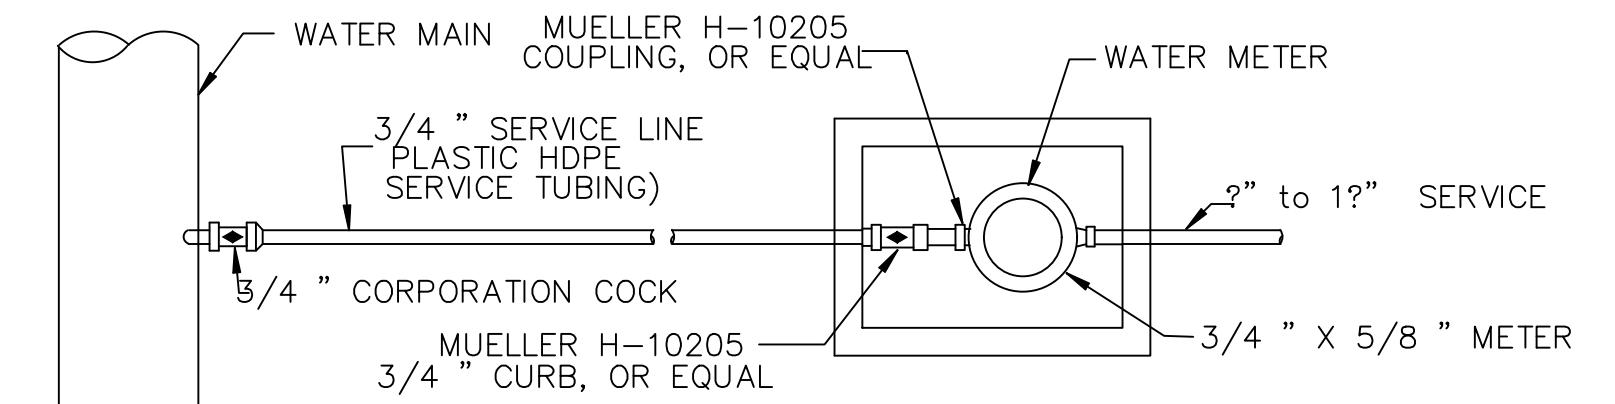


ENCASEMENT SPACER DETAILS

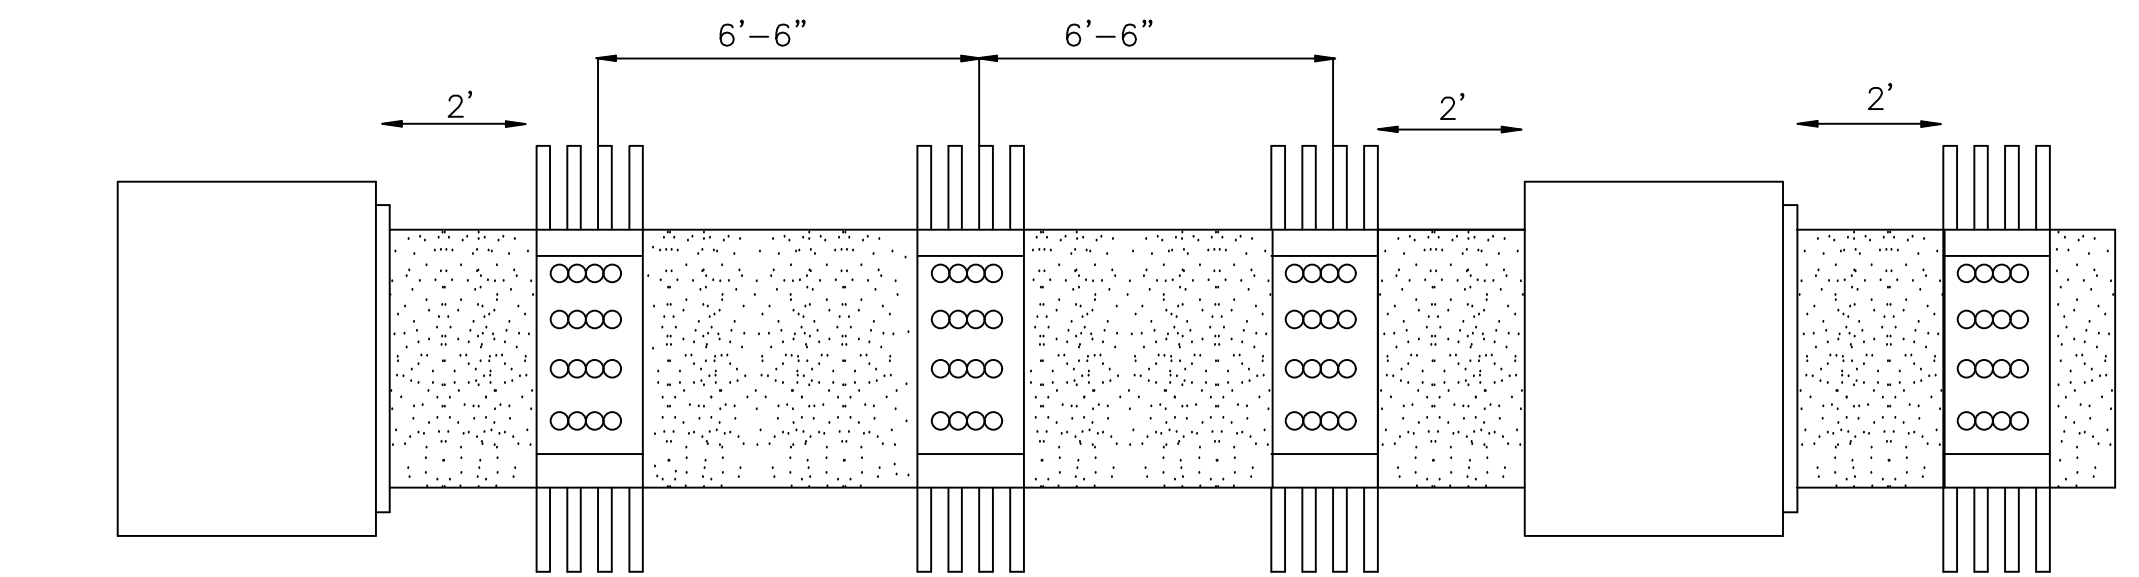


SPACING DETAILS

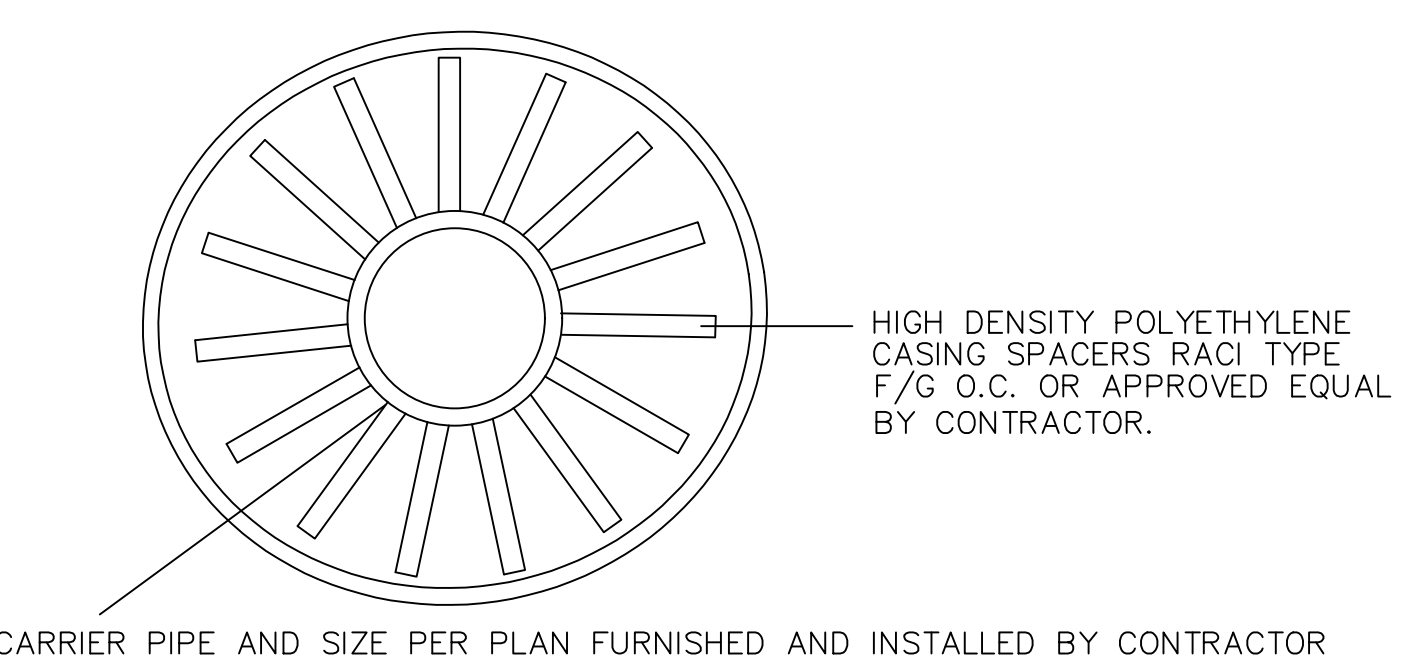


DR 18 C900 PVC PIPE		SDR 35 PVC SEWER PIPE	
PIPE SIZE	RACI SPACERS	PIPE SIZE	RACI SPACER
4"	2F OR 2N	6"	2F, 1G OR 1M, 1N OR 1E, 2H OR 2P, 1Q
6"	2F, 1G OR 2M OR 1E, 1H OR 2P	8"	3F, 1G OR 1M, 2N OR 2E, 1H OR 2P, 1Q
8"	3F, 1G OR 2M, 1N OR 2E, 1H OR 2P, 1Q	10"	4F OR 3M OR 3E OR 3P
10"	4F OR 3M OR 3E OR 3P	12"	5F OR 3M, 2N OR 3E, 1H OR 2P, 2Q
12"	5F OR 3M, 1N OR 3E, 1H OR 3P, 1Q	15"	6F OR 3M, 2N OR 4E, OR 3P, 2Q
14"	6F OR 4M OR 4E OR 4P	18"	7F OR 5M, OR 5E OR 5P
16"	7F OR 5M, OR 4E, 1H OR 5P		

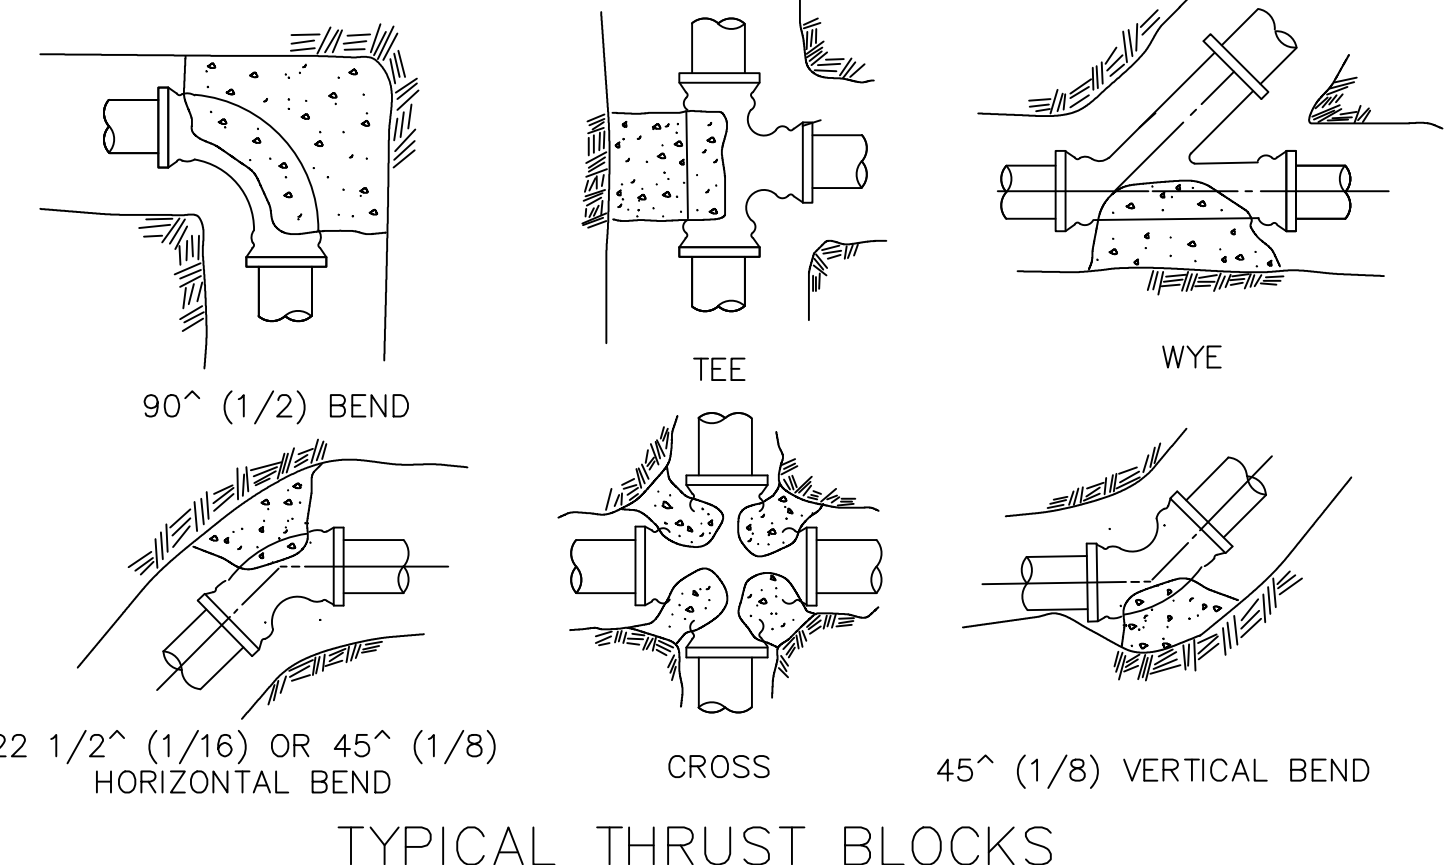

TYPICAL THRUST BLOCKS

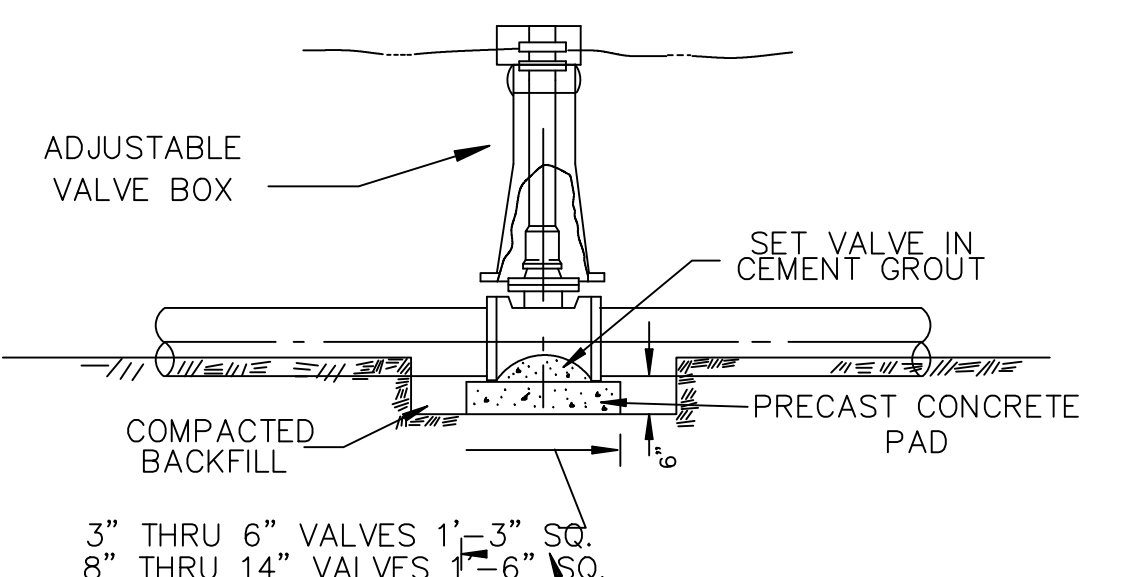


BLOCKING FOR VALVES


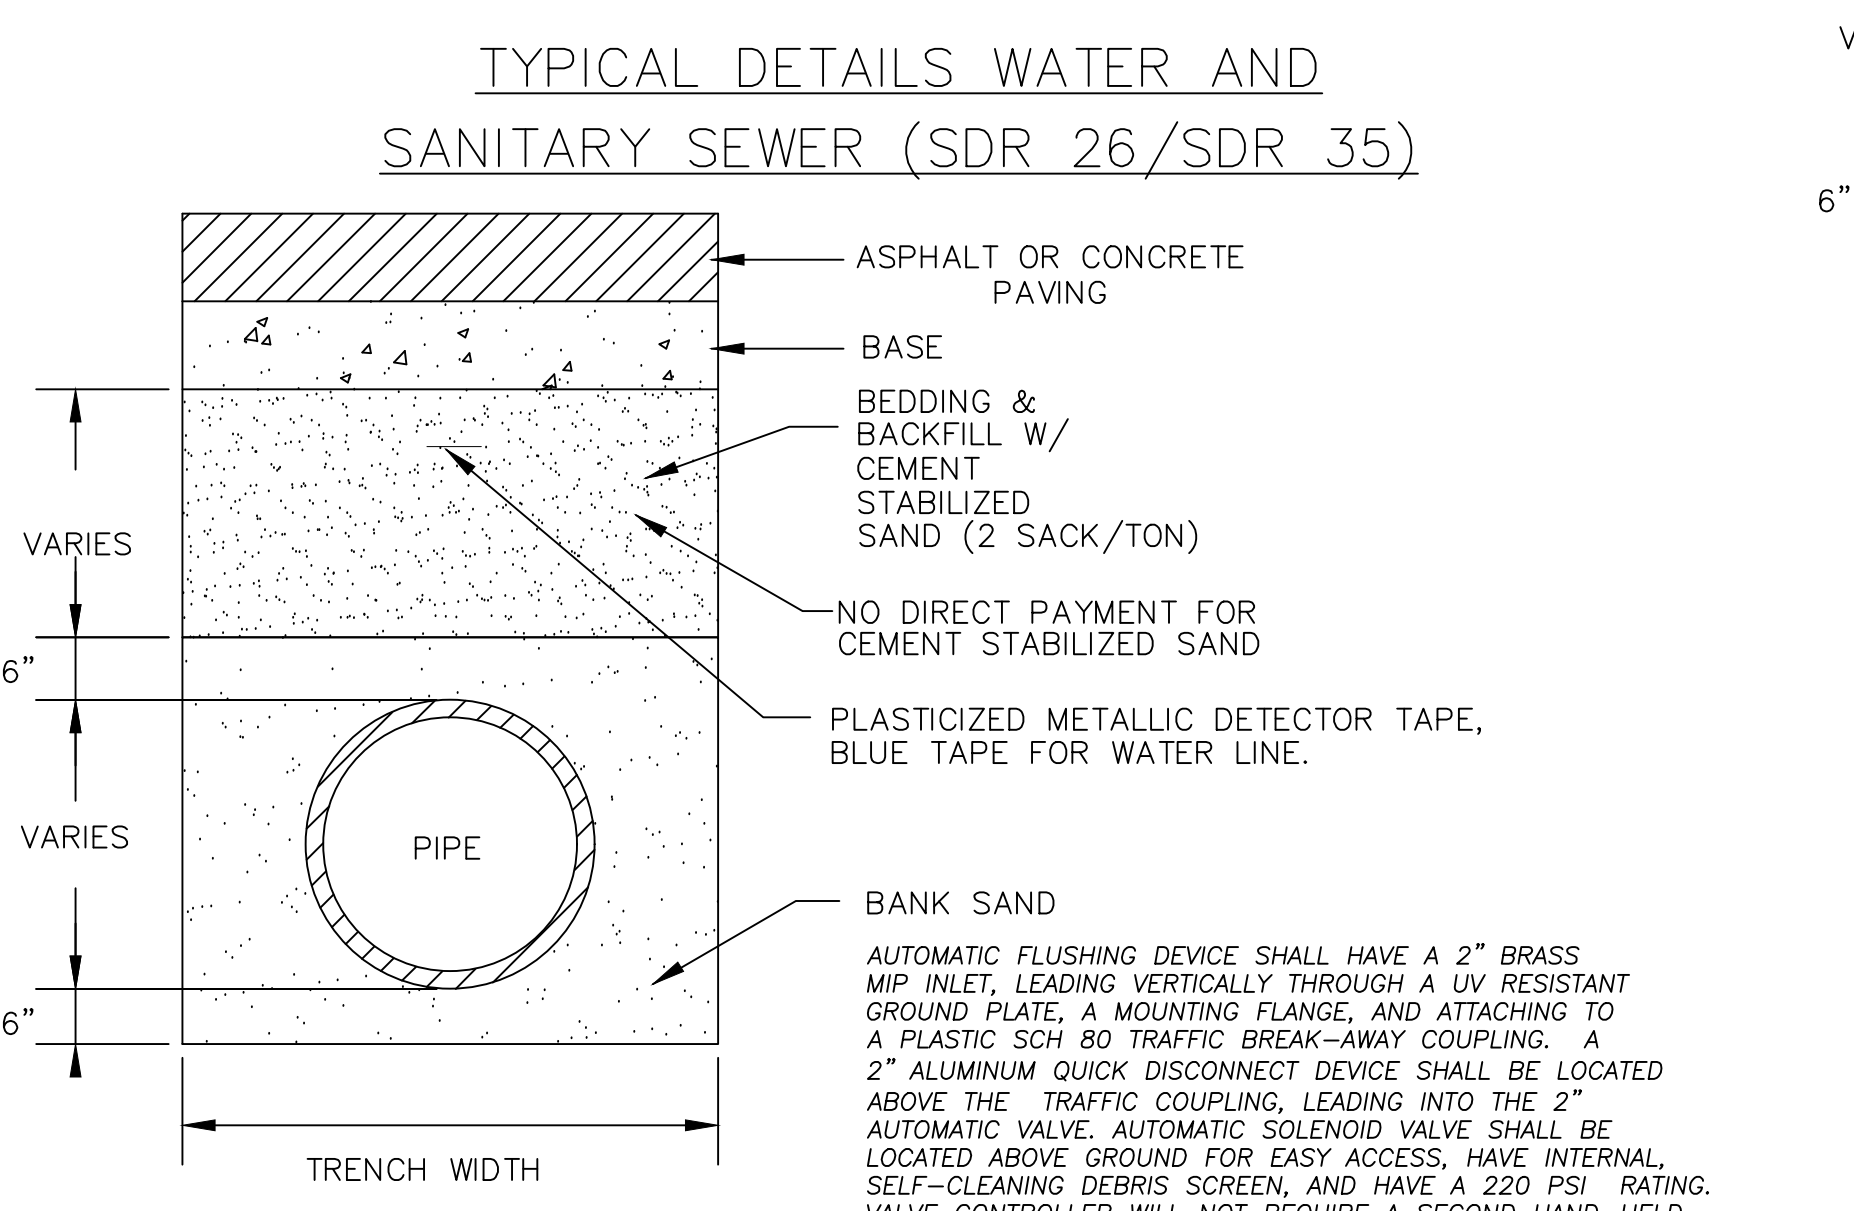


BACKFILL DETAIL WATERLINE UNDER PAVEMENT

MODEL	SIZE	BYPASS	L1	W1	H1	WEIGHT LBS.
DMC-BT2	2"	1"	6'-0"	3'-6"	4'-0"	12,000
DMC-BT3	3"	1 1/2"	8'-0"	5'-0"	4'-0"	15,000
DMC-BT4	4"	2"	8'-0"	5'-0"	4'-0"	15,000
DMC-BT4	4"	2"	11'-0"	6'-0"	4'-0"	18,000
DMC-BT6	6"	3"	13'-0"	7'-0"	4'-3"	25,000

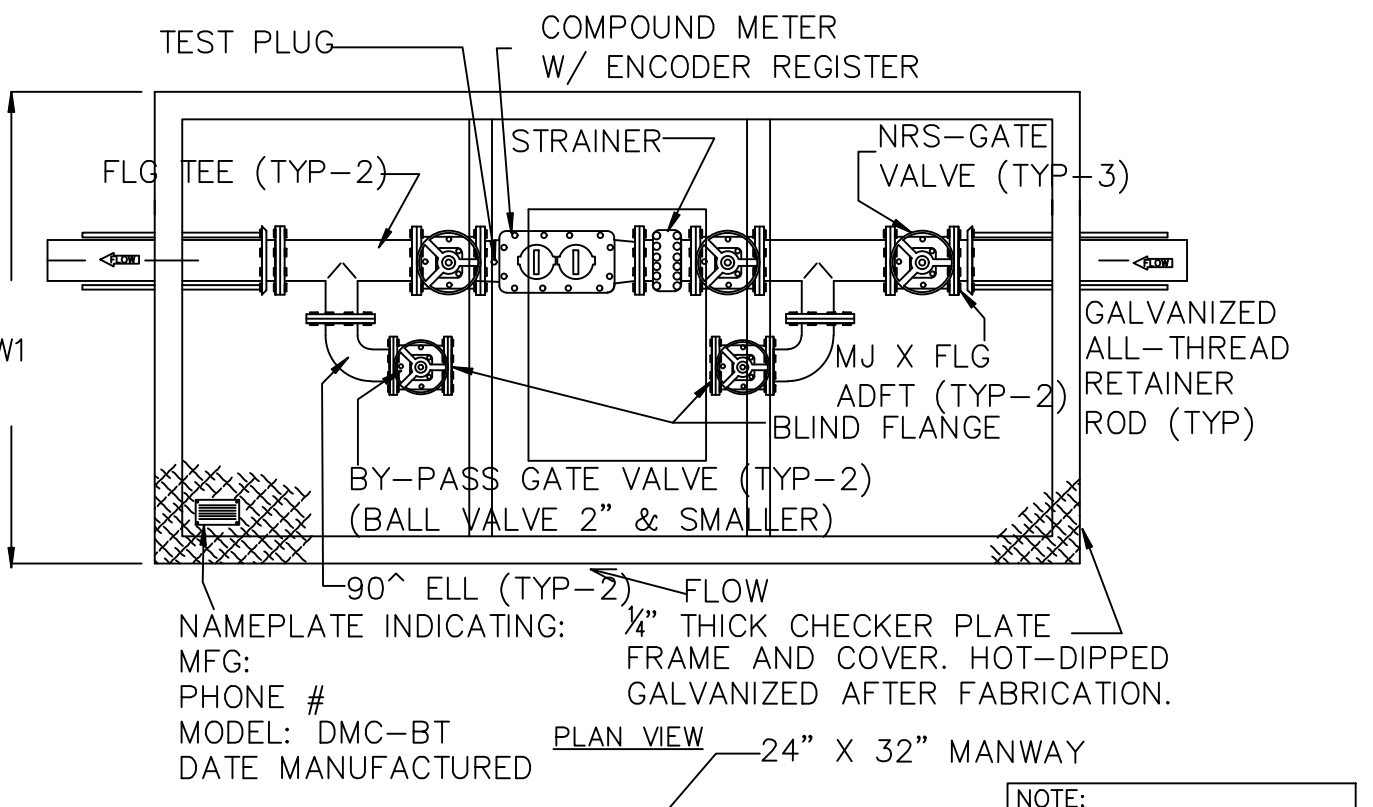


LARGE METER INSTALLATION (2\"/>

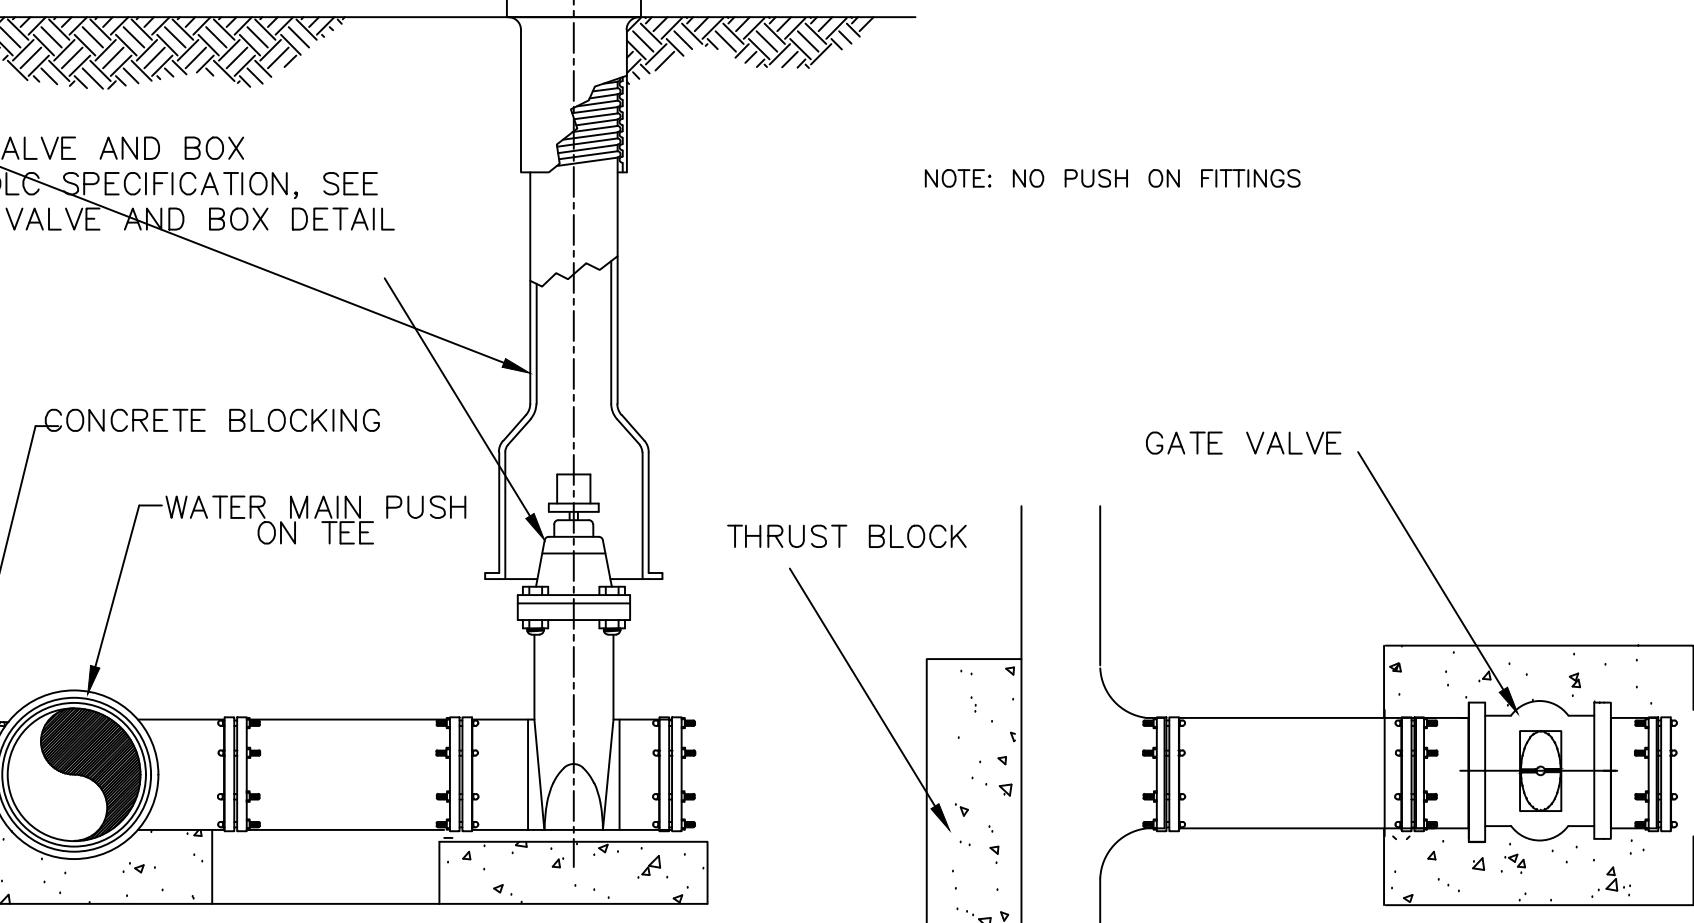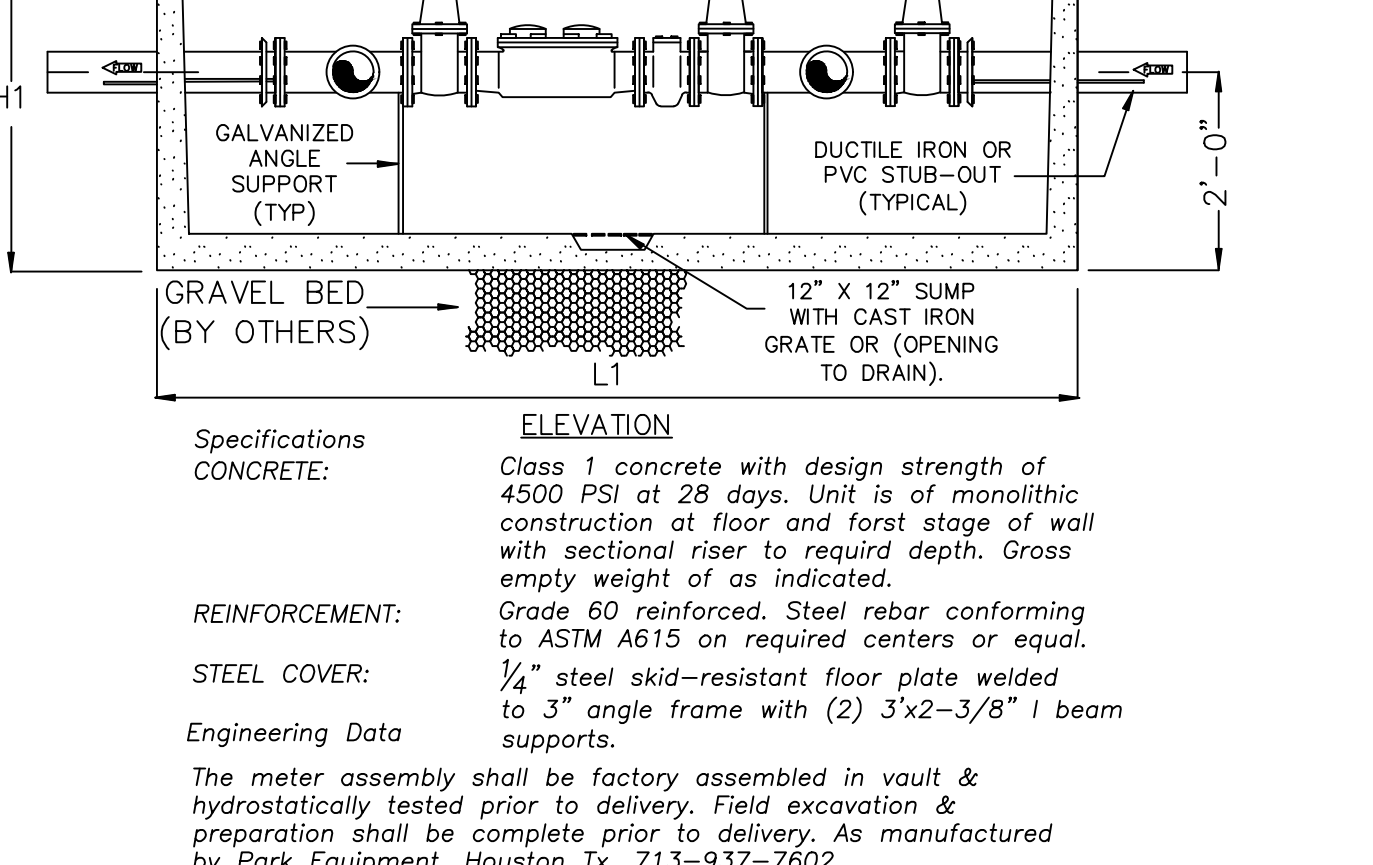


BLOCKING FOR GATE VALVES


- NOTES: 1. ALL MATERIALS AND COATINGS TO BE IN ACCORDANCE WITH ENGINEERING DEPARTMENT SPECIFICATIONS. 2. INSULATED JOINT TO BE MADE UP USING INSULATING GASKETS, PLASTIC BOLT SLEEVES AND WASHERS OF INSULATING GASKET MATERIAL BACKED WITH ZINC-PLATED WASHERS, OR OTHER METHODS APPROVED SPECIFICALLY BY THE ENGINEERING DEPARTMENT. 3. NO FIELD FABRICATION OF STEEL WATER PIPE OFFSETS ALLOWED. 4. OFFSET SECTIONS SHALL BE THRUST-BLOCKED IN ACCORDANCE WITH DETAIL SHEET NO. MC-11-03, IF NECESSARY ALL THREAD RODS SHALL BE USED TO RESTRAIN THE JOINTS.

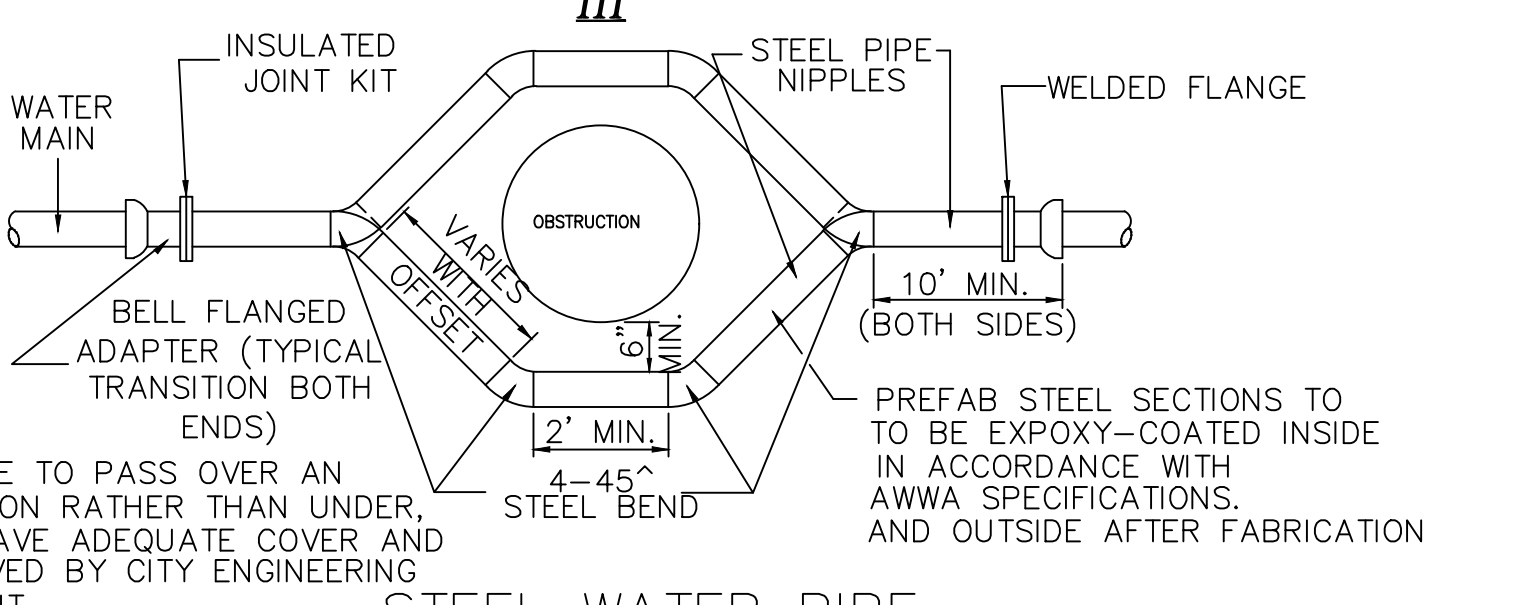

STEEL WATER PIPE OFFSET ASSEMBLY

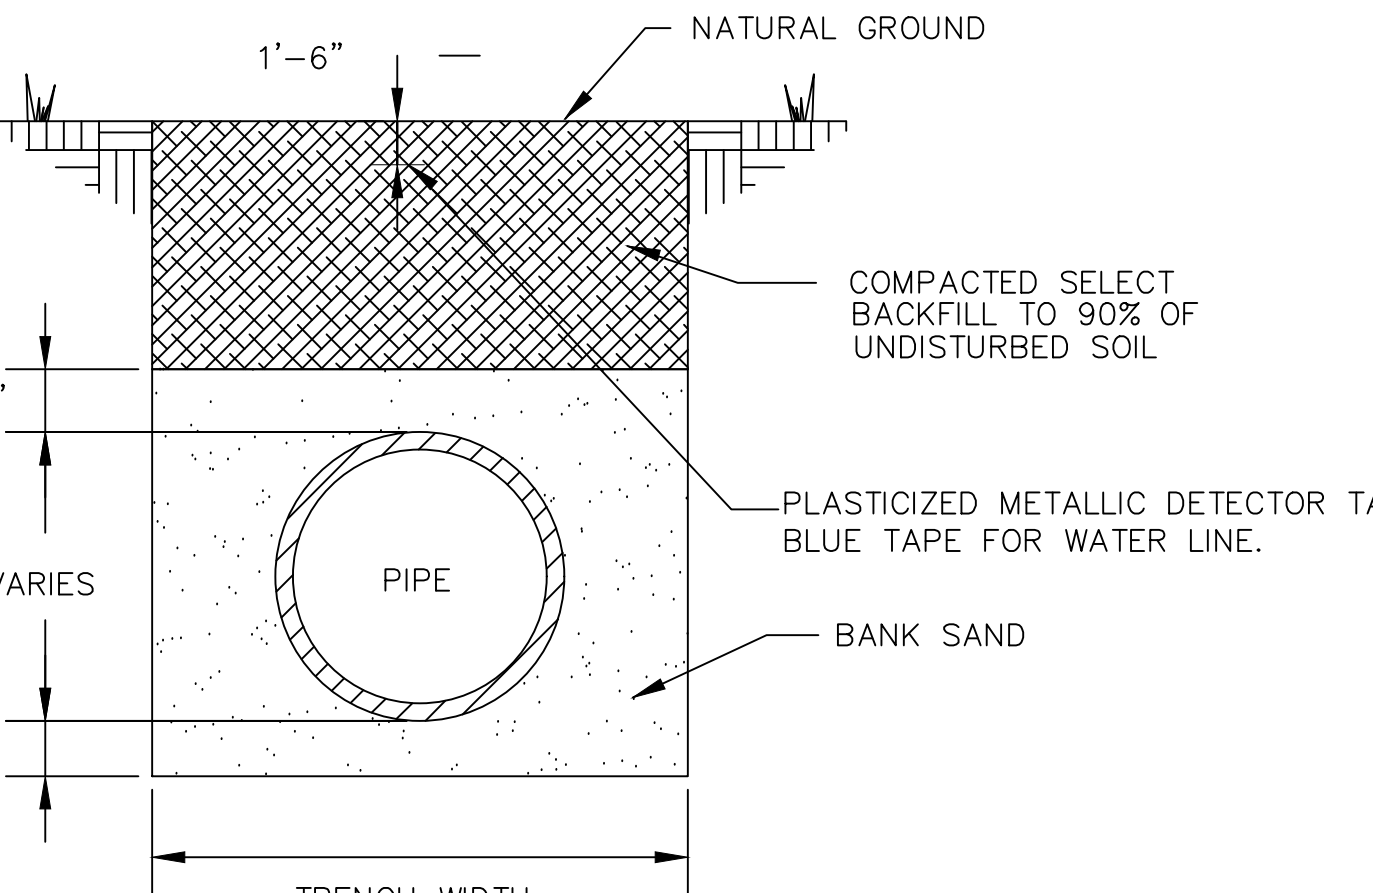


BACKFILL DETAIL NOT UNDER PAVEMENT

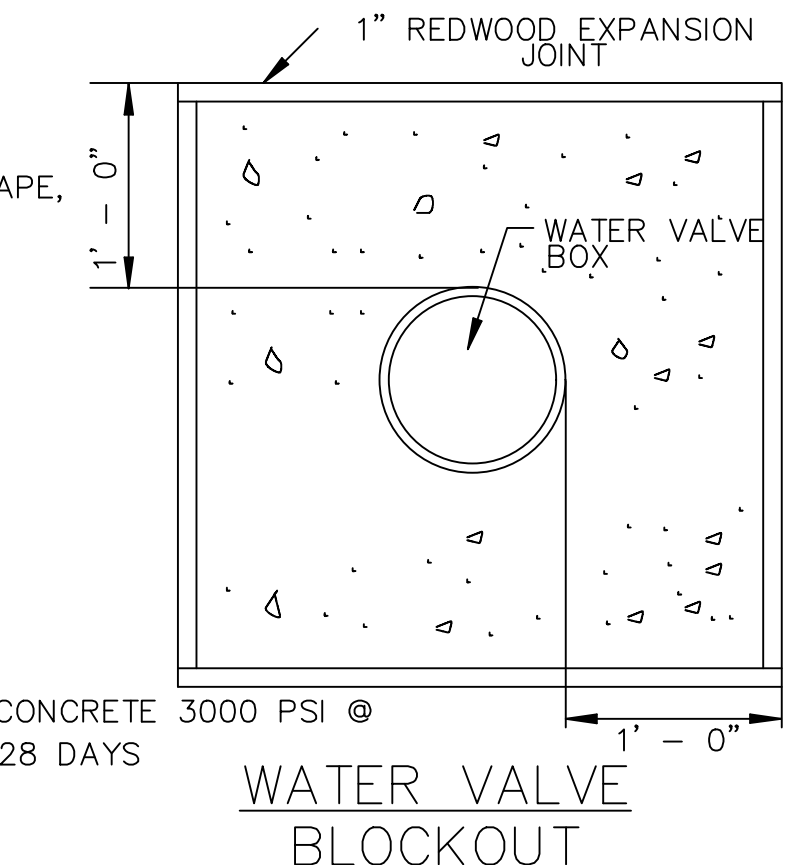


WATER VALVE BLOCKOUT

FITTING SIZE	TEES & PLUGS		90° BEND		45° BENDS & WYES	
	H	W	H	W	H	W
4"	1'-7"	1'-2"	1'-9"	1'-6"	1'-8"	0'-10"
6"	2'-0"	1'-11"	2'-5"	2'-2"	1'-10"	1'-7"
8"	2'-8"	2'-6"	3'-2"	3'-0"	2'-5"	2'-1"
10"	3'-4"	3'-3"	4'-0"	3'-10"	3'-0"	2'-9"
12"	4'-0"	3'-10"	4'-8"	4'-8"	3'-8"	3'-3"
14"	5'-5"	3'-10"	6'-6"	4'-11"	4'-3"	3'-5"
20"	5'-0"	5'-0"	6'-0"	6'-0"	5'-0"	4'-0"
24"	6'-0"	6'-0"	7'-0"	7'-0"	5'-0"	5'-0"
30"	7'-6"	7'-6"	8'-0"	8'-0"	6'-3"	6'-3"

FITTING SIZE	REDUCERS & 22 1/2° BENDS		11° BENDS	
	H	W	H	W
4"	1'-7"	0'-8"	0'-6"	0'-6"
6"	1'-9"	0'-10"	1'-0"	0'-6"
8"	1'-9"	1'-6"	1'-0"	1'-0"
10"	2'-2"	1'-11"	1'-5"	1'-0"
12"	2'-7"	2'-3"	2'-0"	1'-0"
14"	3'-5"	2'-5"	2'-0"	1'-6"
20"	3'-6"	3'-0"	3'-0"	2'-0"
24"	4'-8"	3'-0"	3'-0"	3'-0"
30"	4'-9"	4'-8"	3'-3"	3'-3"

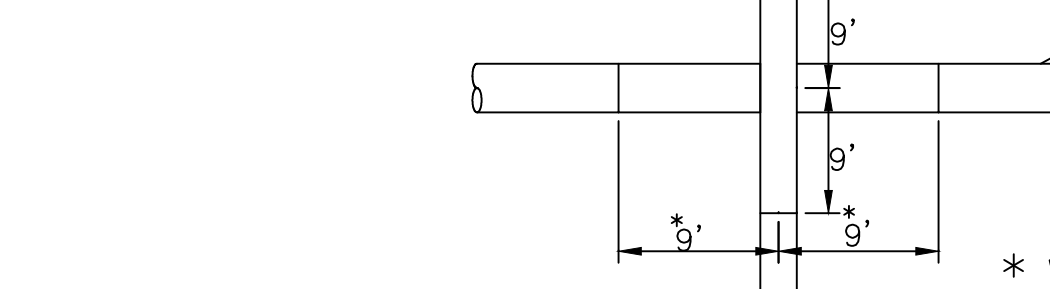

PROP. WATER LINE

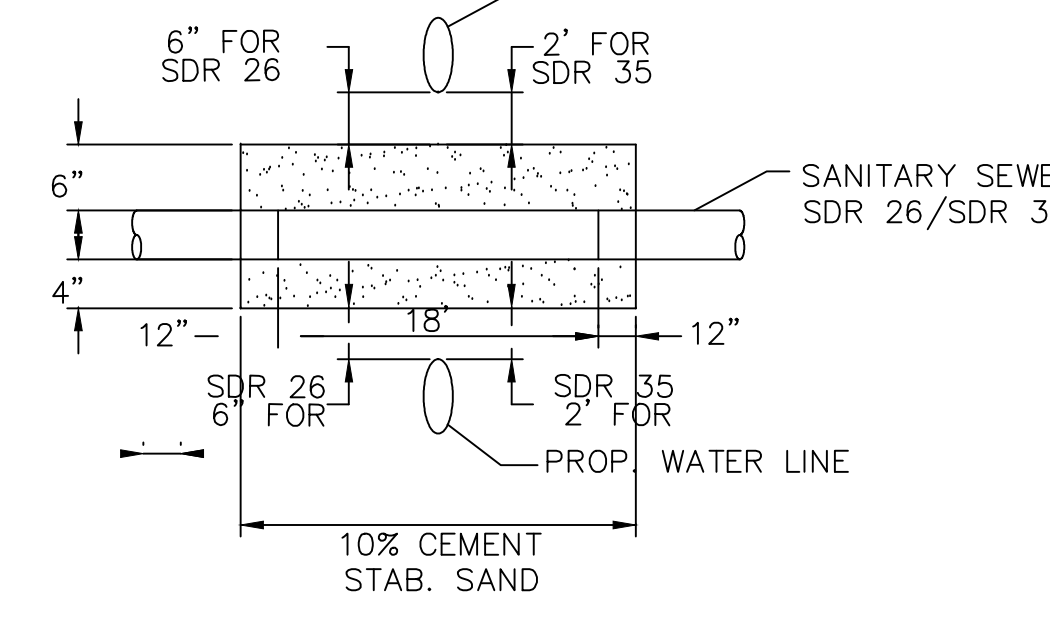

PROP. SANITARY SEWER LINE SDR 26/SDR 35

ONE - CALL NOTIFICATION SYSTEM
CALL BEFORE YOU DIG!!!
(713) 223-4567 (in Houston, Tx)
(New Statute Number Outside Houston)
1-800-545-6005

KEY PLAN (NOT TO SCALE)

W
F
R
S
O


REVISION HISTORY	
ADDENDUM NO. 3	10-07-2020

PROFESSIONAL SEAL
STATE OF TEXAS
FRED DALLY
90904
LICENSED
10/07/2020


DRAWN BY	CHECKED BY
JDM	JDM
PROJECT NUMBER 418198	PROJECT ABBREVIATION GC_RBB
ORIGINAL ISSUE DATE 07 OCT 2020	DATE 07 OCT 2020

C11.0-PH1
SHEET NUMBER

- NOTES:
1. THIS DETAIL MAY BE USED ONLY FOR DRY STABLE TRENCH CONDITION. SEE SPECIFICATIONS FOR REQUIREMENTS IN OTHER CONDITIONS.
 2. MIN TRENCH WIDTH SHALL BE PIPE OD PLUS AN ALLOWANCE "A" FOR THE NOMINAL PIPE SIZE:
NOMINAL PIPE SIZE "A"
18" TO 30" 24"
OVER 30" 36"
 3. MAX TRENCH WIDTH SHALL BE NOT GREATER THAN MIN TRENCH WIDTH PLUS 24 INCHES, UNLESS OTHERWISE NOTED.
 4. MIN. BEDDING DEPTH SHALL BE 12 INCHES.
 5. ALTERNATIVE EMBEDMENT BACKFILL MATERIALS FOR FORCE MAINS MAY BE ALLOWED

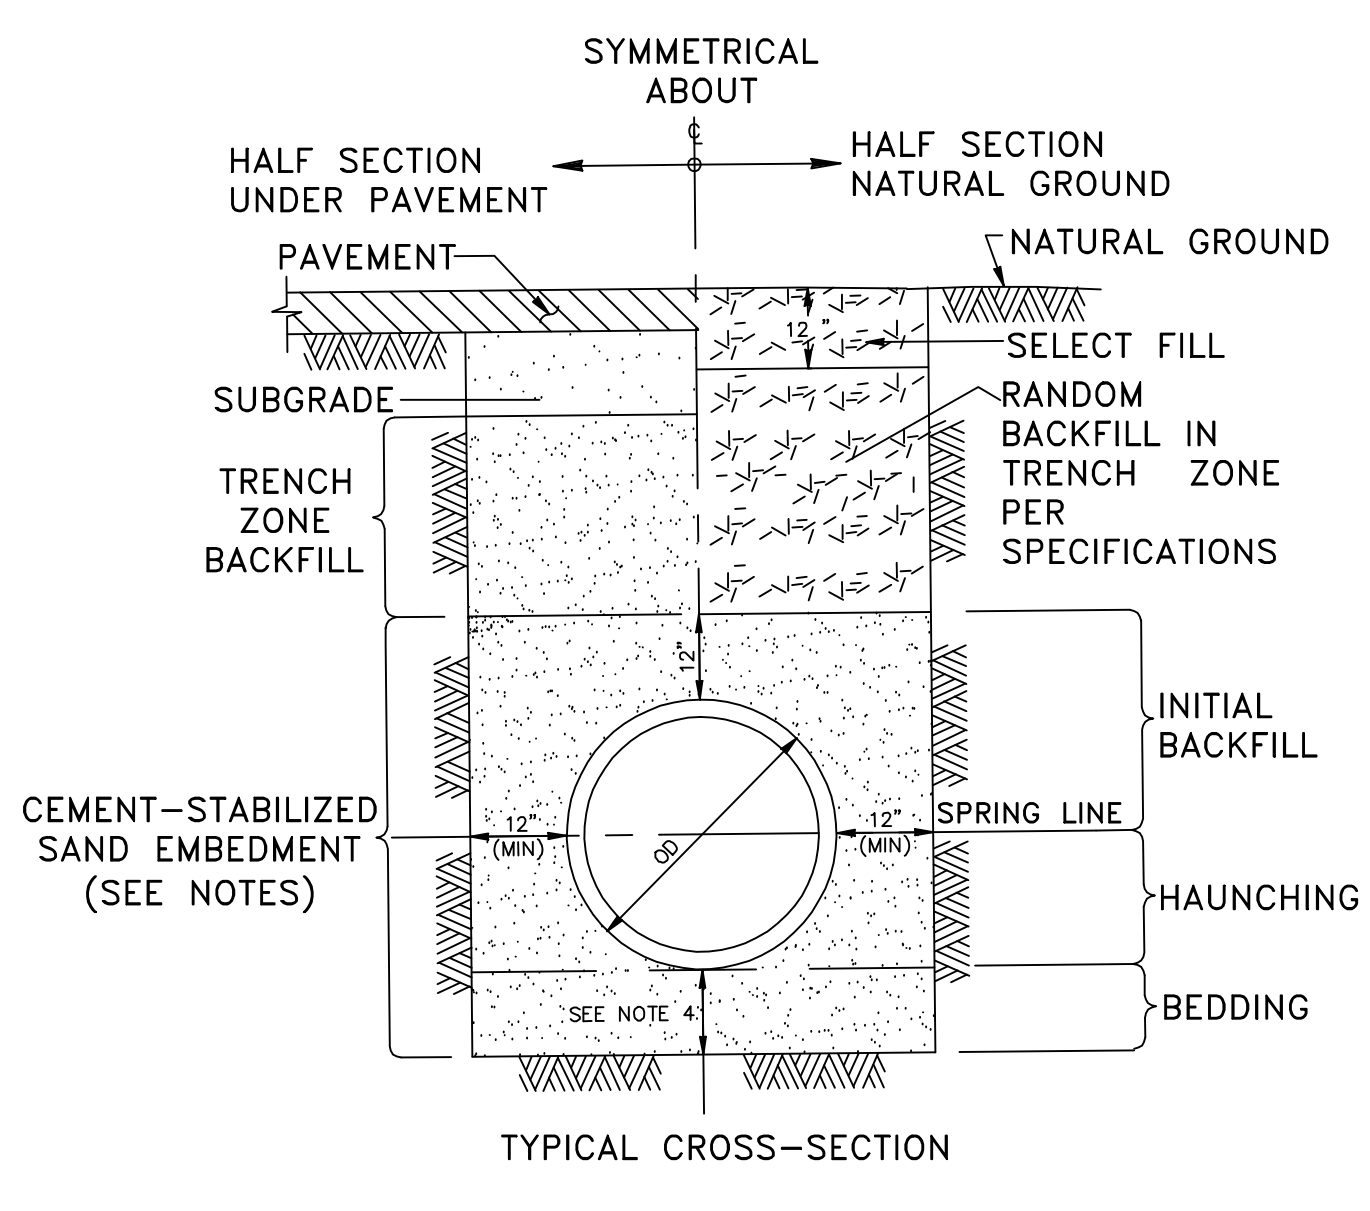

SANITARY SEWER BEDDING & BACKFILL

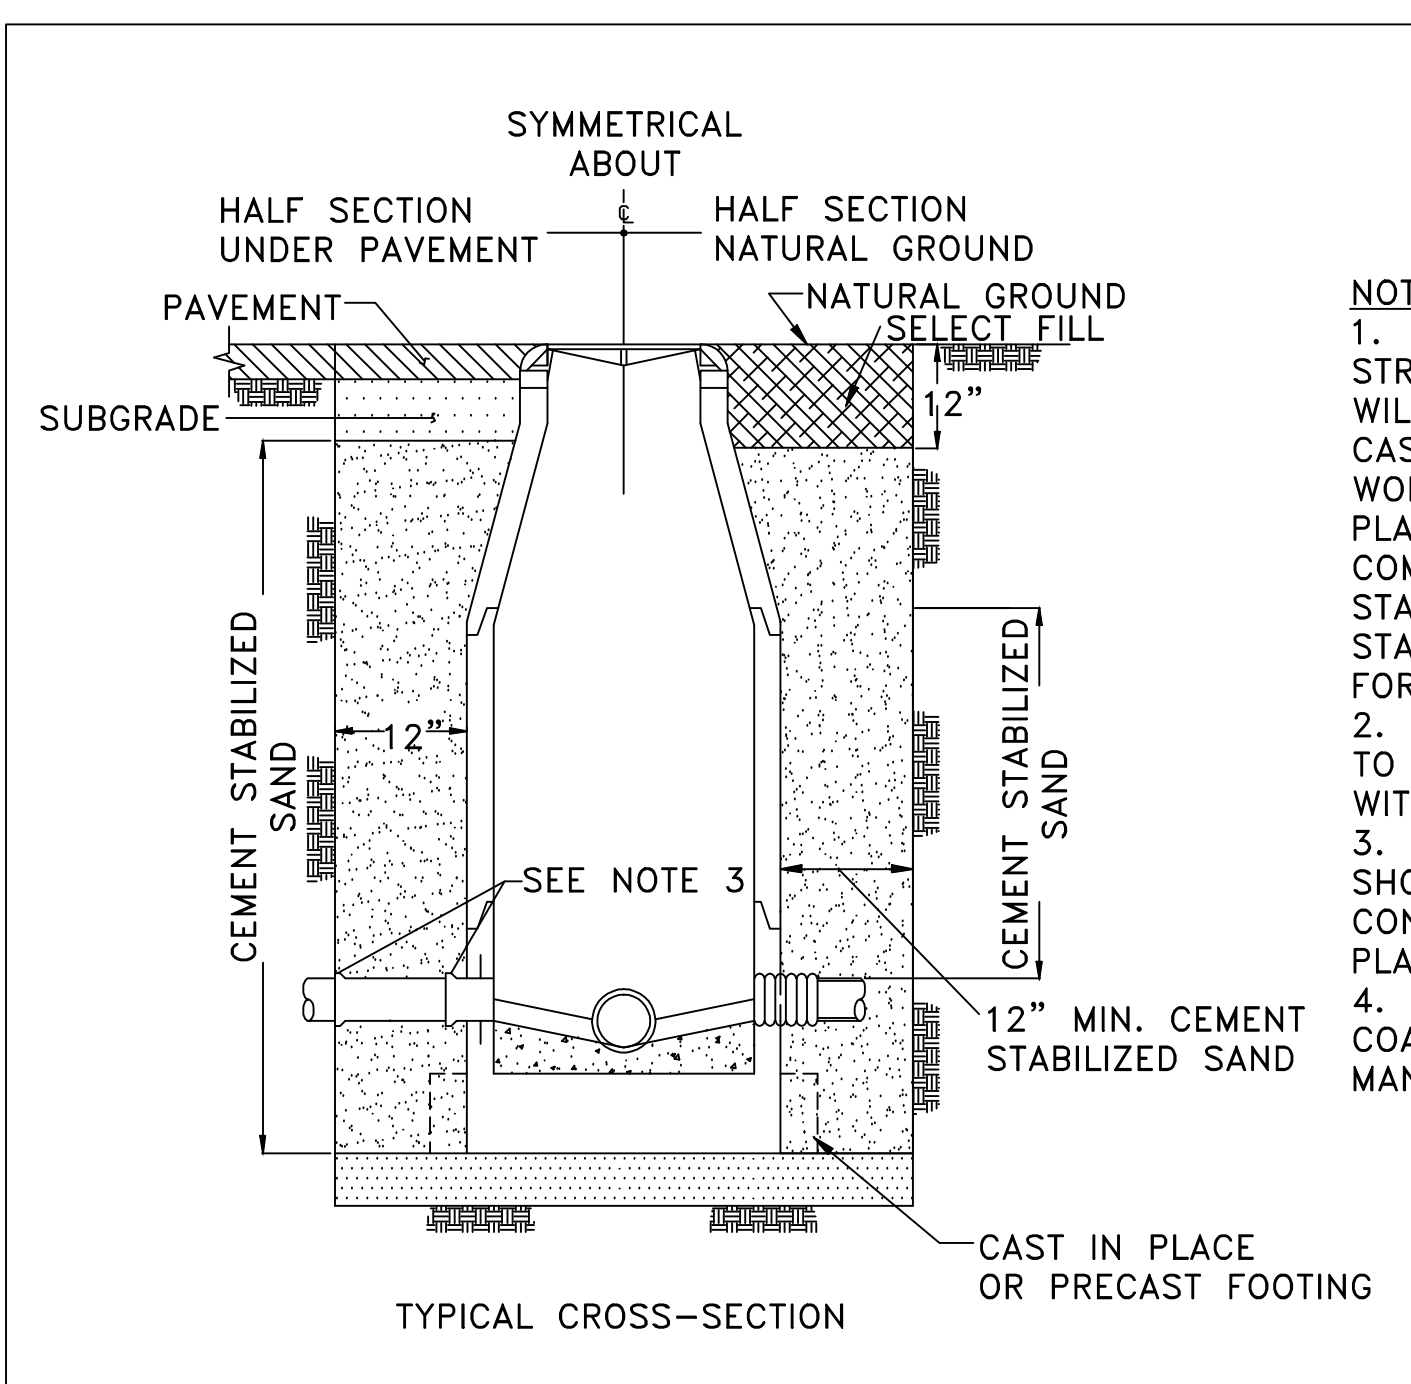

SANITARY SEWER MANHOLE

- NOTES:
1. GROUTING OF MANHOLE STRUCTURE ANNULAR SPACE WILL BE PERMITTED IN CASES WHERE INSUFFICIENT WORK SPACE EXISTS FOR PLACEMENT AND COMPACTION OF CEMENT STABILIZED SAND. PER CLP STANDARD SPECIFICATION FOR TUNNEL GROUT.
 2. THIS DETAIL ALSO APPLIES TO BACKFILL OF SHAFTS WITHOUT STRUCTURES.
 3. ARRANGE PIPE JOINTS AS SHOWN WHEN USING RIGID CONNECTION TO CAST IN PLACE MANHOLE BASE.
 4. NEED COAL-TAR EPOXY COATING ON INSIDE OF MANHOLE OR EQUAL.

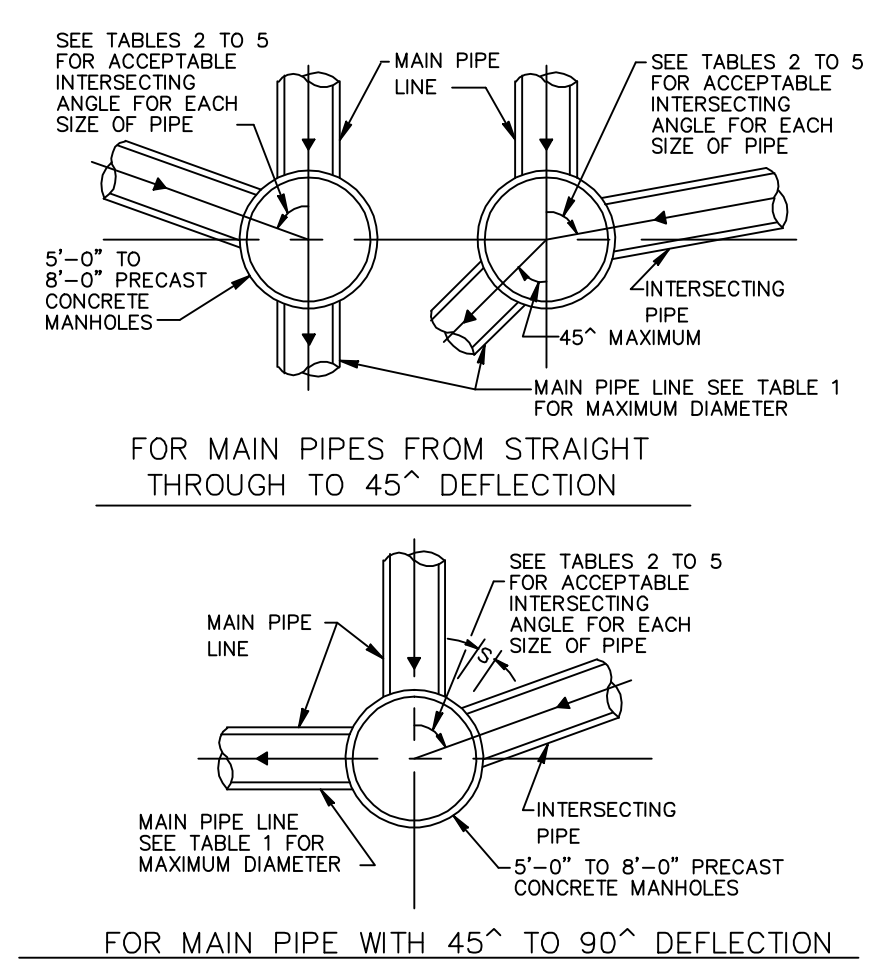


TABLE 3
MINIMUM ANGLE AND INTERSECTING PIPE ID SIZES FOR 6'-0" DIA MANHOLE

INTERSECTING PIPE ID SIZES (INCHES)	MINIMUM INTERSECTING ANGLE IN DEGREES FOR VARIOUS MAIN PIPE ID SIZES IN INCHES											
	8"	10"	12"	15"	18"	21"	24"	27"	30"	33"	36"	42"

TABLE 4
MINIMUM ANGLE AND INTERSECTING PIPE ID SIZES FOR 7'-0" DIA MANHOLE

INTERSECTING PIPE ID SIZES (INCHES)	MINIMUM INTERSECTING ANGLE IN DEGREES FOR VARIOUS MAIN PIPE ID SIZES IN INCHES												
	8"	10"	12"	15"	18"	21"	24"	27"	30"	33"	36"	42"	48"

TABLE 1
MAXIMUM MAIN PIPE DIAMETER (D) IN INCHES

MANHOLE DIAMETER (D)	STRAIGHT THROUGH TO 45° DEFLECTION	WITH 90° DEFLECTION	TABLE TO BE USED
5	36	27	2
6	42	33	3
7	48	36	4
8	60	42	5

- NOTES TO SPECIFIER:
1. " " INDICATES THAT A SPECIAL DESIGN OR THE NEXT LARGER MANHOLE SIZE SHALL BE USED.
 2. TABLES 2 TO 5 ARE BASED ON A MIN SEPARATION DISTANCE "S" OF 15.5" OR INTERSECTION PIPE OD/2, WHICHEVER IS GREATER BETWEEN MAIN AND INTERSECTING PIPES ALONG THE MANHOLE INSIDE WALL ARC.
 3. PIPE WALL THICKNESS USED IN TABLES 2 TO 5 ARE BASED ON RCP. THE DESIGN ENGINEER MAY CALCULATE TO SEE IF THINNER WALL PIPES CAN MEET THE SEPARATION CRITERIA FOR ANGLES SMALLER THAN THE TABLES ALLOW.
 4. LIMITATIONS TO BASE HEIGHT ARE BASED ON RESISTING BUOYANT UPLIFT FORCES BASED ON WATER AT GROUND SURFACE AND A SAFETY FACTOR OF 1.20.
 5. A SPECIAL DESIGN IS REQUIRED IF MANHOLE ID IS GREATER THAN 8 FT.

5'-0" TO 8'-0" DIAMETER PRECAST CONCRETE MANHOLE NOTES
N.T.S

TABLE 5
MINIMUM ANGLE AND INTERSECTING PIPE ID SIZES FOR 8'-0" DIA MANHOLE

INTERSECTING PIPE ID SIZES (INCHES)	MINIMUM INTERSECTING ANGLE IN DEGREES FOR VARIOUS MAIN PIPE ID SIZES IN INCHES														
	8"	10"	12"	15"	18"	21"	24"	27"	30"	33"	36"	42"	48"	54"	60"


TABLE 2
MINIMUM ANGLE AND INTERSECTING PIPE ID SIZES FOR 5'-0" DIA MANHOLE

INTERSECTING PIPE ID SIZES (INCHES)	MINIMUM INTERSECTING ANGLE IN DEGREES FOR VARIOUS MAIN PIPE ID SIZES IN INCHES								
	8"	10"	12"	15"	18"	21"	24"	27"	30"


*NOT APPLICABLE (INTERSECTING PIPE GREATER THAN MAIN PIPE)




PLAN VIEW FRAME AND COVER
SCALE: 1" = 1'-0"

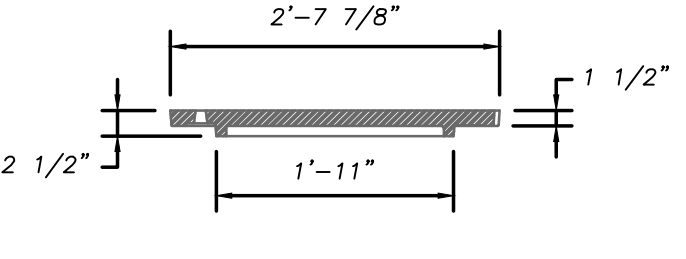


COVER SECTION A-A
SCALE: 1" = 1'-0"

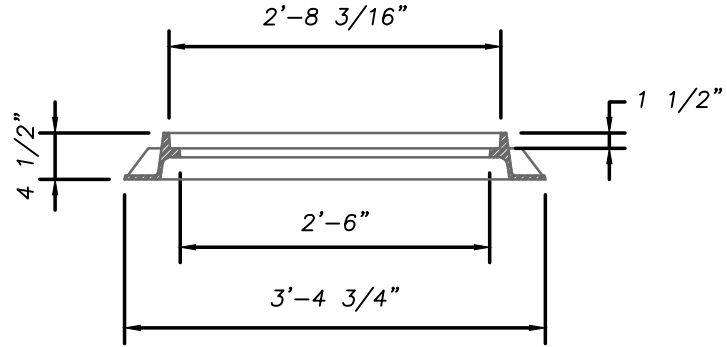


FRAME SECTION A-A
SCALE: 1" = 1'-0"

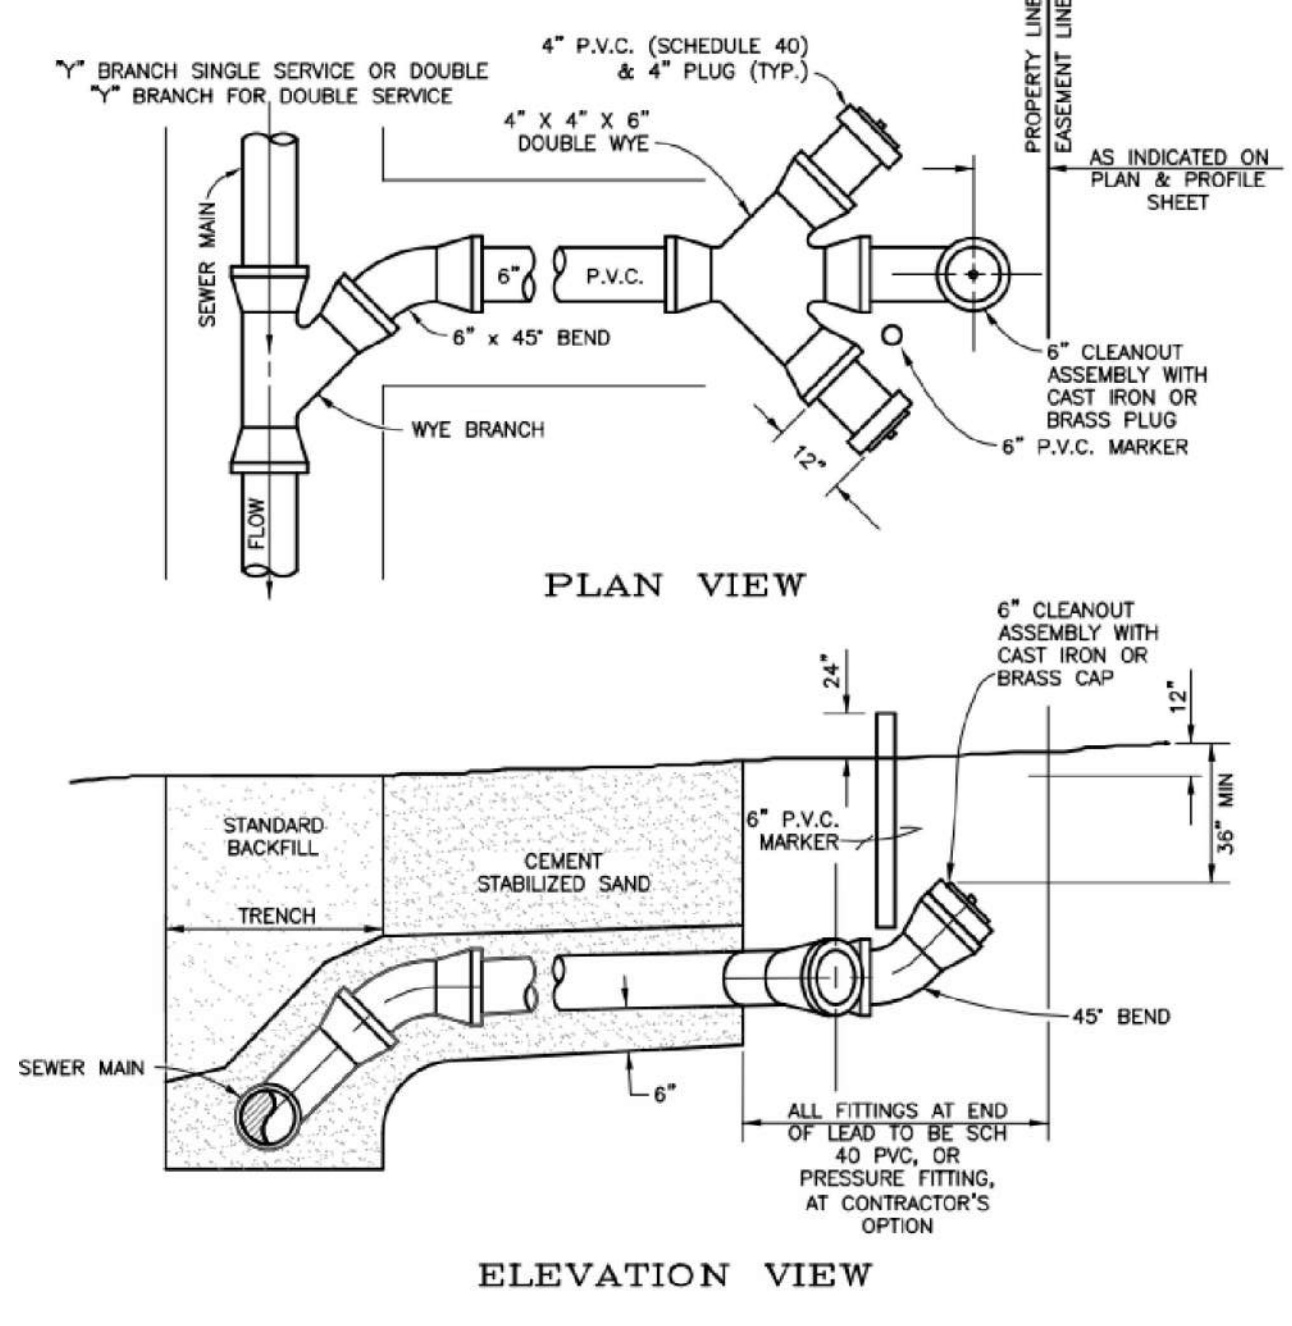


SANITARY SEWER SERVICE CONNECTION

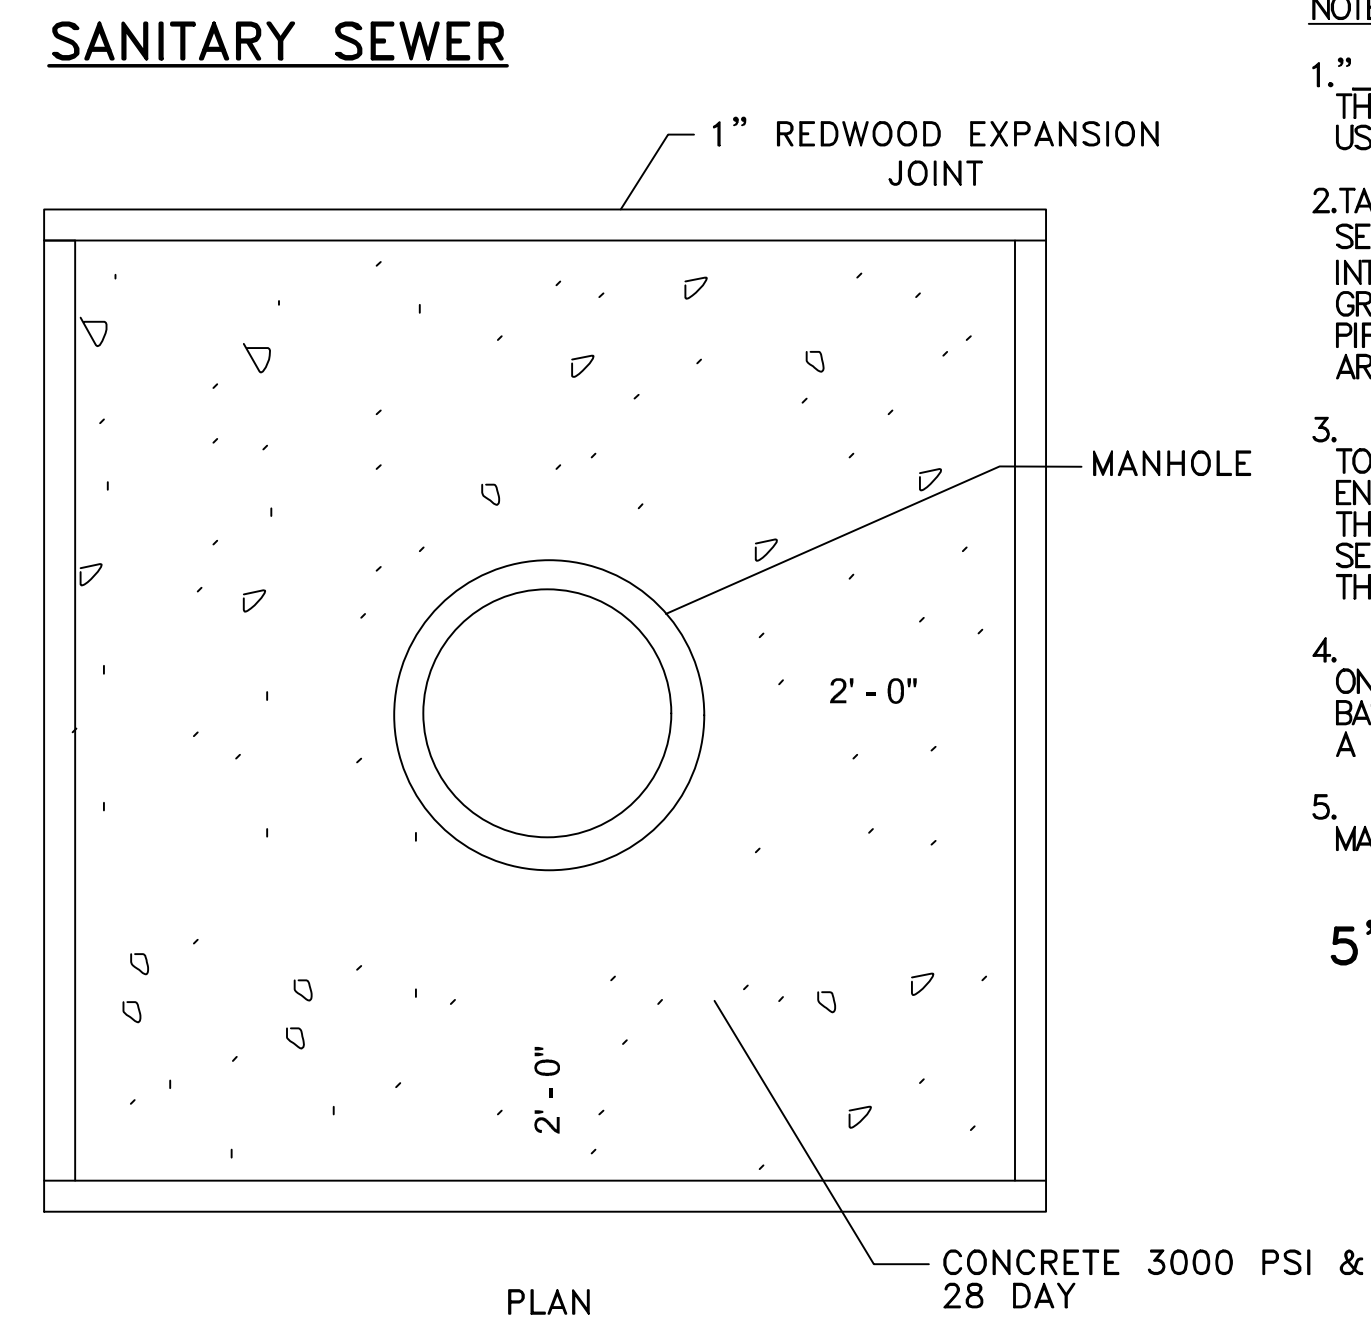


STANDARD MANHOLE BLOCKOUT FOR CONCRETE PAVEMENT

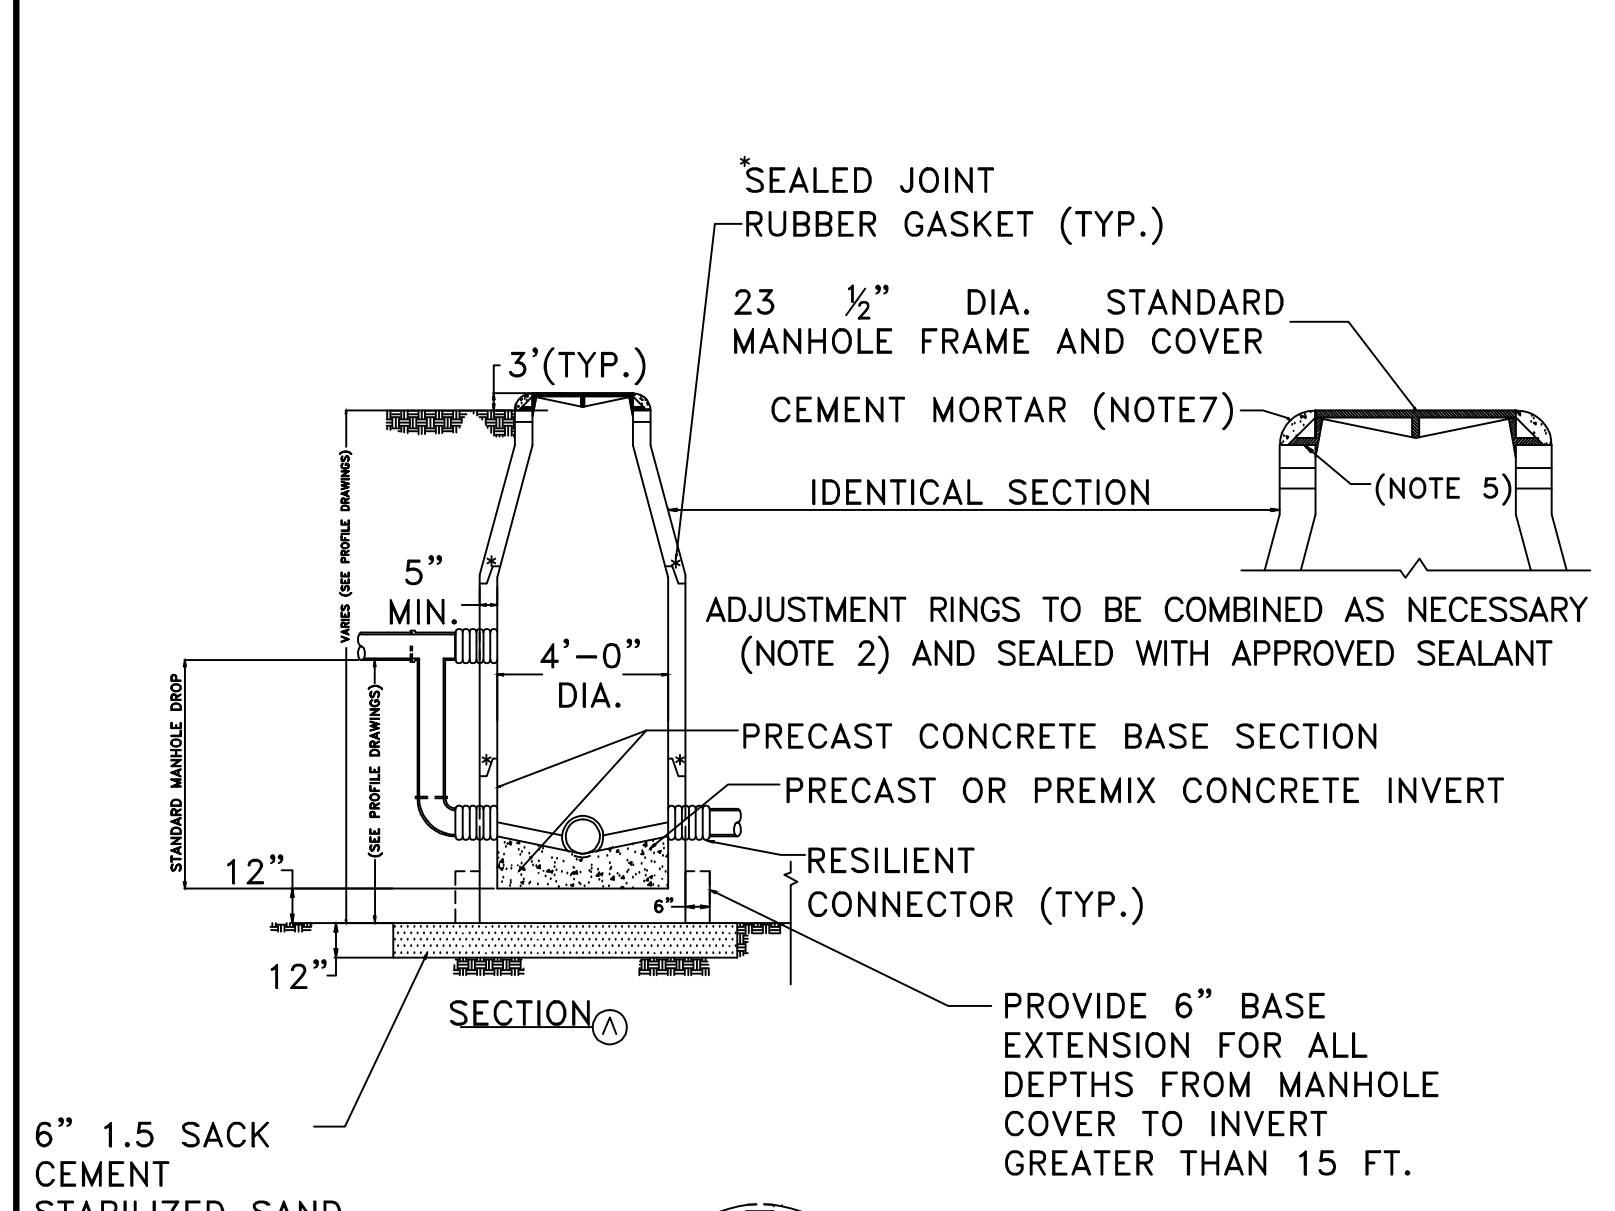

- NOTES:
1. DEPTH MANHOLE DETERMINES SECTIONS REQUIRED.
 2. PRECAST CONCRETE RINGS SHALL BE PROVIDED FOR A COMBINED ADJUSTMENT HEIGHT OF AT LEAST 12". THE TOTAL HEIGHT OF THE ADJUSTMENT RINGS SHALL NOT EXCEED 1'-6".
 3. MANHOLE WALL THICKNESS FOR DEPTH EXCEEDING 12'0" SHALL BE 12" THICK.
 4. MANHOLE DROP AND INTERSECTING PIPES SHALL BE INSTALLED ONLY WHEN CALLED FOR IN PLAN AND PROFILE DRAWING.
 5. SEAT MANHOLE FRAME IN SEALANT PER CITY OF LA PORTE STANDARD SPECIFICATION.
 6. ECCENTRIC PRECAST CONCRETE MANHOLE MAY BE USE.
 7. OMIT CEMENT MORTAR WHEN MANHOLE IS LOCATED IN PAVED AREAS.
 8. MIN. REINFORCING IN THE PRECAST CONCRETE BASE SHALL BE #5@ 8 EW.
 9. PROVIDED BACKFILL TO MATCH ADJACENT PIPE TRENCH BACKFILL PER CITY OF LA PORTE STANDARD SPECIFICATION.
 10. TEE INCLUDED IN PRICE OF DROP.
 11. HORSE-SHOE SHAPED OPENINGS OR BREAKOUT OPENINGS SHALL NOT BE ACCEPTED.

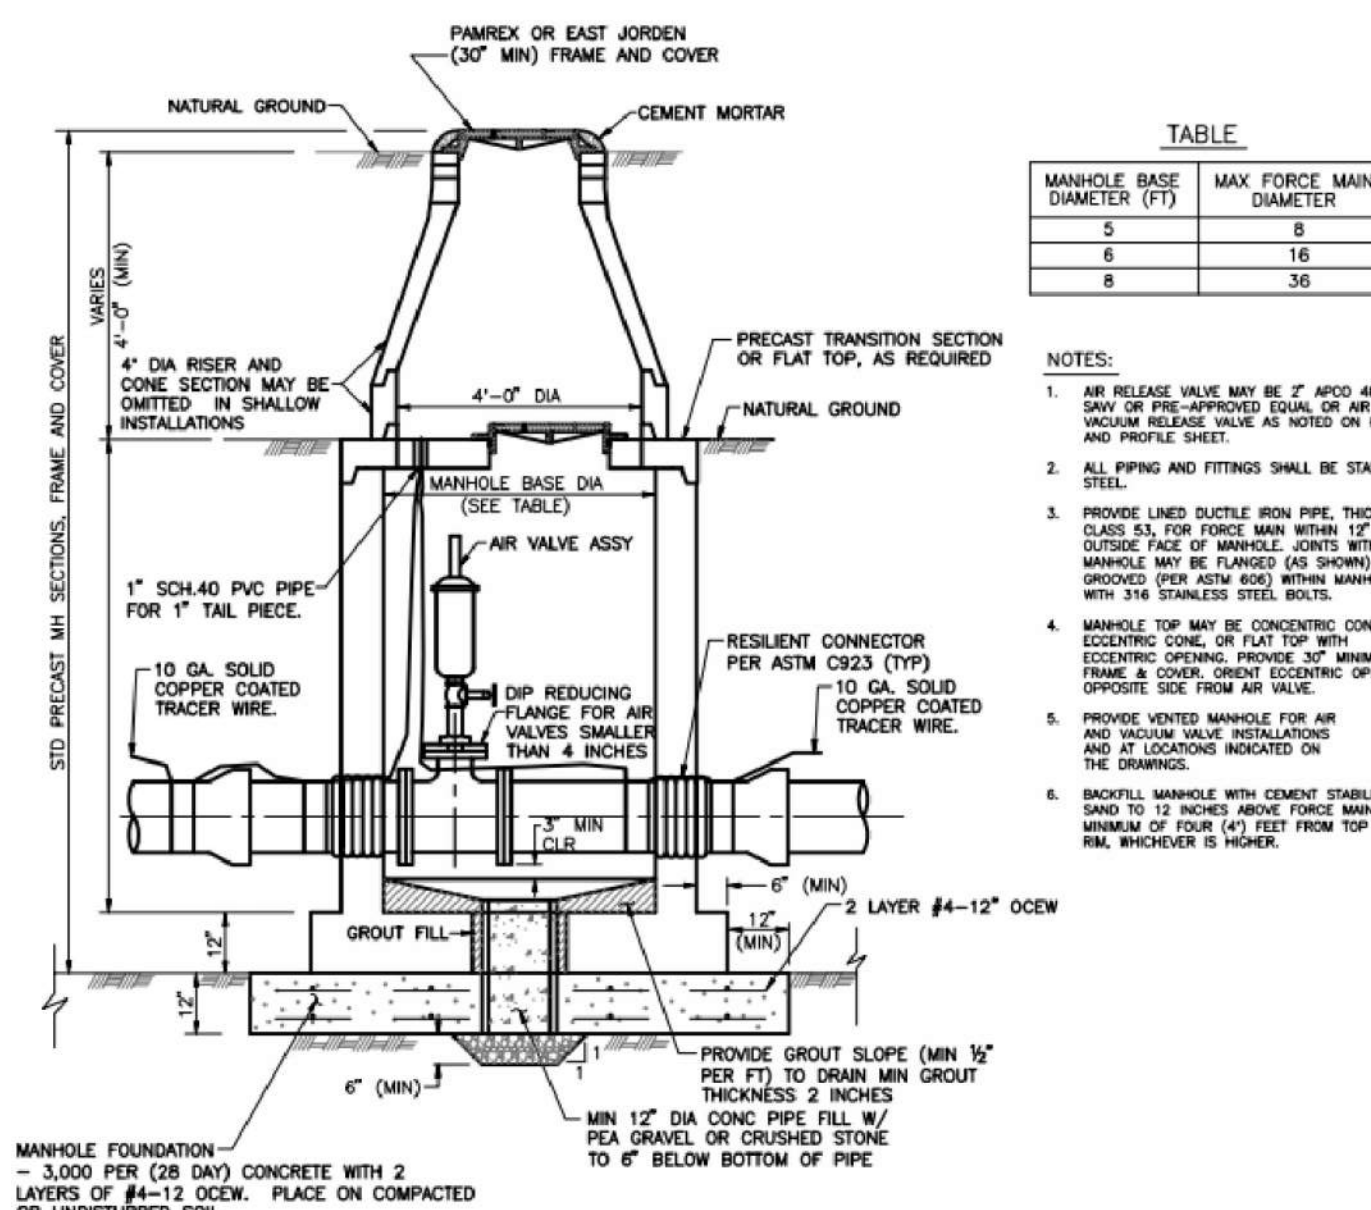

SANITARY SEWER AIR RELEASE OR AIR/VACUUM RELEASE VALVE MANHOLE

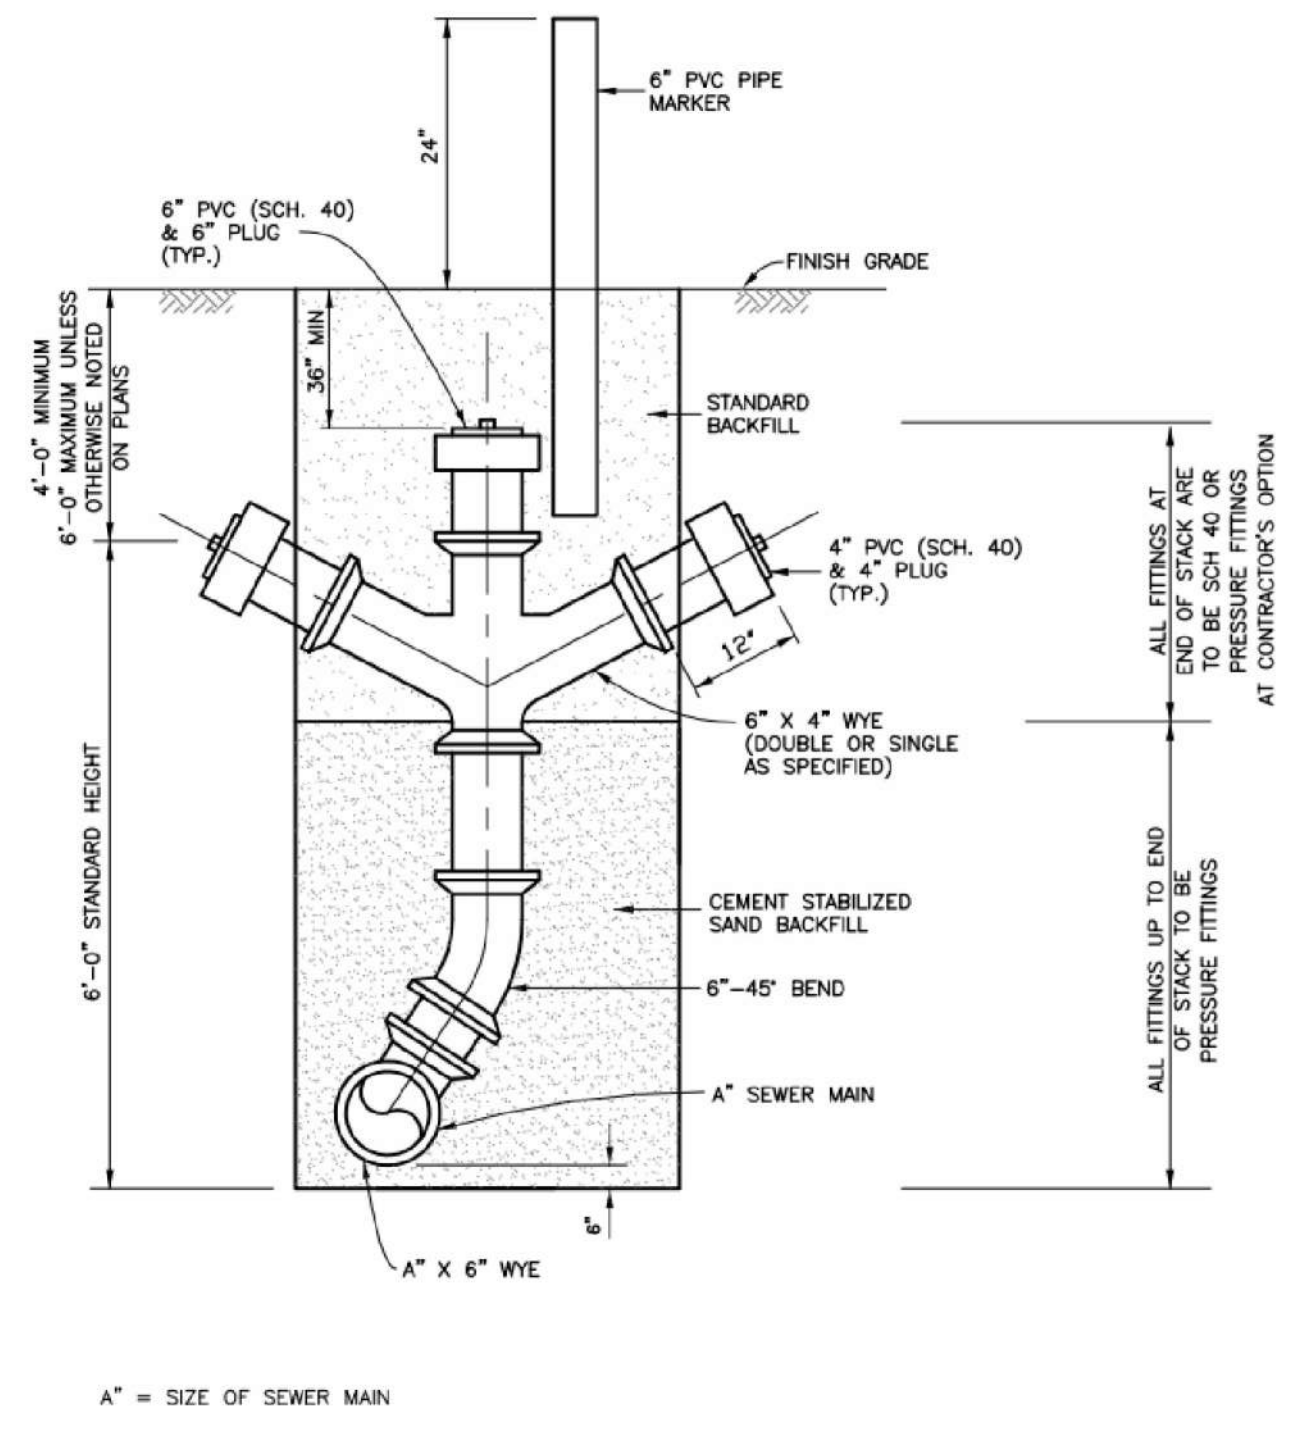


SANITARY SEWER STACK

ONE - CALL NOTIFICATION SYSTEM CALL BEFORE YOU DIG!!!
(713) 223-4567 (in Houston, Tx)
(New Statelwide Number Outside Houston) 1-800-545-6005

REVISION HISTORY

REVISION	DESCRIPTION	DATE
ADDENDUM NO. 3		10-07-2020


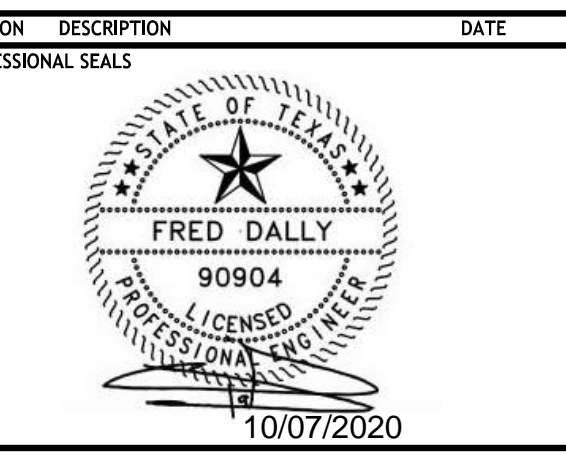


SANITARY SEWER DETAILS

DRAWN BY: JDM CHECKED BY: JDM
PROJECT NUMBER: 418198 PROJECT ABBREVIATION: GC_REB
ORIGINAL ISSUE DATE: 07/07/20
ISSUE FOR PERMIT DATE: 07/07/2020

C12.0-PH1

**Galveston County
Road & Bridge Department Facilities PH1**
5115 Texas Highway 3
Dickinson, TX

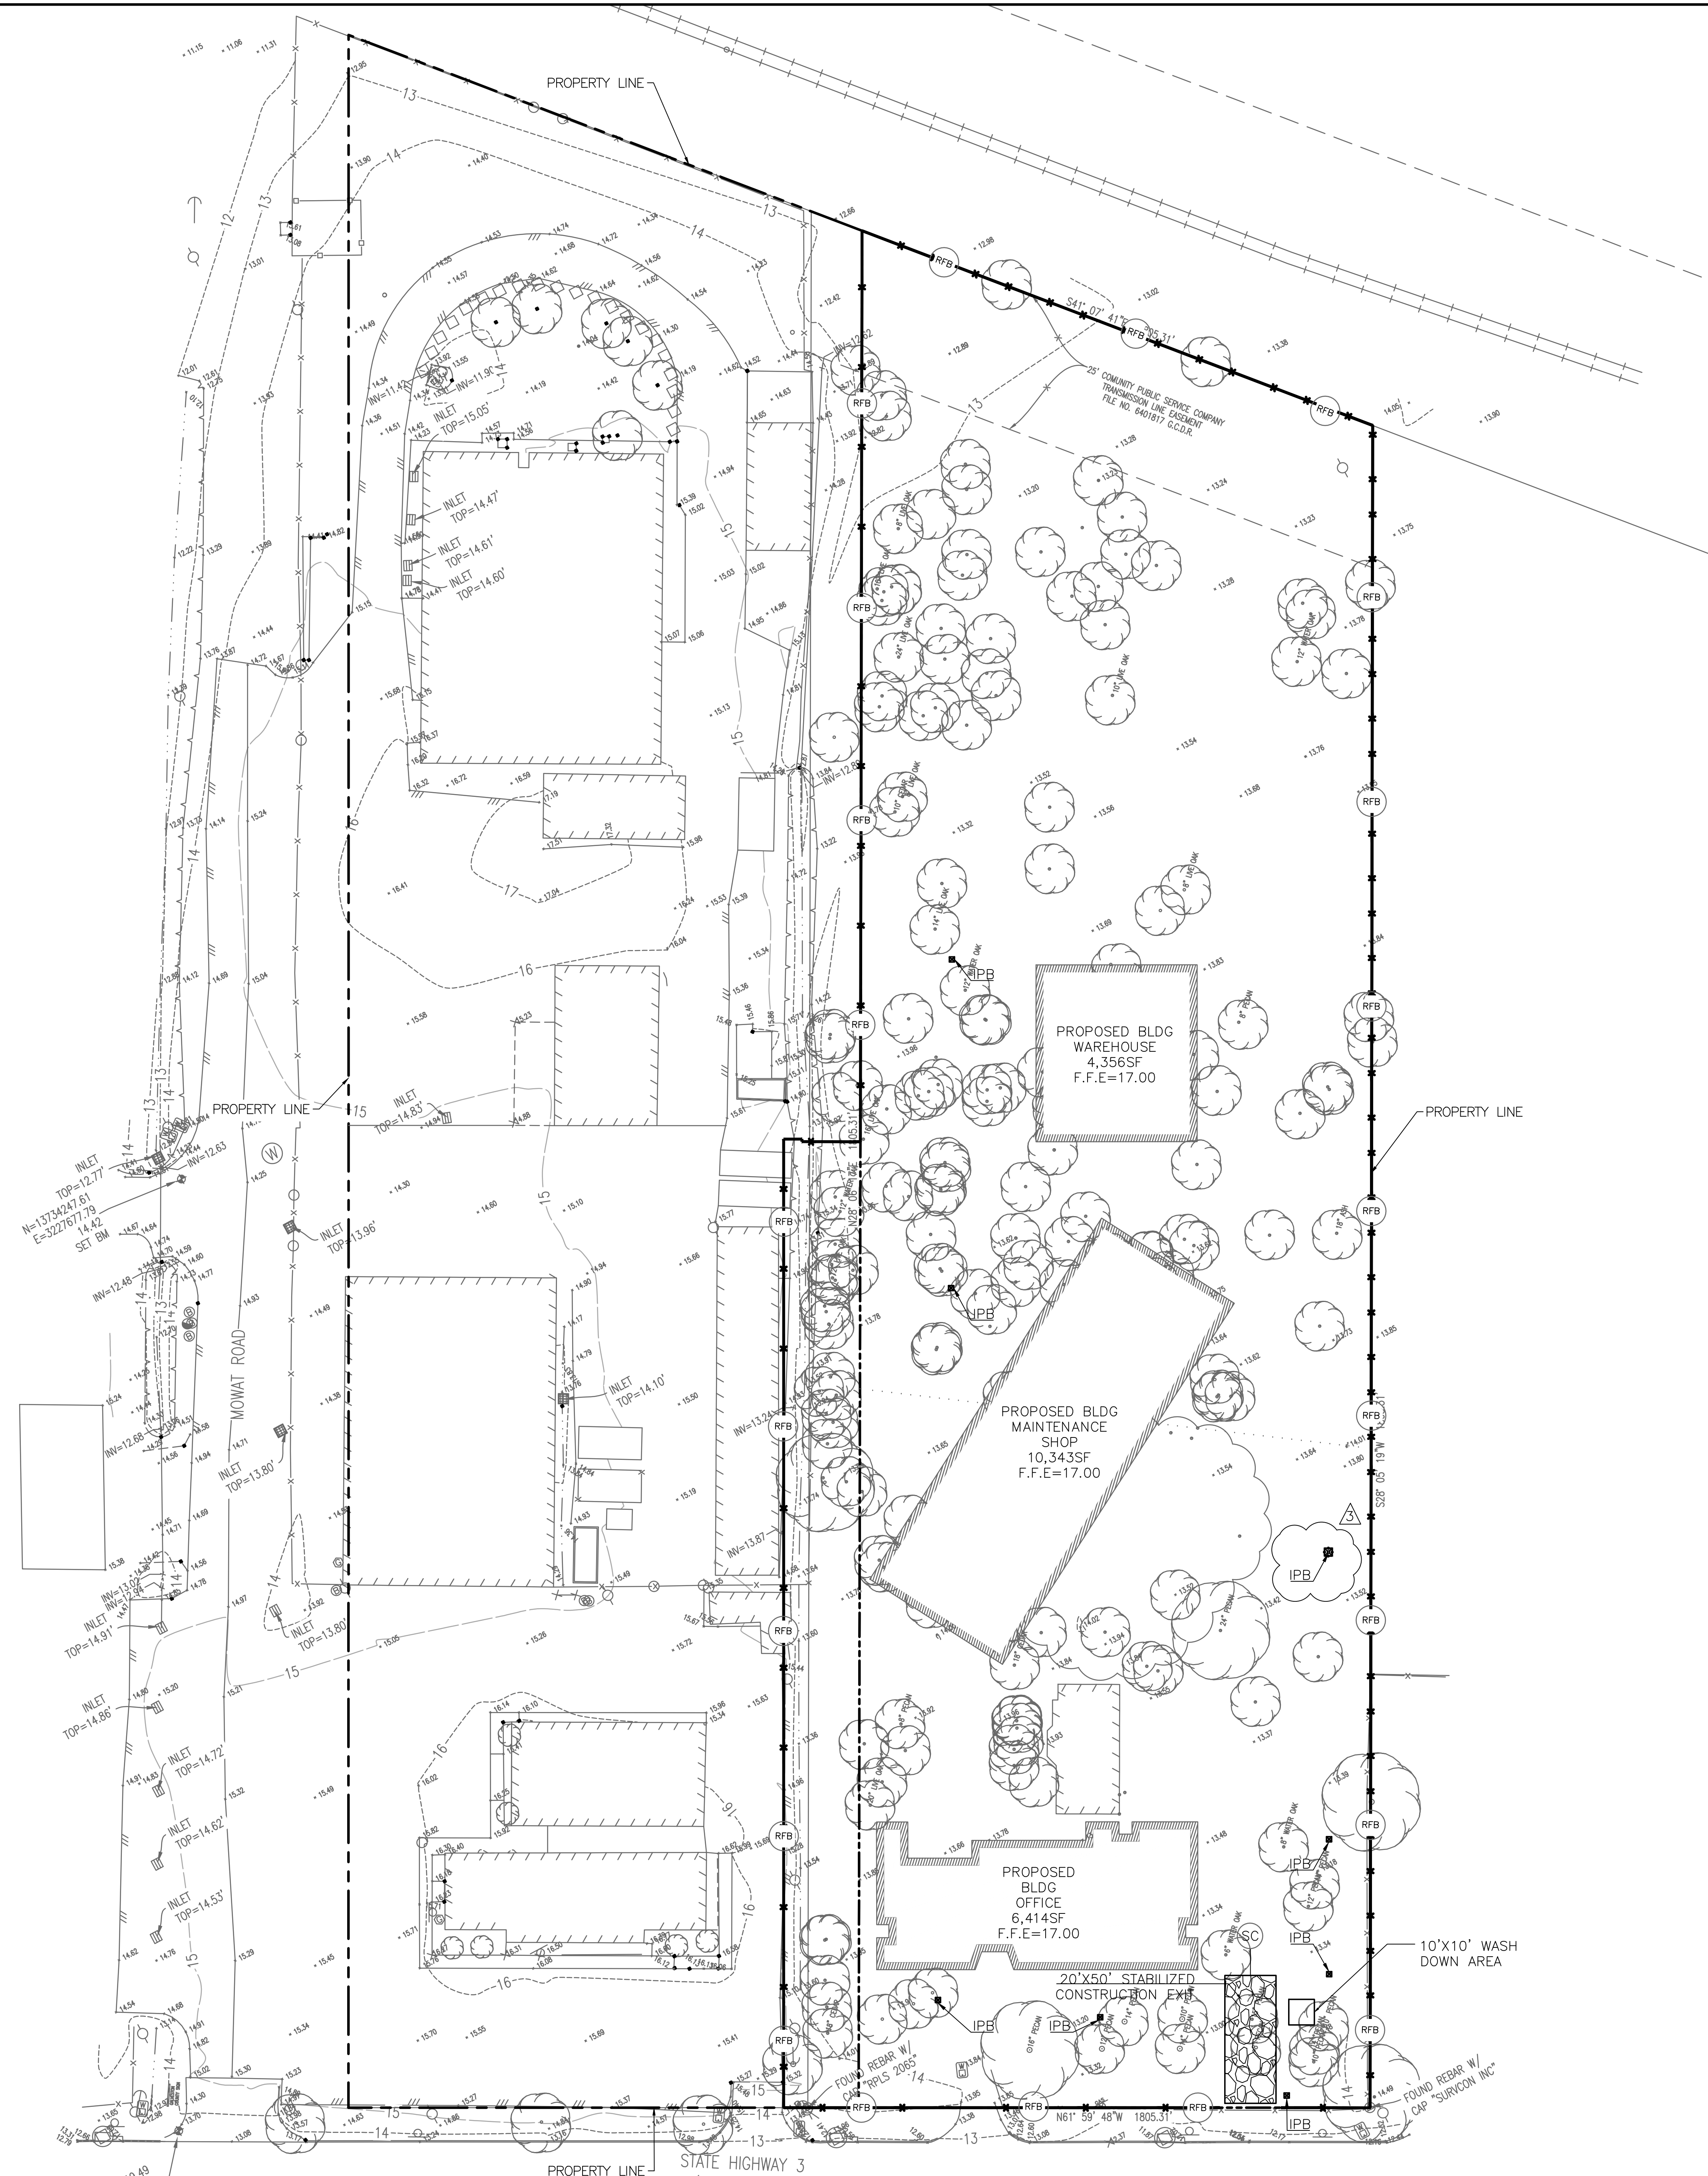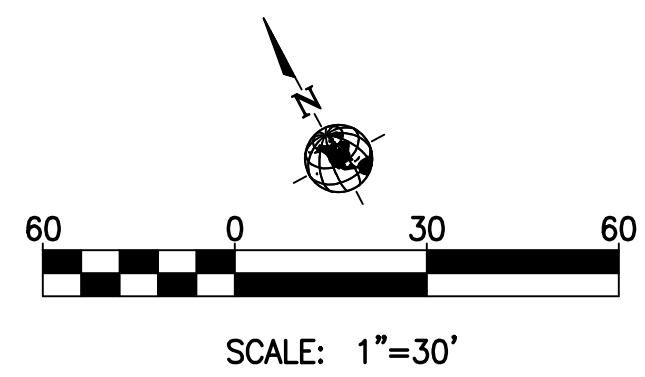

SWPPP LEGEND

- REINFORCED FILTER FABRIC BARRIER AT LEAST 2' BEHIND BACK OF CURB/PAVEMENT
- STABILIZED CONSTRUCTION EXIT.
- INLET PROTECTION BARRIER (IPB).
- WASH DOWN AREA.

SWPPP CONSTRUCTION NOTES


1. CONTRACTOR SHALL IMPLEMENT INLET PROTECTION DEVICES AND REINFORCED FILTER FABRIC BARRIER ALONG ROAD AND SIDE DITCHES AT LOCATION SHOWN ON THE TYPICAL STORM WATER POLLUTION PREVENTION (SWPPP) PLANS TO KEEP SILT AND/OR EXCAVATED MATERIALS FROM ENTERING INTO THE STORM WATER INLETS AND DITCHES EVENTUALLY POLLUTING THE RECEIVING STORM.
2. DURING THE EXCAVATION PHASE OF THE PROJECT, CONTRACTOR SHALL SCHEDULE THE WORK IN SHORT SEGMENTS SO THAT EXCAVATED MATERIAL CAN BE QUICKLY HAULED AWAY FROM THE SITE AND TO PREVENT IT FROM STAYING UNCOLLECTED ON THE EXISTING PAVEMENT. ANY LOOSE EXCAVATED MATERIAL WHICH FALLS ON PAVEMENTS OR DRIVEWAYS SHALL BE SWEEPED BACK INTO THE EXCAVATED AREA.
3. CONTRACTOR SHALL CLEAN UP THE EXISTING STREET INTERSECTIONS AND DRIVEWAYS DAILY, AS NECESSARY, TO REMOVE ANY EXCESS MUD, SILT OR ROCK TRACKED FROM THE EXCAVATED AREA.
4. CONTRACTOR SHALL FOLLOW GOOD HOUSEKEEPING PRACTICES DURING THE CONSTRUCTION OF THE PROJECT ALWAYS CLEANING UP DIRT AND LOOSE MATERIAL AS CONSTRUCTION PROGRESSES.
5. CONTRACTOR TO INSPECT AND MAINTAIN THE AREAS LISTED BELOW AT LEAST ONCE EVERY FOURTEEN (14) CALENDAR DAYS AND WITHIN 24 HOURS OF THE END OF A STORM EVENT OF 0.5 INCHES OR GREATER.
 - DISTURBED AREAS OF THE CONSTRUCTION SITE THAT HAVE NOT BEEN FINALLY STABILIZED.
 - AREAS USED FOR STORAGE OF MATERIALS THAT ARE EXPOSED TO PRECIPITATION.
 - STRUCTURAL CONTROL MEASURES.
 - LOCATIONS WHERE VEHICLES ENTER OR EXIT THE SITE.
6. CONTRACTOR TO BE RESPONSIBLE TO MAINTAIN EXISTING DITCHES AND/OR CULVERTS FOR UNOBSTRUCTED DRAINAGE AT ALL TIMES. WHERE SODDING IS DISTURBED BY EXCAVATION ON BACKFILLING OPERATIONS, SUCH AREAS SHALL BE REPLACED BY SEEDING OR SODDING. SLOPES 4:1 OR STEPPER SHALL BE REPLACED BY CLOCK SODDING.

CONCRETE TRUCK/EQUIPMENT WASH OUT

1. CONTRACTOR(S) SHALL NOT WASH OUT CONCRETE TRUCKS OR EQUIPMENT INTO STREET DEAD ENDS, RIGHT-OF-WAYS, GUTTERS, STORM SEWER INLETS, WATERWAYS, CREEKS OR ANY LOCATION WHERE THE MATERIALS COULD REACH THE STORM SEWER (MS4) SYSTEM. ROCKED CUL-DE-SACS ARE NOT APPROVED WASH OUT AREAS. ALL DEPOSITED MATERIALS SHALL BE REMOVED AND PROPERLY DISPOSED OF AT THE COMPLETION OF WORK.
2. WASH OUT CONCRETE TRUCKS AND/OR EQUIPMENT ONLY IN A DESIGNATED, CONFINED WASHOUT AREA WHERE THE WATER WILL FLOW INTO A TEMPORARY PIT IN A DIRT AREA OR ONTO STOCKPILES OF AGGREGATE BASE OR SAND. THIS AREA MUST BE AN IDENTIFIED LOCATION.
3. COLLECT AND RETURN SWEEPINGS FROM EXPOSED AGGREGATE CONCRETE TO A STOCKPILE OR DISPOSE OF THE WASTE IN A TRASH CONTAINER.

**ONE-CALL NOTIFICATION SYSTEM
CALL BEFORE YOU DIG!!!**
(713) 223-4567 (in Houston, Tx)
(New Statewide Number Outside Houston)
1-800-545-6005

KEY PLAN (NOT TO SCALE)

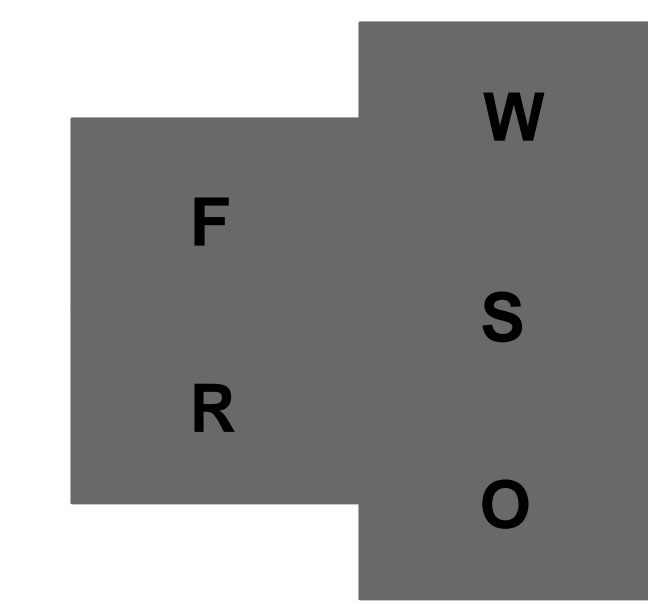

REVISION HISTORY		
ADDENDUM NO. 3	10-07-2020	



PROFESSIONAL SEAL

10/07/2020

SWPP PLAN	
DRAWN BY JDM	CHECKED BY JDM
PROJECT NUMBER 478198	PROJECT ABBREVIATION GC_RBB
ORIGINAL ISSUE ISSUE FOR PERMIT	DATE 07 OCT 2020

C13.0-PH1
SHEET NUMBER




Galveston County
Road & Bridge Department Facilities PH1
5115 Texas Highway 3
Dickinson, TX

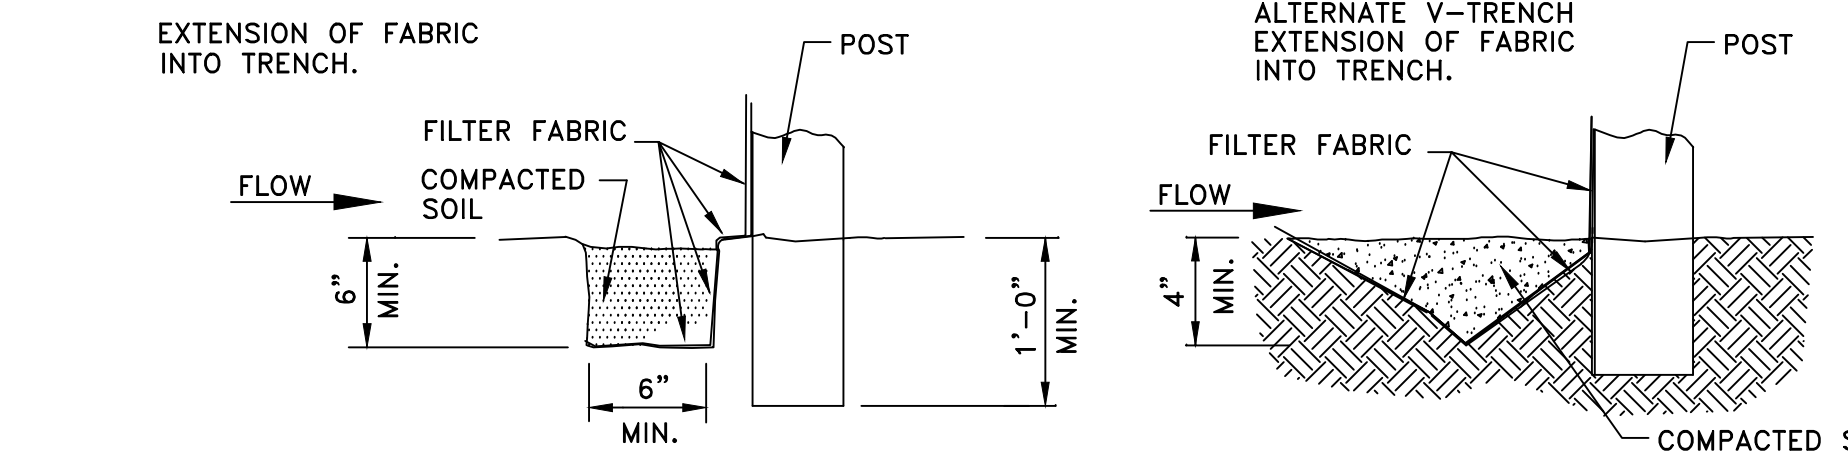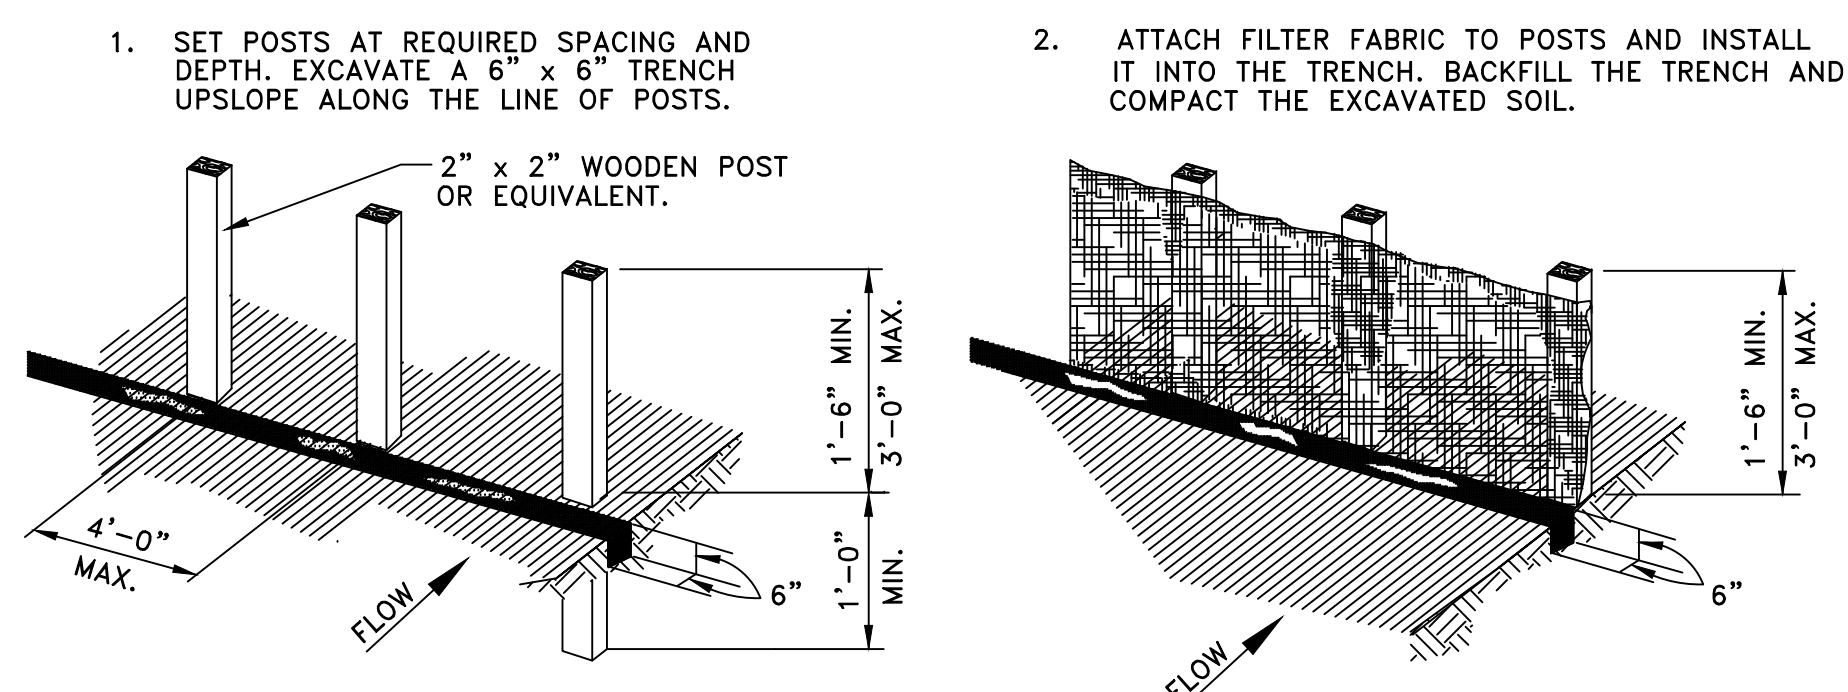

GENERAL NOTES:

- SET POSTS AT 4- FEET MAXIMUM SPACING. IF FACTORY PREASSEMBLED FENCE WITH SUPPORT NETTING IS USED, SPACING OF POST MAY BE INCREASED TO 8 FEET MAXIMUM.
- WHEN TWO SECTIONS OF FILTER FABRIC ADJOIN EACH OTHER, OVERLAP 6 INCHES AT THE POST, FOLD TOGETHER, AND ATTACH TO THE POSTS.
- REMOVE SEDIMENT DEPOSITS WHEN SILT DEPTH REACHES ONE-THIRD OF THE HEIGHT OF THE FENCE.




FILTER FABRIC FENCE

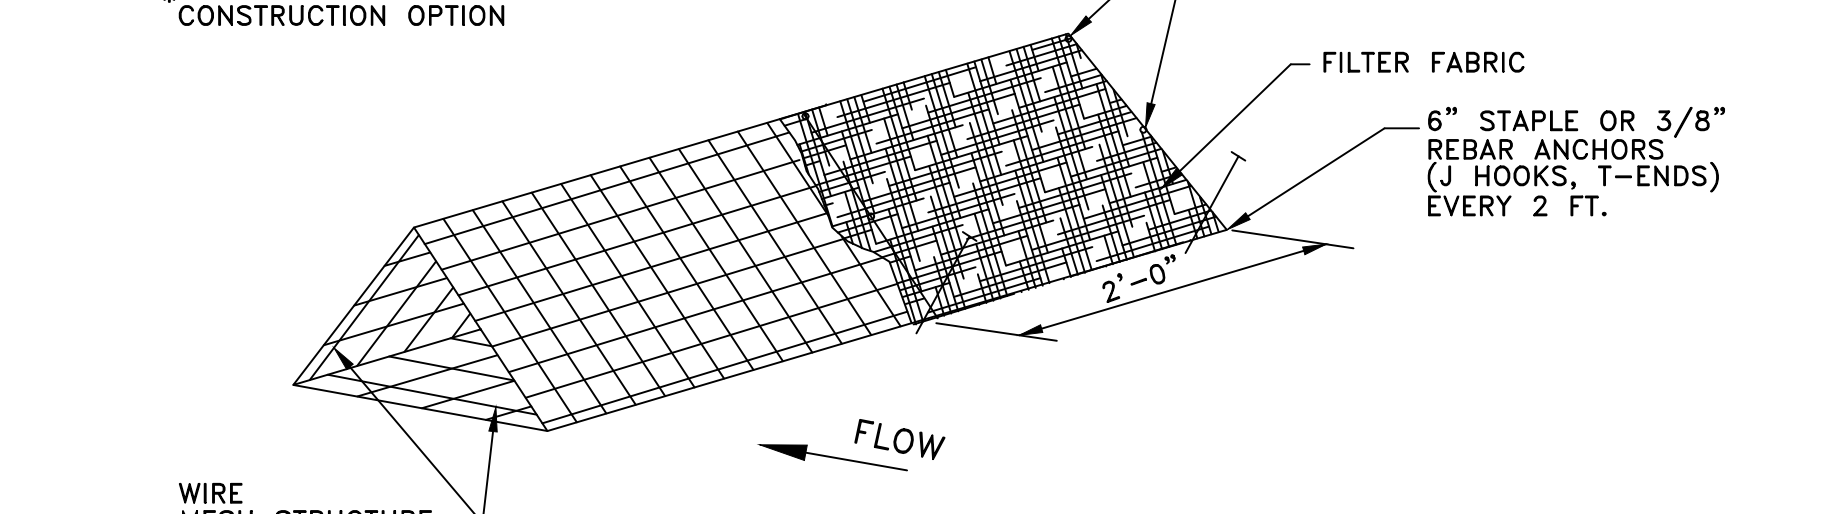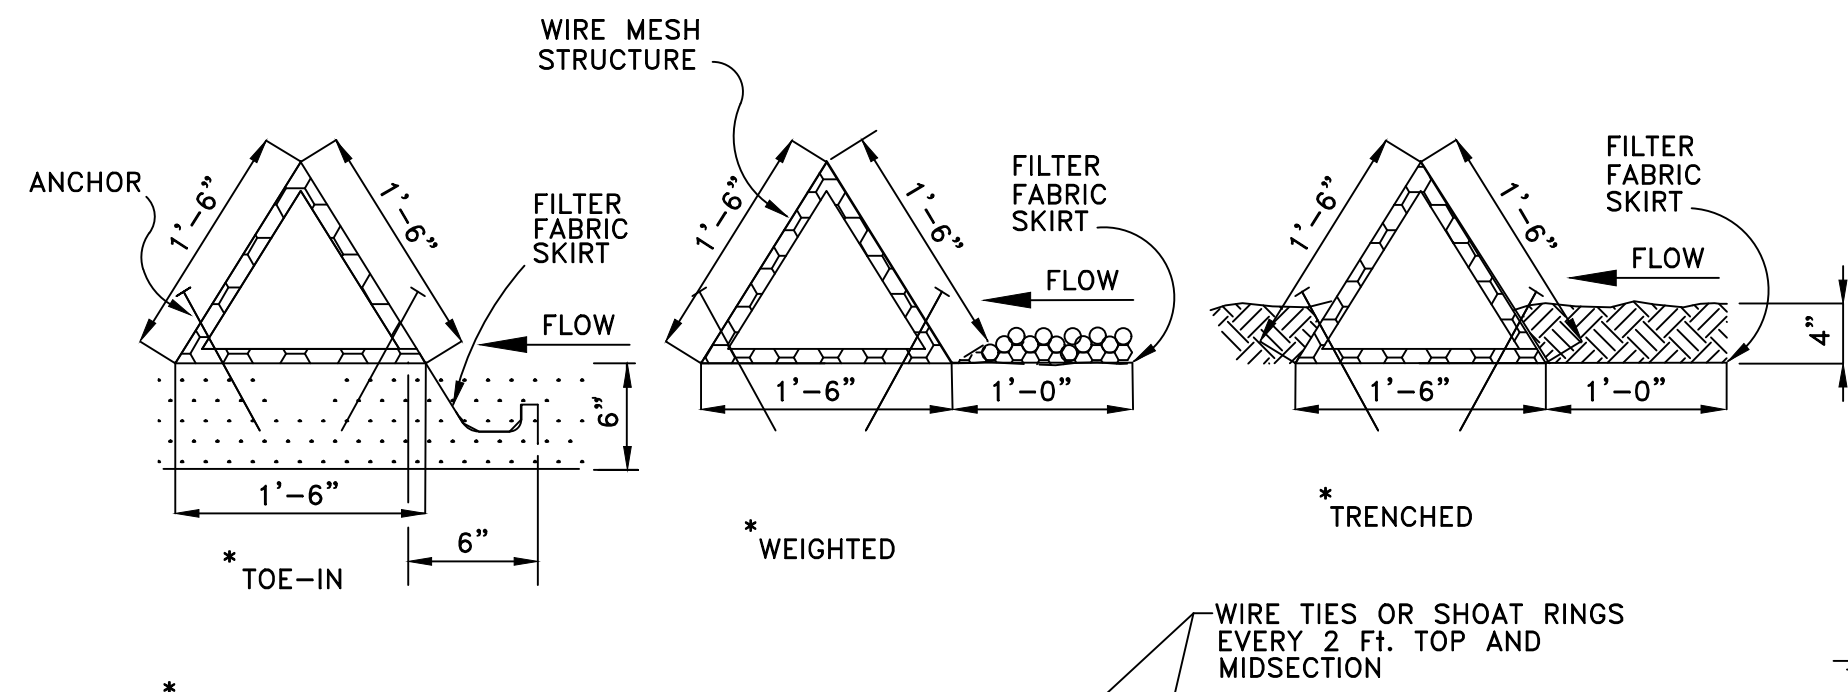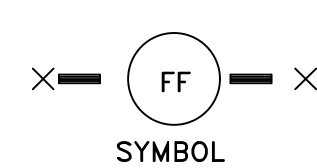

GENERAL NOTES:

- PLACE BARRIER IN A ROW WITH ENDS TIGHTLY ABUTTING THE ADJACENT BARRIER.
- USING ONE CONTINUOUS SECTION OF FILTER FABRIC, WRAP FABRIC AROUND WIRE MESH AND EXTEND FABRIC TO FORM SKIRT ON THE UPSTREAM SIDE.
- WEIGHT SKIRT WITH A CONTINUOUS LAYER OF 3-INCH TO 5-INCH OPEN GRADED ROCK, OR TOE IN SKIRT WITH SIX INCHES WITH MECHANICALLY COMPACTED MATERIAL.
- SECURELY ANCHOR BARRIER AND SKIRT IN PLACE USING 6-INCH WIRE STAPLES ON 2-FOOT CENTERS ON BOTH EDGES, OR STAKE USING 18-INCH BY 3/8 INCH REBARS (T-ENDS, J-HOOKS).
- FILTER FABRIC SHALL BE LAPPED OVER ENDS 6 INCHES TO COVER SEGMENT JOINTS. FASTEN JOINTS WITH GALVANIZED SHOAT RINGS OR EQUIVALENT.
- THE BARRIER STRUCTURE SHALL BE WELDED WIRE MESH, 18 INCHES ON EACH SIDE.



TRIANGULAR FILTER FABRIC FENCE

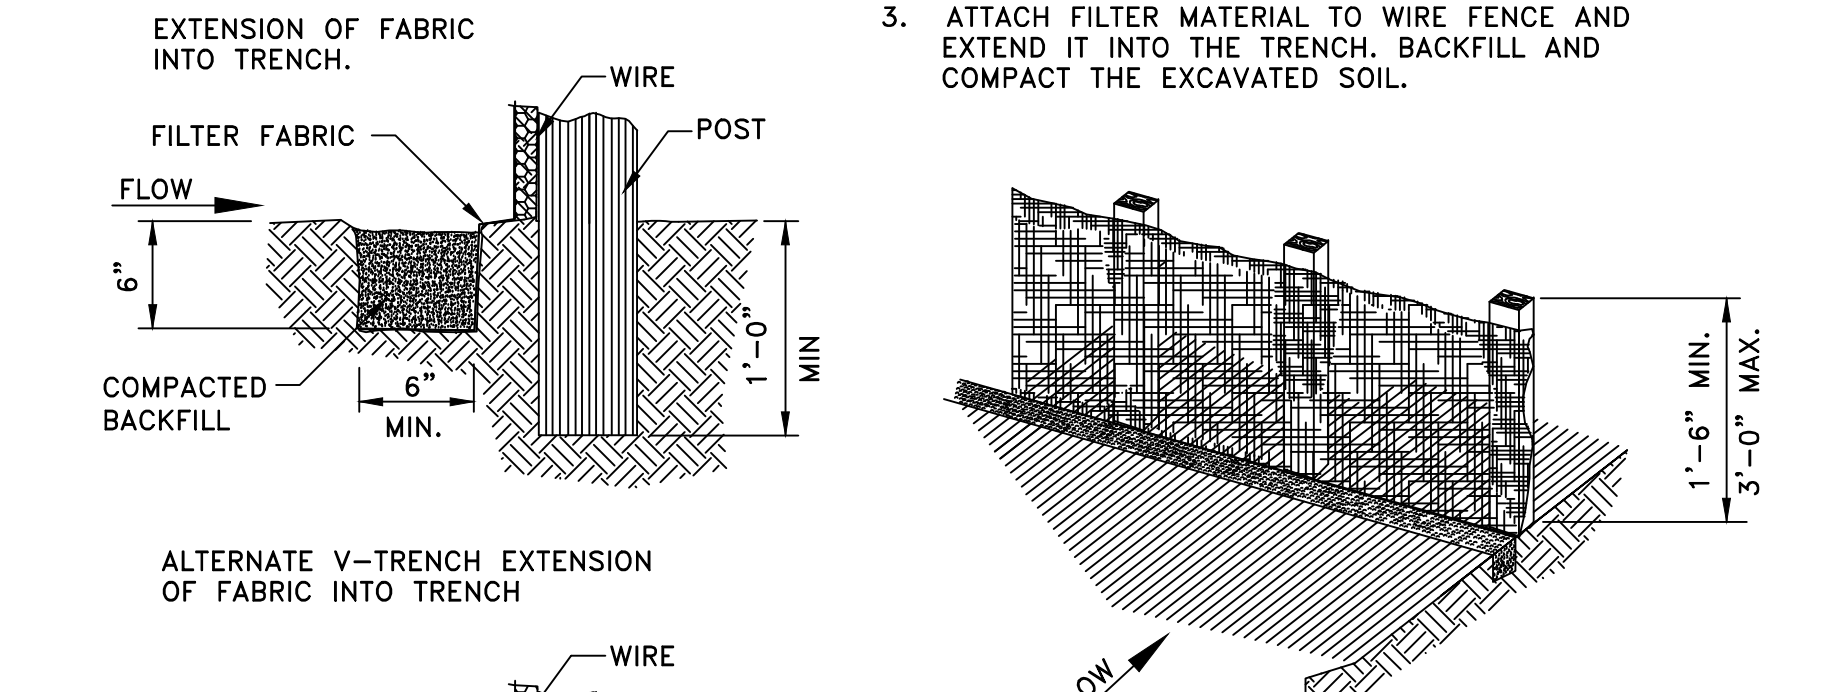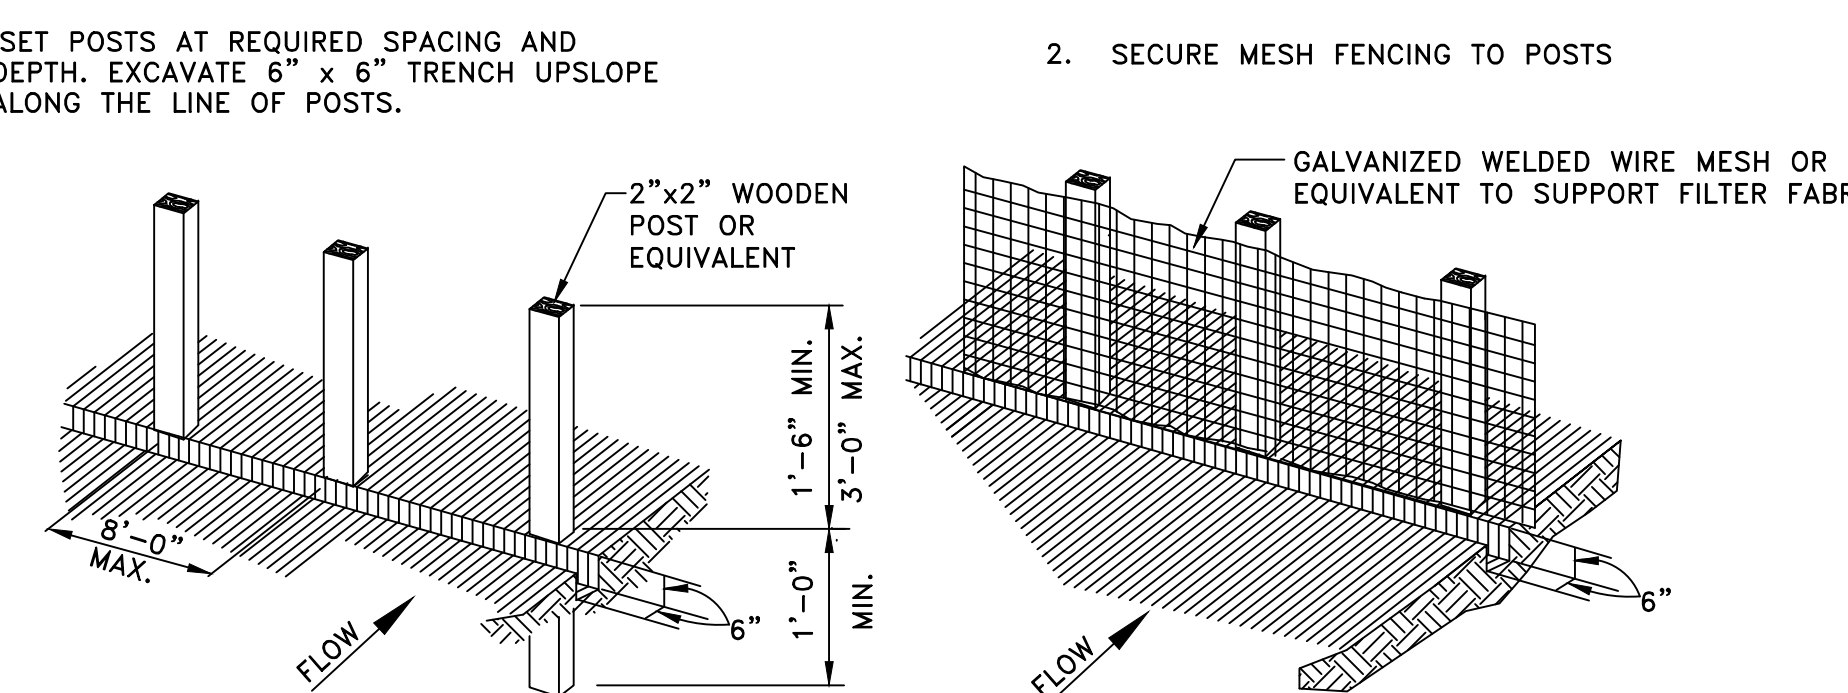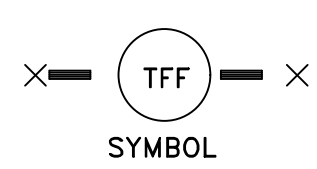


GENERAL NOTES:

- SECURELY FASTEN MESH FENCING TO POSTS WITH STAPLES OR TIE WIRES.
- SECURELY FASTEN FILTER FABRIC TO MESH FENCING.
- WHEN TWO SECTIONS OF FILTER FABRIC ADJOIN EACH OTHER, OVERLAP 6 INCHES AT A POST, FOLD TOGETHER, AND ATTACH TO A POST.
- REMOVE SEDIMENT DEPOSITS WHEN SILT REACHES ONE-THIRD OF THE HEIGHT OF THE FENCE IN DEPTH.

REINFORCED FILTER FABRIC BARRIER


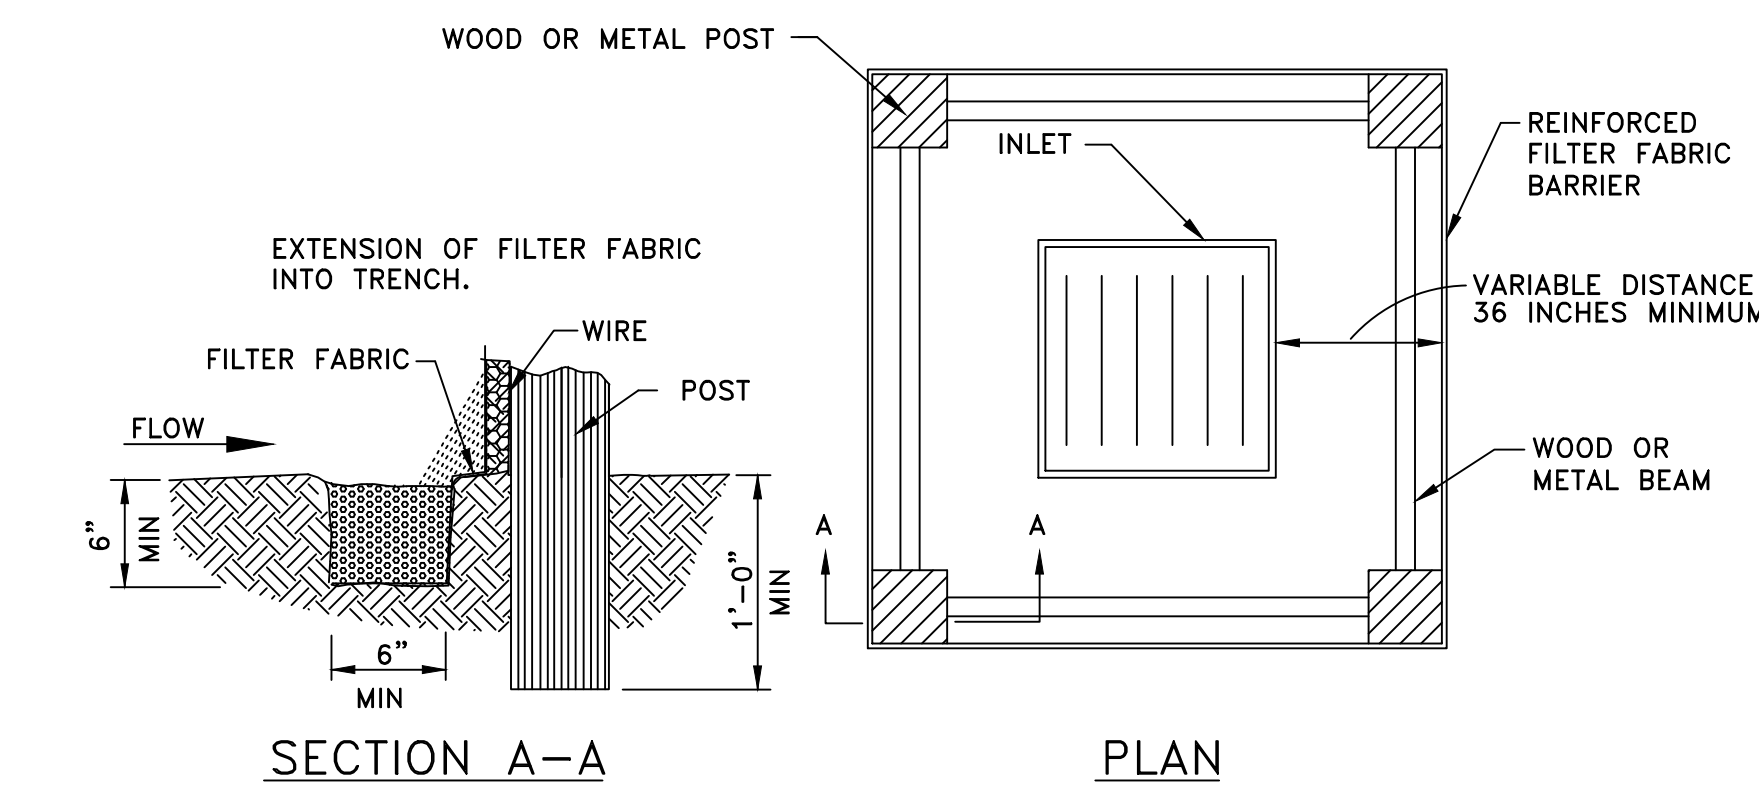
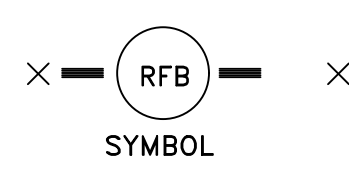


SEE REINFORCED FILTER FABRIC BARRIER DETAIL FOR REINFORCED FILTER FABRIC BARRIER REQUIREMENTS

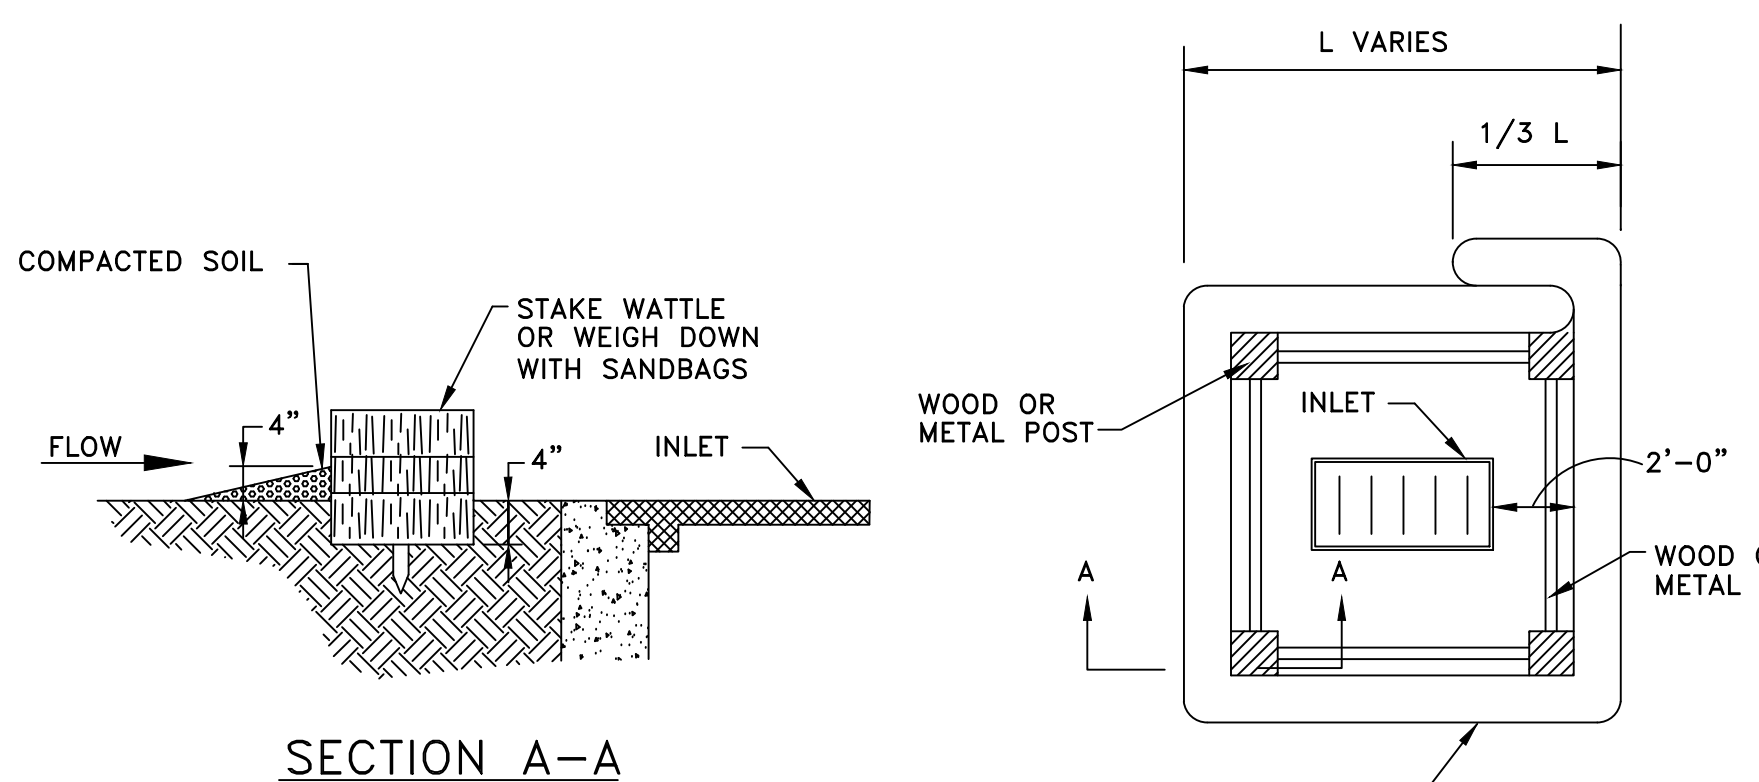

NOTE: TYPICALLY STRAW BALES ARE NOT RECOMMENDED FOR INLET PROTECTION BARRIERS.




INLET PROTECTION BARRIERS FOR STAGE I INLETS

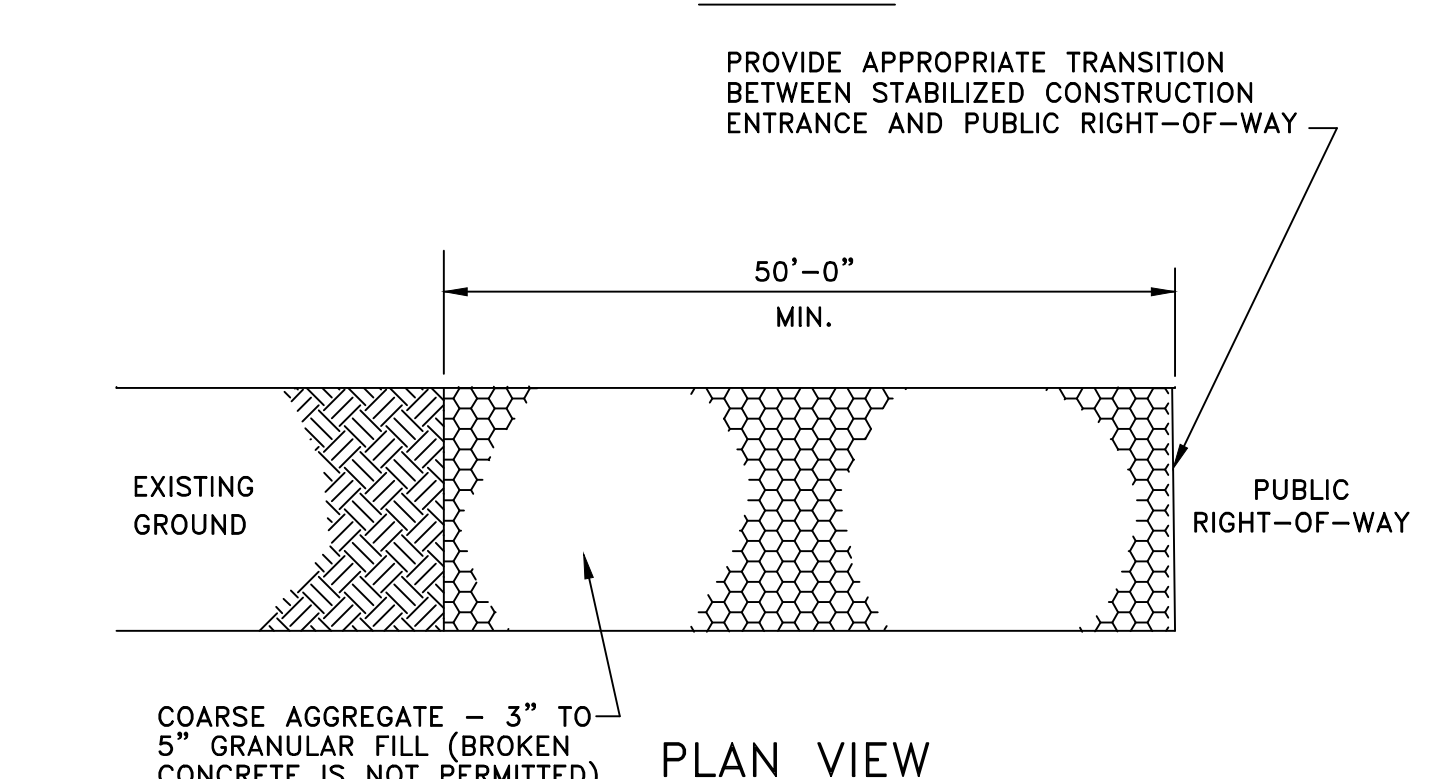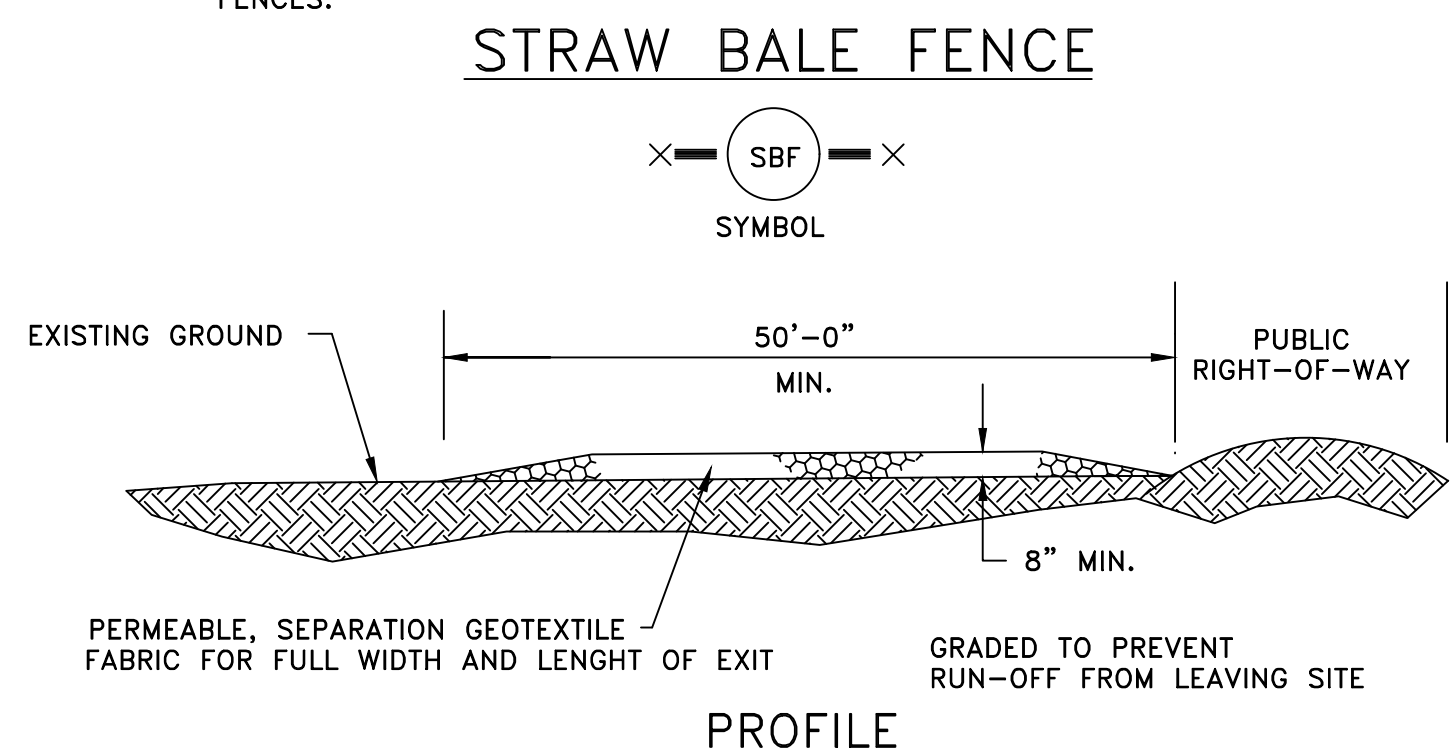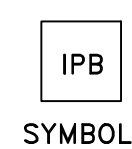

GENERAL NOTES:

- MINIMUM LENGTH IS AS SHOWN ON CONSTRUCTION DRAWINGS OR 50 FEET, WHICHEVER IS MORE.
- CONSTRUCT AND MAINTAIN CONSTRUCTION EXIT WITH CONSTANT WIDTH ACROSS ITS LENGTH, INCLUDING ALL POINTS OF INGRESS OR EGRESS.
- UNLESS SHOWN ON THE CONSTRUCTION DRAWINGS, STABILIZATION FOR OTHER AREAS WILL HAVE THE SAME AGGREGATE THICKNESS AND WIDTH REQUIREMENTS AS THE STABILIZED CONSTRUCTION EXIT.
- WHEN SHOWN ON THE CONSTRUCTION DRAWINGS, WIDEN OR LENGTHEN STABILIZED AREA TO ACCOMMODATE A TRUCK WASHING AREA. PROVIDE OUTLET SEDIMENT TRAP FOR THE TRUCK WASHING AREA.
- PROVIDE PERIODIC TOP DRESSING WITH ADDITIONAL COARSE AGGREGATE TO MAINTAIN THE REQUIRED DEPTH OR WHEN SURFACE BECOMES PACKED WITH MUD.
- PERIODICALLY TURN AGGREGATE TO EXPOSE A CLEAN DRIVING SURFACE.
- ALTERNATIVE METHODS OF CONSTRUCTION INCLUDE:
-CEMENT STABILIZED SOIL: COMPACTED CEMENT STABILIZED SOIL, LIMESTONE AGGREGATE, OR OTHER FILL MATERIAL IN AN APPLICATION OF THICKNESS OF 8 INCHES.
-WOOD MATS: OAK OR OTHER HARDWOOD TIMBERS PLACED EDGE TO EDGE AND ACROSS SUPPORT WOODEN BEAMS WHICH ARE PLACED ON TOP OF EXISTING SOIL IN AN APPLICATION THICKNESS OF 6 INCHES.
-STEEL MATS: PERFORATED MATS PLACED ACROSS PERPENDICULAR SUPPORT MEMBERS.



STABILIZED CONSTRUCTION ACCESS

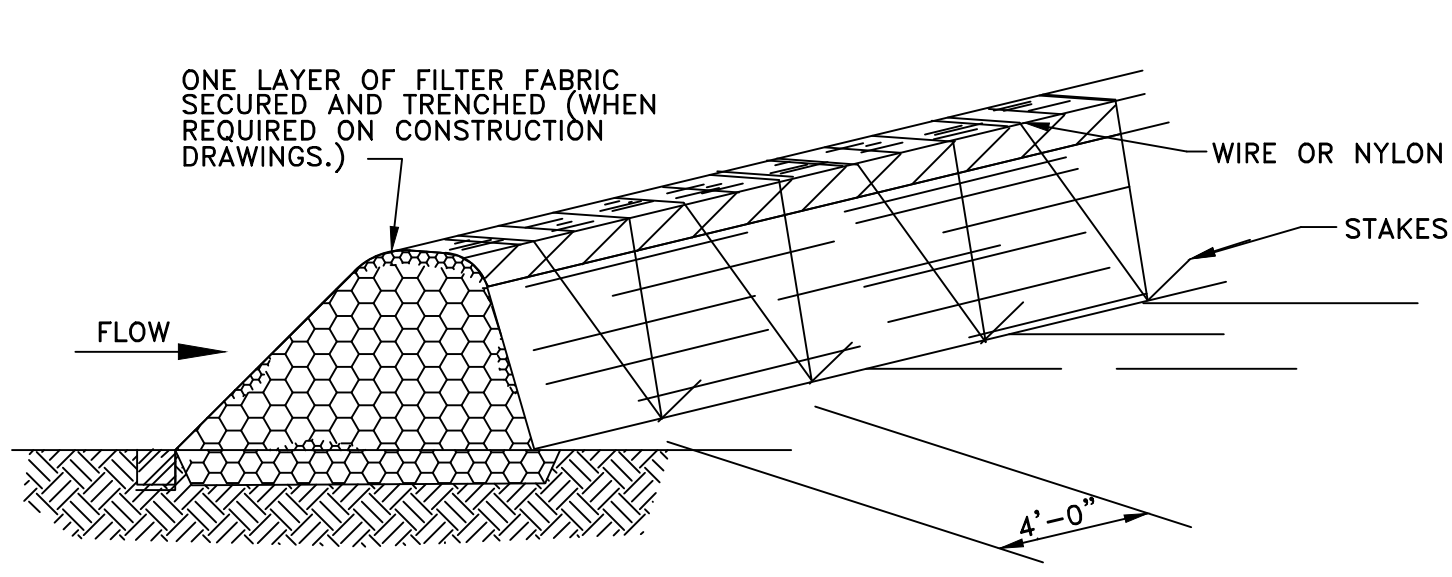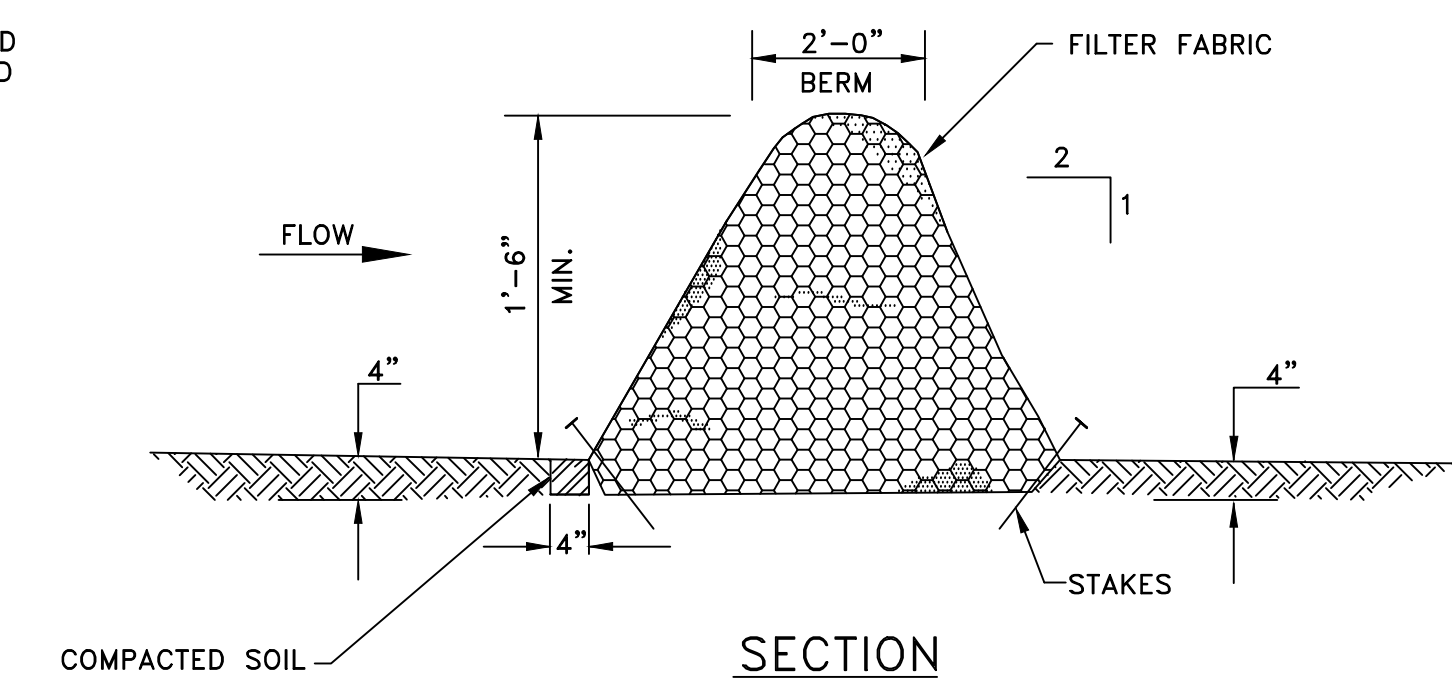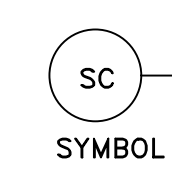

GENERAL NOTES:

- LIMIT USE TO ONSITE SWALES FOR PURPOSES OF LOW FLOW VELOCITY DISSIPATION FOR EROSION CONTROL. USE STRAW BALE FENCES TO TREAT OVERLAND FLOW ONLY. DO NOT USE BRUSH BERMS TO TREAT FLOW IN CHANNELS.
- PLACE WOODY BRUSH AND BRANCHES HAVING A DIAMETER OF LESS THAN 2 INCHES WITH A 6-INCH OVERLAP. AVOID INCORPORATION OF ANNUAL WEEDS AND SOIL INTO BRUSH BERM.
- MINIMUM HEIGHT OF THE BRUSH BERM IS 18 INCHES, MEASURED FROM THE TOP OF THE EXISTING GROUND AT THE UPSLOPE TOE TO THE TOP OF THE BERM.
- HAND PLACE BRUSH BERMS ALONG CONTOUR LINES. MACHINE PLACEMENT OF BRUSH BERMS IS NOT PERMITTED.
- IMBED BRUSH BERM AT LEAST 4 INCHES INTO THE SOIL.
- ANCHOR BRUSH BERMS USING WIRE OR NYLON ROPE ACROSS THE BERM WITH A MINIMUM TENSION OF 50 POUNDS.
- SECURELY TIE ROPE TO 18-INCH REBAR STAKES DRIVEN INTO THE GROUND ON 4-FOOT CENTERS ON BOTH SIDES OF THE BERM.
- PERFORM MAINTENANCE AS NEEDED.

BRUSH BERM

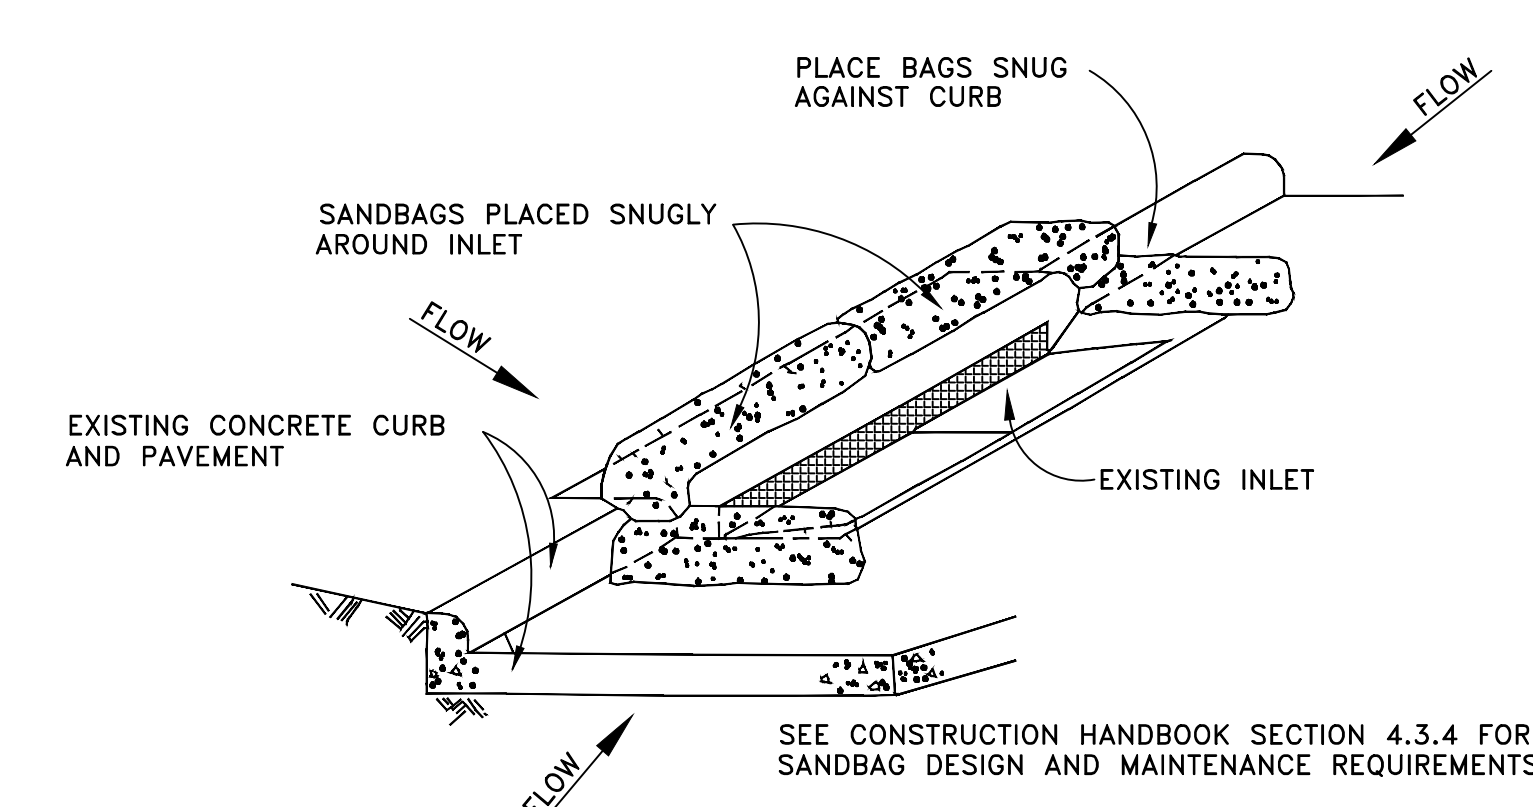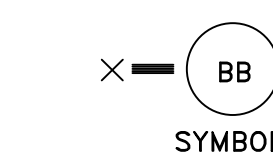

GENERAL NOTES:


- BAGS OR WATTLES CAN BE USED FOR THIS APPLICATION.
- PROVIDE WOVEN OR UNWOVEN GEOTEXTILE FILTER FABRIC FOR BAGS.
- PROVIDE COARSE SAND AND AGGREGATE MIX FOR FILL MATERIAL FOR BAGS. USE ONLY PARTICLES CONSISTING OF CLEAN, HARD, DURABLE MATERIALS FREE FROM ADHERENT COATINGS, SALT, ALKALI, DIRT, CLAY, LOAM, SHALE, SOFT OR FLAKY MATERIALS, OR ORGANIC AND INJURIOUS MATTER.
- REMOVE SEDIMENT DEPOSIT WHEN THE SEDIMENT HAS ACCUMULATED TO ONE-THIRD THE HEIGHT OF THE BARRIER.

INLET PROTECTION BARRIERS FOR STAGE II INLETS




ONE- CALL NOTIFICATION SYSTM
CALL BEFORE YOU DIG!!!
(713) 223-4567 (in Houston, Tx)
(New Statewide Number Outside Houston)
1-800-545-6005

KEY PLAN (NOT TO SCALE)

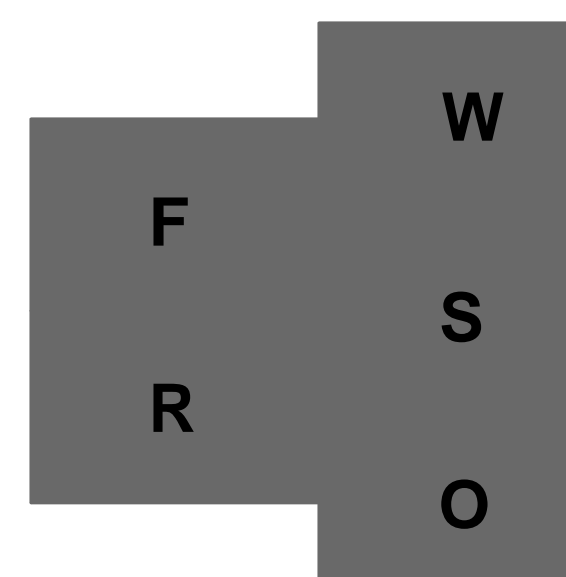






REVISION HISTORY		
NO.	DESCRIPTION	DATE
1	ADDENDUM NO. 3	10-07-2020

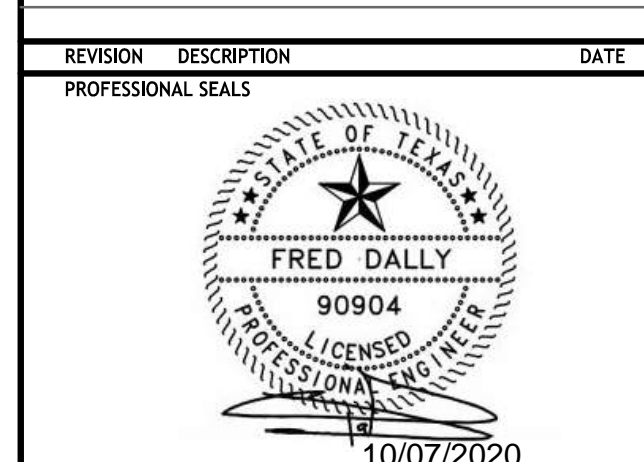

SWPPP DETAILS	
DRAWN BY	CHECKED BY
JDM	JDM
PROJECT NUMBER	PROJECT ABBREVIATION
418198	GC_RBB
ISSUE FOR PERMIT	DATE
	07 OCT 2020


C14.0-PH1

**Galveston County
 Road & Bridge Department Facilities PH1**
 5115 Texas Highway 3
 Dickinson, TX

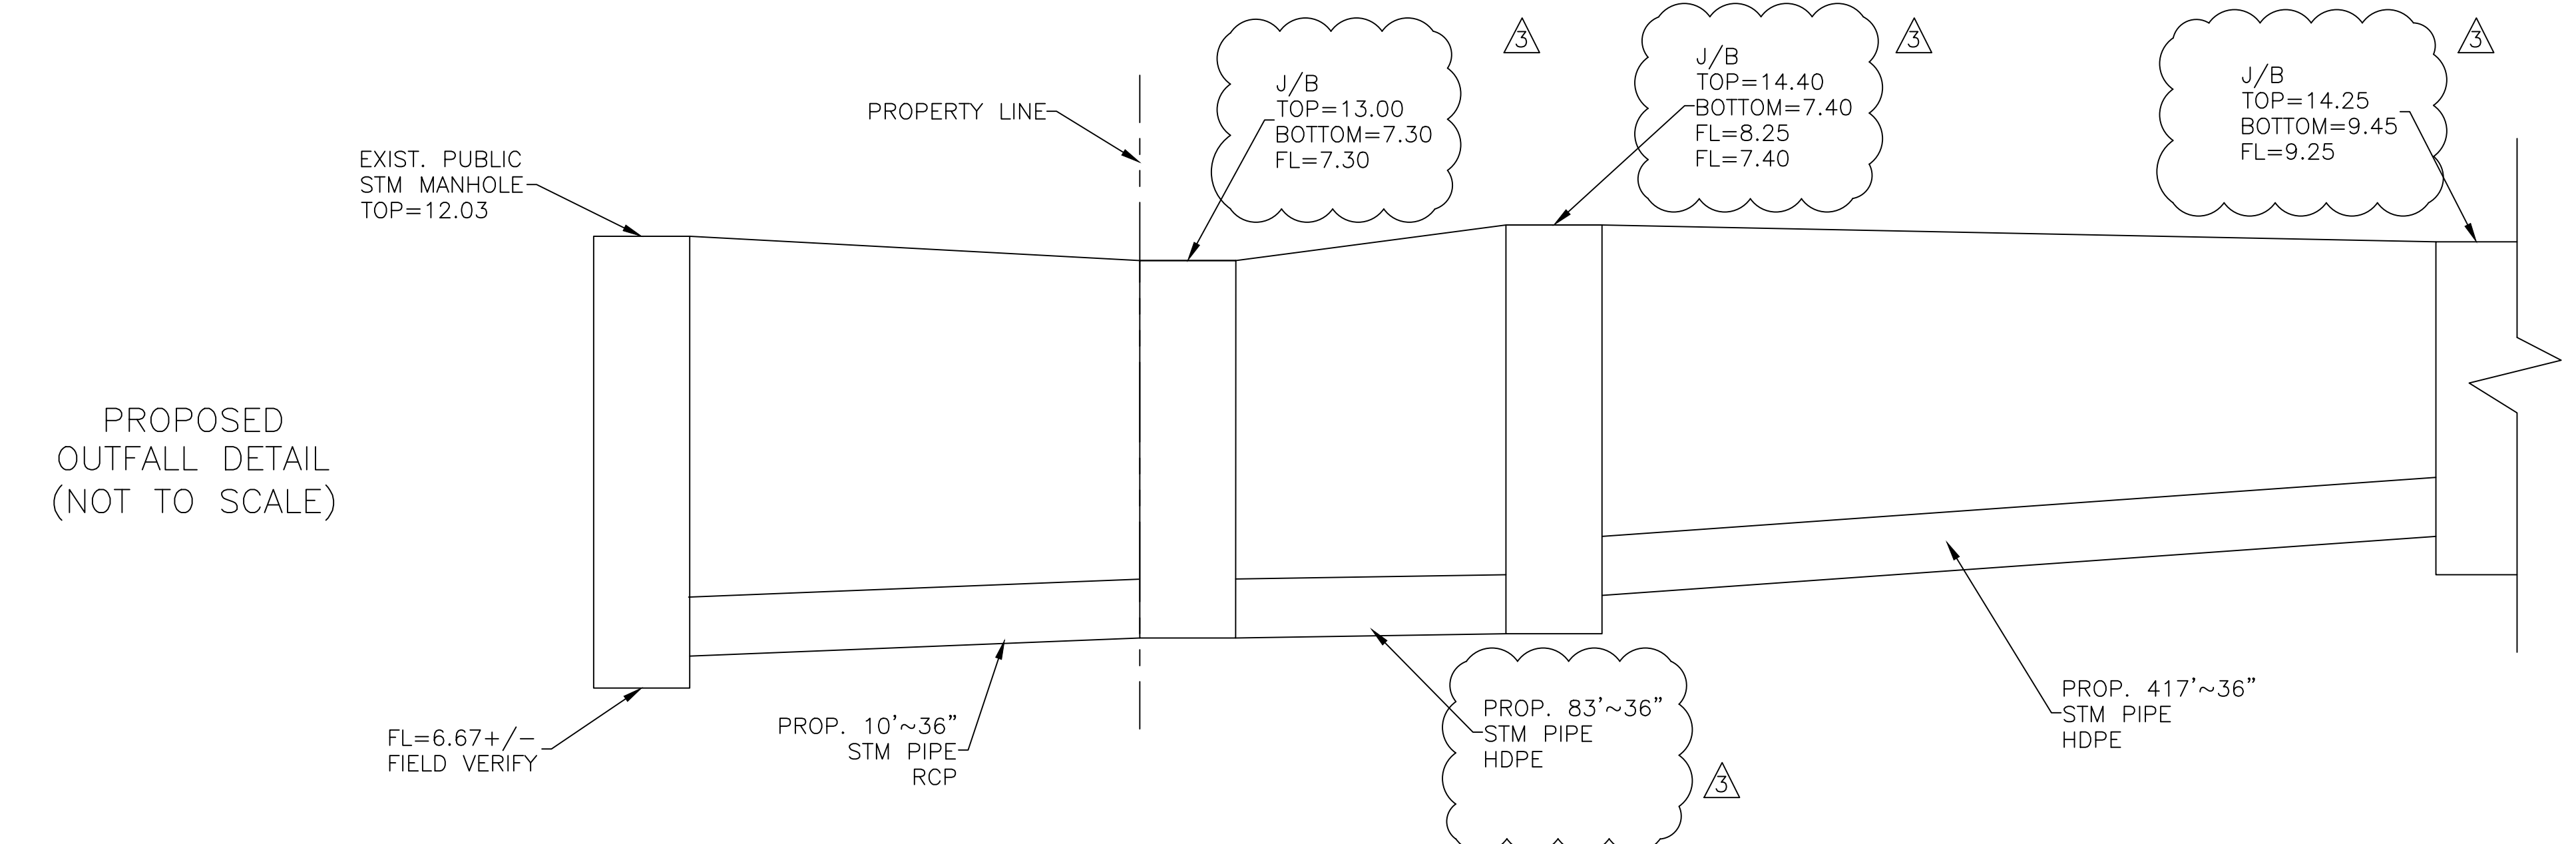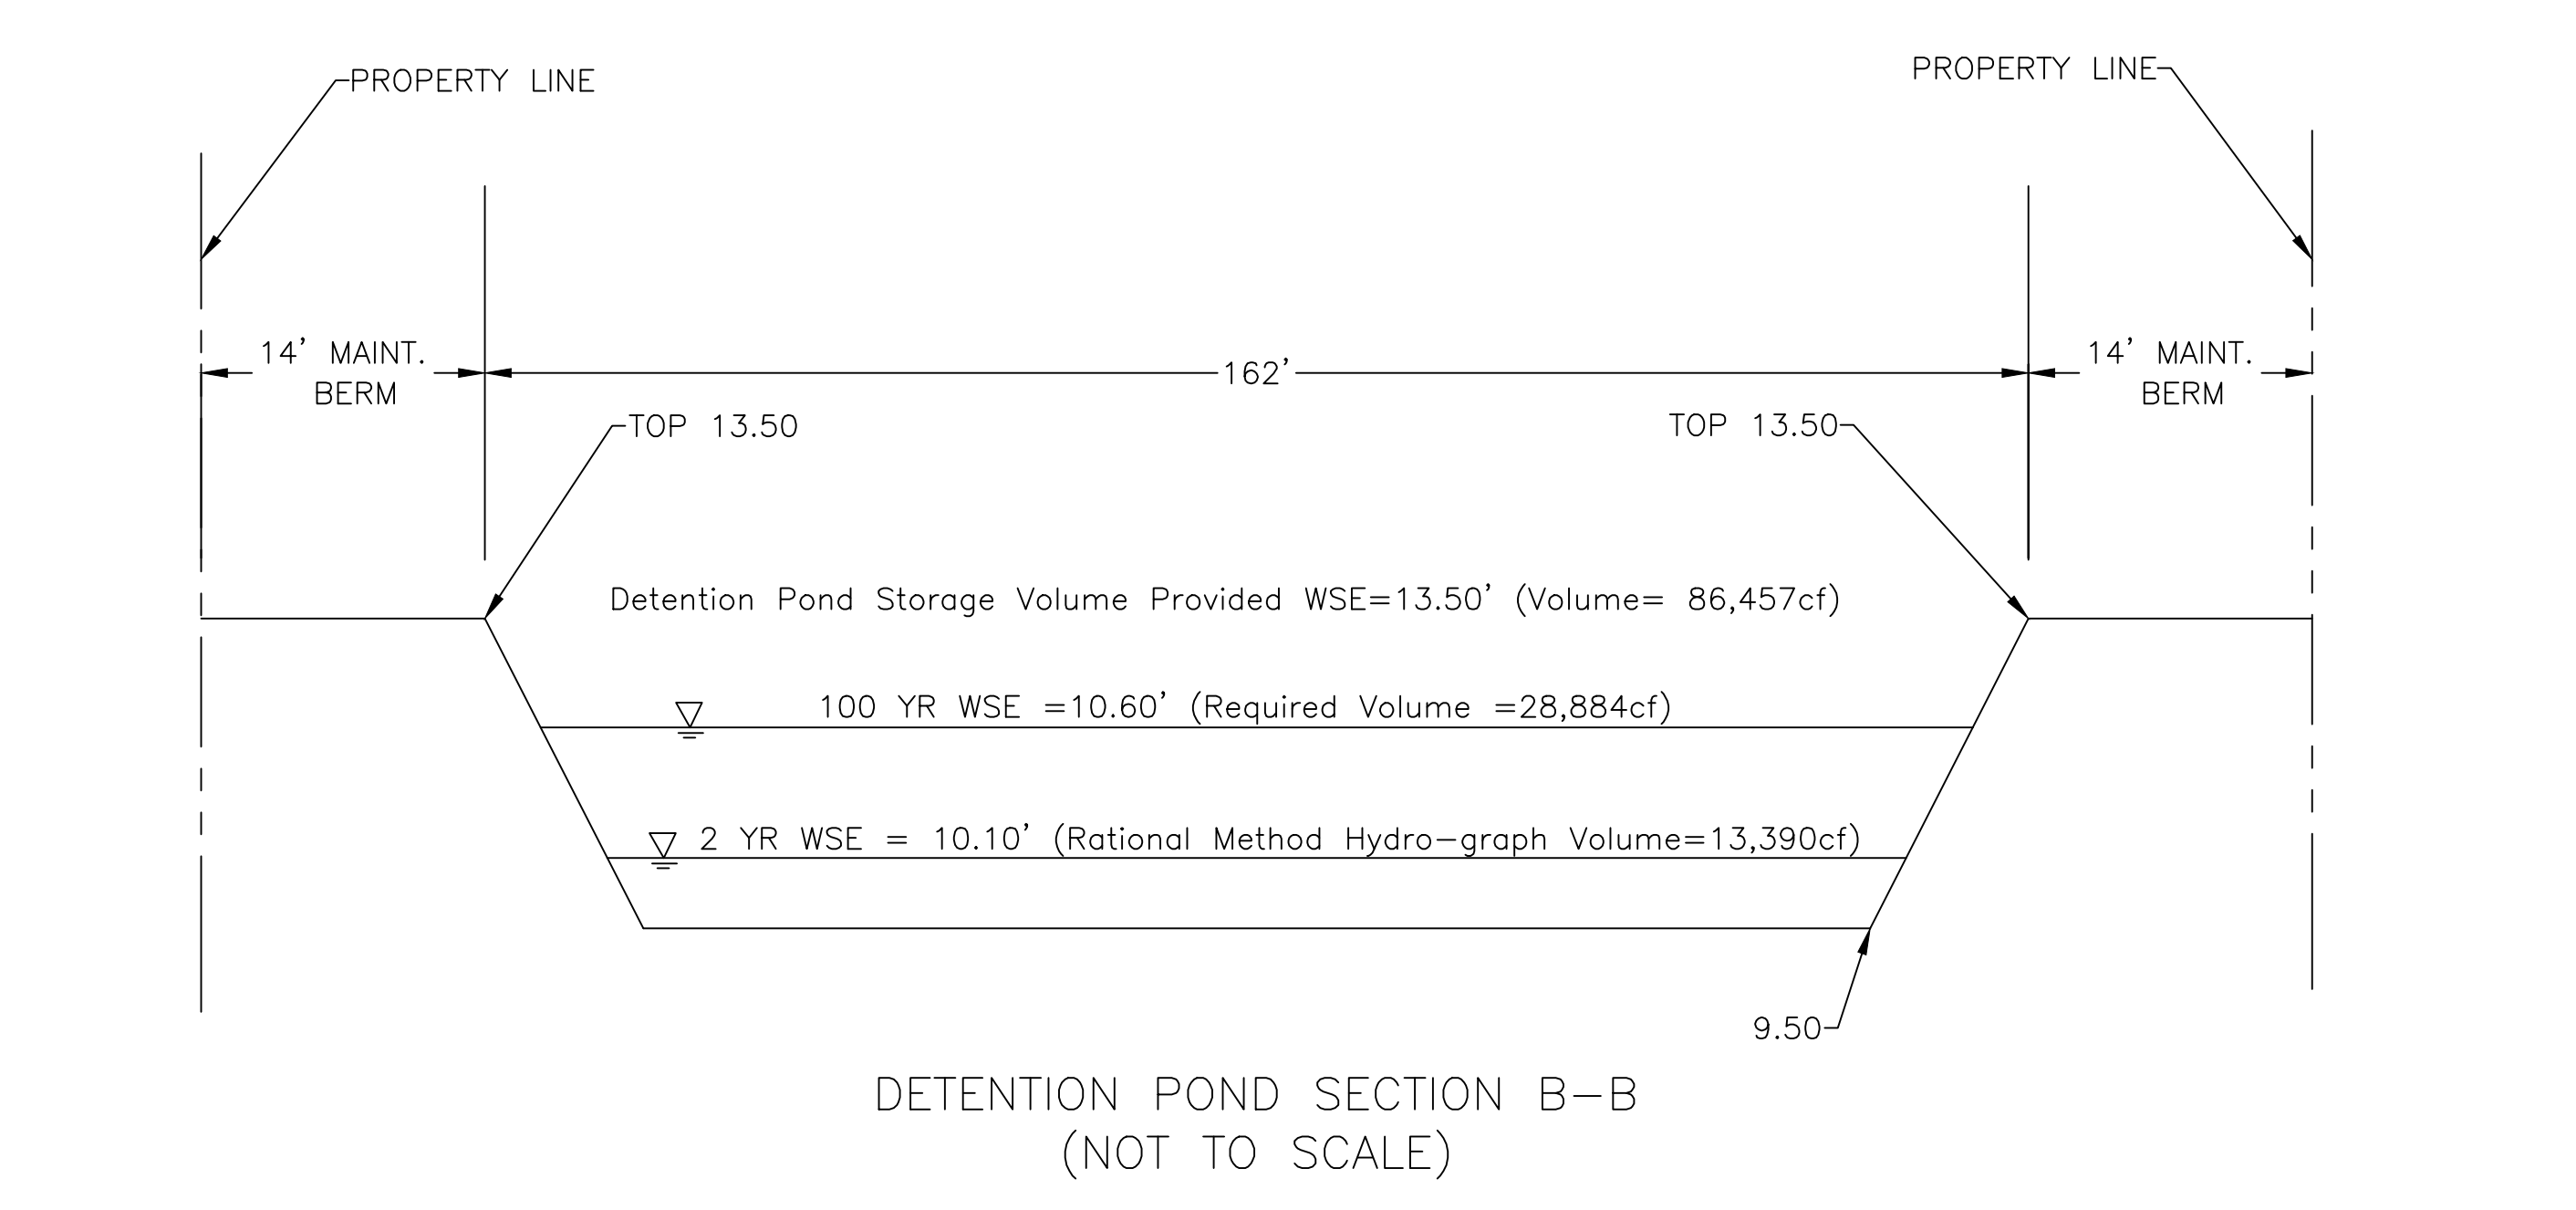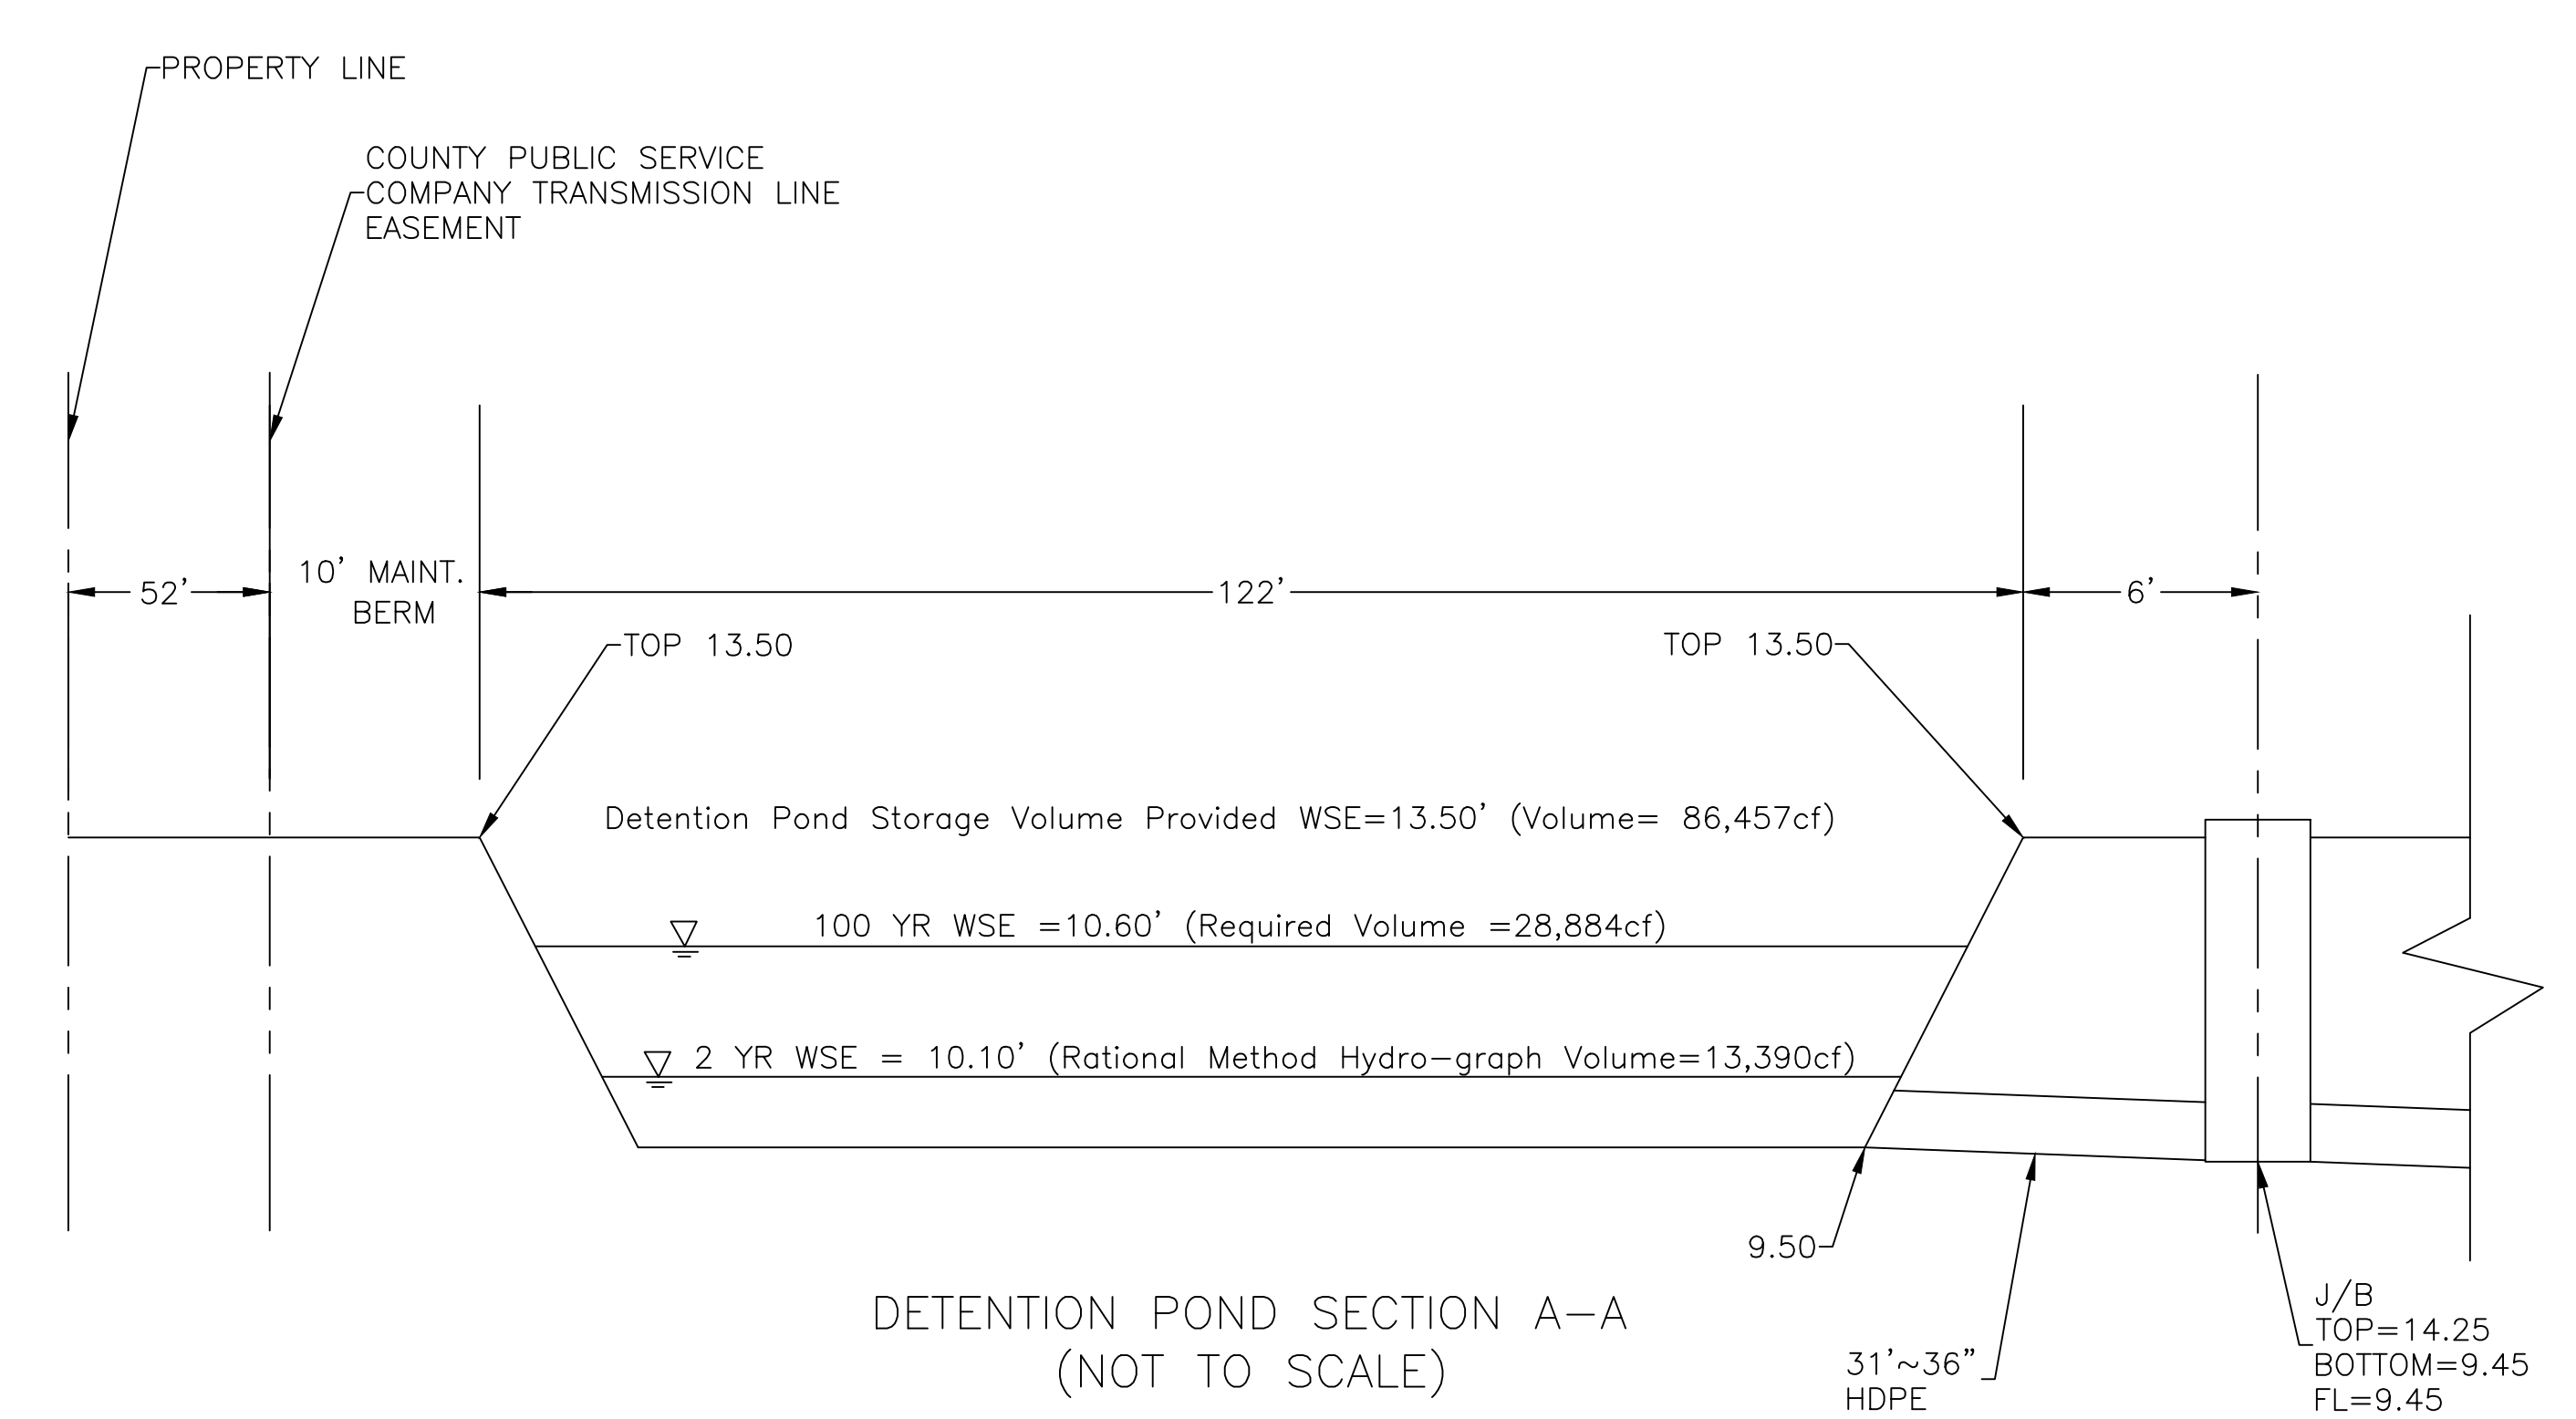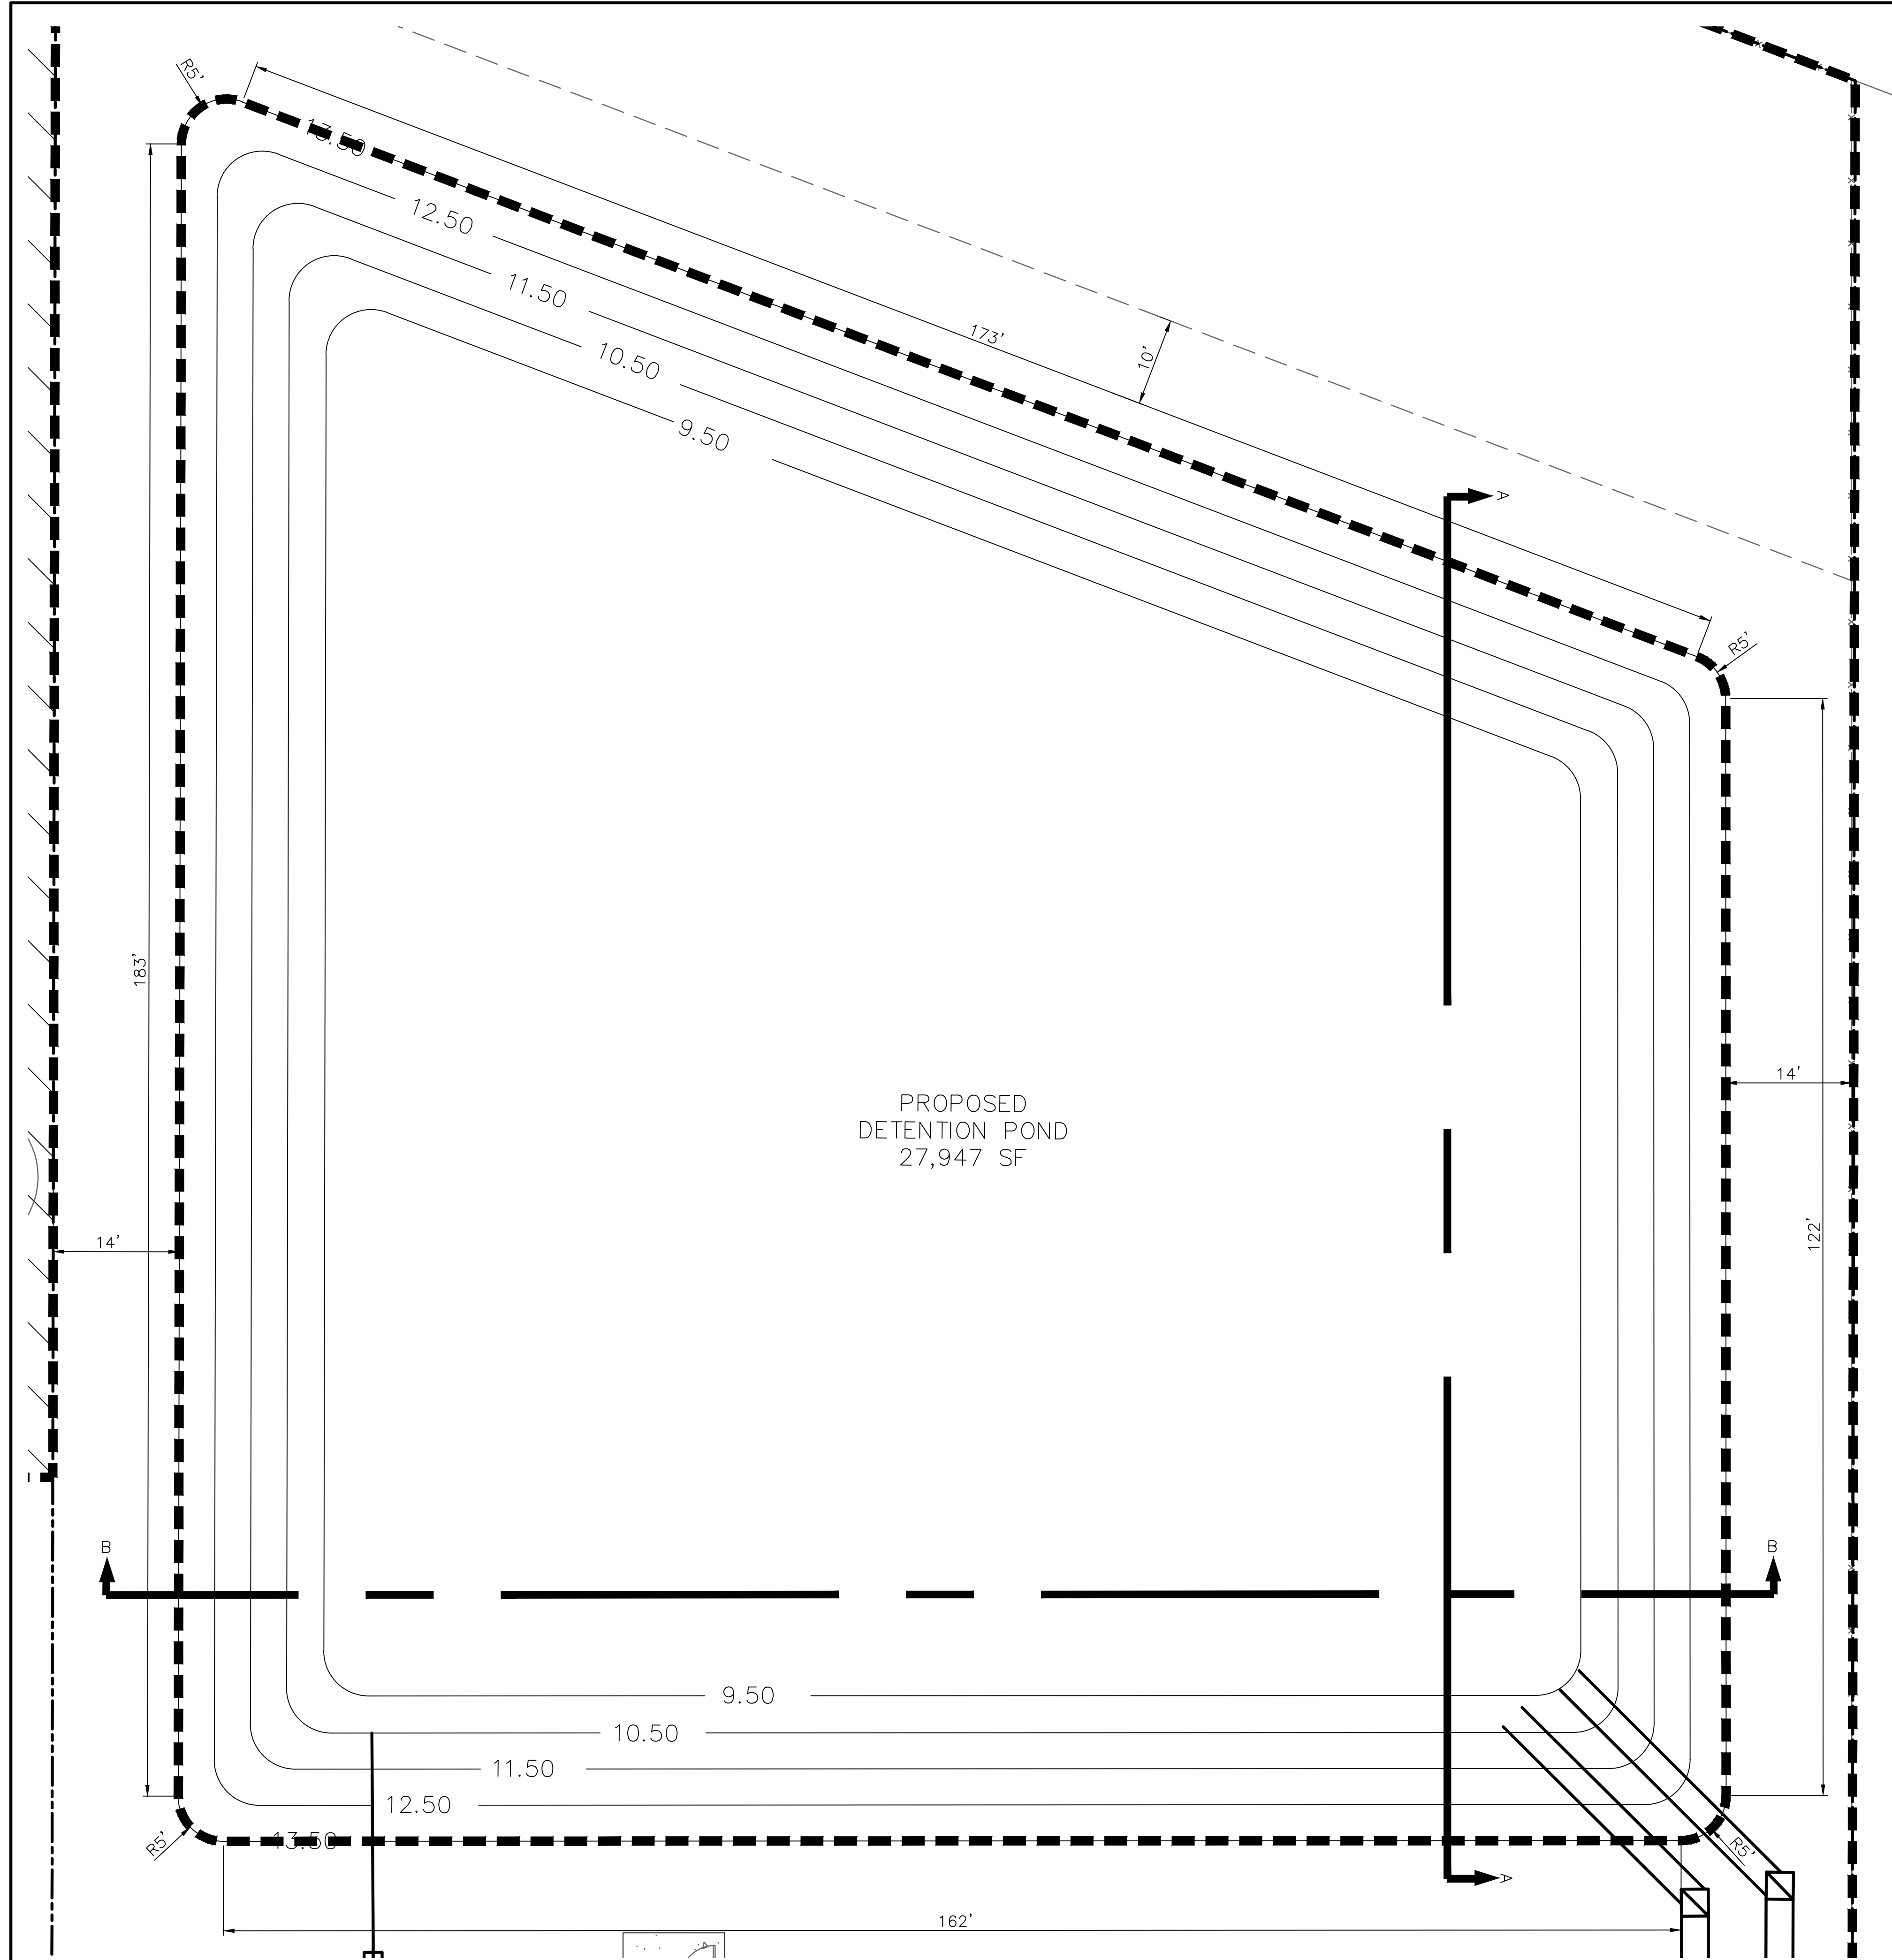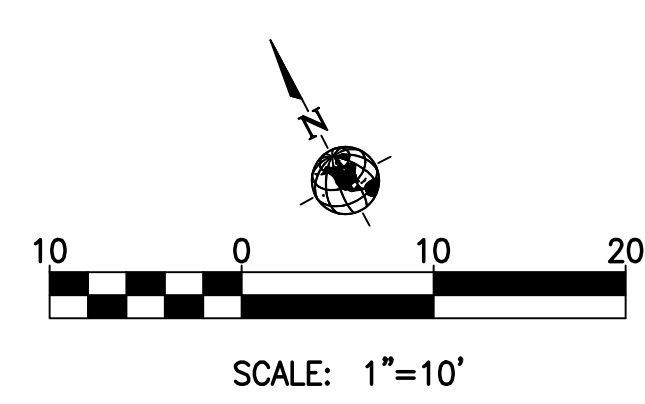

**ONE-CALL NOTIFICATION SYSTEM
 CALL BEFORE YOU DIG!!!**
 (713) 223-4567 (In Houston, TX)
 (New Statewide Number Outside Houston)
 1-800-545-6005

KEY PLAN (NOT TO SCALE)

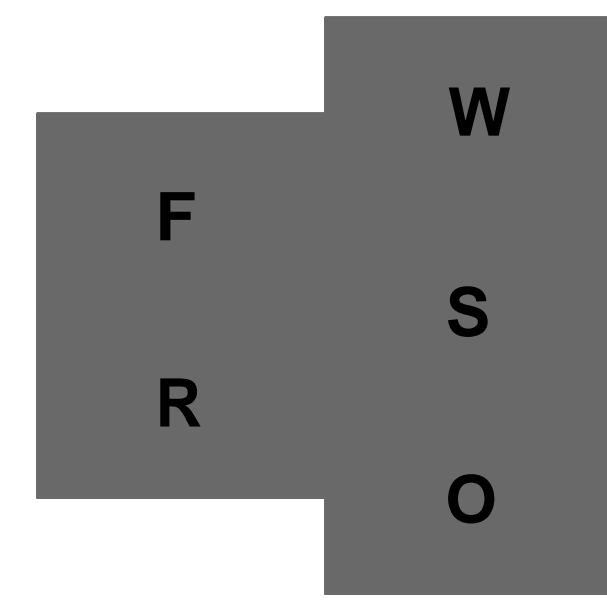

REVISION HISTORY		
ADDENDUM NO. 3		10-07-2020

REVISION DESCRIPTION DATE



PROFESSIONAL SEALS

**DETENTION POND
 CROSS SECTION**


DRAWN BY JDM	CHECKED BY JDM
PROJECT NUMBER 418198	PROJECT ABBREVIATION GC-R&B
ORIGINAL ISSUE ISSUE FOR PERMIT	DATE 07 OCT 2020

C15.0-PH1


Galveston County
Road & Bridge Department Facilities PH1
5115 Texas Highway 3
Dickinson, TX

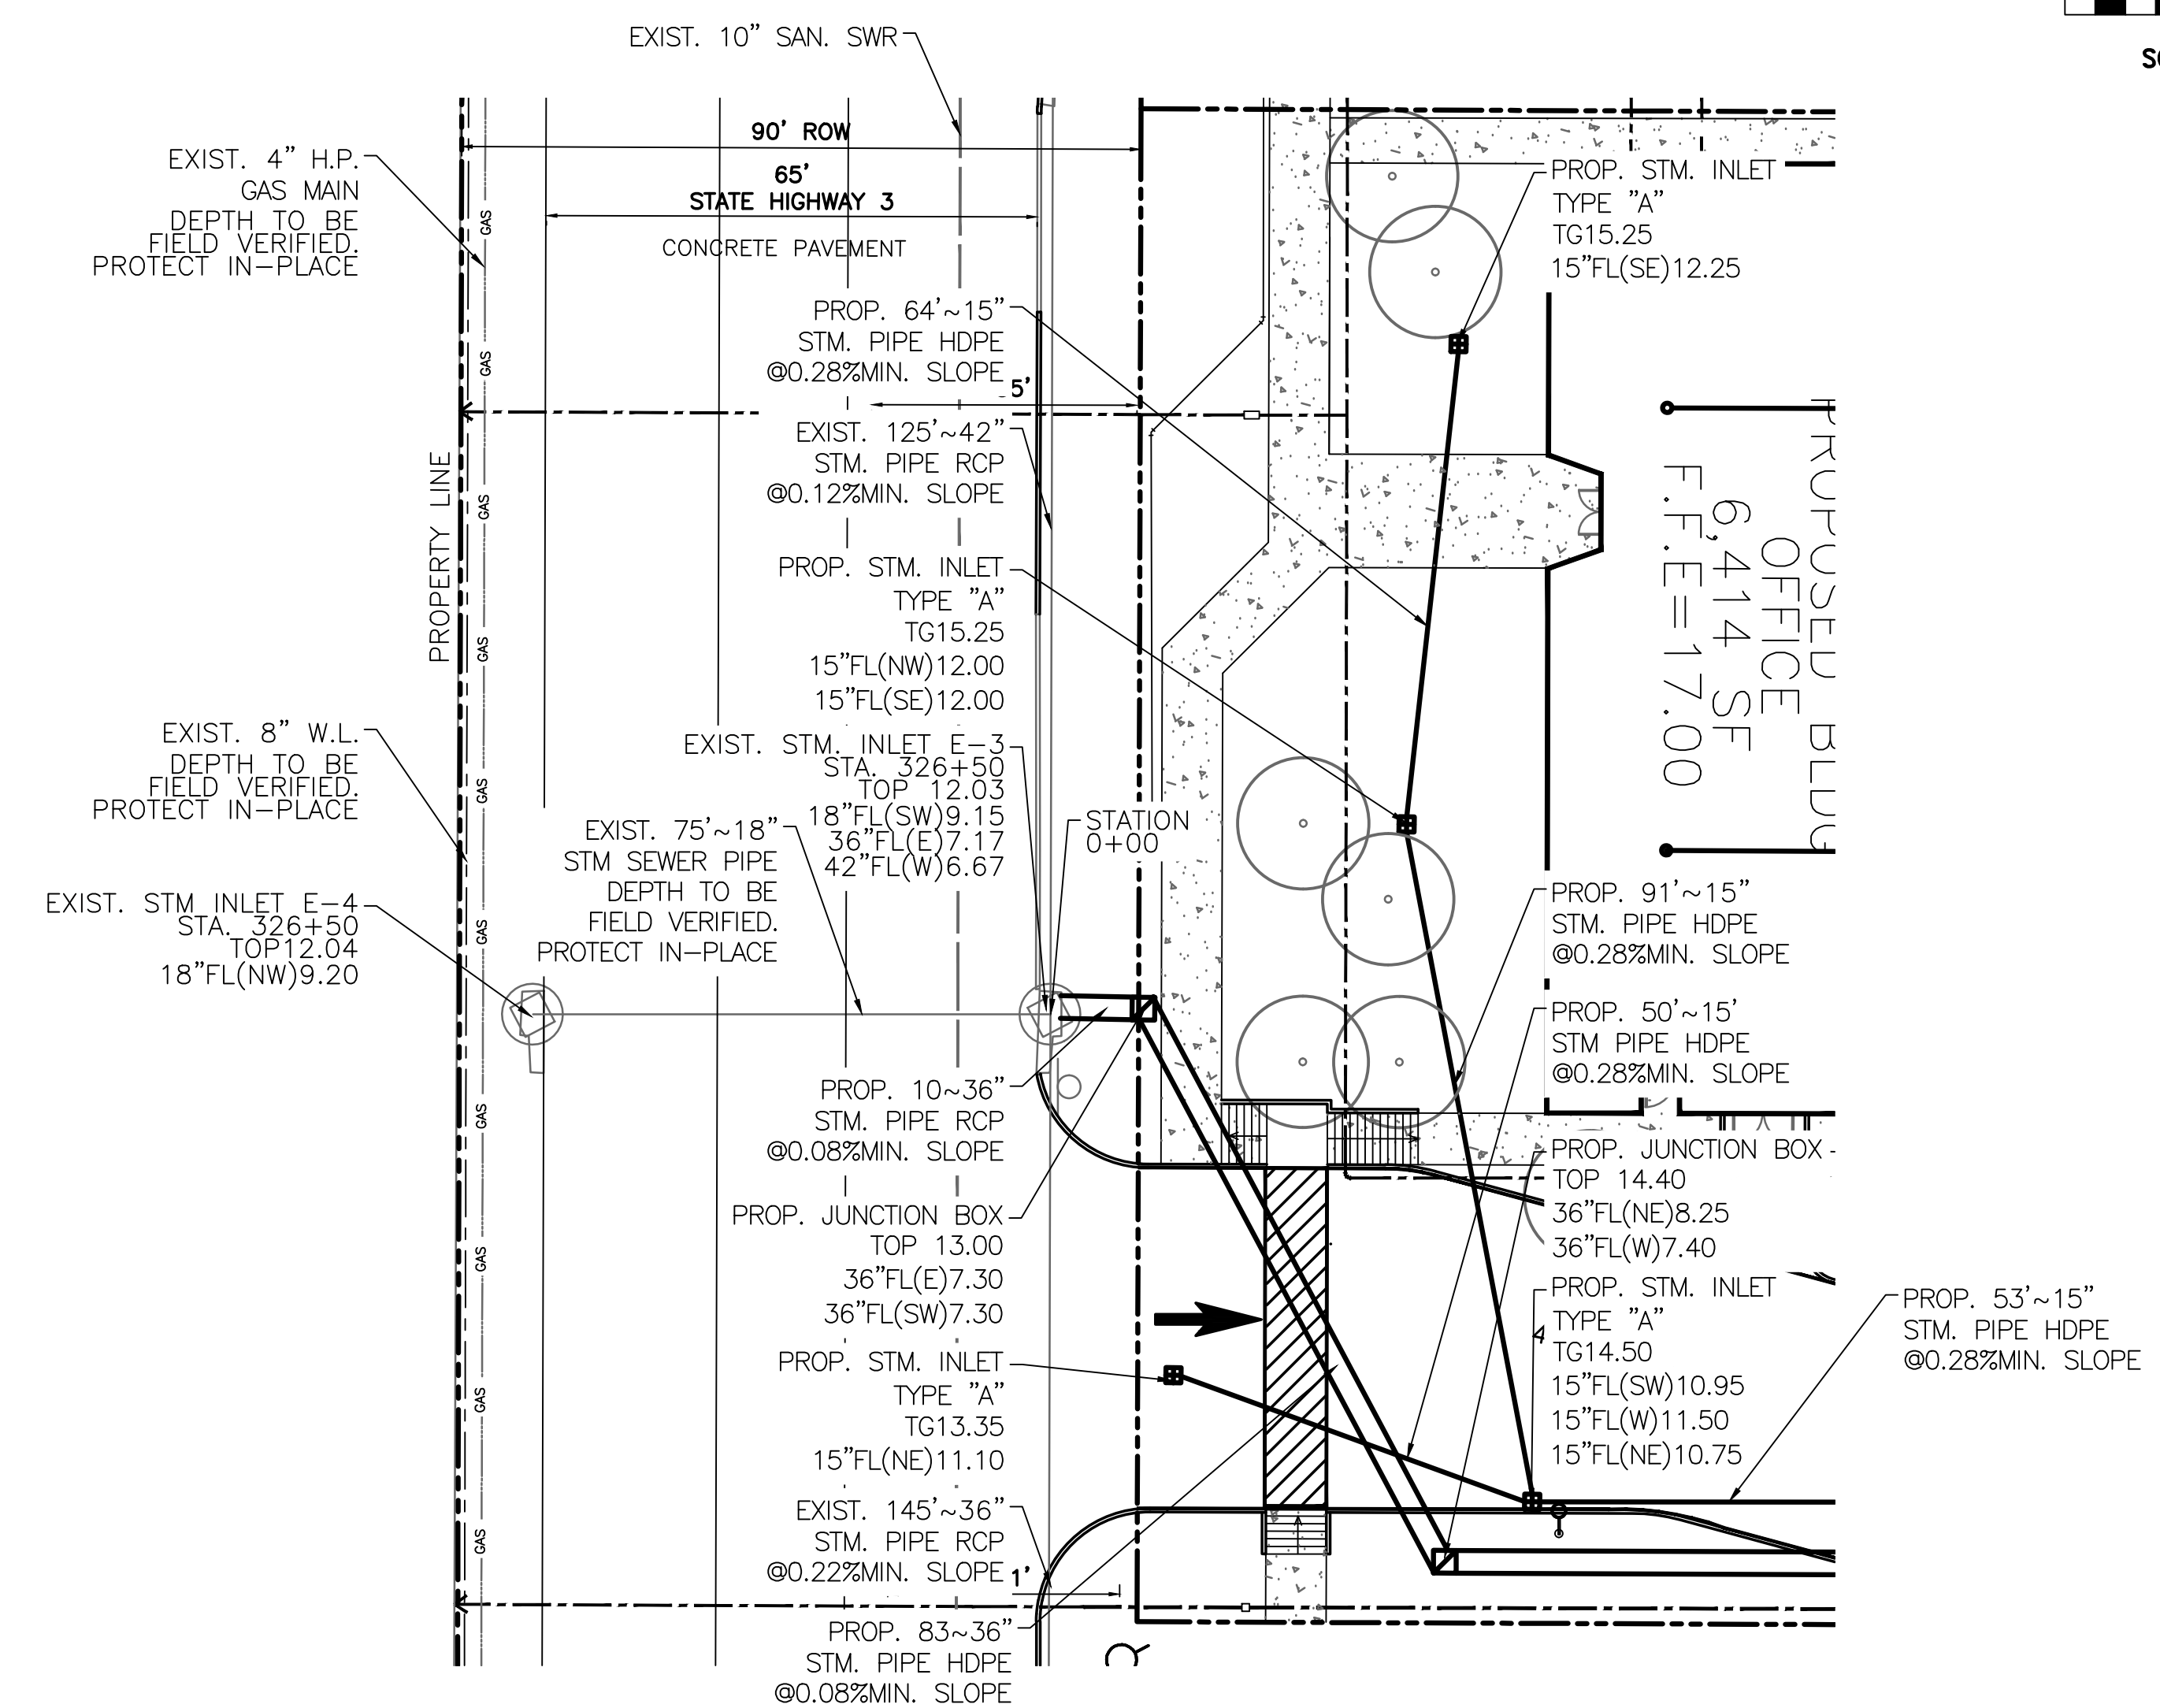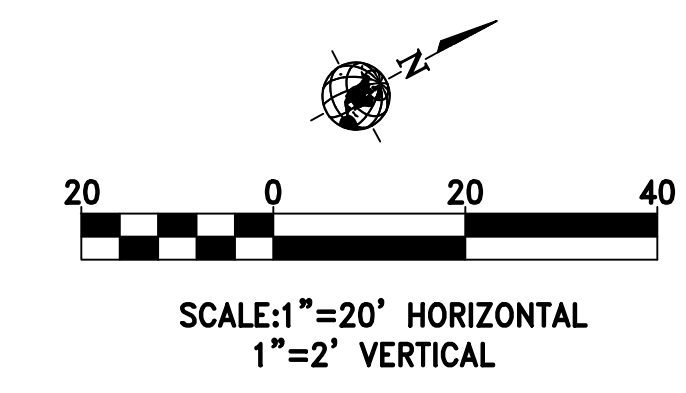

PROPOSED 36" STORM SEWER PLAN VIEW
GALVESTON COUNTY ROAD & BRIDGE DEPARTMENT FACILITIES, HIGHWAY 3

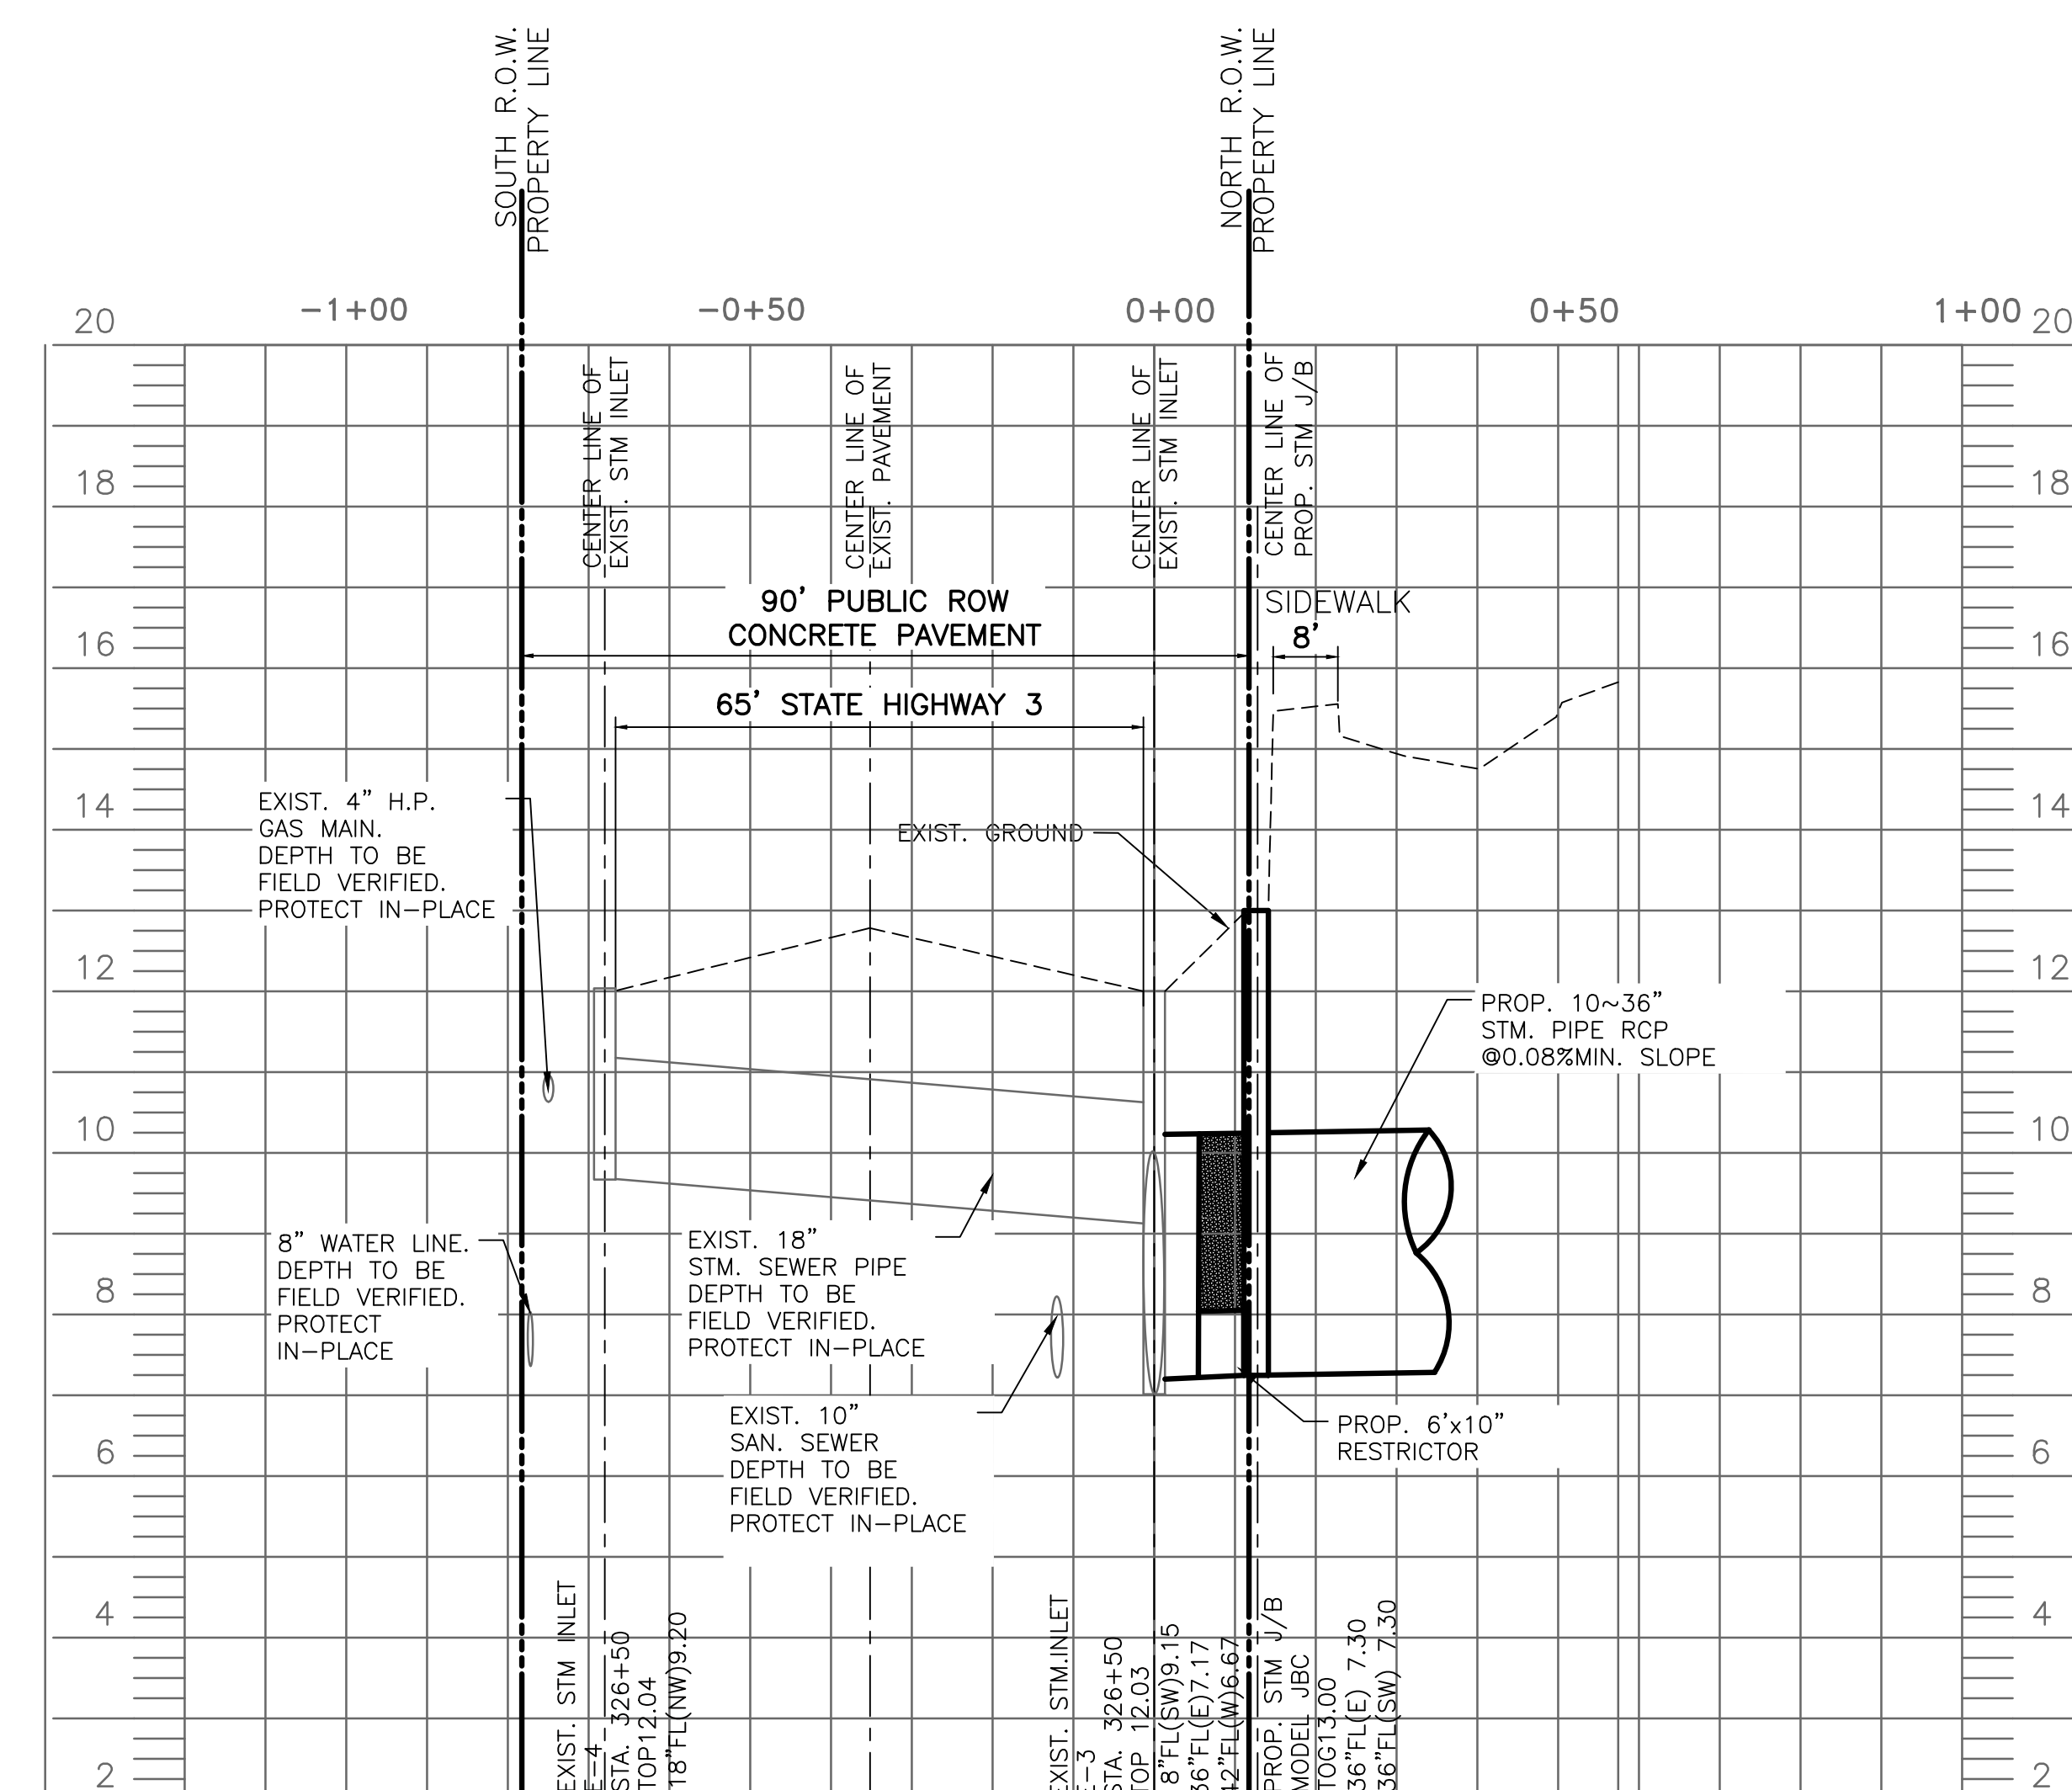


PROPOSED 36" STORM SEWER PROFILE VIEW
GALVESTON COUNTY ROAD & BRIDGE DEPARTMENT FACILITIES, HIGHWAY 3

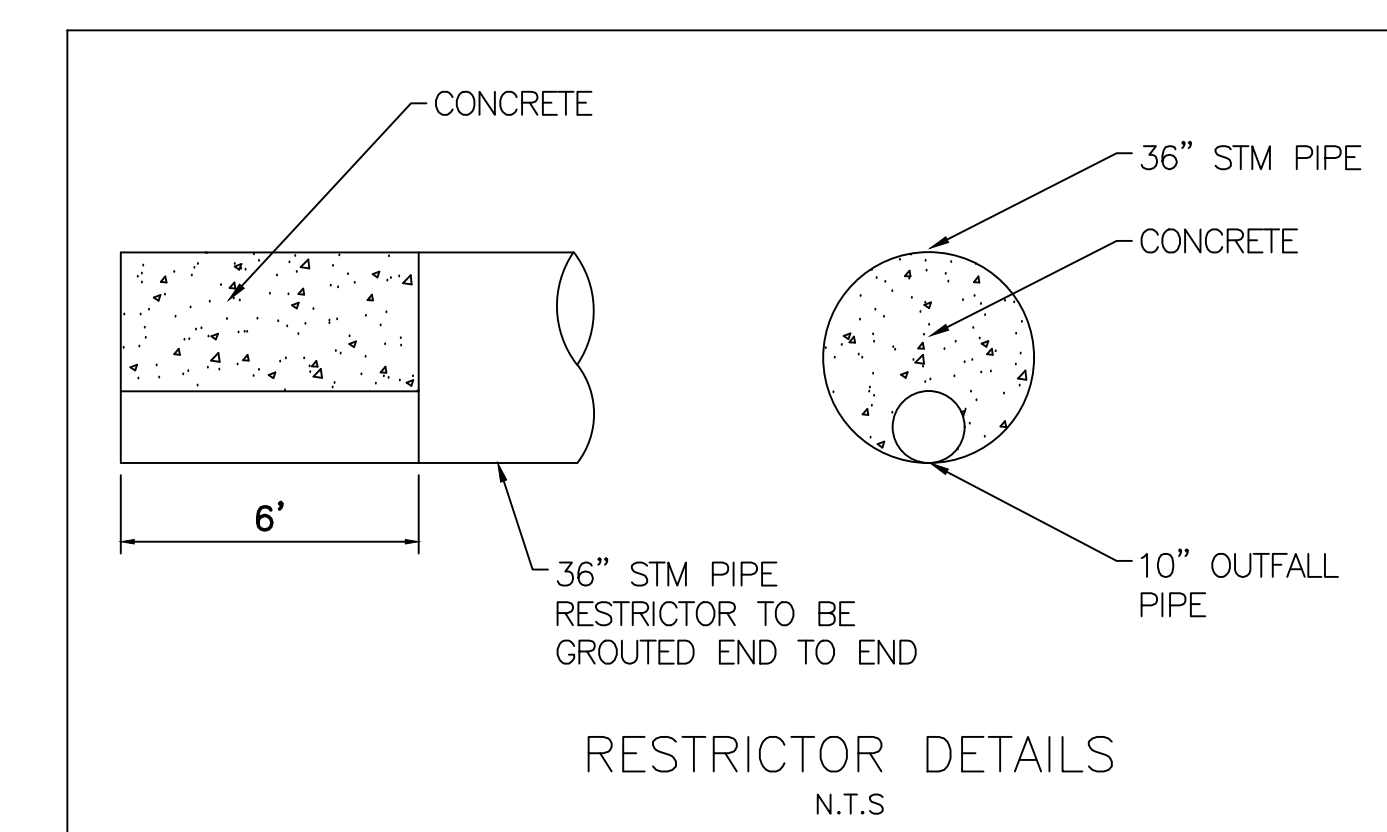

ONE- CALL NOTIFICATION SYSTEM
CALL BEFORE YOU DIG!!!
(713) 223-4567 (in Houston, Tx)
(New Statewide Number Outside Houston)
1-800-545-6005

KEY PLAN (NOT TO SCALE)

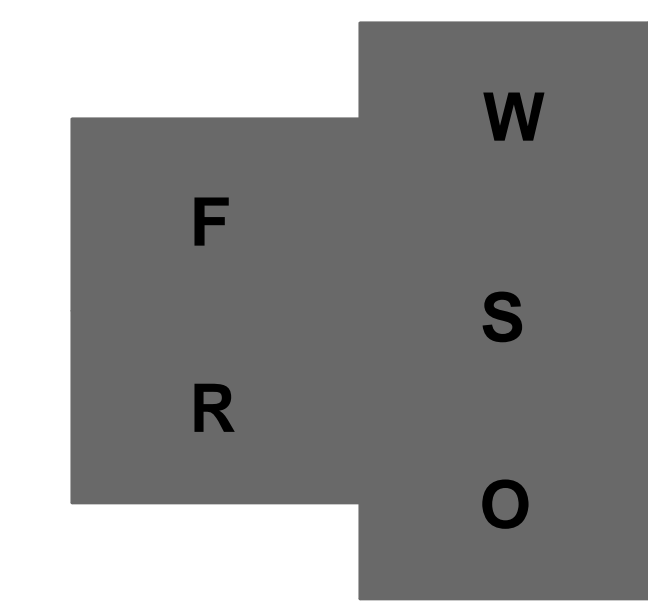

REVISION HISTORY		
ADDENDUM NO. 3	10-07-2020	

REVISION	DESCRIPTION	DATE
1	PROFESSIONAL SEAL	10/07/2020

STORM DRAIN PLAN & PROFILE

DRAWN BY JDM	CHECKED BY JDM
PROJECT NUMBER 418198	PROJECT ABBREVIATION GC_RBB
ORIGINAL ISSUE ISSUE FOR PERMIT	DATE 07 OCT 2020

C16.0-PH1
SHEET NUMBER

Galveston County
Road & Bridge Department Facilities PH1
5115 Texas Highway 3
Dickinson, TX








REVISION	DESCRIPTION	DATE
1	ADDENDUM NO. 3	10-07-2020

PROFESSIONAL SEAL

WATER LINE PLAN & PROFILE


DRAWN BY JDM	CHECKED BY JDM
PROJECT NUMBER 418198	PROJECT ABBREVIATION GC_RBB
ORIGINAL ISSUE ISSUE FOR PERMIT	DATE 07 OCT 2020

C17.0-PH1

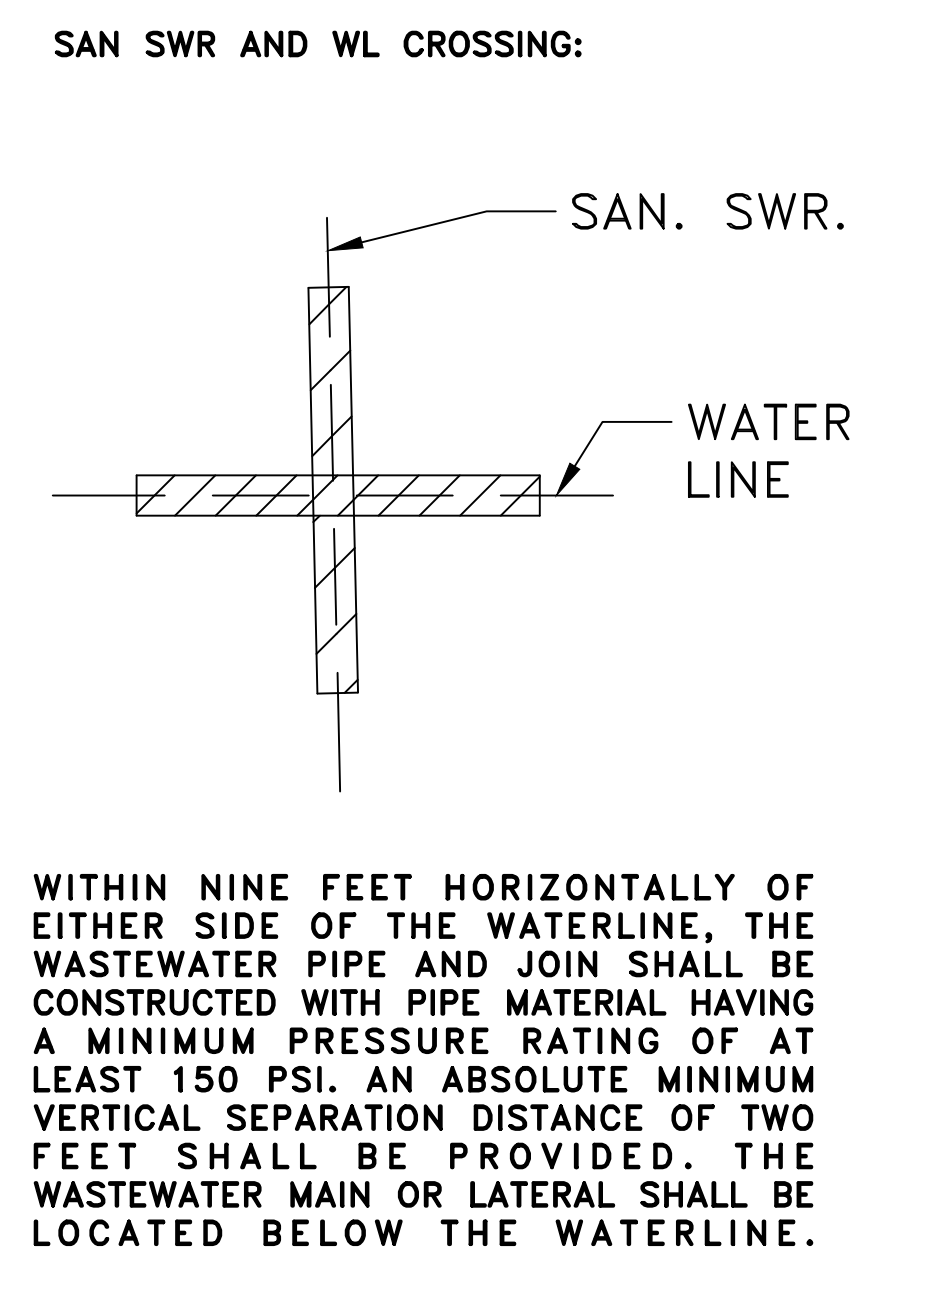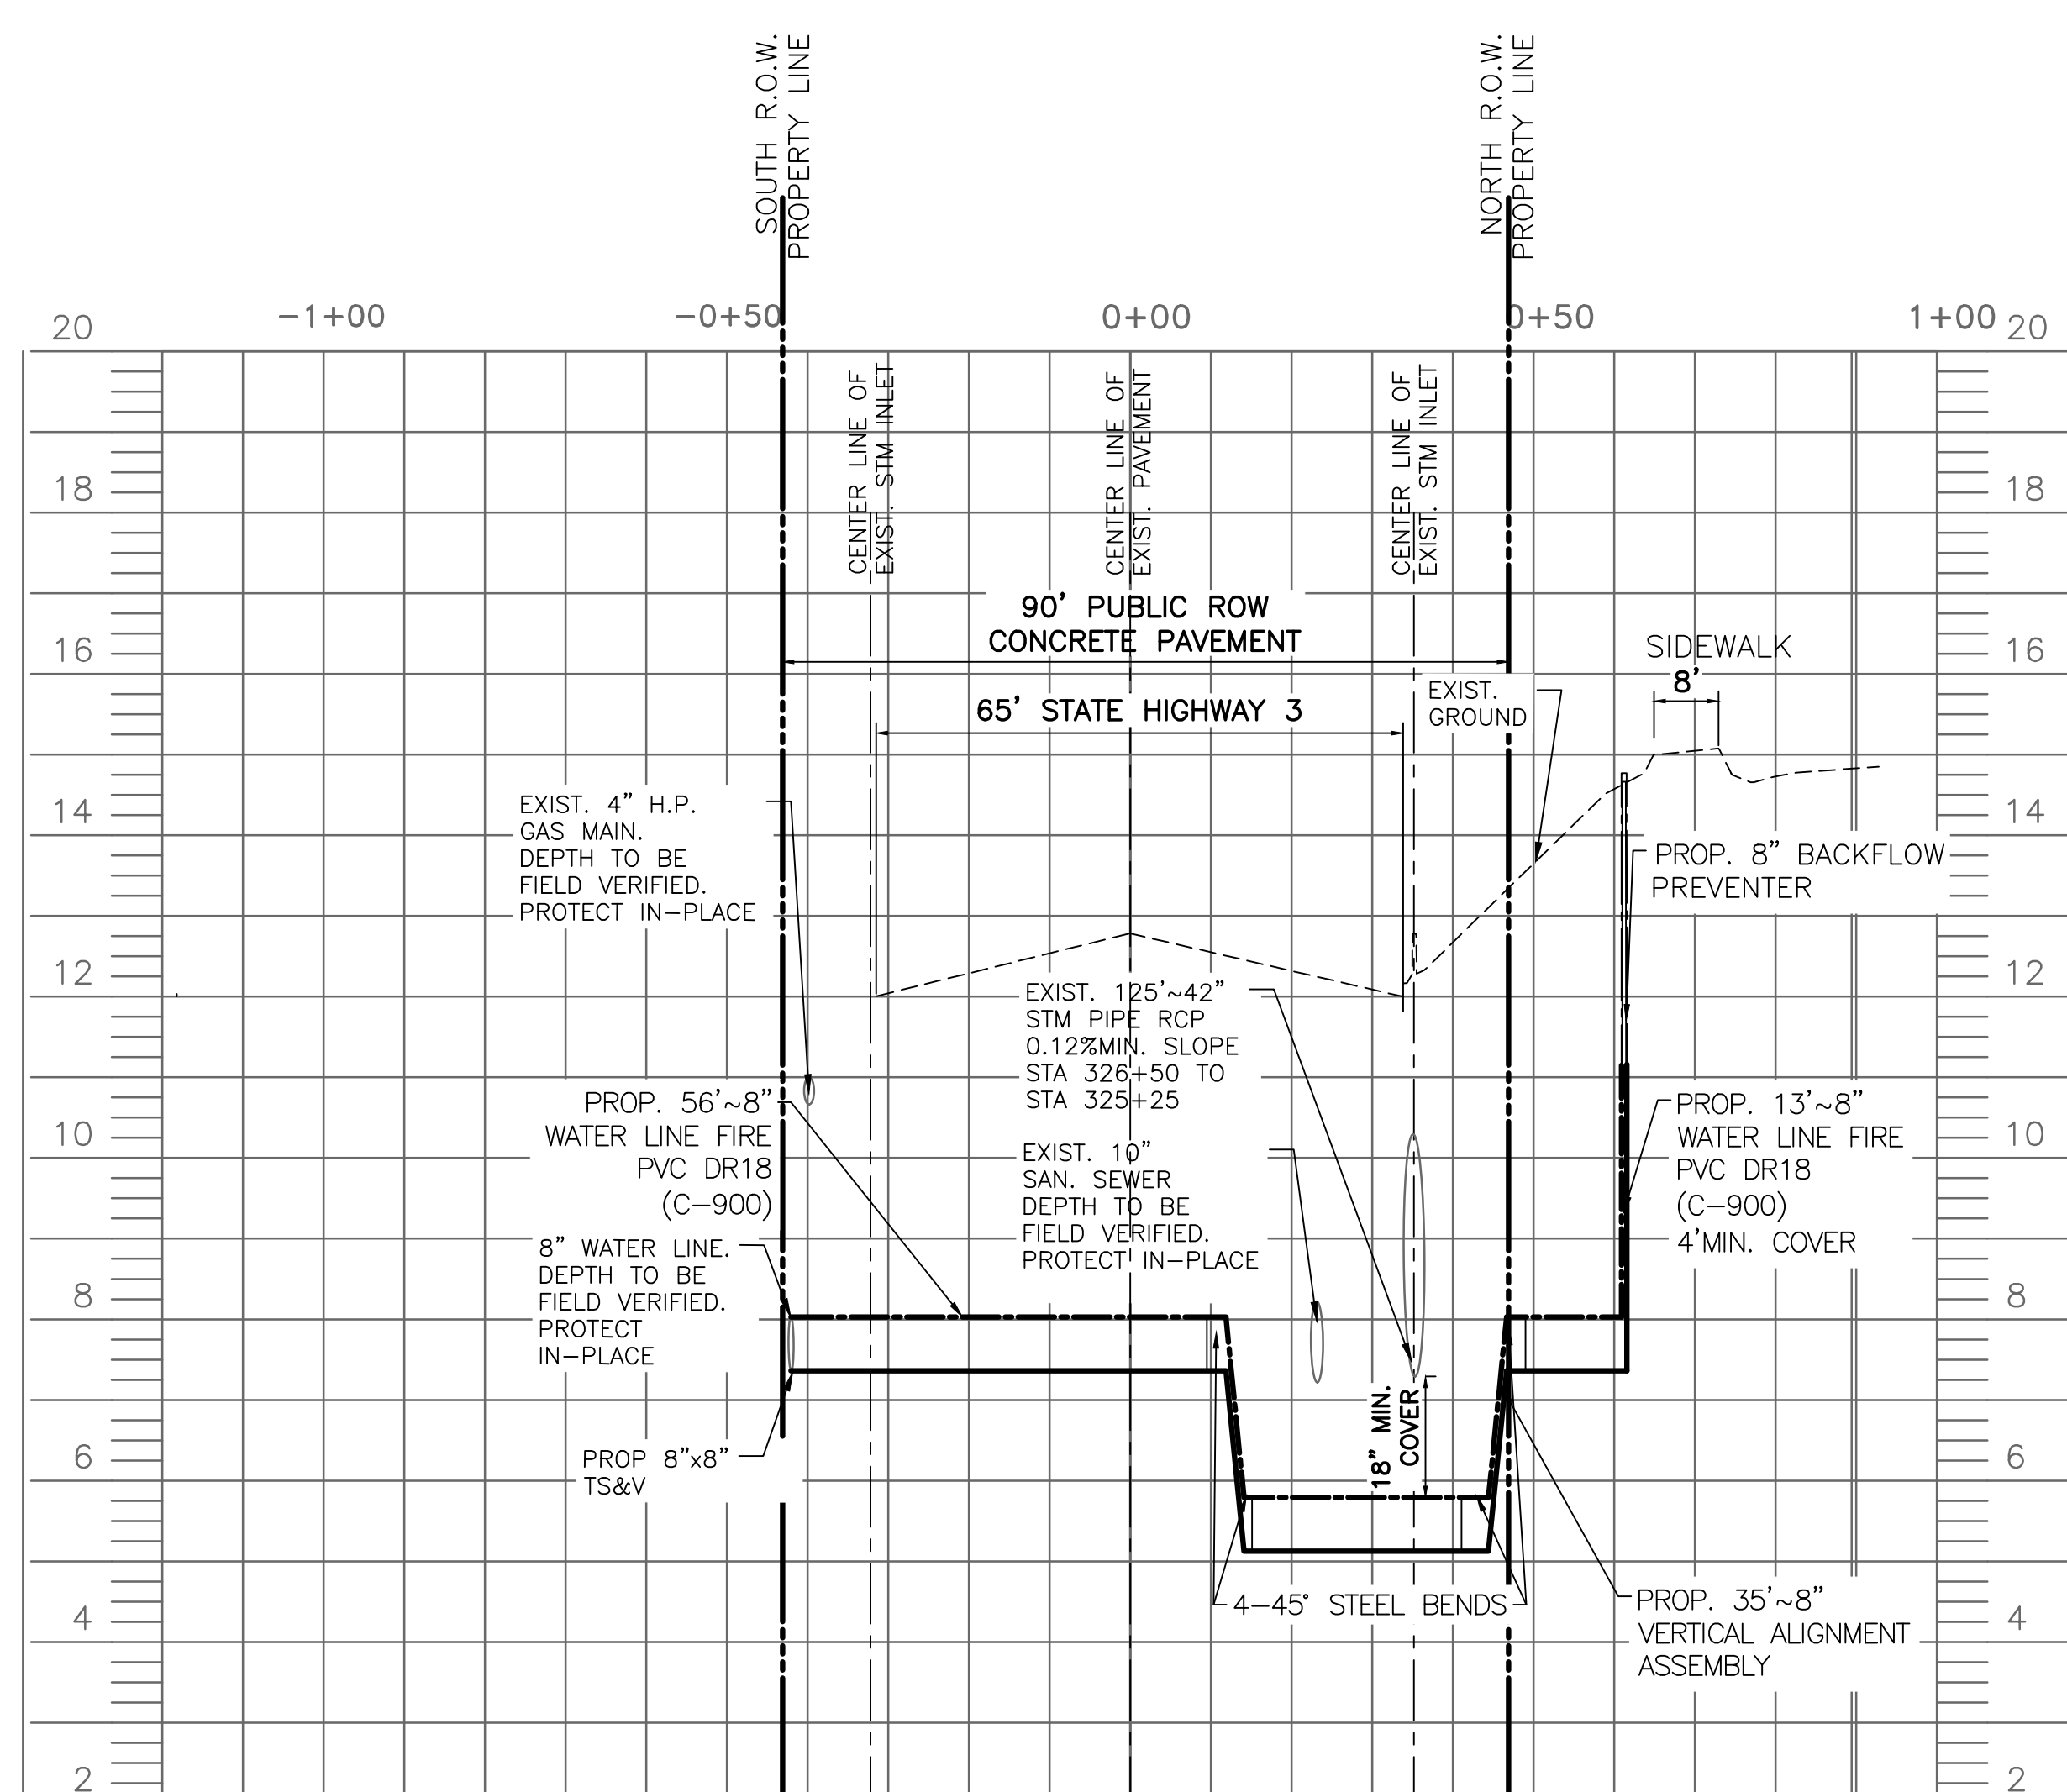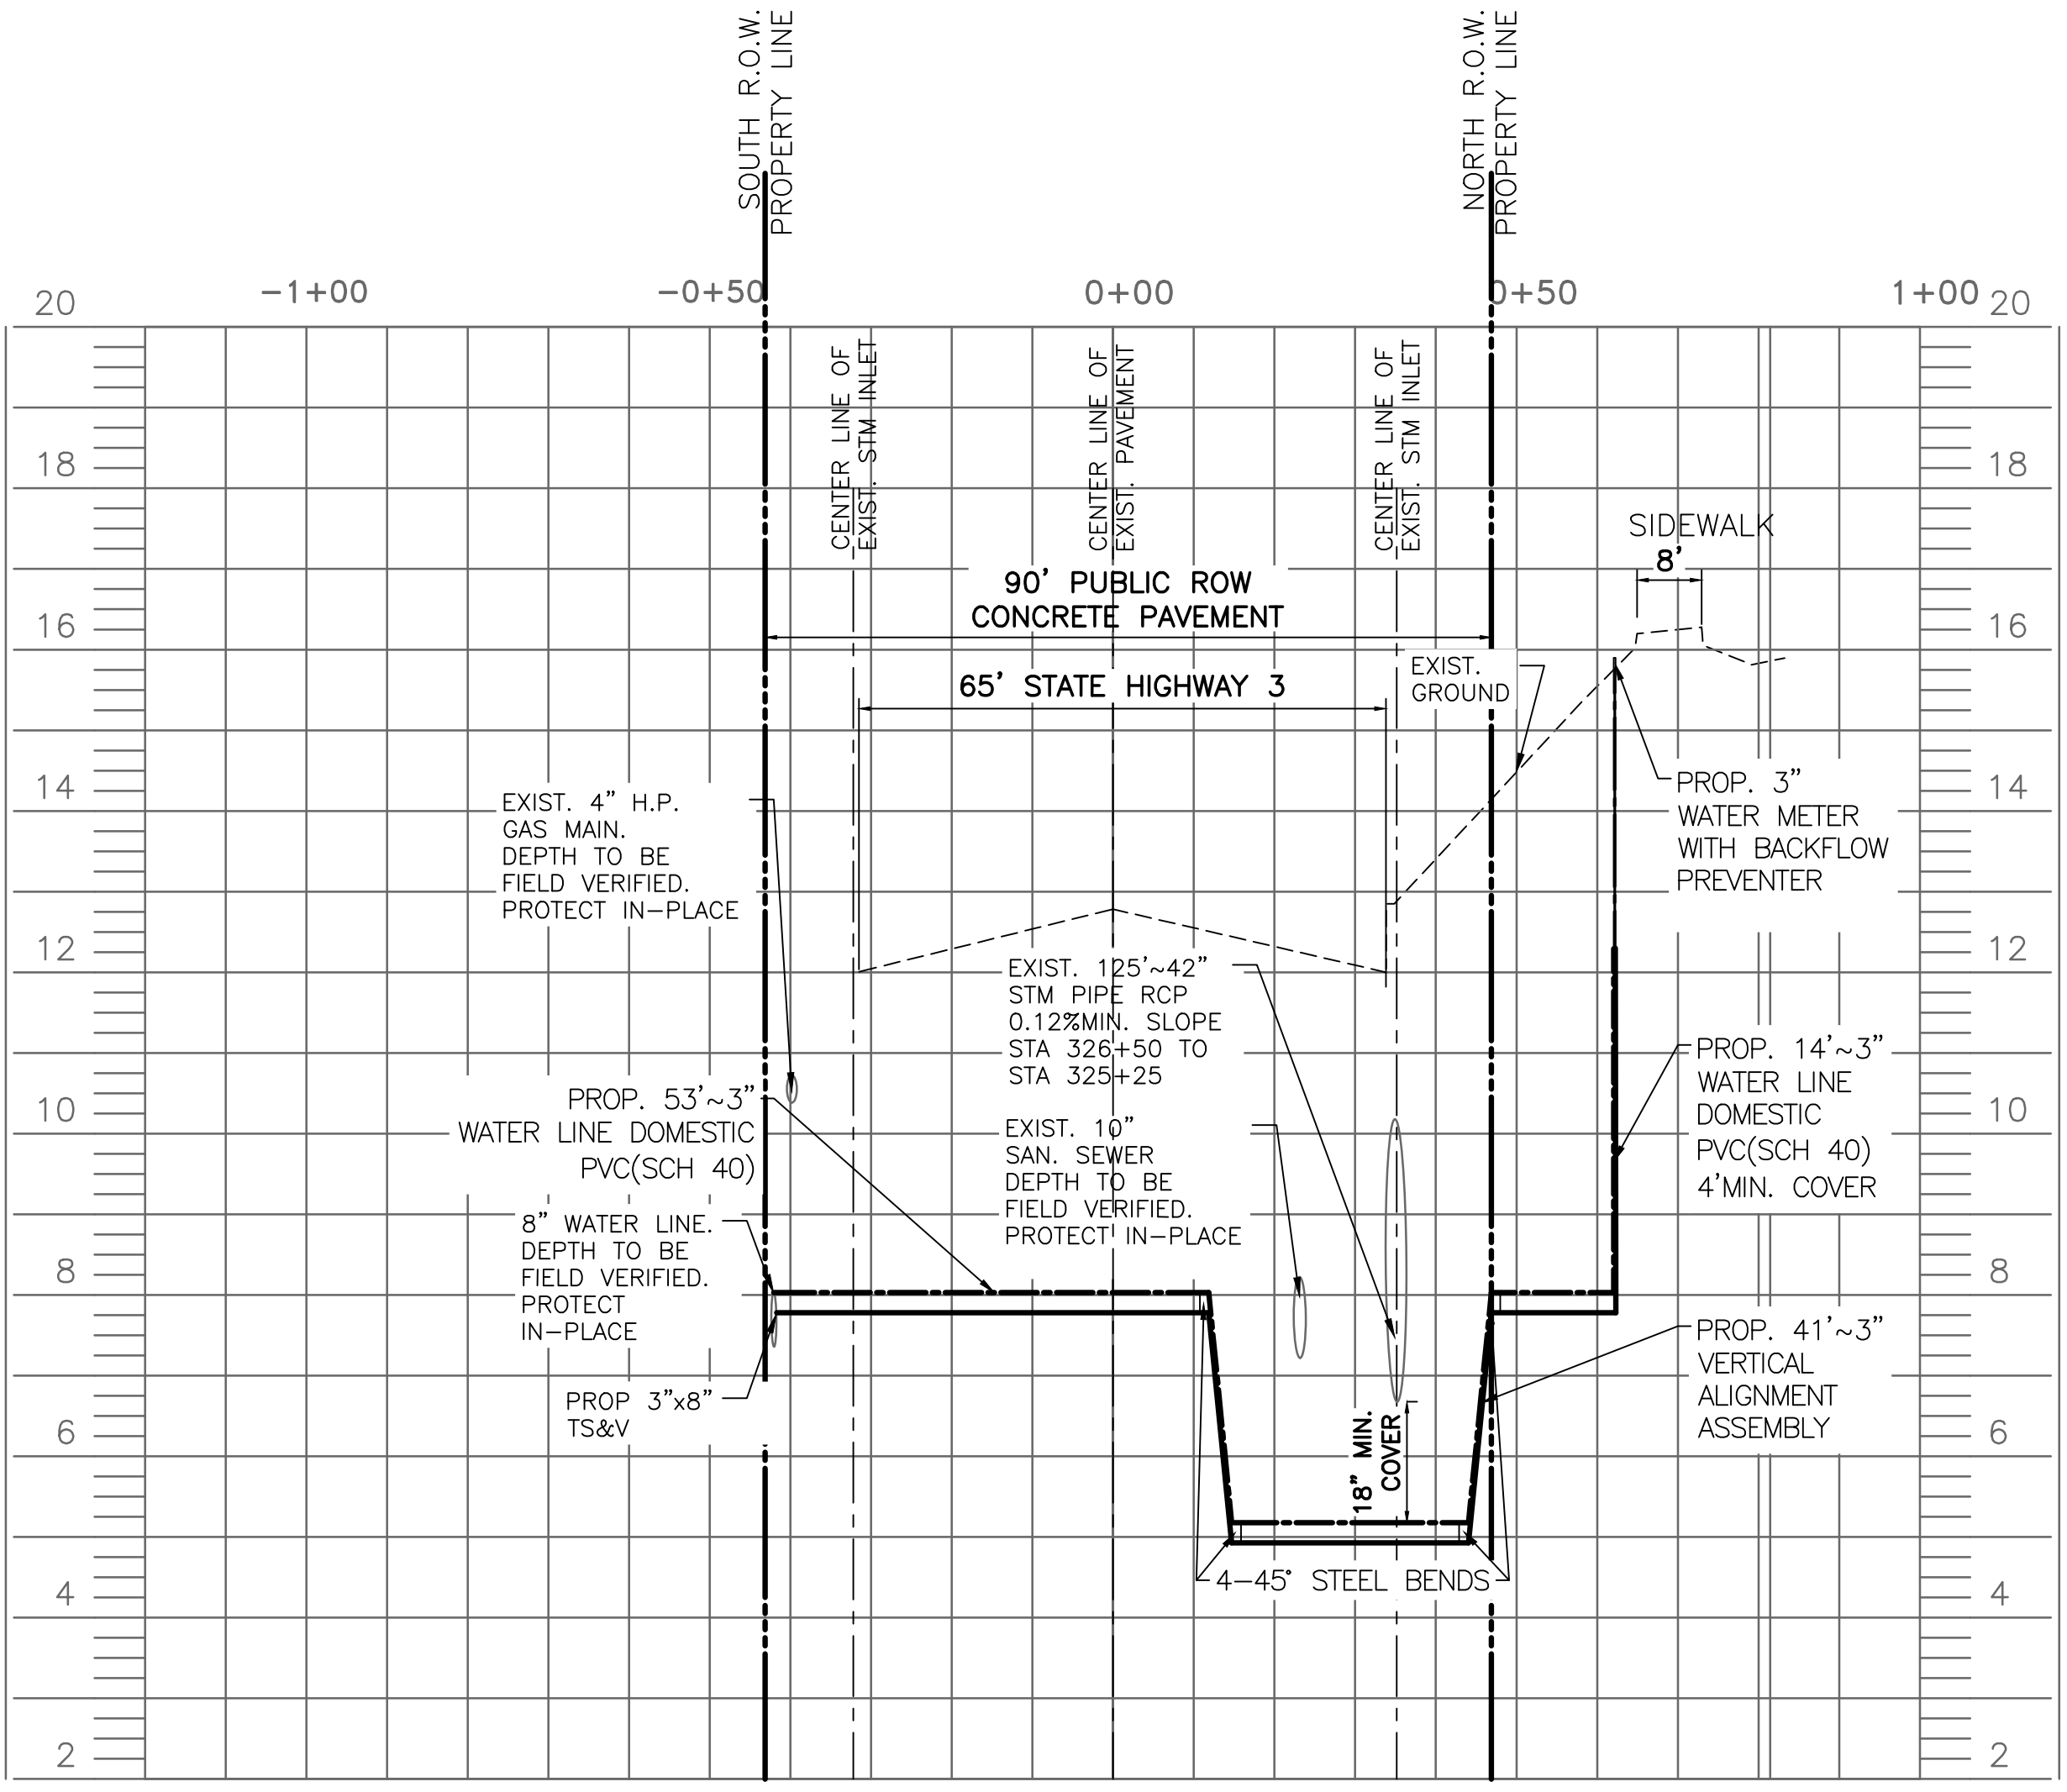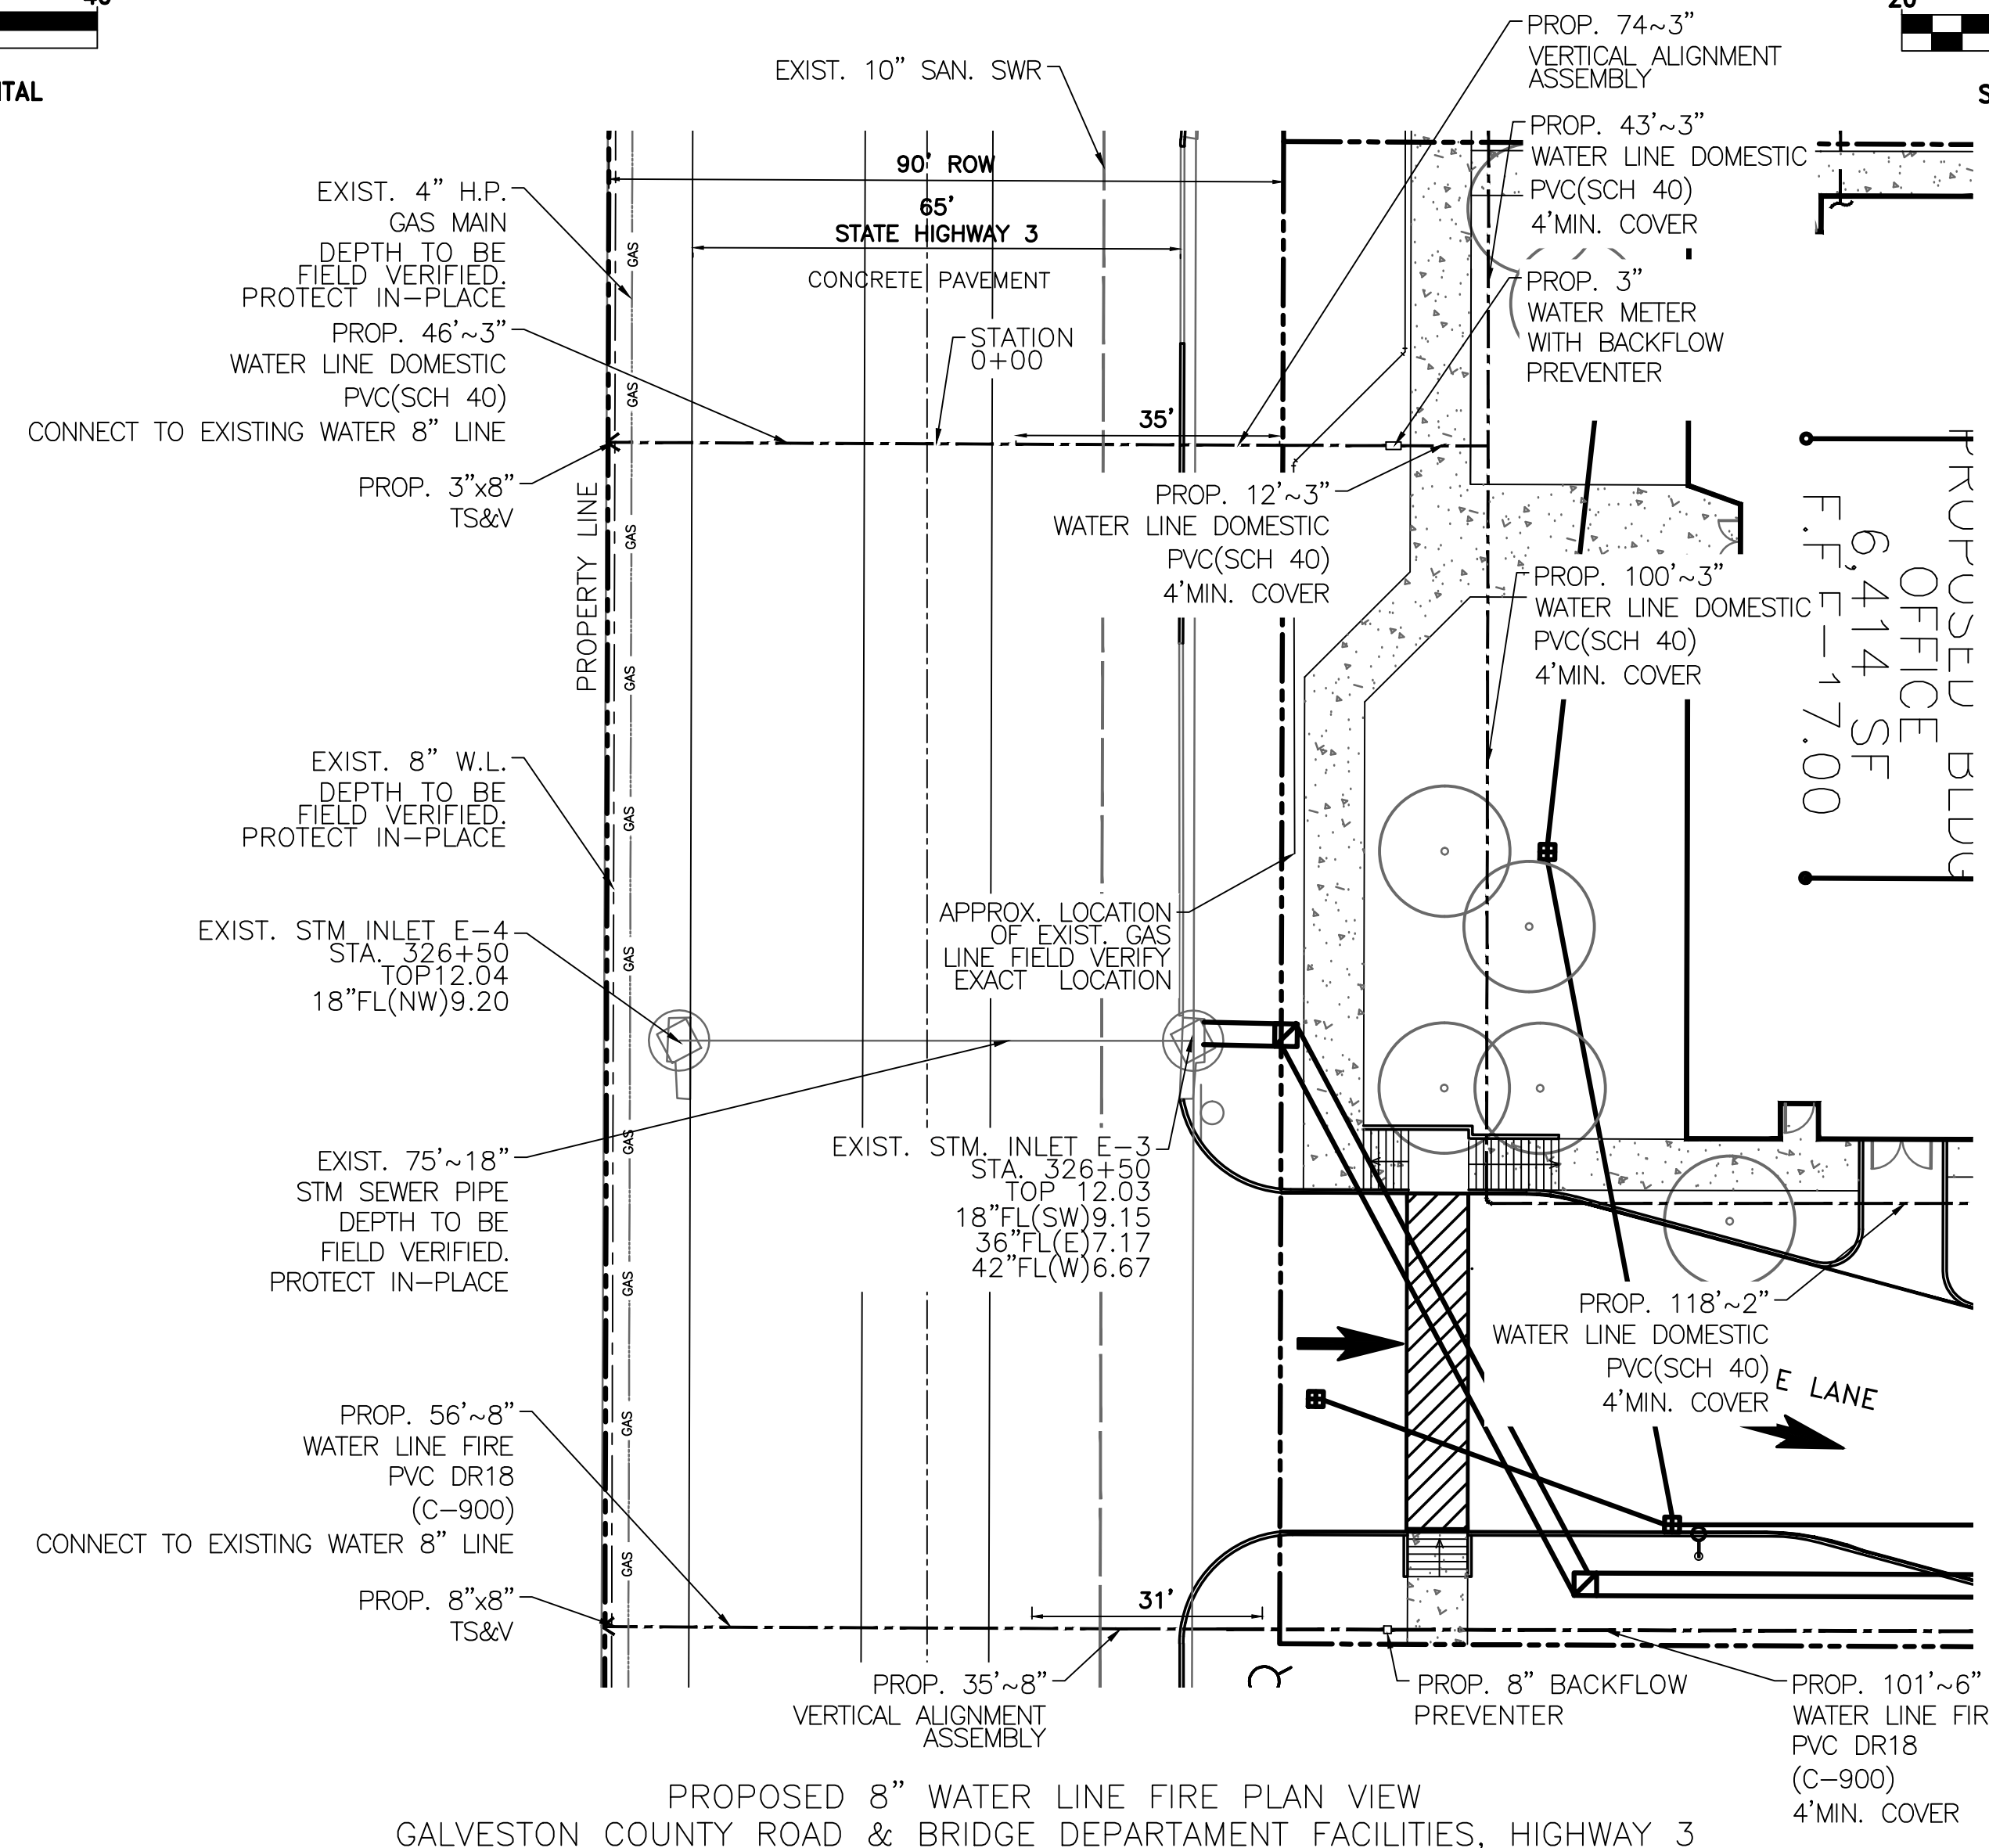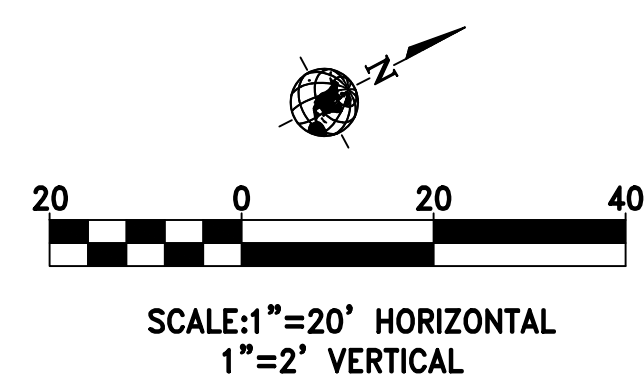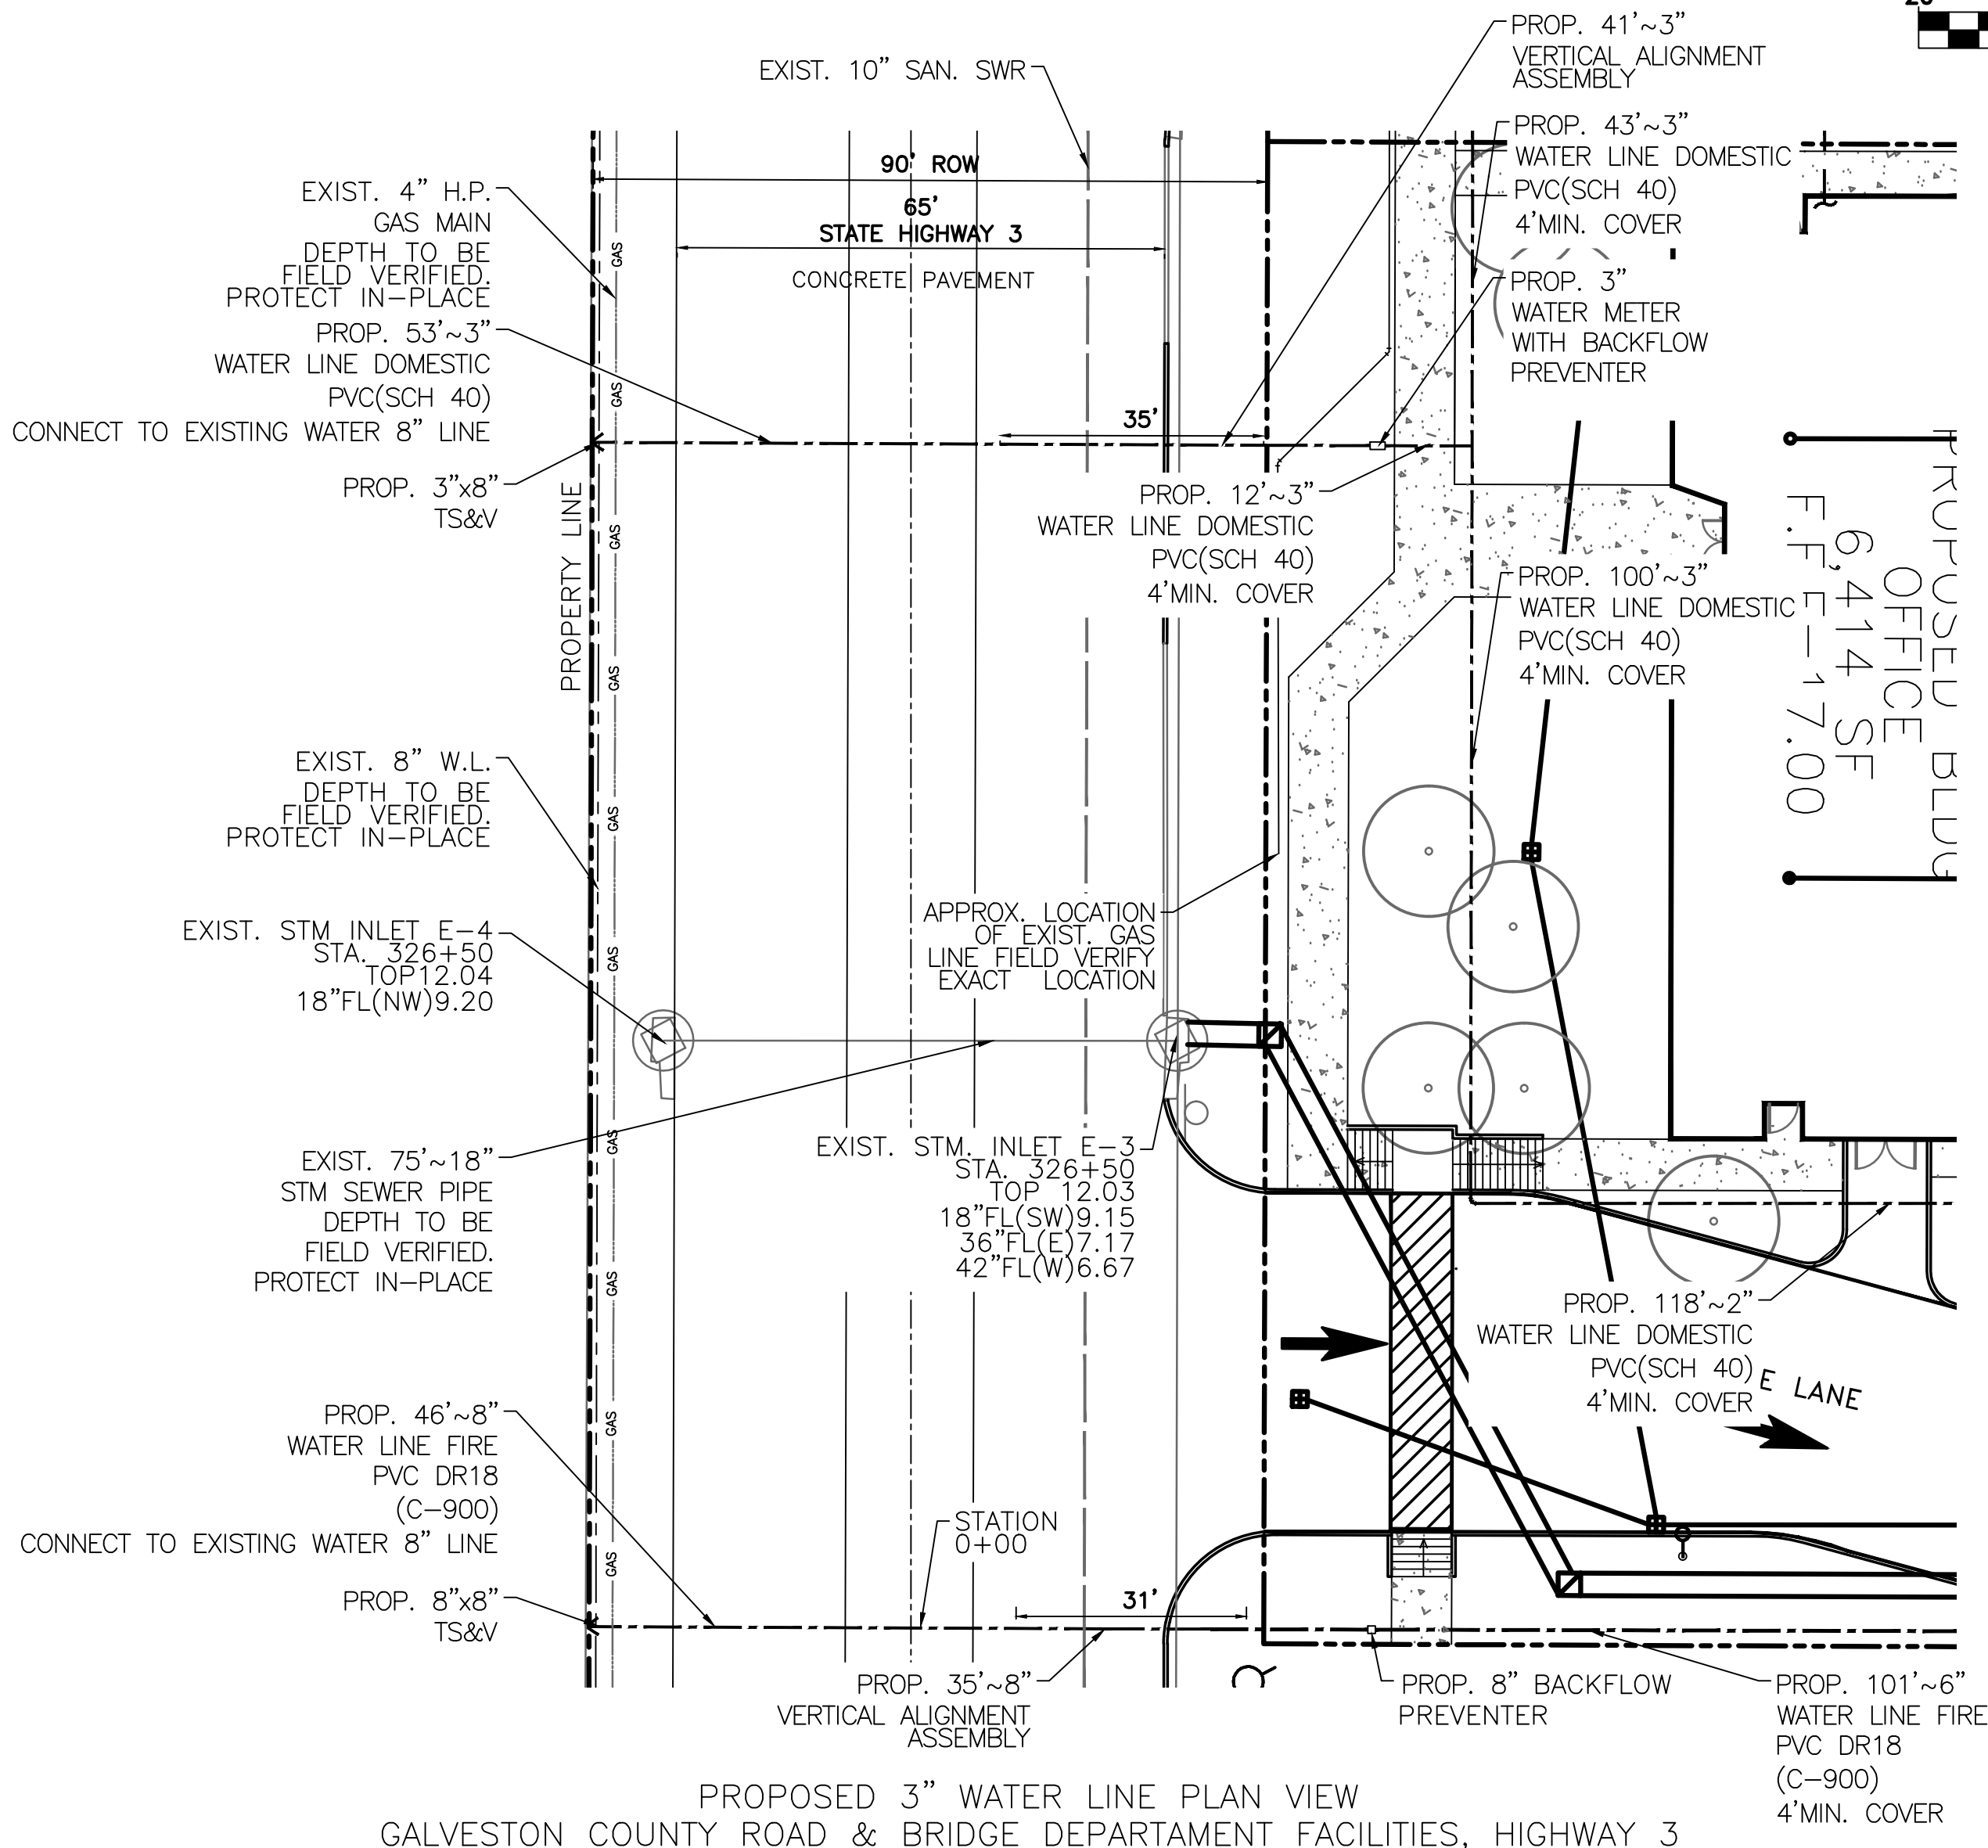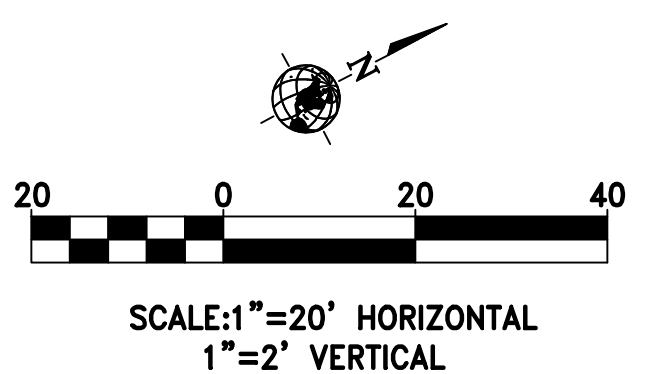

ONE - CALL NOTIFICATION SYSTEM
CALL BEFORE YOU DIG!!!
(713) 223-4567 (in Houston, TX)
(New Statewide Number Outside Houston)
1-800-545-6005

KEY PLAN (NOT TO SCALE)

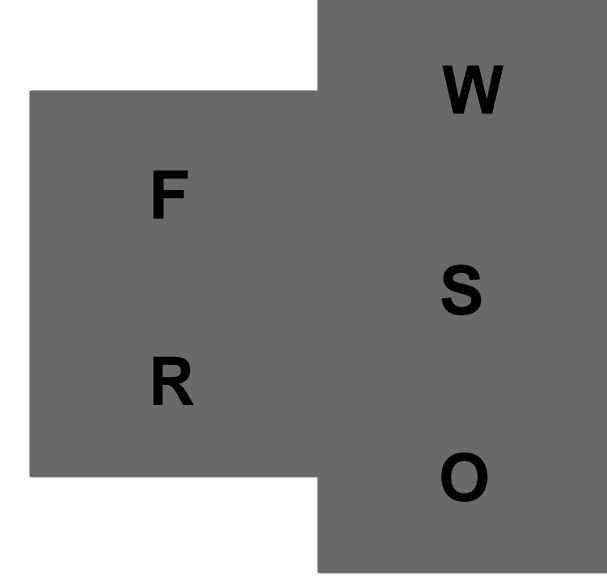


GALVESTON COUNTY ROAD & BRIDGE DEPARTMENT FACILITIES - PHASE 2


5115 TEXAS HIGHWAY 3 DICKINSON, TX

ISSUE FOR PERMIT

△ 3 ADDENDUM NO.3 10-07-2020

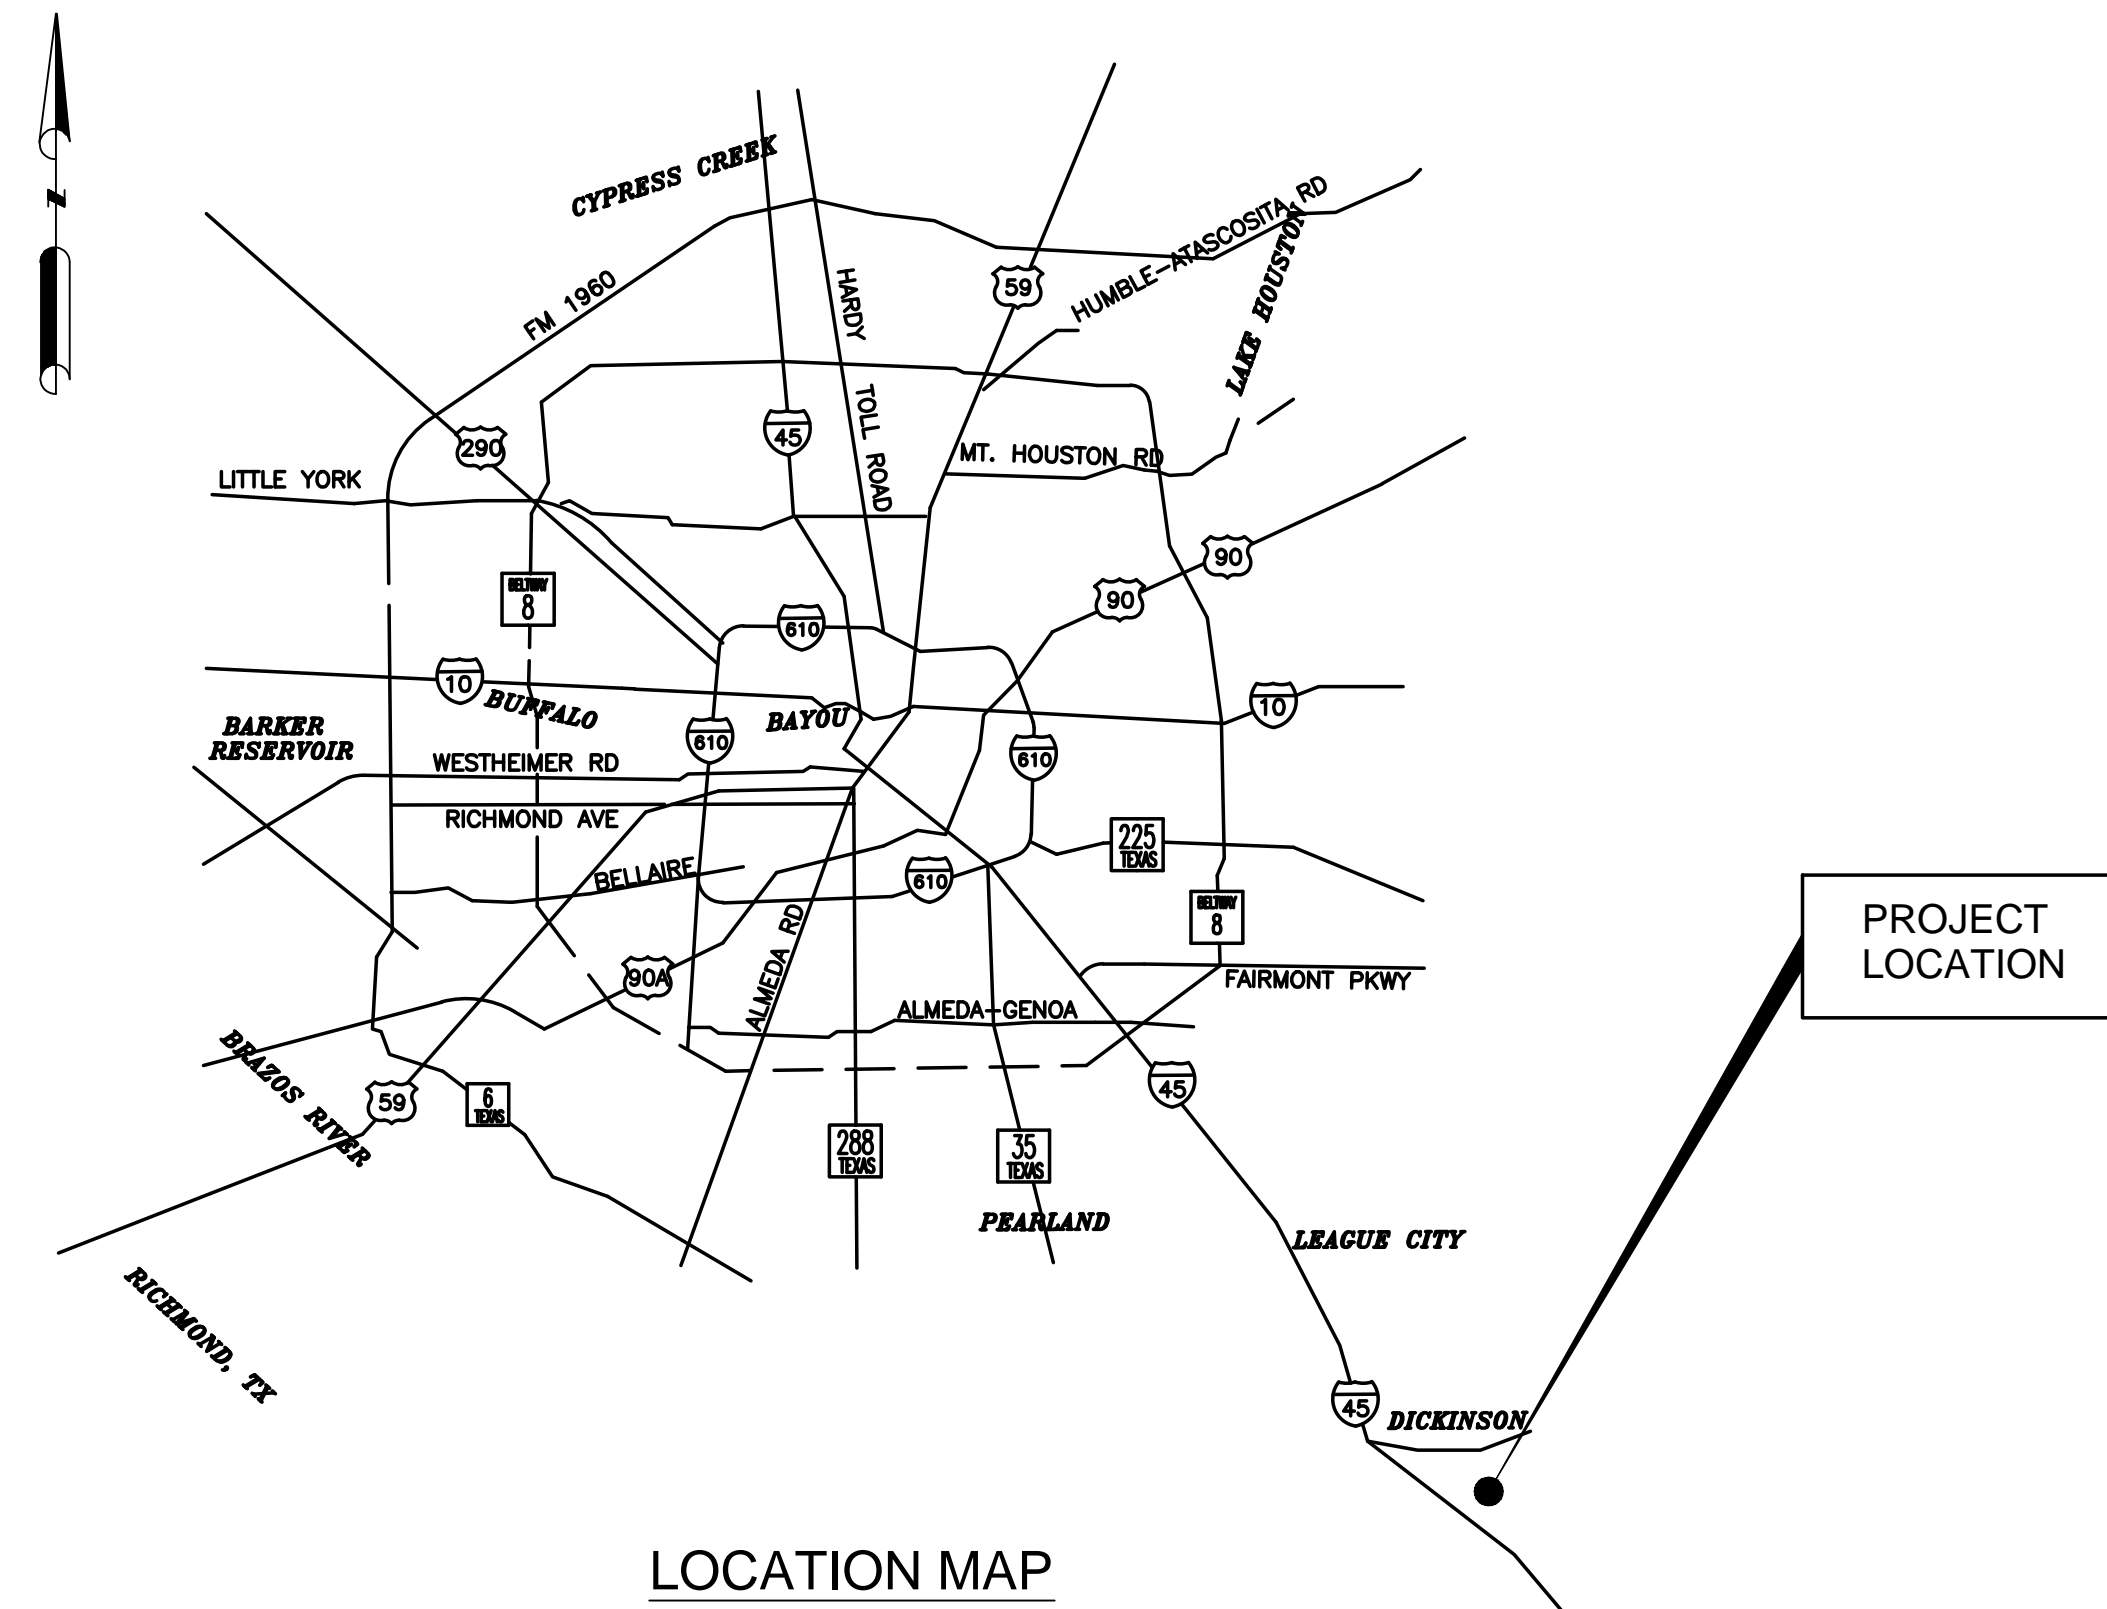

LOCATION MAP

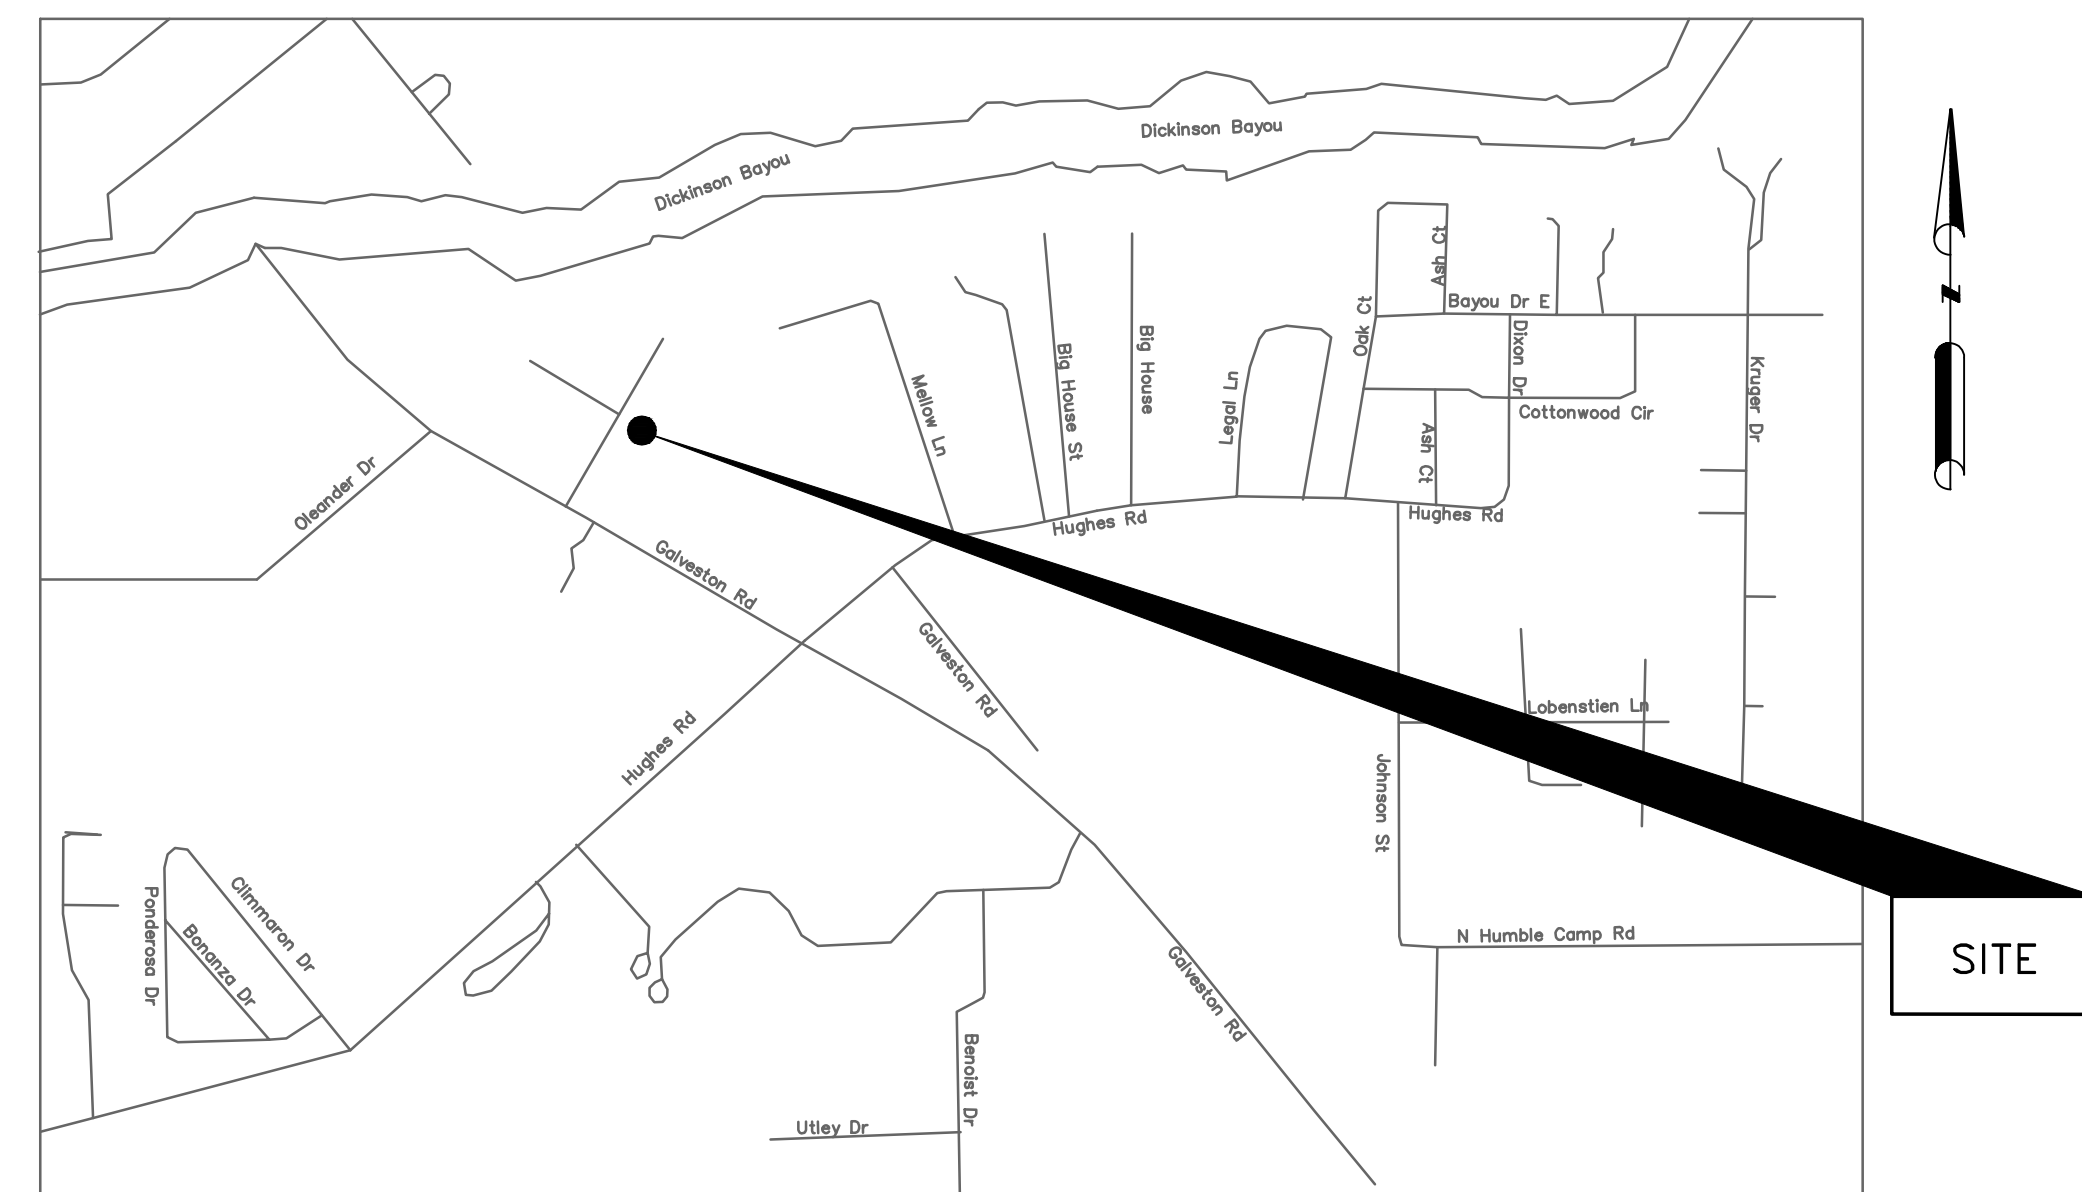

VICINITY MAP
N.T.S.
KEY MAP: 190-A

CIVIL ENGINEER:

DALLY+ASSOCIATES, INC.

TBPE FIRM REGISTRATION #3426

9800 RICHMOND AVENUE, SUITE 460
HOUSTON, TX 77042
(713) 337 8881
www.dallyassociates.com

Project Manager: Jose Diego Monroy, CFM
Project Engineer: Fred Dally, P.E.

OCTOBER 07, 2020

CIVIL SHEET INDEX

SHEET #	SHEET NAME
△ 3 C1.0-PH2	COVER SHEET
C2.0-PH2	TOPOGRAPHIC SURVEY
C3.0-PH2	DEMOLITION PLAN
C4.0-PH2	PAVING PLAN △
C5.0-PH2	LAYOUT PLAN
C6.0-PH2	GRADING PLAN
C7.0-PH2	UTILITY PLAN
C7.1-PH2	UTILITY PLAN
C8.0-PH2	GENERAL NOTES
C9.0-PH2	PAVEMENT DETAILS
C10.0-PH2	(STORM DRAIN DETAILS) △
C11.0-PH2	WATER DETAILS
C12.0-PH2	SANITARY SEWER DETAILS
C13.0-PH2	STORM WATER POLLUTION PREVENTION PLAN △
C14.0-PH2	SWPPP DETAILS

ONE-CALL NOTIFICATION SYSTEM
 CALL BEFORE YOU DIG!!!
(713) 223-4567 (In Houston, Tx)
 (New Statewide Number Outside Houston)
 1-800-545-6005

GALVESTON COUNTY
 ROAD & BRIDGE
 DEPARTMENT FACILITIES PH2
 5115 TX-3
 DICKINSON, TX 77539


COVER SHEET

TBPE FIRM REGISTRATION #3426
 DRAWING SCALE
 DESIGNED BY: JDM
 CHECKED BY: JDM
 DATE: 10/07/2020
△ 3 C1.0-PH2

NO. | DATE | REVISIONS | FD | APP.
 3 | 10/07/20 | | | |

GENERAL NOTES:

1. According to the Federal Emergency Management Agency (FEMA) Flood Insurance Rate Map (FIRM) for Galveston County, Texas, Map No. 485470095 C dated May 2, 1983 This properties lies within "Zone C" of the flood insurance rate map and does not lie within a special flood hazard area.
This flood statement does not imply that the property or structures thereon will be free from flooding or flood damage. On rare occasions floods can and will occur in areas not shown on flood insurance maps. The actual location of the flood zone as determined by scaling from said FEMA map, the actual location, as determined by elevation contours, may differ. Intertek Surveying & Services assumes no liability as to the accuracy of the location of the flood zone as shown on this map. This flood statement shall not create liability on the part of KM Surveying, LLC.
2. This survey has been prepared for the sole purpose of the transaction described in the above mentioned Commitment for title insurance and the parties listed therein. This survey is not to be used for any subsequent transactions.
3. This survey does not determine the location of wetlands, fault lines, toxic waste, cemeteries, landfills, dumps or any other environmental issues.
4. Intertek Surveying & Services has not been provided with construction plans showing the location of underground utilities. Underground utilities may exist which are not shown hereon.
5. Readily visible improvements/utilities were located with this survey, no subsurface probing, excavation or exploration was performed Intertek Surveying & Services.
6. This exhibit has been prepared without benefit of current title report. There may be easements, setbacks, and other matters of record not shown hereon, the surveyor has not abstract the property.
7. Reference is made to a Survey of a 3.193-acre (139,093 sq. ft.) Tract situated in Galveston County, Texas, dated 12/12/2018. Prepared by Weisser Engineering Co. Job. No. GD404 and in the field book 3510.

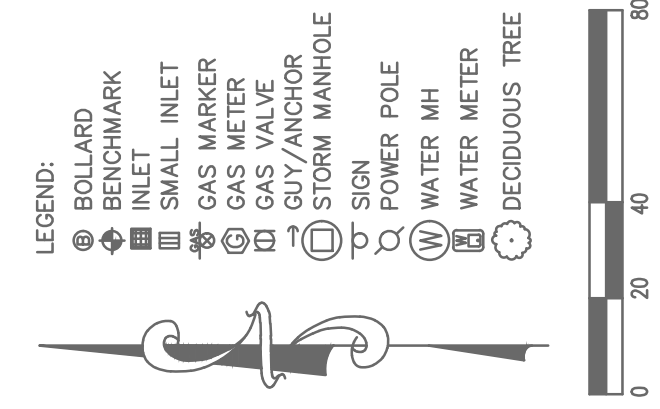


- LEGEND:**
- ⊙ BOLLARD
 - ⊕ BENCHMARK
 - ⊖ INLET
 - ⊕ INLET
 - ⊕ GAS METER
 - ⊕ GAS VALVE
 - ⊕ GUY/ANCHOR
 - ⊕ STORM MANHOLE
 - ⊕ SIGN
 - ⊕ POWER POLE
 - ⊕ WATER MH
 - ⊕ WATER METER
 - ⊕ DECIDUOUS TREE

PROJECT SITE


Utility Map
N.T.S.

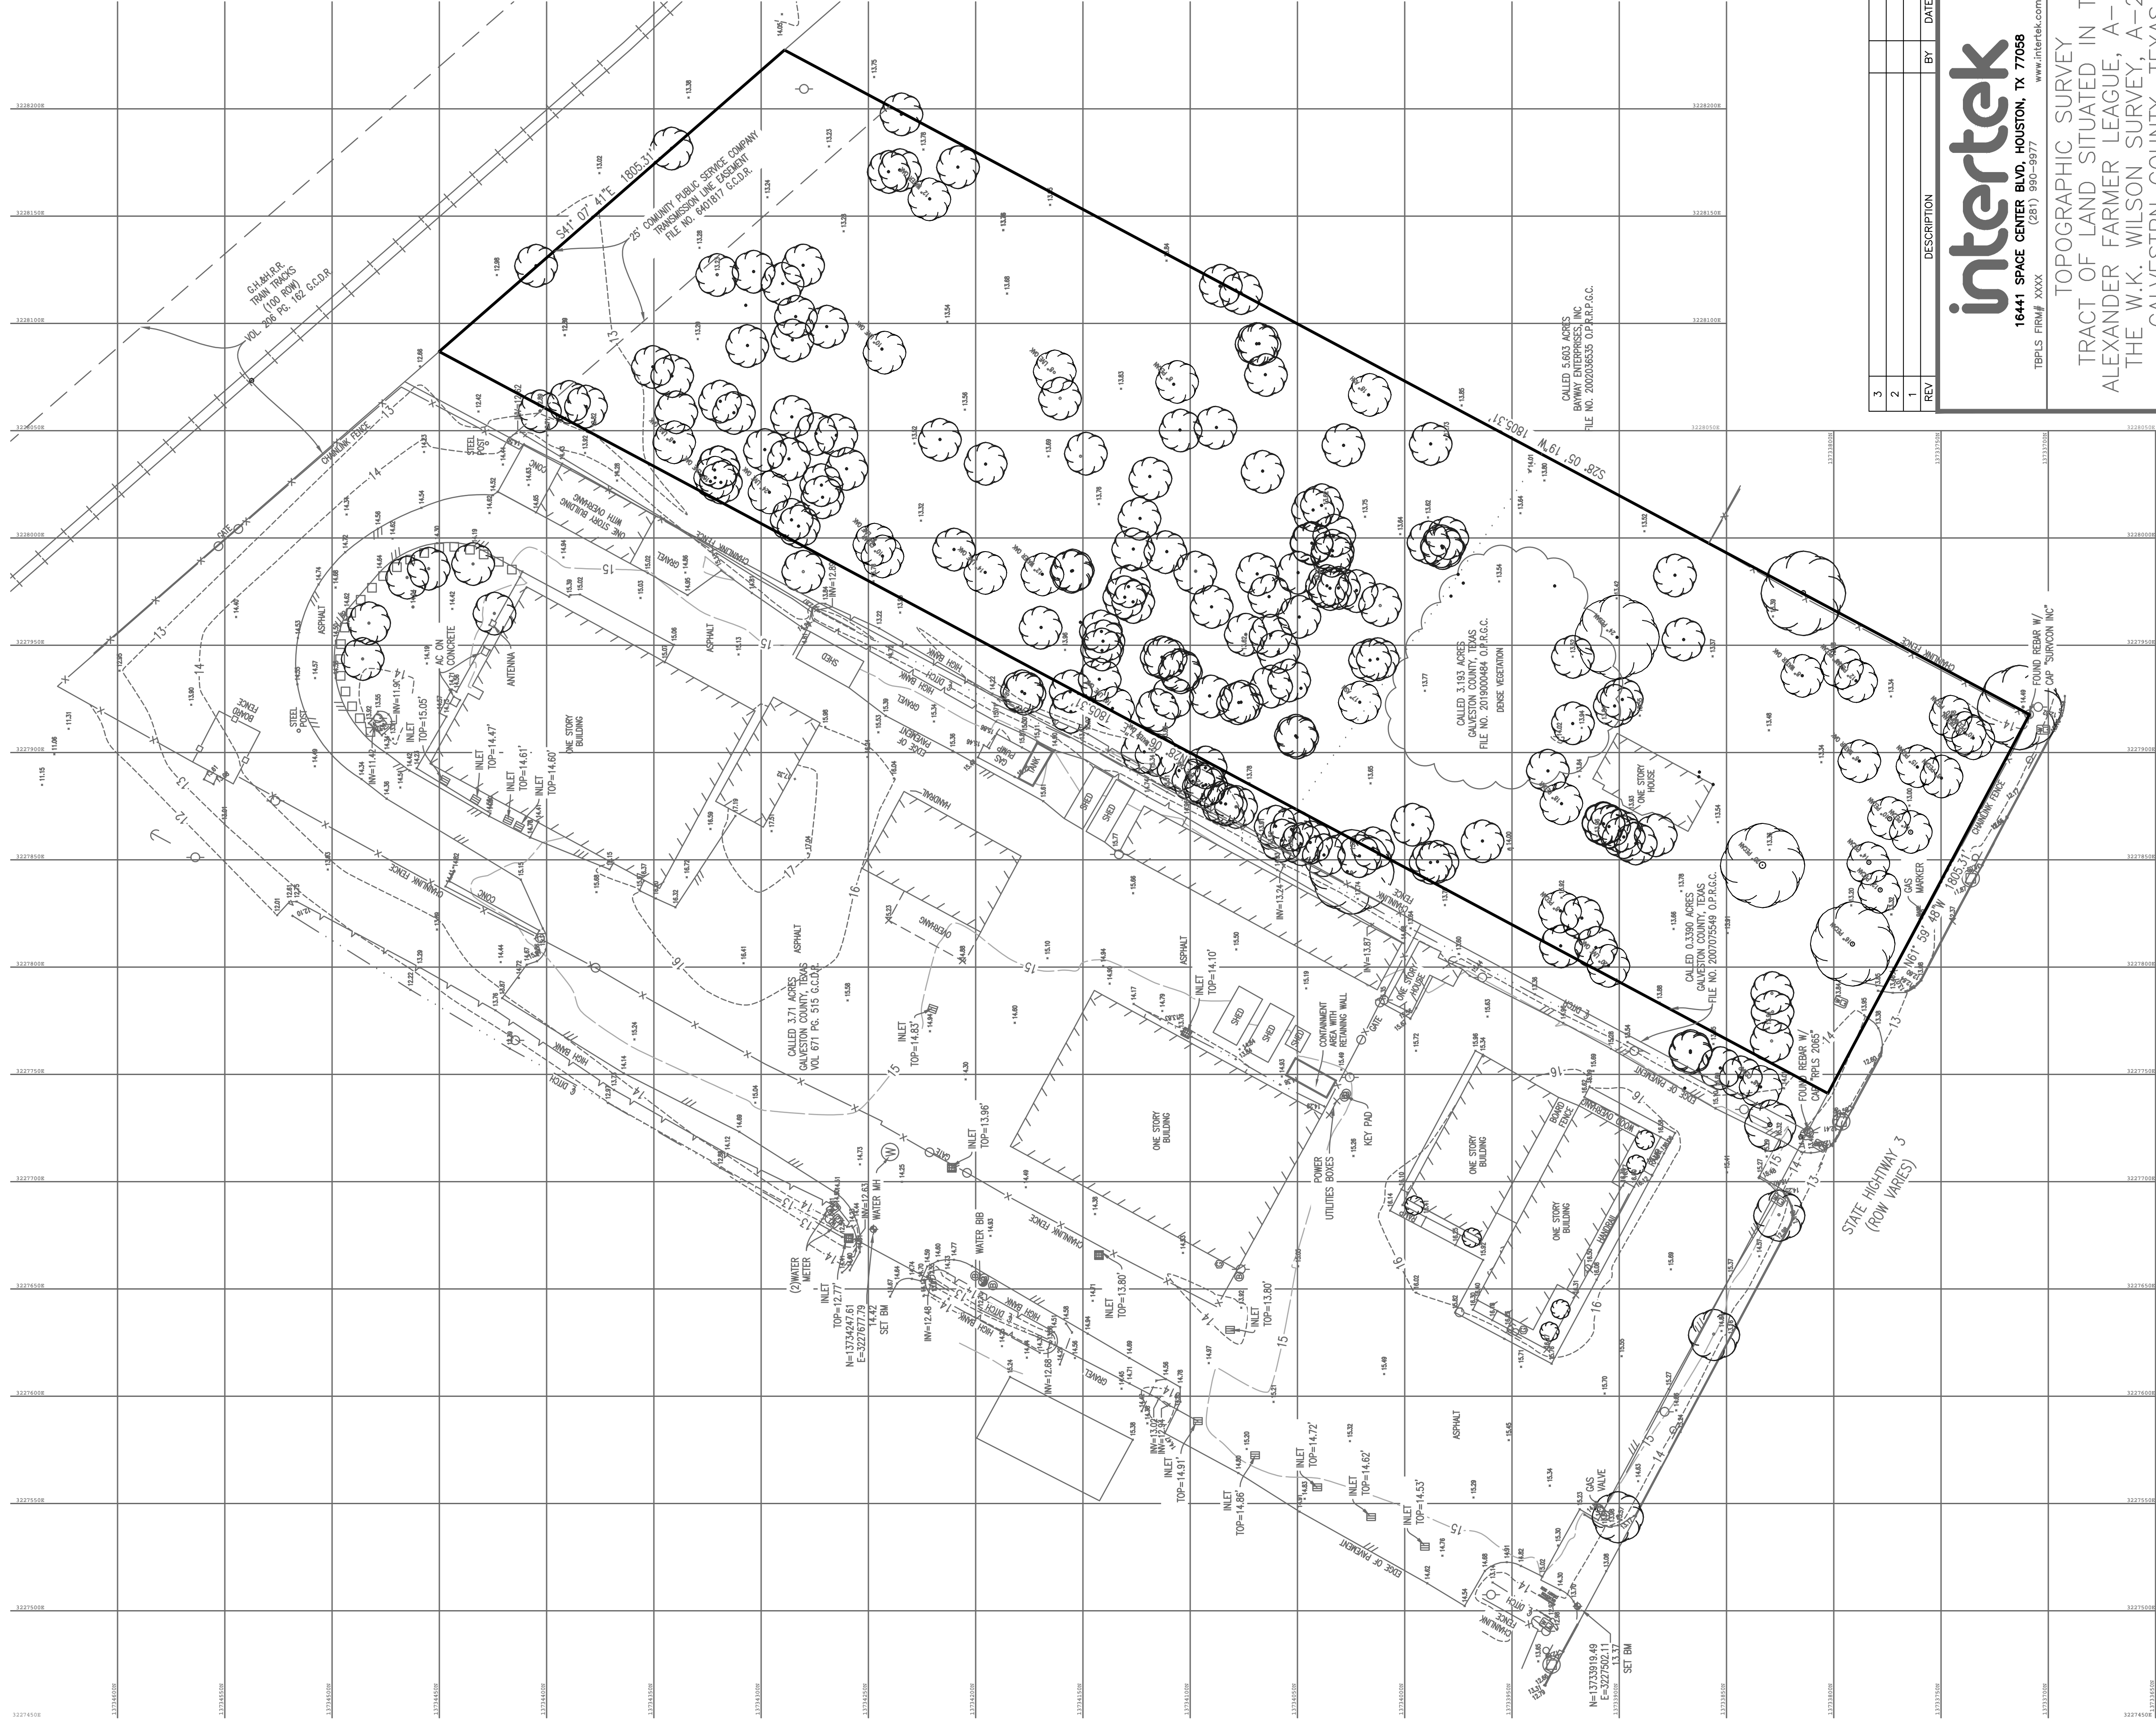

REV	DESCRIPTION	BY	DATE
3			
2			
1			

intertek
16441 SPACE CENTER BLVD., HOUSTON, TX 77068
TBP/LS FIRM# XXXX www.intertek.com

TOPOGRAPHIC SURVEY
TRACT OF LAND SITUATED IN THE
ALEXANDER FARMER LEAGUE, A-11 &
THE W.K. WILSON SURVEY, A-205
GALVESTON COUNTY, TEXAS


SURVEYED: MR 19113
DRAWN: MR 19113
DATE: November 8, 2019
DWG: psi - Iss - 19113 topo 071720 BAREGRED 19113 SHEET NO.: 1 OF 1

C2.0-PH2

**Galveston County
Road & Bridge Department Facilities PH2**
5115 Texas Highway 3
Dickinson, TX

REVISION HISTORY
ADDENDUM NO. 3 10-07-2020



REVISION DESCRIPTION DATE
PROFESSIONAL SEALS

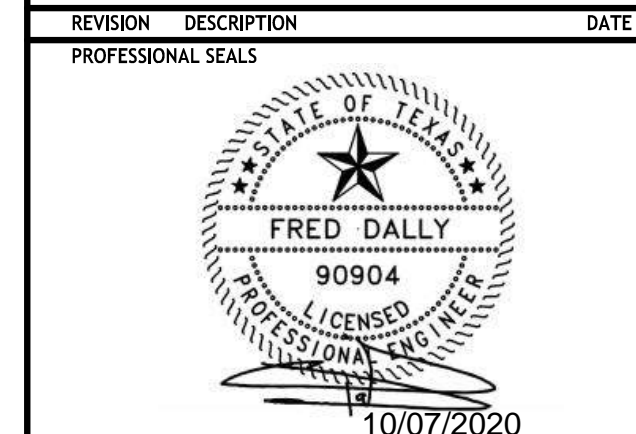

DEMOLITION PLAN

DRAWN BY JDM CHECKED BY JDM
PROJECT NUMBER 418198 PROJECT ABBREVIATION GC-R&B
ORIGINAL ISSUE DATE DATE 07 OCT 2020
ISSUE FOR PERMIT

C3.0-PH2
SHEET NUMBER

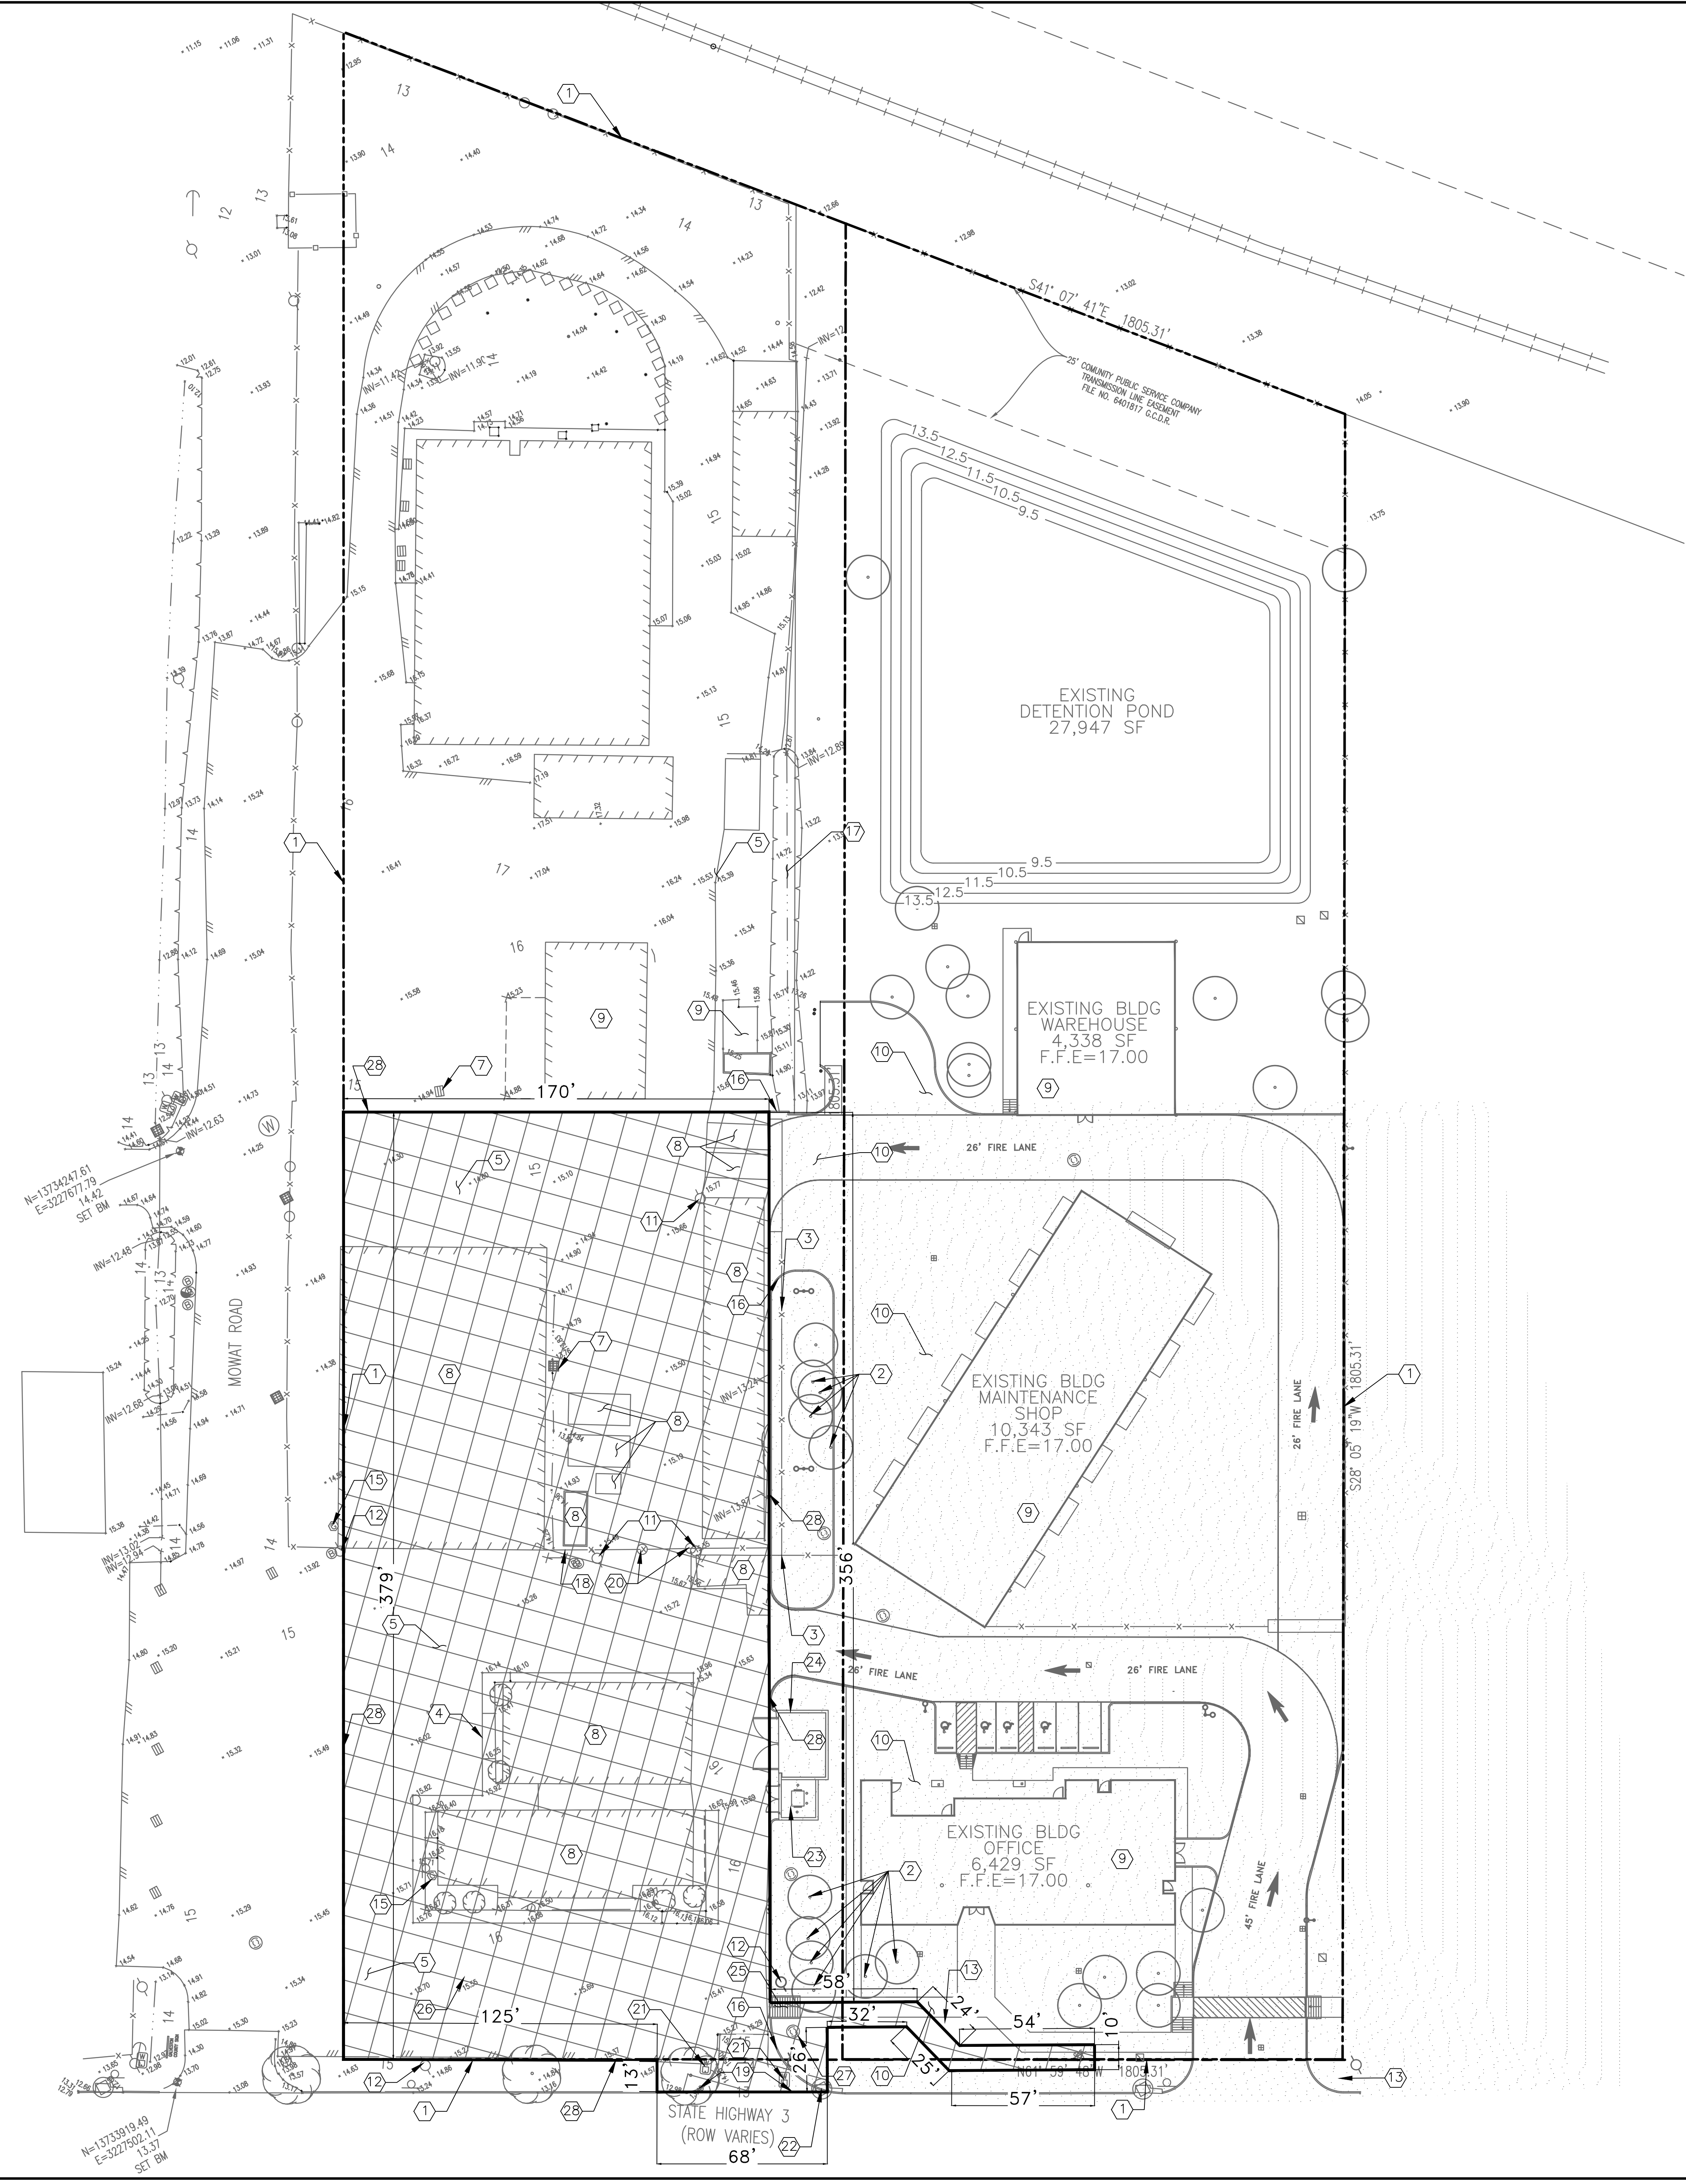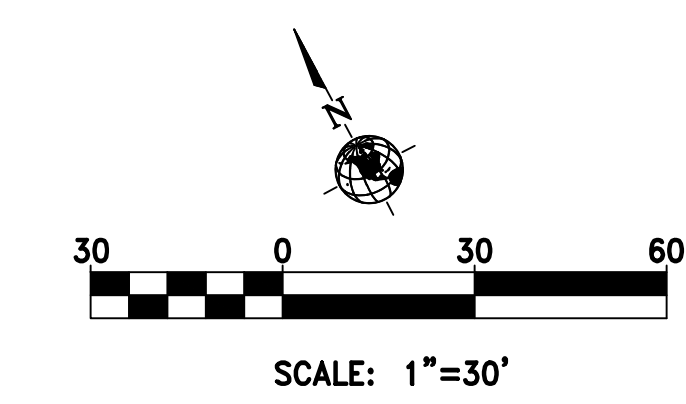

DEMOLITION NOTES TO CONTRACTOR

- 1. ALL ITEMS DESIGNATED TO BE REMOVE SHALL BECOME THE PROPERTY OF THE CONTRACTOR.
- 2. THE CONTRACTOR AND OWNER SHALL COORDINATE WITH CENTERPOINT FOR TERMINATION OF POWER AND GAS SERVICES TO THE SITE OR NEW SERVICES. THIS WORK WILL BE PROVIDED BY CENTERPOINT AND SHALL BE SCHEDULE AS ONE OF THE FIRST ITEMS OF BUSINESS.
- 3. THE CONTRACTOR SHALL BE PROVIDE AN APPROVED TRAFFIC CONTROL PLAN TO PERFORM ANY WORK PROPER SIGNAGE.
- 4. WHEN EXISTING SIDEWALK IS CLOSED FOR CONSTRUCTION, CONTRACTOR SHALL BARRICADE THAT AREA AND PROVIDE SAFE ALTERNATE PATH FOR PEDESTRIAN WITH PROPER SIGNAGE.
- 5. ALL TRAFFIC SIGNAGE WITHIN THE ROW SHALL BE PROTECTED INPLACE AT ALL TIMES. ANY DAMAGE TO THEN SHALL BE REPAIRED IMMEDIATELY. DURING THE CONSTRUCTION, SAFE OPERATION OF PEDESTRIAN OR VEHICULAR TRAFFIC, CONTRACTOR SHALL PROVIDE A CERTIFIED FLAGGER OR PEACE OFFICER UNTIL THAT SIGN IS RESTORED TO EXISTING CONDITION.
- 6. CONTRACTOR SHALL REPAIR ANY ITEMS DAMAGE DURING CONSTRUCTION TO ITS EXISTING CONDITION.
- 7. PRIOR TO ANY DEMOLITION WORK, THE CONTRACTOR SHALL LOCATED AS WELL CAPPED. ALL UTILITIES THAT ARE SHOWN SHALL BE LOCATED AS WELL AND CAPPED. ALL UTILITIES NOT SHOW SHALL BE LOCATED AS WELL CAPPED. UTILITIES THAT ARE SHOWN ON PLANS ARE APPROXIMATE LOCATION ONLY.
- 8. THE CONTRACTOR SHALL BE RESPONSIBLE FOR PROVIDING POSITIVE DRAINAGE ON SITE DURING ALL CONSTRUCTION ACTIVITIES.
- 9. THE CONTRACTOR SHALL ENTER & EXIT THE SITE THROUGH EXISTING DRIVEWAY.
- 10. CAUTION. THERE ARE OVERHEAD POWERLINES WITH IN THE WORK AREA. CONTRACTOR SHALL FOLLOW CITY, STATE AND FEDERAL GUIDELINES WHEN WORKING AROUND EXISTING POWER LINES.
- 11. THE DEMOLITION AND REMAIN OF THE TREES WILL BE UNDER THE INDICATIONS OF THE PLANS OF LANDSCAPE. PLEASE CONFIRM WITH THE CITY.

DEMOLITION KEY NOTES


- 1 PROPERTY LINE.
- 2 EXISTING TREE TO REMAIN. PROTECT IN-PLACE.
- 3 EXISTING CHAINLINK FENCE TO REMAIN. PROTECT IN-PLACE
- 4 EXISTING CONCRETE PAVEMENT TO BE REMOVED.
- 5 EXISTING ASPHALT PAVEMENT TO BE REMOVED.
- 6 EXISTING SANITARY SEWER MANHOLE TO REMAIN. PROTECT IN-PLACE.
- 7 EXISTING STORM DRAIN INLET TO REMAIN. PROTECT IN-PLACE.
- 8 EXISTING BUILDING TO BE REMOVED.
- 9 EXISTING BUILDING TO REMAIN.
- 10 EXISTING CONCRETE PAVEMENT TO REMAIN. PROTECT IN-PLACE.
- 11 EXISTING POWER POLE TO BE REMOVED.
- 12 EXISTING POWER POLE TO REMAIN. PROTECT IN-PLACE.
- 13 EXISTING WATER METER TO REMAIN OR TO BE REMOVED. PROTECT IN-PLACE. IN ACCORDING WITH OWNER/CITY FOR FURTHER INSTRUCTION.
- 14 EXISTING GAS MARKER TO REMAIN. PROTECT IN-PLACE.
- 15 EXISTING GAS METER TO REMAIN. PROTECT IN-PLACE.
- 16 EXISTING CURB TO REMAIN. PROTECT IN-PLACE.
- 17 EXISTING DITCH TO BE REMOVED.
- 18 EXISTING CHAINLINK FENCE TO BE REMOVED.
- 19 EXISTING CURB TO BE REMOVED.
- 20 EXISTING GATE TO B REMOVED
- 21 EXISTING WATER METER TO BE RELOCATED.
- 22 EXISTING INLET BB TO REMAIN. PROTECT IN-PLACE.
- 23 EXISTING DUMPSTER TO REMAIN. PROTECT IN-PLACE.
- 24 EXISTING GENERATOR TO REMAIN. PROTECT IN-PLACE.
- 25 EXISTING ADA RAMP TO REMAIN. PROTECT IN-PLACE.
- 26 EXISTING SANITARY SEWER LINE TO REMAIN. PROTECT IN-PLACE
- 27 EXISTING MANHOLE SANITARY SEWER TO REMAIN. PROTECT IN-PLACE.
- 28 LIMITS OF DEMOLITION.



DEMOLITION HATCH LEGEND



ONE- CALL NOTIFICATION SYSTM
CALL BEFORE YOU DIG!!!
(713) 223-4567 (In Houston, Tx)
(New Statewide Number Outside Houston)
1-800-545-6005

KEY PLAN (NOT TO SCALE)

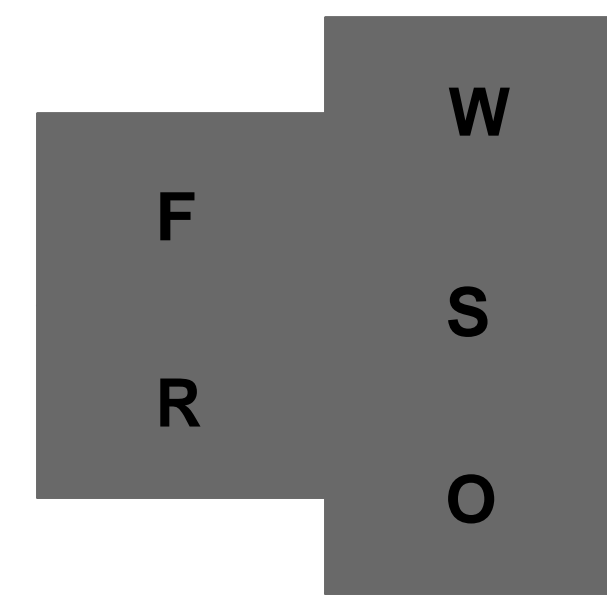

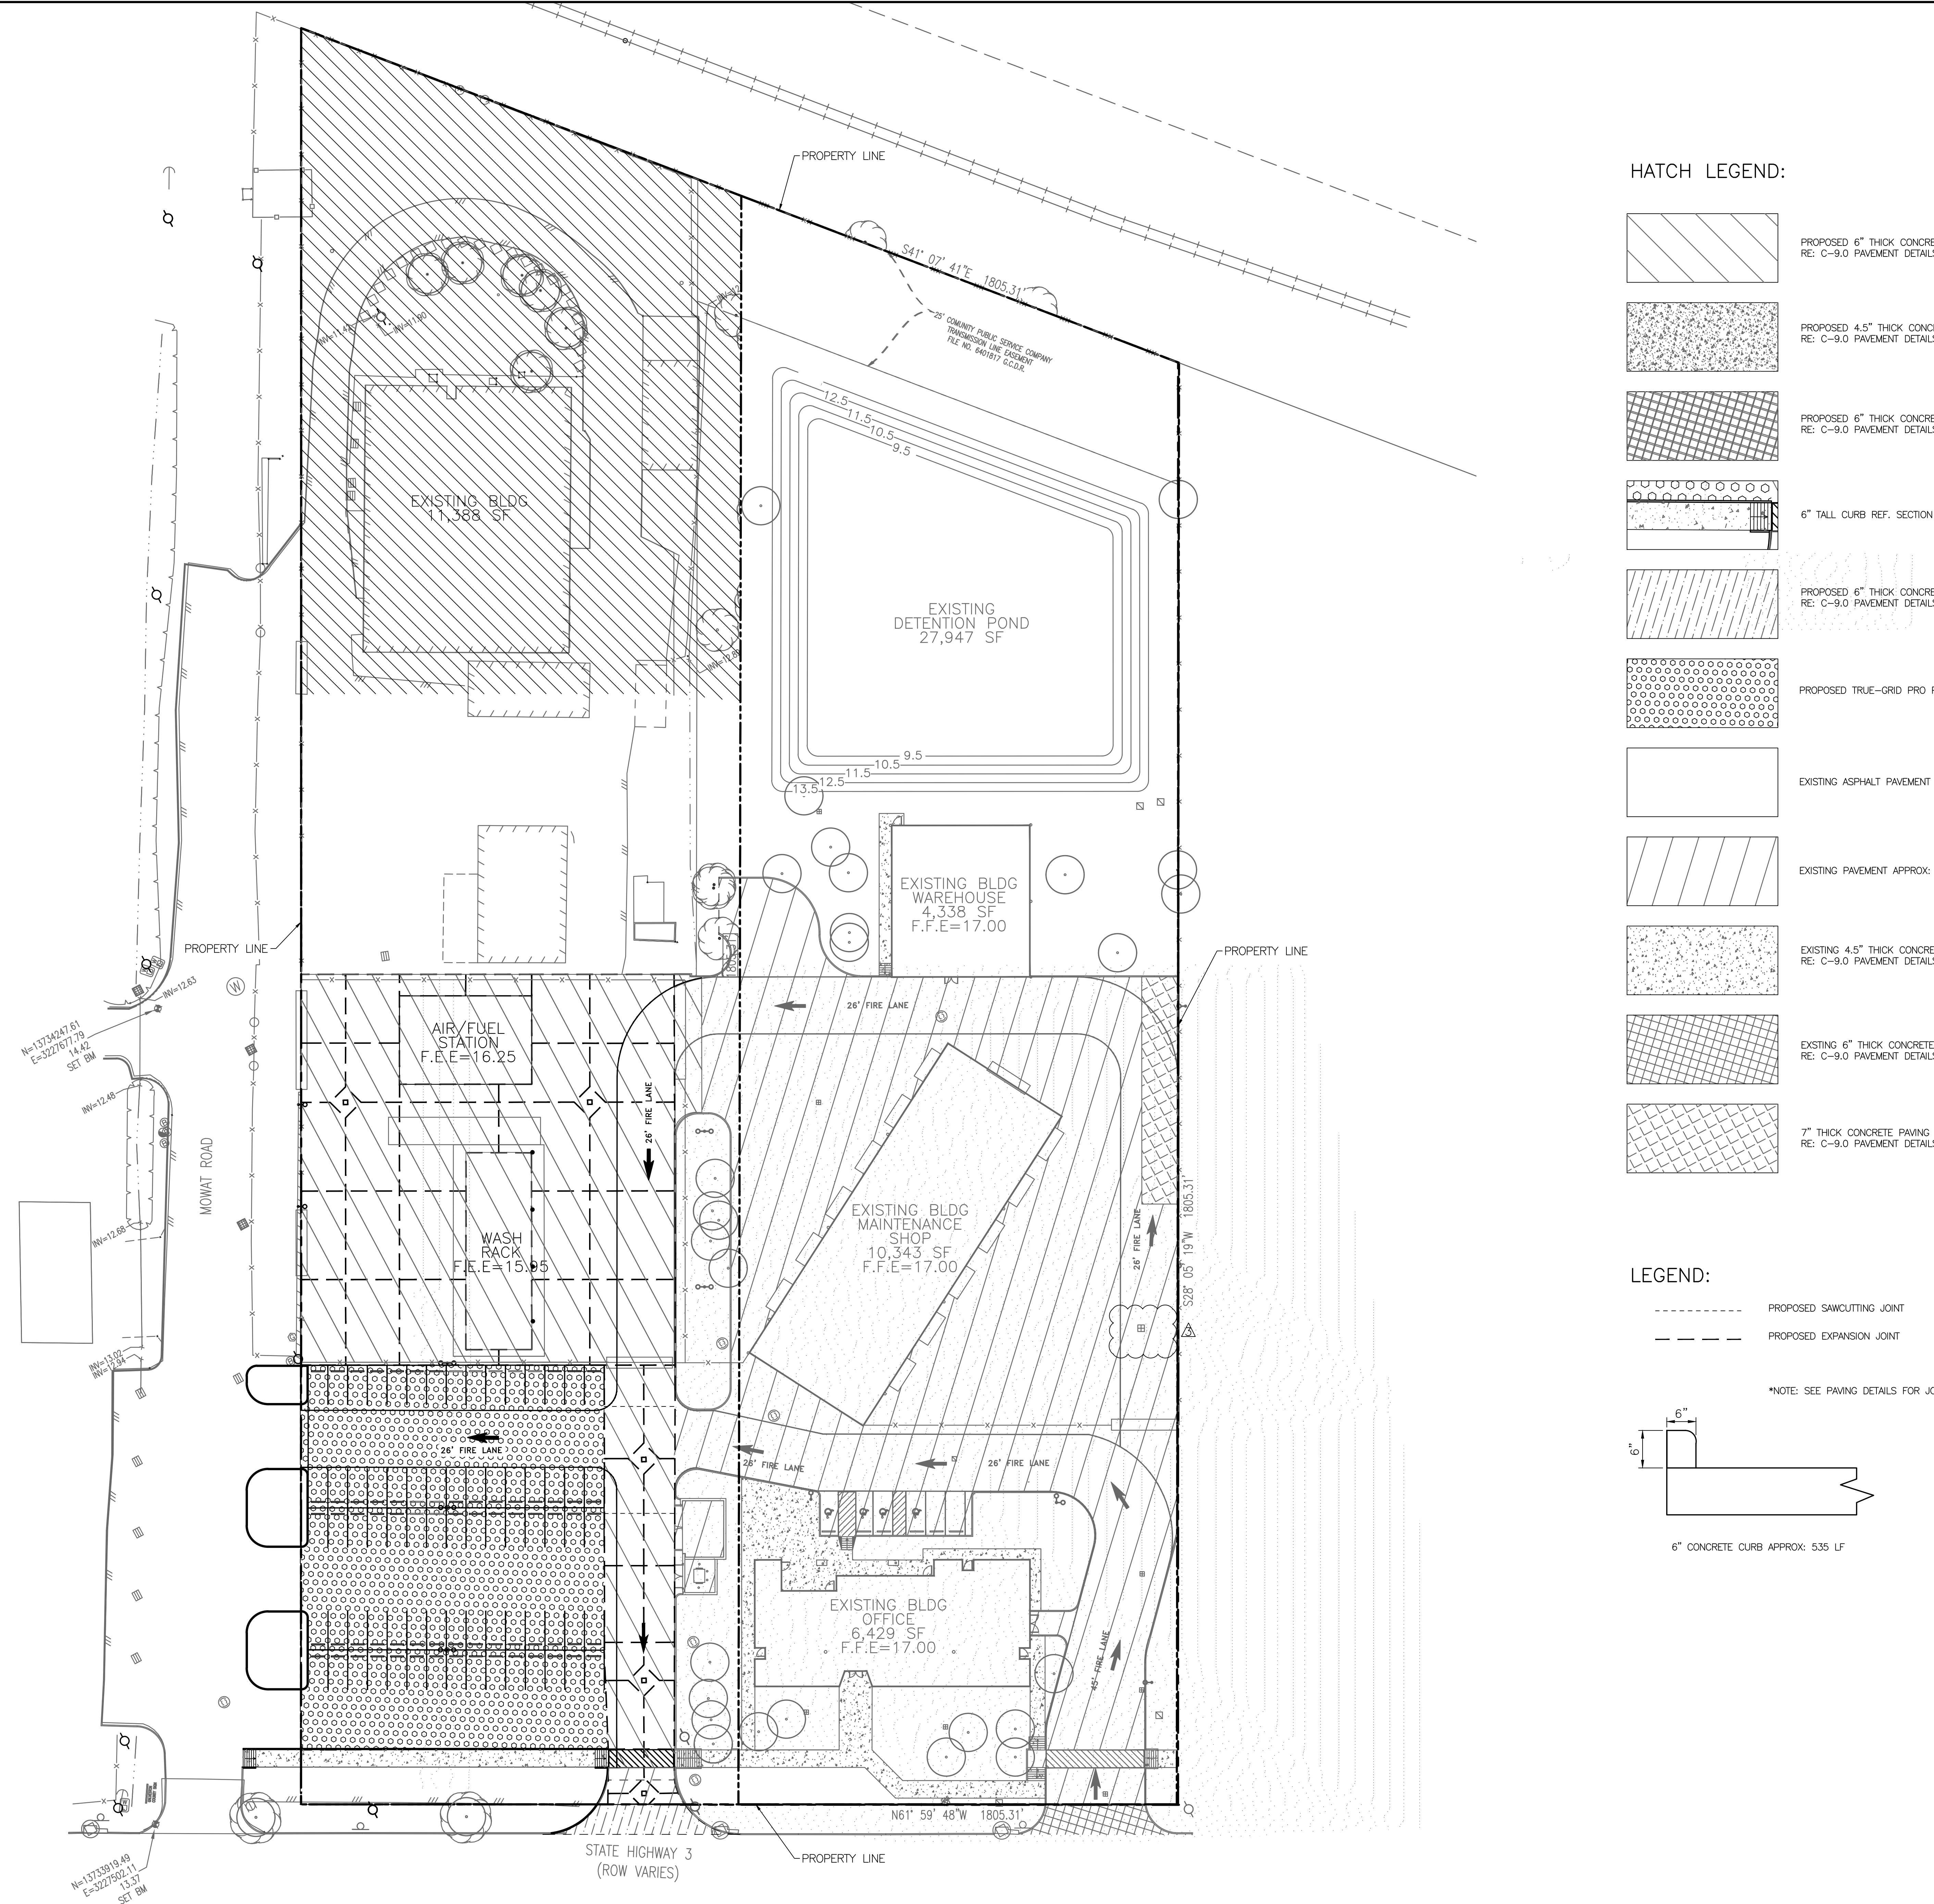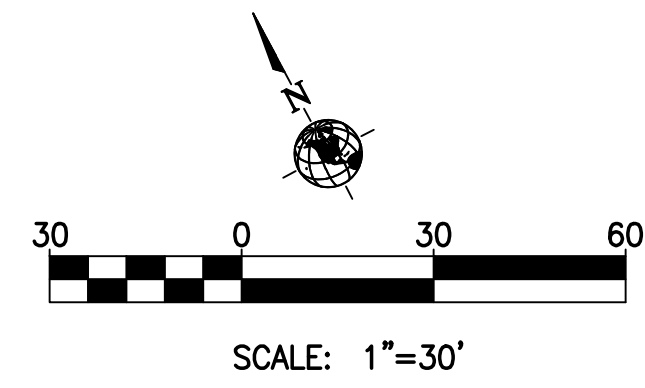


HATCH LEGEND:

- PROPOSED 6" THICK CONCRETE PAVING APPROX: 30,938 SQFT
RE: C-9.0 PAVEMENT DETAILS
- PROPOSED 4.5" THICK CONCRETE FOR SIDEWALK APPROX: 1,335 SQFT
RE: C-9.0 PAVEMENT DETAILS
- PROPOSED 6" THICK CONCRETE FOR DRIVEWAY APPROX: 737 SQFT
RE: C-9.0 PAVEMENT DETAILS
- 6" TALL CURB REF. SECTION
- PROPOSED 6" THICK CONCRETE FOR DRIVEWAY APPROX: 737 SQFT
RE: C-9.0 PAVEMENT DETAILS
- PROPOSED TRUE-GRID PRO PLUS APPROX: 23,841 SQFT
- EXISTING ASPHALT PAVEMENT APPROX: 18,621 SQFT
- EXISTING PAVEMENT APPROX: 46,728 SQFT
- EXISTING 4.5" THICK CONCRETE FOR SIDEWALK APPROX: 5,788 SQFT
RE: C-9.0 PAVEMENT DETAILS
- EXISTING 6" THICK CONCRETE FOR DRIVEWAY APPROX: 707 SQFT
RE: C-9.0 PAVEMENT DETAILS
- 7" THICK CONCRETE PAVING APPROX: 1,699 SQFT
RE: C-9.0 PAVEMENT DETAILS

LEGEND:

- PROPOSED SAWCUTTING JOINT
- PROPOSED EXPANSION JOINT

*NOTE: SEE PAVING DETAILS FOR JOINT SECTIONS

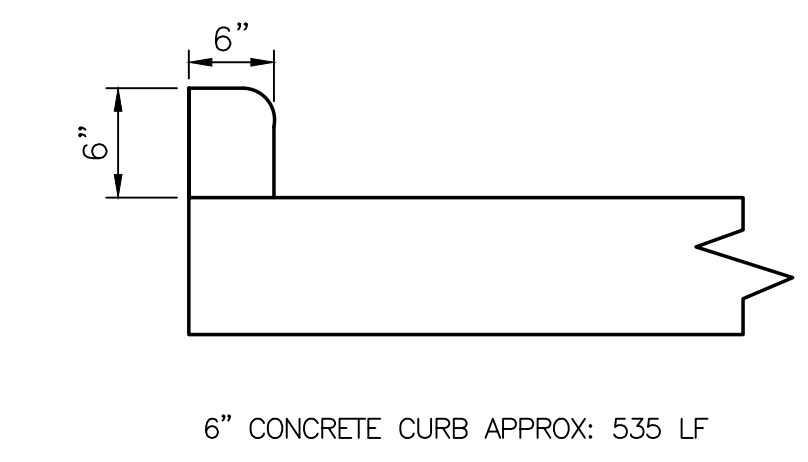

**ONE-CALL NOTIFICATION SYSTEM
CALL BEFORE YOU DIG!!!**
(713) 223-4567 (In Houston, TX)
(New Statewide Number Outside Houston)
1-800-545-6005

KEY PLAN (NOT TO SCALE)

W
F S
R O

Galveston County Road & Bridge Department Facilities PH2


5115 Texas Highway 3
Dickinson, TX

REVISION HISTORY		
NO.	DESCRIPTION	DATE
1	ADDENDUM NO. 3	10-07-2020

PROFESSIONAL SEALS

PAVING PLAN	
DRAWN BY	CHECKED BY
JDM	JDM
PROJECT NUMBER 418198	PROJECT ABBREVIATION GC-R&B
ORIGINAL ISSUE ISSUE FOR PERMIT	DATE 07 OCT 2020
C4.0-PH2	
SHEET NUMBER	

FILE PATH: \\server\path
DATE: 6/26/2020 2:02:08 PM

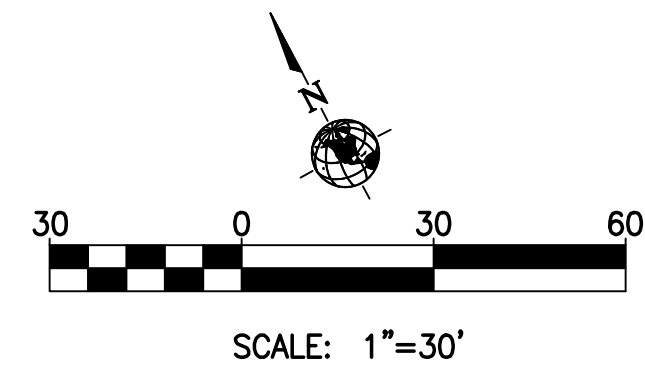

SITE LAYOUT NOTES


1. THE HORIZONTAL AND VERTICAL LOCATION OF EXISTING SUBSURFACE UTILITIES HAVE BEEN DETERMINED FROM DATA PROVIDED BY OTHERS. IT WILL BE THE RESPONSIBILITY OF THE CONTRACTOR TO PROTECT ALL EXISTING UTILITIES WITHIN THE AREA OF CONSTRUCTION THAT ARE TO REMAIN IN SERVICE. CONTRACTOR SHALL VERIFY SIZE AND LOCATION OF ALL UTILITIES PRIOR TO CONSTRUCTION.
2. ALL DIMENSIONS ARE FROM FACE OF CURB UNLESS OTHERWISE NOTED.
3. ALL DIMENSIONS ARE TO FACE OF BUILDING. REFER TO ARCHITECTURAL PLANS FOR BUILDING DIMENSIONS.
4. REFER TO ARCHITECTURAL PLANS FOR ALL STAIRS, HANDICAPPED RAMP AND RETAINING WALL DETAILS.
5. REFER TO LANDSCAPE ARCHITECT PLANS FOR DETAILS AND DIMENSIONS OF LANDSCAPE AND HARDSCAPE AREAS.

LAYOUT KEY NOTES

- 1 PROPERTY LINE.
- 2 PROPOSED 5" THICK CONCRETE SIDEWALK PER PAVEMENT DETAILS.
- 3 PROPOSED 4" YELLOW STRIPING PER PAVEMENT DETAILS TYP.
- 4 PROPOSED STORM DRAIN INLET TYPE "A" PER STORM DRAIN DETAILS.
- 5 PROPOSED JUNCTION BOX PER STORM DRAIN DETAILS.
- 6 PROPOSED ADA RAMP PER PAVEMENT DETAILS.
- 7 PROPOSED LIGHT POLE; REFER TO MEP DRAWINGS FOR LAYOUT AND SPECIFICATIONS.
- 8 EXISTING TRAFFIC SIGN TO REMAIN. PROTECT IN-PLACE.
- 9 PROPOSED AIR/FUEL STATION.
- 10 PROPOSED WASH RACK.
- 11 PROPOSED WHEEL STOP.
- 12 EXISTING POWER POLE TO REMAIN. PROTECT IN-PLACE.
- 13 PROPOSED CHAIN - LINK FENCE
- 14 PROPOSED GATE BY OTHERS.
- 15 PROPOSED 8" SQUARE PREFINISHED METAL DOWNSPOUT. REFER TO ARCHITECTURAL DRAWINGS.
- 16 PROPOSED 6" CONCRETE CURB PER PAVEMENT DETAILS.
- 17 EXISTING STORM DRAIN INLET TYPE "A" PER STORM DRAIN DETAILS.
- 18 EXISTING JUNCTION BOX PER STORM DRAIN DETAILS.


HATCH LEGEND

- CONSTRUCT 5" CONCRETE SIDEWALK ON PRIVATE AND PUBLIC PROPERTY OVER COMPACTED SUB-GRADE PER GEOTECHNICAL ENGINEER'S RECOMMENDATIONS
- PROPOSED BUILDING LAYOUT
- AREA NOT IN SCOPE

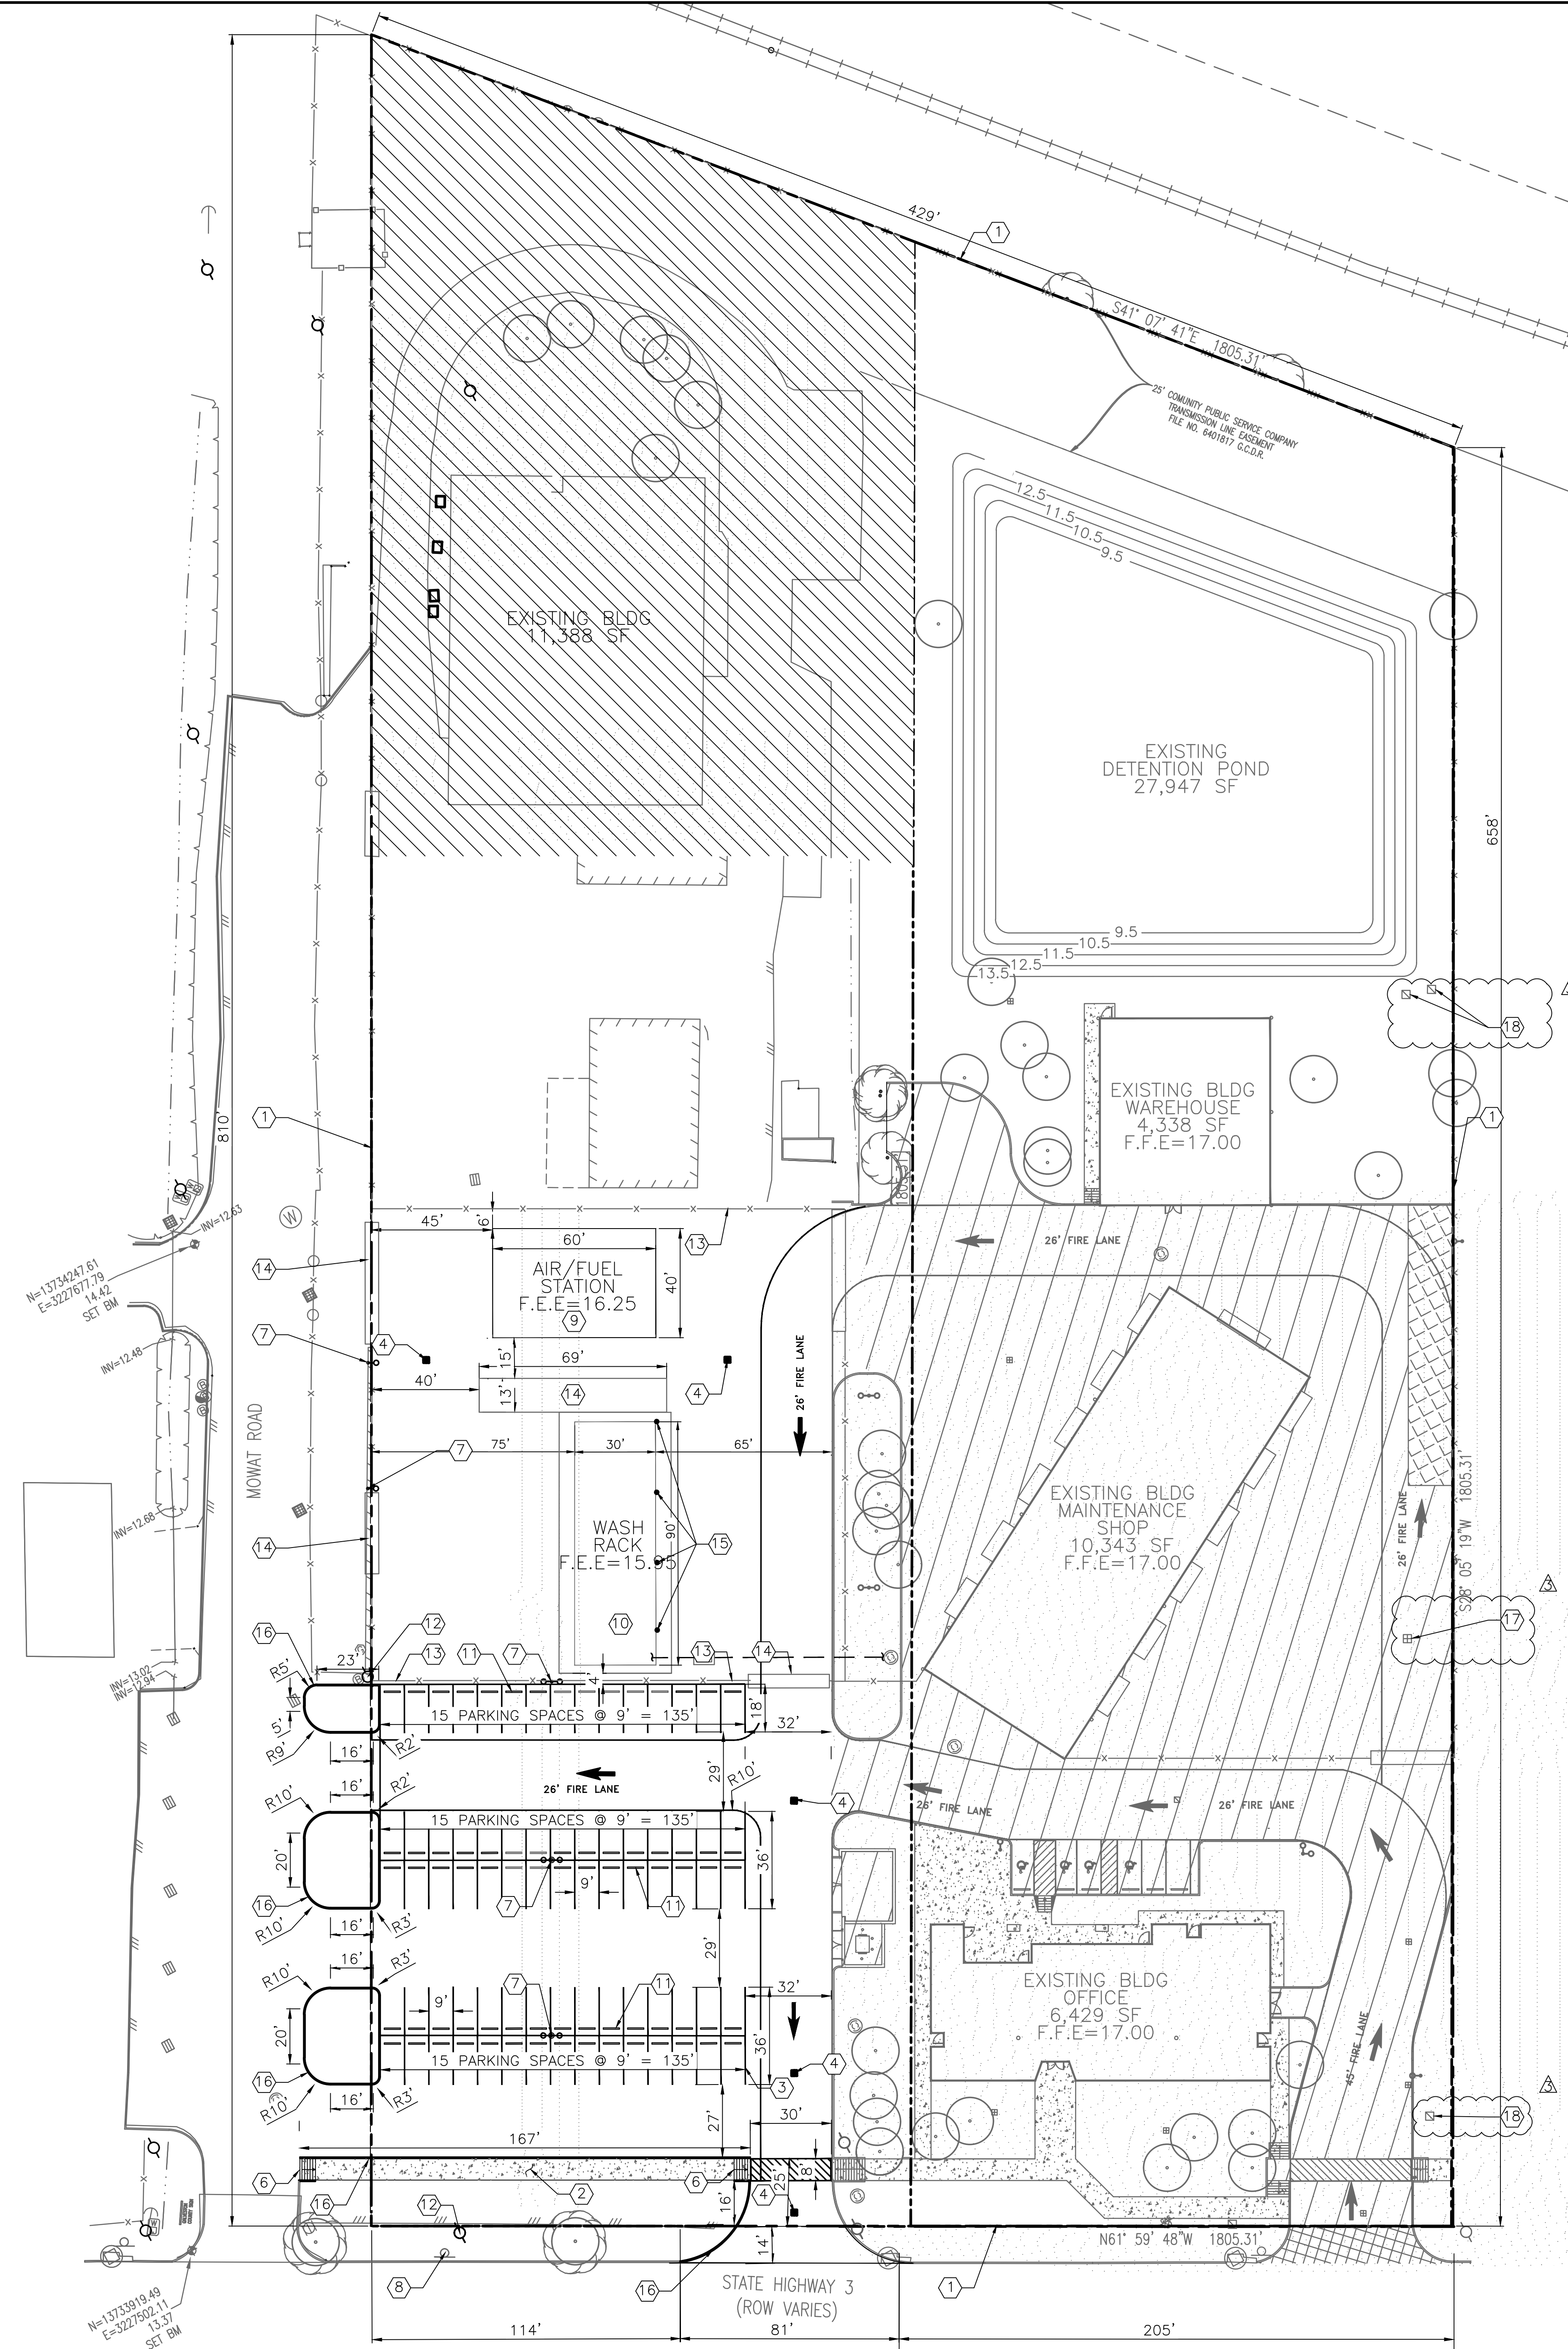

ONE- CALL NOTIFICATION SYSTEM
CALL BEFORE YOU DIG!!!
(713) 223-4567 (In Houston, TX)
(New Statewide Number Outside Houston)
1-800-545-6005

KEY PLAN (NOT TO SCALE)

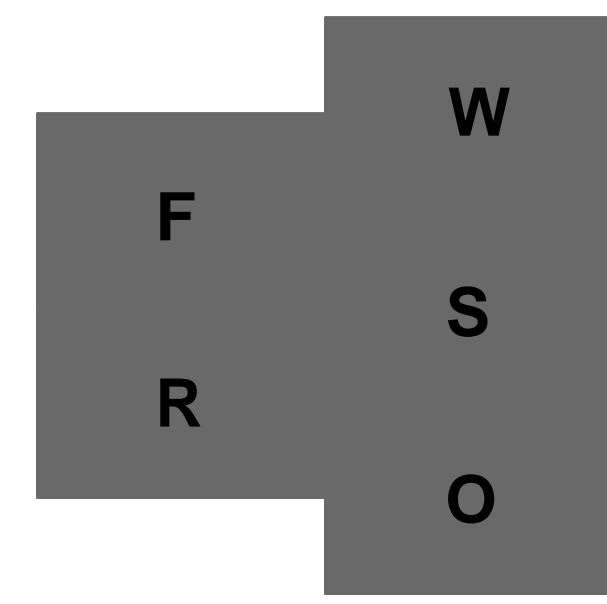

REVISION HISTORY		
ADDENDUM NO. 3		10-07-2020


REVISION	DESCRIPTION	DATE
PROFESSIONAL SEALS		

10/07/2020

LAYOUT PLAN

DRAWN BY JDM	CHECKED BY JDM
PROJECT NUMBER 418198	PROJECT ABBREVIATION GC-R&B
ISSUE FOR PERMIT	DATE 07 OCT 2020

SHEET NUMBER

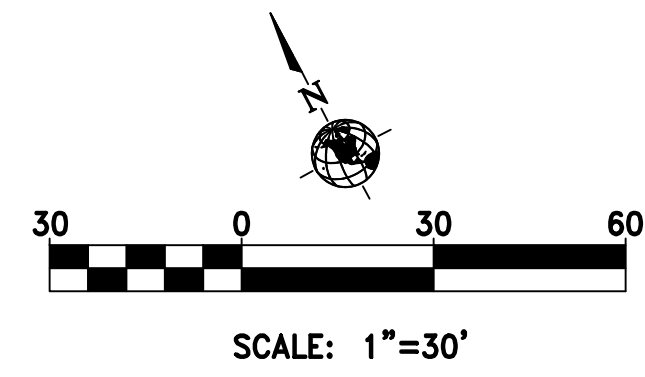

Page Southerland Page, Inc.
 1100 Louisiana, Suite One
 Houston, TX 77002
 pagespp.com
 TEL: 713.871.8484
 FAX: 713.871.8440
 ARCHITECTURE / ENGINEERING / INTERIORS / PLANNING / CONSULTING
 Austin / Dallas / Denver / Dubai / Houston / Mexico City /
 San Francisco / Washington DC / International Affiliate Offices

Civil Engineering
 Dally & Associates
 9800 Richmond Avenue
 Suite 460
 Houston, TX 77042
 713.337.8881
 MEP Engineering
 Page
 1100 Louisiana
 Suite One
 Houston, TX 77002
 713.871.8484
 Landscape Architecture
 Knudson, LP
 8588 Katy Freeway
 Suite 441
 Houston, TX 77024
 713.463.8200
 Structural Engineering
 Dally & Associates
 9800 Richmond Avenue
 Suite 460
 Houston, TX 77042
 713.337.8881
 Low Voltage & Security
 4b Technology Group, LLC
 390 Glenborough Dr.
 Suite 290
 Houston, TX 77067
 832.249.9379

Galveston County
Road & Bridge Department Facilities PH2
 5115 Texas Highway 3
 Dickinson, TX

GRADING PLAN NOTES


1. REFER TO GEOTECHNICAL REPORT FOR ALL COMPACTION AND MOISTURE CONTENT REQUIREMENTS.
2. IT WILL BE THE RESPONSIBILITY OF THE CONTRACTOR TO PROTECT ALL MANHOLES, CLEANOUTS, VALVE BOXES, FIRE HYDRANTS, ECT. WITHIN THE AREA OF CONSTRUCTION THAT ARE TO REMAIN. THEY MUST BE ADJUSTED TO PROPER LINE AND GRADE BY THE CONTRACTOR PRIOR TO AND AFTER THE PLACING OF PAVING AND GRADING. AT NO ADDITIONAL COST TO THE OWNER.
- 3.
4. ALL INLETS AND MANHOLES SHALL MEET THE REQUIREMENTS OF THE LOCAL GOVERNING AGENCY.
5. SIDEWALKS SHALL HAVE A SLOPE NO GRATER THAN 5% AND A CROSS SLOPE NOT GRATER THAN 2%, UNLESS OTHERWISE.

ABBREVIATIONS

- TW TOP OF WALL
- TP TOP OF PAVEMENT ELEVATION
- TC TOP OF CURB ELEVATION
- TG TOP OF GRATE ELEVATION (STORM DRAIN INLET)
- FG FINISHED GRADE ELEVATION
- FFE FINISHED FLOOR ELEVATION
- BFE BASE FLOOD ELEVATION
- FL FLOWLINE ELEVATION


HATCH LEGEND

- CONSTRUCT 5" CONCRETE SIDEWALK OVER COMPACTED SUB-GRADE PER GEOTECHNICAL. ENGINEER'S RECOMMENDATIONS
- PROPOSED BUILDING LAYOUT.
- AREA NOT IN SCOPE

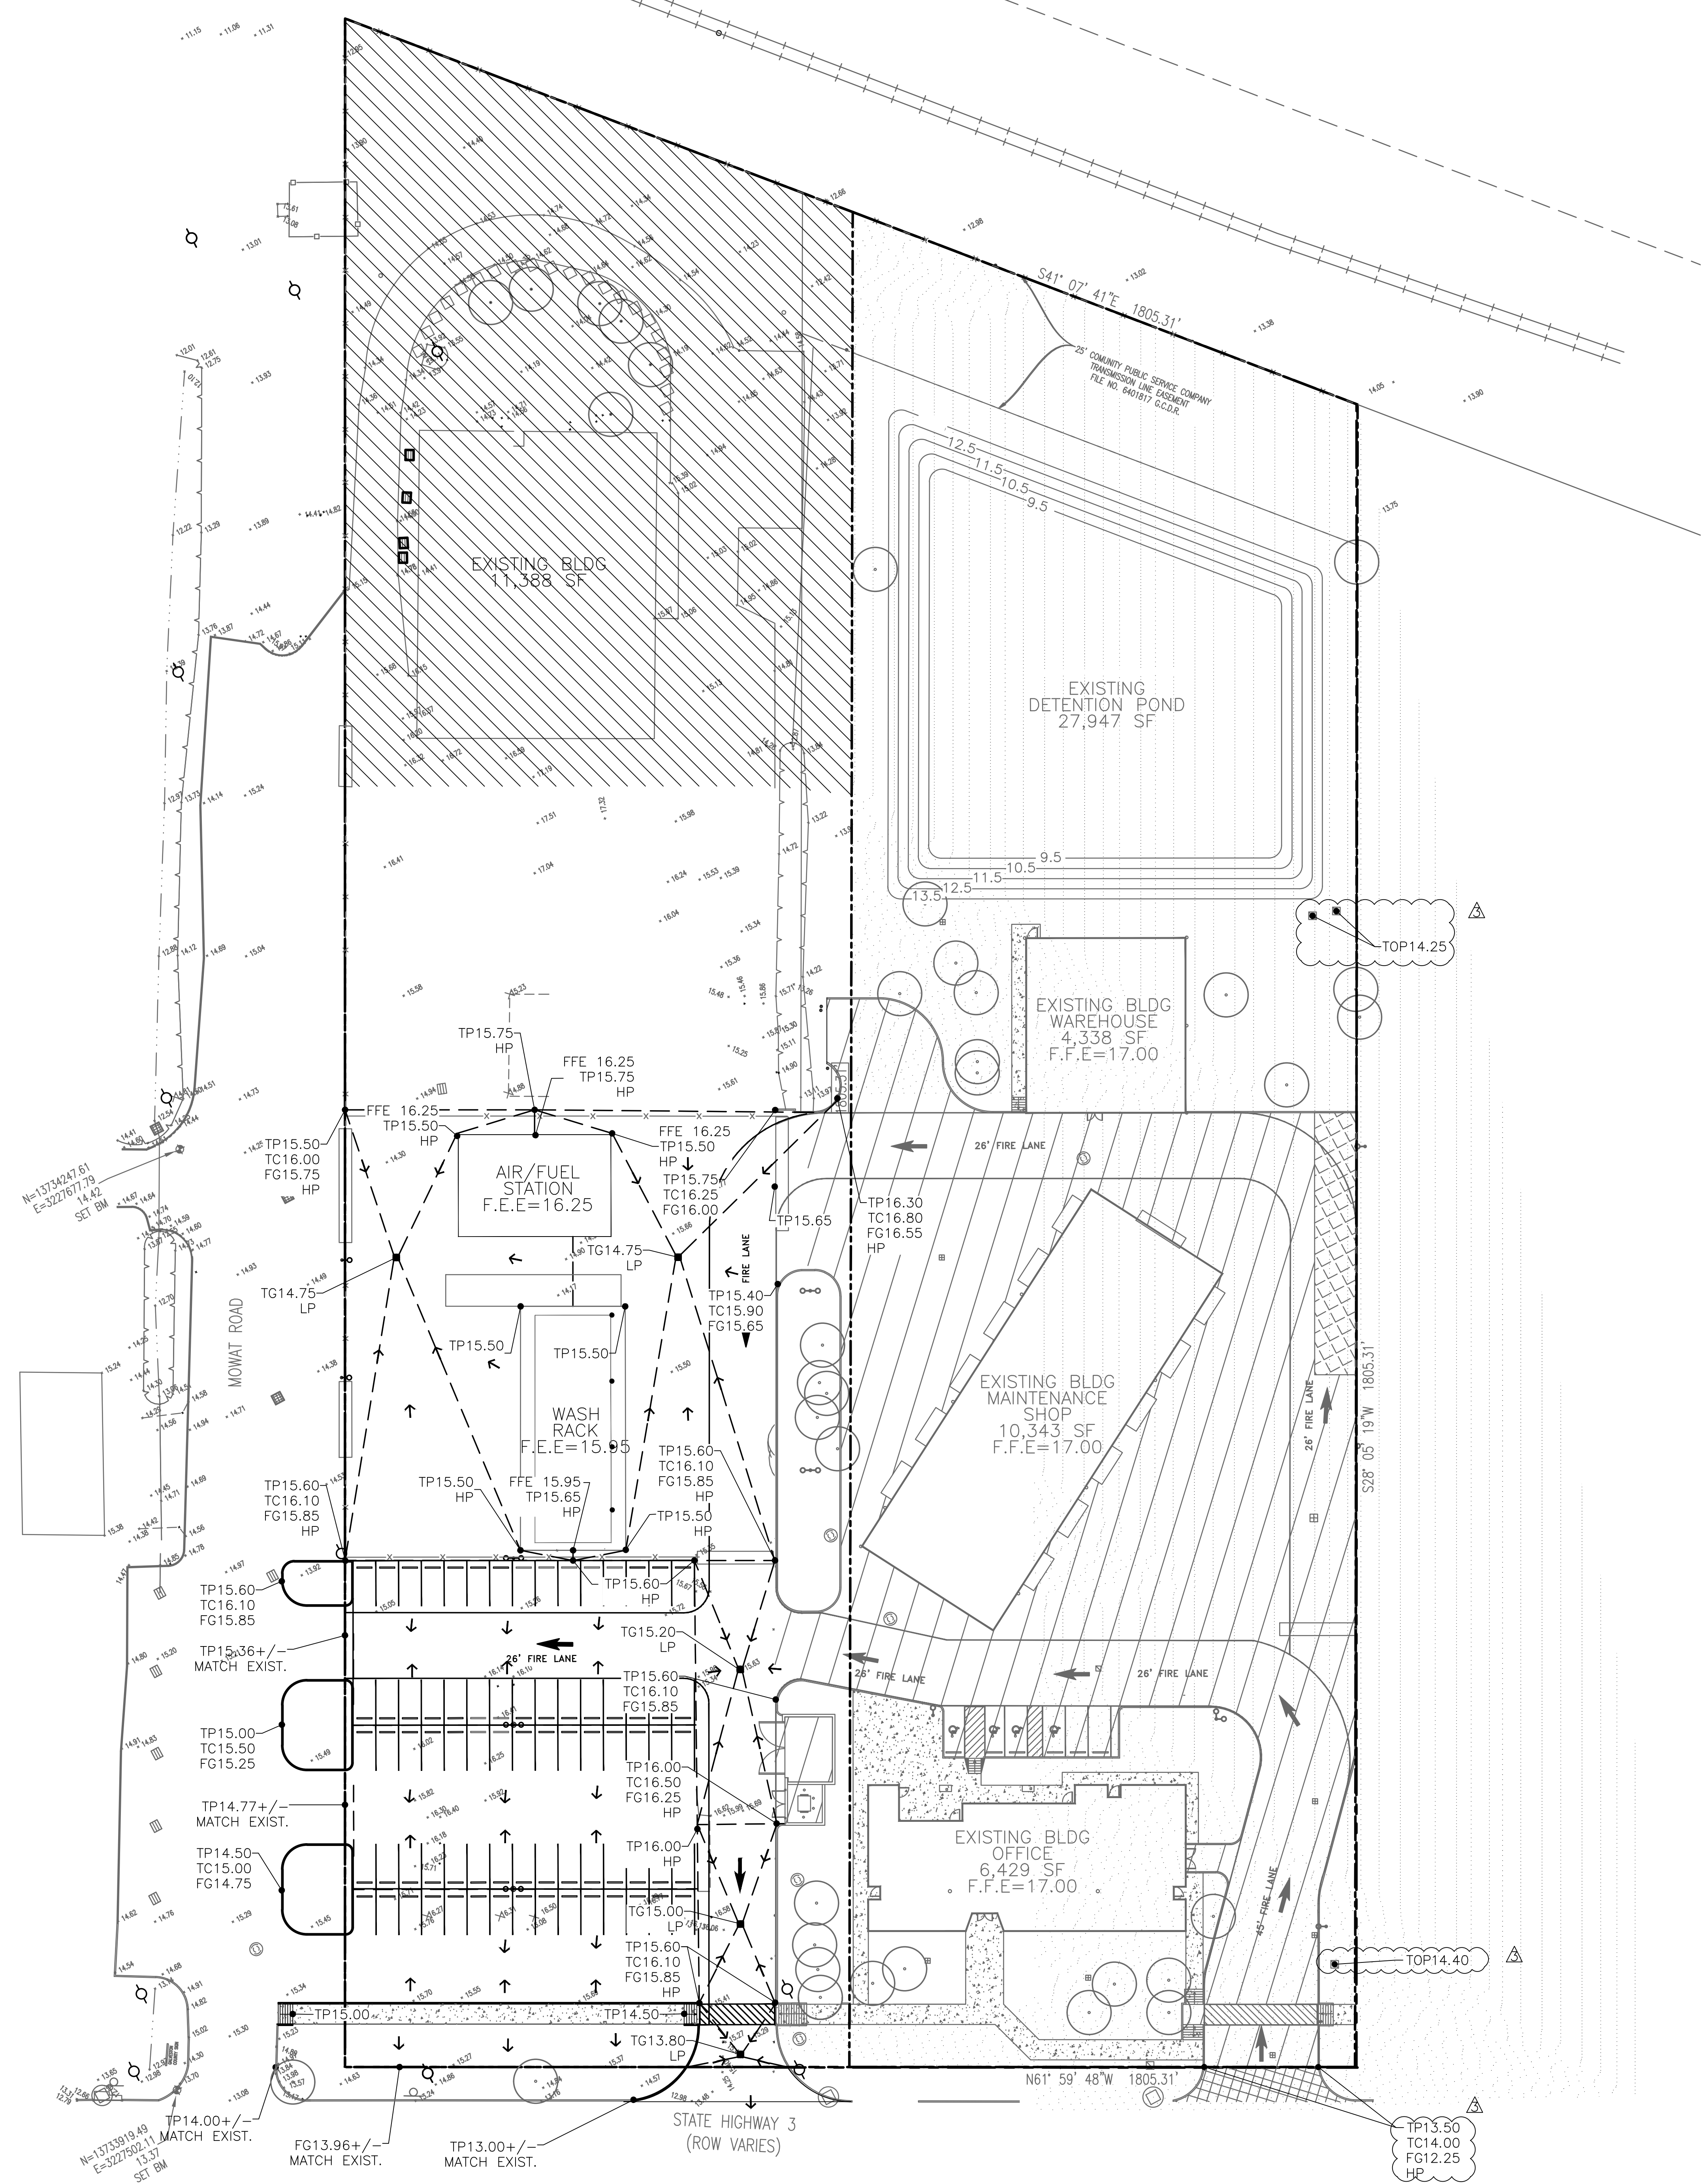


REVISION HISTORY		
ADDENDUM NO. 3		10-07-2020


**ONE-CALL NOTIFICATION SYSTEM
 CALL BEFORE YOU DIG!!!**
 (713) 223-4567 (In Houston, Tx)
 (New Statewide Number Outside Houston)
 1-800-545-6005

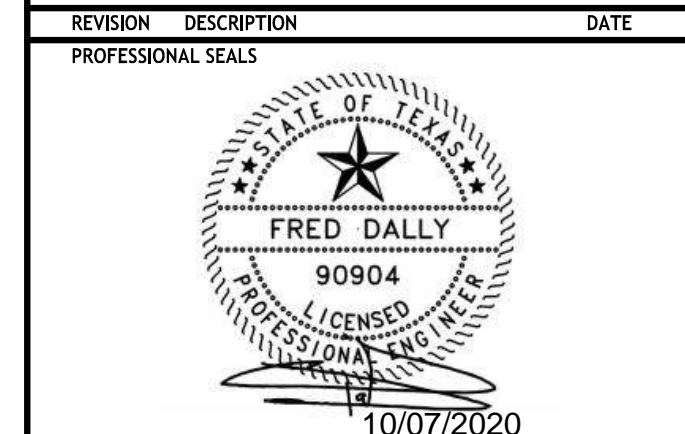

KEY PLAN (NOT TO SCALE)

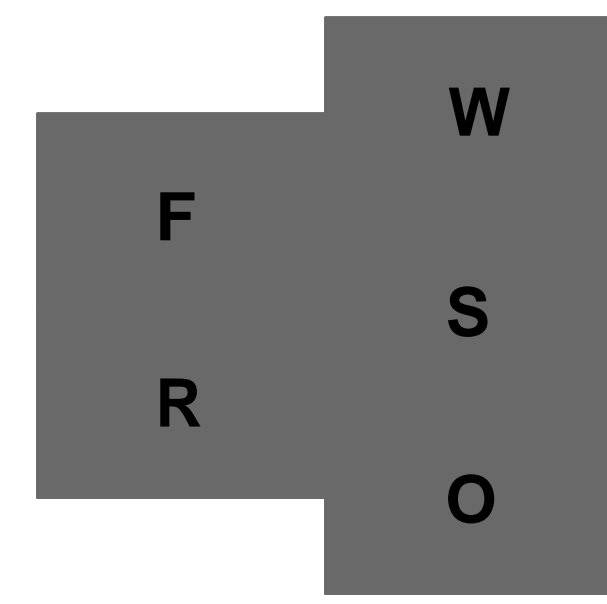

DRAWN BY		CHECKED BY	
JDM		JDM	
PROJECT NUMBER 418198		PROJECT ABBREVIATION GC-R&B	
ORIGINAL ISSUE		DATE	
ISSUE FOR PERMIT		07 OCT 2020	
C6.0-PH2			
SHEET NUMBER			

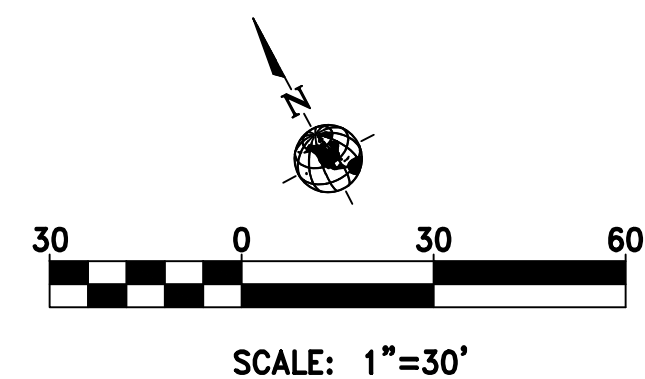

Page Southerland Page, Inc.
1100 Louisiana, Suite One
Houston, TX 77002
pagespp.com

ARCHITECTURE / ENGINEERING / INTERIORS / PLANNING / CONSULTING
Austin / Dallas / Denver / Dubai / Houston / Mexico City /
San Francisco / Washington DC / International Affiliate Offices


Civil Engineering
Dally & Associates
9800 Richmond Avenue
Suite 460
Houston, TX 77042
713.337.8881

MEP Engineering
Page
1100 Louisiana
Suite One
Houston, TX 77002
713.871.8484

Low Voltage & Security
4b Technology Group, LLC
390 Glenborough Dr.
Suite 290
Houston, TX 77067
832.249.9379

Landscape Architecture
Knudson, LP
8588 Katy Freeway
Suite 441
Houston, TX 77024
713.463.8200

Galveston County
Road & Bridge Department Facilities PH2
5115 Texas Highway 3
Dickinson, TX

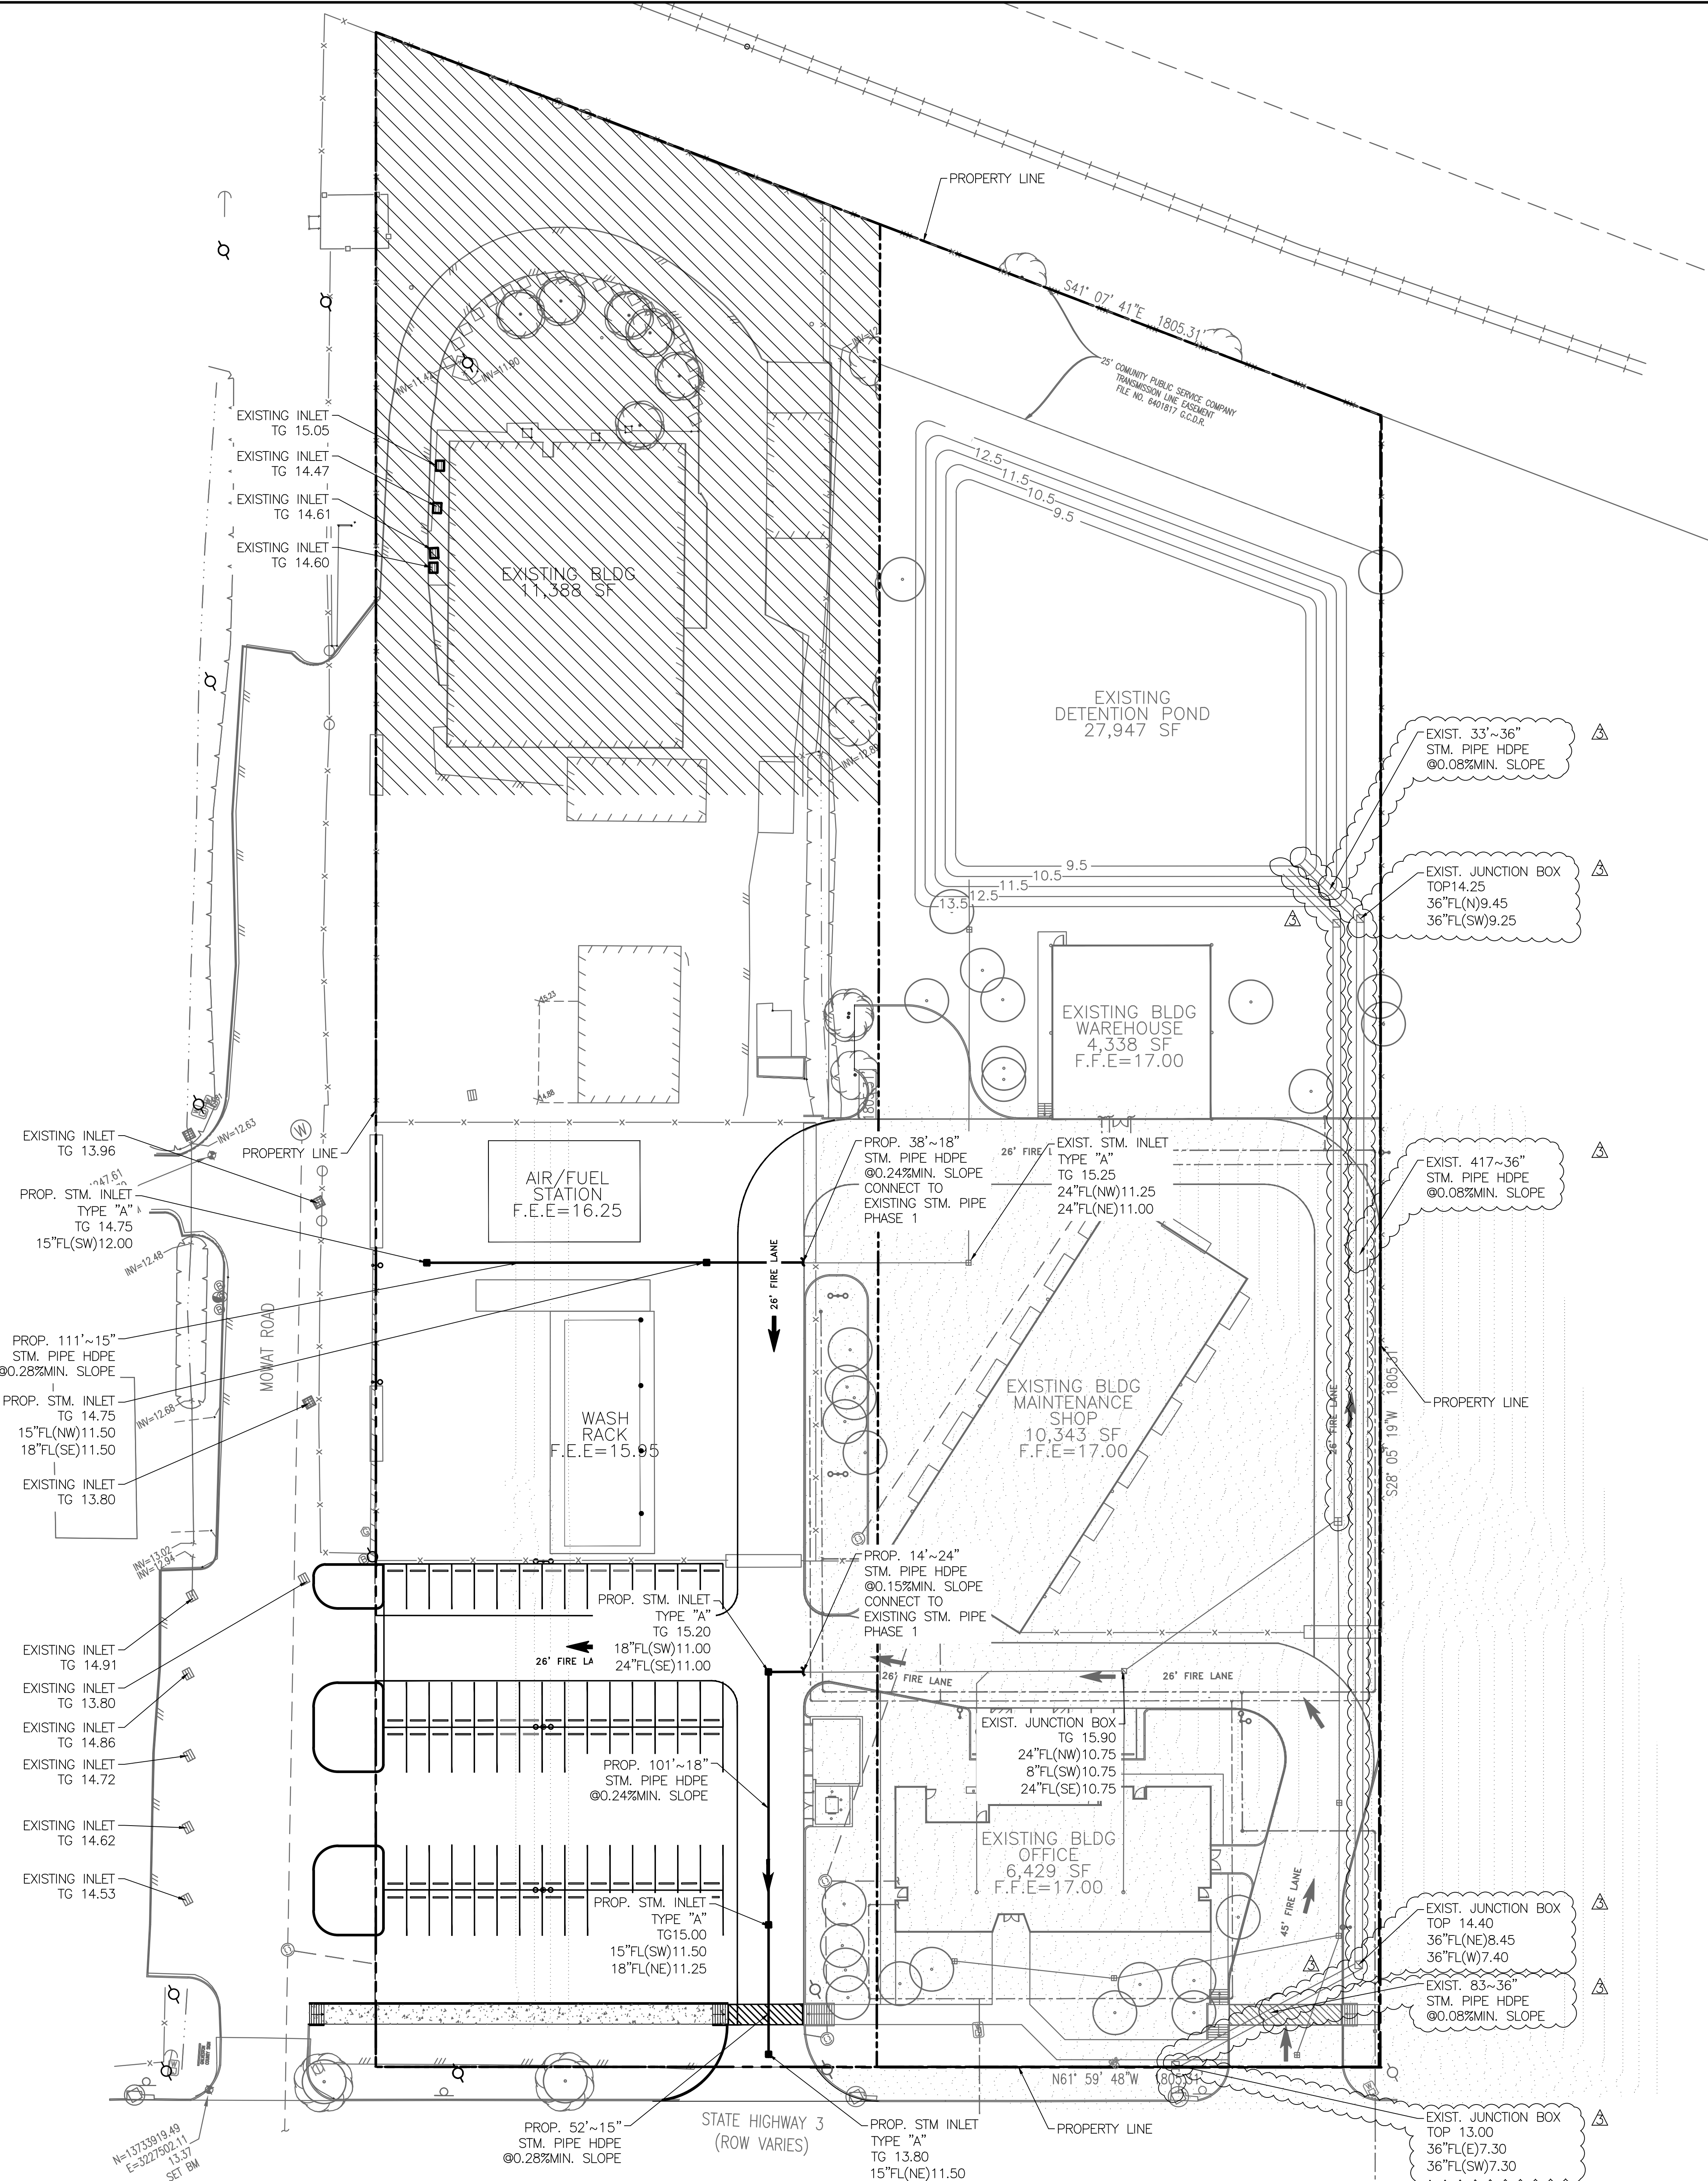

UTILITY PLAN NOTES

- REFER TO GEOTECHNICAL REPORT FOR ALL COMPACTION AND MOISTURE CONTENT REQUIREMENTS.
- IT WILL BE THE RESPONSIBILITY OF THE CONTRACTOR TO PROTECT ALL MANHOLES, CLEANOUTS, VALVE BOXES, FIRE HYDRANTS, ECT. WITHIN THE AREA OF CONSTRUCTION THAT ARE TO REMAIN. THEY MUST BE ADJUSTED TO PROPER LINE AND GRADE BY THE CONTRACTOR PRIOR TO AND AFTER THE PLACING OF PAVING AND GRADING. AT NO ADDITIONAL COST TO THE OWNER.
- ALL INLETS AND MANHOLES SHALL MEET THE REQUIREMENTS OF THE LOCAL GOVERNING AGENCY.
- ALL ROOF DRAINS ARE 4" TYP. REFER TO ARCHITECTURAL DRAWINGS FOR DETAILS.
- SIDEWALKS SHALL HAVE A SLOPE NO GRATER THAN 5% AND A CROSS SLOPE NOT GRATER THAN 2%, UNLESS OTHERWISE NOTED.


HATCH LEGEND

- CONSTRUCT 5" CONCRETE SIDEWALK OVER COMPACTED SUB-GRADE PER GEOTECHNICAL. ENGINEER'S RECOMMENDATIONS
- PROPOSED BUILDING LAYOUT.
- AREA NOT IN SCOPE

REVISION HISTORY	
ADDENDUM NO. 3	10-07-2020

**ONE- CALL NOTIFICATION SYSTEM
CALL BEFORE YOU DIG!!!**
(713) 223-4567 (In Houston, TX)
(New Statewide Number Outside Houston)
1-800-545-6005

KEY PLAN (NOT TO SCALE)

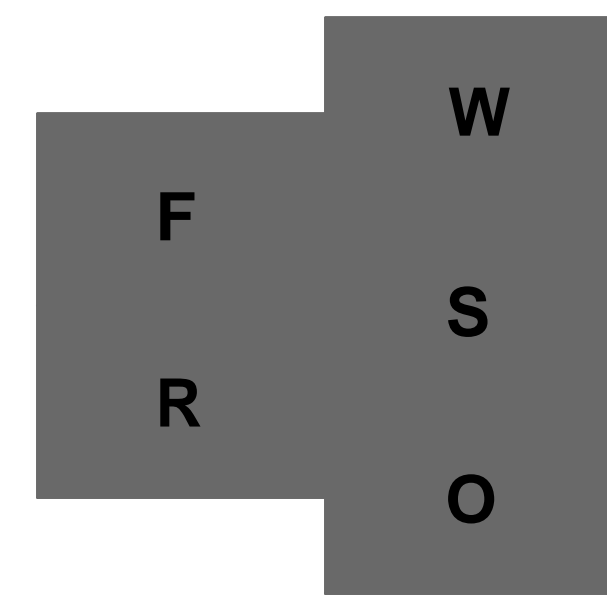

REVISION DESCRIPTION DATE

PROFESSIONAL SEALS

UTILITY PLAN

DRAWN BY: JDM CHECKED BY: JDM


PROJECT NUMBER: 418198 PROJECT ABBREVIATION: GC_R&B

ORIGINAL ISSUE DATE: 07 OCT 2020

ISSUE FOR PERMIT

C7.0-PH2

SHEET NUMBER

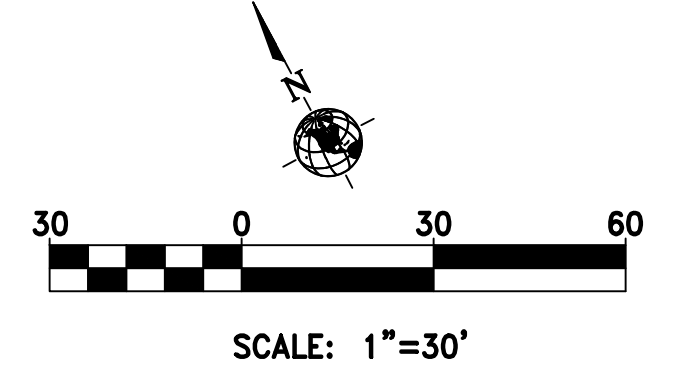

Page Southerland Page, Inc.
 1100 Louisiana, Suite One
 Houston, TX 77002
 pagespp.com
 TEL: 713.871.8484
 FAX: 713.871.8484
 ARCHITECTURE / ENGINEERING / INTERIORS / PLANNING / CONSULTING
 Austin / Dallas / Denver / Dubai / Houston / Mexico City /
 San Francisco / Washington DC / International Affiliate Offices

Civil Engineering
 Dally & Associates
 9800 Richmond Avenue
 Suite 460
 Houston, TX 77042
 713.337.8881
 MEP Engineering
 Page
 1100 Louisiana
 Suite One
 Houston, TX 77002
 713.871.8484
 Landscape Architecture
 Knudson, LP
 8588 Katy Freeway
 Suite 441
 Houston, TX 77024
 713.463.8200
 Structural Engineering
 Dally & Associates
 9800 Richmond Avenue
 Suite 460
 Houston, TX 77042
 713.337.8881
 Low Voltage & Security
 4b Technology Group, LLC
 390 Glenborough Dr.
 Suite 290
 Houston, TX 77067
 832.249.9379

UTILITY PLAN NOTES


1. REFER TO GEOTECHNICAL REPORT FOR ALL COMPACTION AND MOISTURE CONTENT REQUIREMENTS.
2. IT WILL BE THE RESPONSIBILITY OF THE CONTRACTOR TO PROTECT ALL MANHOLES, CLEANOUTS, VALVE BOXES, FIRE HYDRANTS, ECT. WITHIN THE AREA OF CONSTRUCTION THAT ARE TO REMAIN. THEY MUST BE ADJUSTED TO PROPER LINE AND GRADE BY THE CONTRACTOR PRIOR TO AND AFTER THE PLACING OF PAVING AND GRADING. AT NO ADDITIONAL COST TO THE OWNER.
3. ALL INLETS AND MANHOLES SHALL MEET THE REQUIREMENTS OF THE LOCAL GOVERNING AGENCY.
4. ALL ROOF DRAINS ARE 4" TYP. REFER TO ARCHITECTURAL DRAWINGS FOR DETAILS.
5. SIDEWALKS SHALL HAVE A SLOPE NO GRATER THAN 5% AND A CROSS SLOPE NOT GRATER THAN 2%, UNLESS OTHERWISE NOTED.

HATCH LEGEND

- CONSTRUCT 5" CONCRETE SIDEWALK OVER COMPACTED SUB-GRADE PER GEOTECHNICAL. ENGINEER'S RECOMMENDATIONS
- PROPOSED BUILDING LAYOUT.
- AREA NOT IN SCOPE


**Galveston County
 Road & Bridge Department Facilities PH2**
 5115 Texas Highway 3
 Dickinson, TX

REVISION HISTORY		
NO.	DESCRIPTION	DATE
1	ADDENDUM NO. 3	10-07-2020

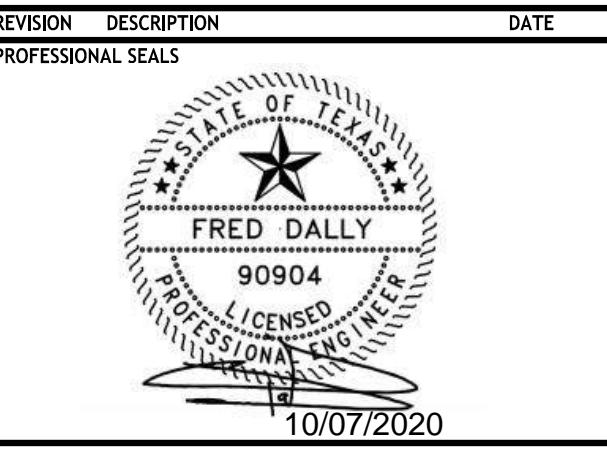


**ONE- CALL NOTIFICATION SYSTEM
 CALL BEFORE YOU DIG!!!**
 (713) 223-4567 (In Houston, Tx)
 (New Statewide Number Outside Houston)
 1-800-545-6005

KEY PLAN (NOT TO SCALE)

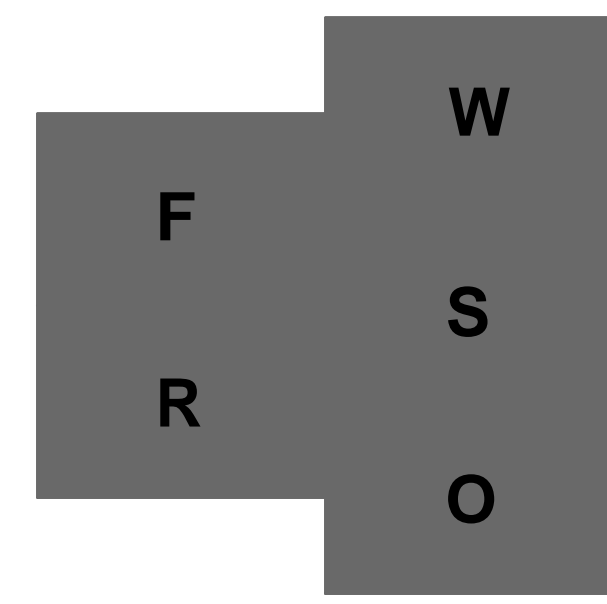

UTILITY PLAN	
DRAWN BY	CHECKED BY
JDM	JDM
PROJECT NUMBER 418198	PROJECT ABBREVIATION GC_R&B
ORIGINAL ISSUE	DATE
ISSUE FOR PERMIT	07 OCT 2020
C7.1-PH2	
SHEET NUMBER	

FILE PATH: \\server\path
 DATE: 6/26/2020 2:02:08 PM

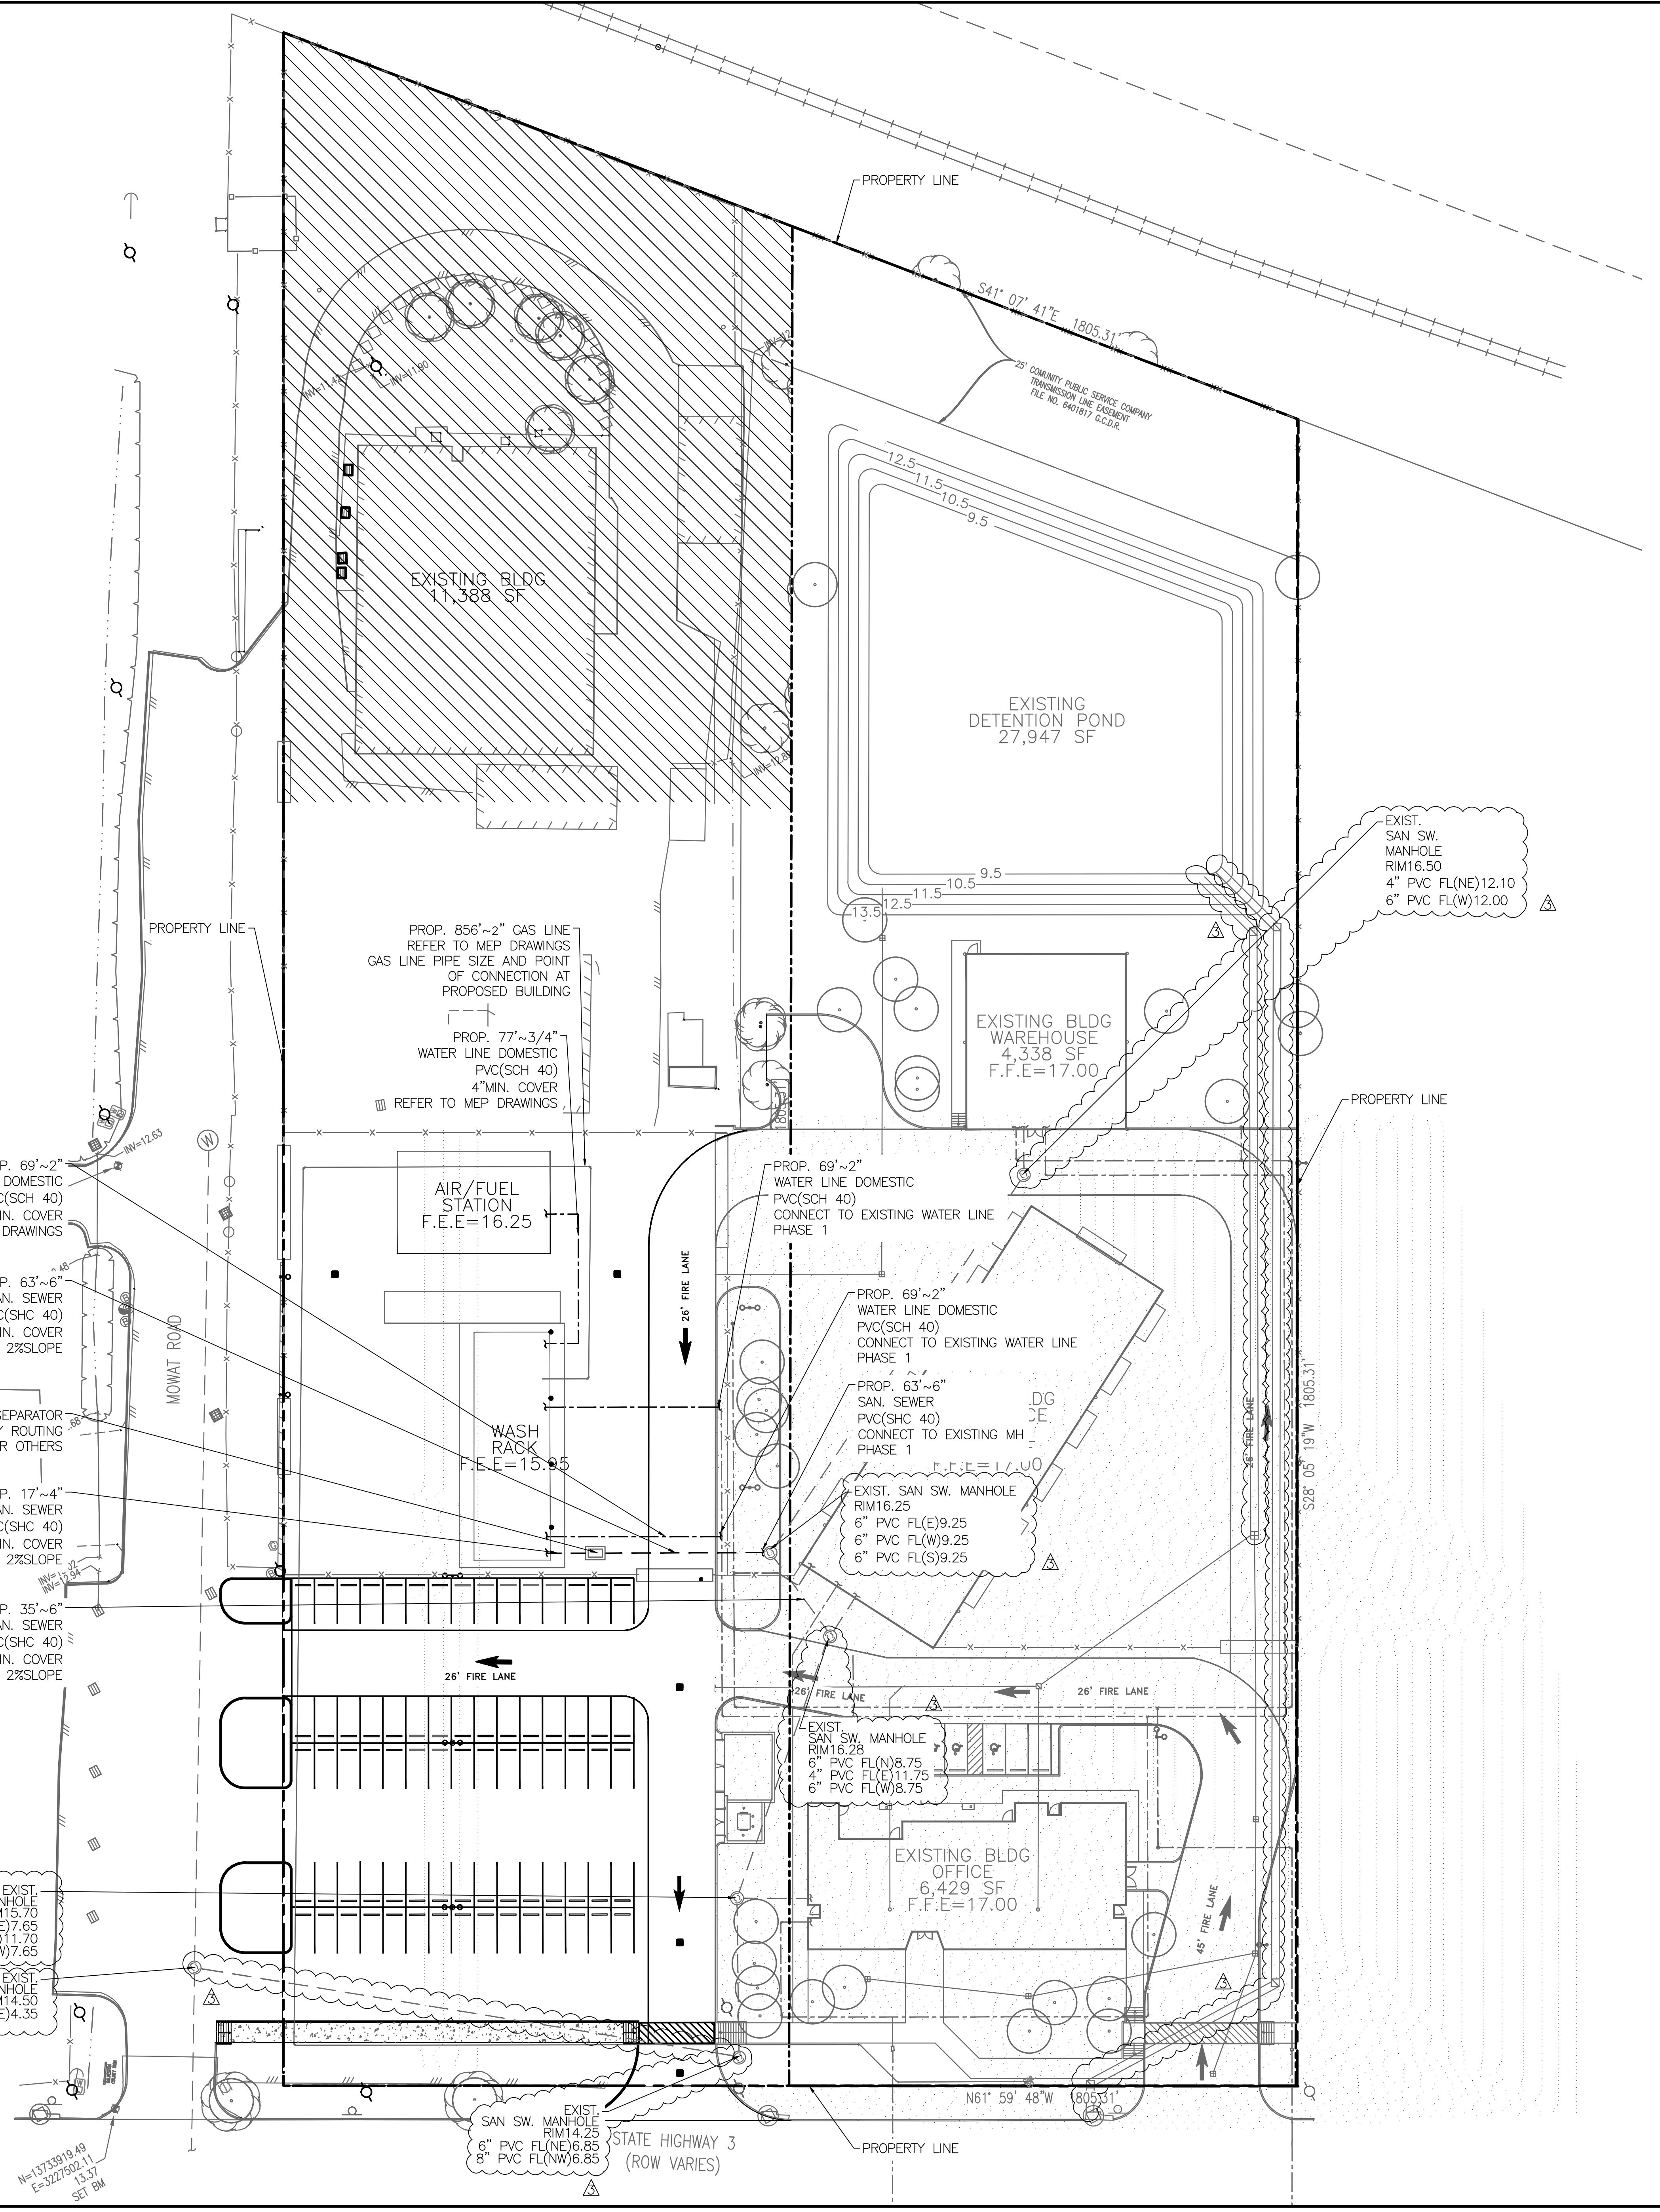

Galveston County
Road & Bridge Department Facilities PH2
5115 Texas Highway 3
Dickinson, TX

A. GENERAL CONSTRUCTION NOTES:

- 1. CONTRACTOR SHALL FIELD VERIFY EXISTING CONDITIONS BEFORE BEGINNING CONSTRUCTION.
2. CONTRACTOR SHALL BE RESPONSIBLE FOR PROVIDING REQUIRED SECURITY TO PROTECT HIS OWN PROPERTY, EQUIPMENT AND WORK IN PROGRESS.
3. CONTRACTOR IS RESPONSIBLE FOR CLEANING OF STREETS CAUSED BY ASSOCIATED CONSTRUCTION AT CLOSE OF EACH WORK DAY.
4. PAVED SURFACES SHALL BE PROTECTED FROM DAMAGE BY TRACKED EQUIPMENT.
5. CONTRACTOR WILL PAY ALL COST TO REPLACE IRON RODS OR OTHER LAND BOUNDARY MARKERS DISTURBED DURING CONSTRUCTION. A REGISTERED LAND SURVEYOR WILL BE USED TO RESET DISTURBED BOUNDARY MARKERS.
6. THE CONTRACTOR SHALL BE RESPONSIBLE FOR MAINTAINING AN UPDATE REDLINED "RECORD" SET OF CONSTRUCTION DRAWINGS ON SITE FOR INSPECTION BY THE ENGINEER.
7. CONTRACTOR SHALL PROVIDE ORANGE FENCING OR BARRICADES TO PROTECT PEDESTRIANS FROM ENTERING WORK AREAS.
8. CONTRACTOR MUST PROVIDE FENCING AROUND OPEN EXCAVATIONS AREA AT ALL TIMES.
9. REFER TO THE SWPPP GENERAL NOTES FOR PROPER MEASURES AND CONTROLS.

B. PAVEMENT

- 1. EXISTING PAVEMENTS, CURBS, SIDEWALKS, AND DRIVEWAYS DAMAGE OR REMOVED DURING CONSTRUCTION SHALL BE REPLACED TO ORIGINAL CONDITION OR BETTER, IN ACCORDANCE WITH THE GOVERNMENT AGENCY HAVING JURISDICTION.
2. THE SUBGRADE SHALL BE BROUGHT TO THE LINES AND GRADES AS SHOWN ON THE DRAWINGS.
3. WHENEVER UNSUITABLE MATERIAL IS ENCOUNTERED AND CANNOT BE HANDLED BY THE EXCAVATION OR EMBANKMENT REQUIREMENTS, THEN THE UNSUITABLE MATERIAL SHALL BE EXCAVATED TO A DEPTH DEEMED SUFFICIENT BY THE ENGINEER AND THE EXCAVATED MATERIAL SHALL BE DISPOSED OF OFF THE JOB SITE. THE EXCAVATED AREA SHALL BE FILLED WITH SELECT FILL PER STANDARDS OF THE GOVERNMENT AGENCY HAVING JURISDICTION.
4. SURPLUS EXCAVATED EARTHEN MATERIAL BECOMES THE PROPERTY OF THE CONTRACTOR AND SHALL BE REMOVED AND DISPOSED OF OFF-SITE. INCLUDE COST OF REMOVAL AND DISPOSAL IN OTHER ITEMS OF WHICH THIS WORK IS A COMPONENT PART. NO SEPARATE PAY. THE MATERIAL MUST BE DISPOSED OF IN A SAFE AND LEGAL MANNER.
5. EXISTING WATER VALVES AND MANHOLES SHALL BE ADJUSTED, AS NECESSARY TO MATCH TOP OF PROPOSED PAVEMENT ELEVATION.

C. SANITARY SEWER, STORM SEWER & DRAINAGE

- 1. ADEQUATE DRAINAGE SHALL BE MAINTAINED AT ALL TIMES DURING CONSTRUCTION.
2. ANY CURB DISTURBED DURING CONSTRUCTION SHALL BE RESTORED TO THE SATISFACTION OF THE ENGINEER OR OWNING AUTHORITY.
3. CONTRACTOR'S ACTIVITIES SHALL HAVE NO EFFECT TO FLOWS TO AND FROM OFF SITE AREAS EXISTING SHEET DRAINAGE SHALL NOT BE IMPEDED BY PROPOSED CONSTRUCTION.
4. WHERE MANHOLES ARE LOCATED WITHIN PAVED AREAS, CONTRACTOR SHALL SET RIM ELEVATIONS TO MATCH FINISHED GRADE ELEVATIONS. OUTSIDE OF PAVED AREAS, SET MANHOLE RIMS 3 INCHES (MINIMUM) TO 6 INCHES (MAXIMUM) ABOVE FINISHED GRADE. ADD SLOPE FILL AROUND MANHOLES, SLOPED AWAY AND DOWN FROM MANHOLE RING.
5. NO DUMPING OF EXCAVATION MATERIALS WILL BE ALLOWED ON PAVED AREAS. CONTRACTOR MUST DETERMINE A LOCATION TO TEMPORARILY STOCKPILE STORM SEWER EXCAVATION TO BE USED AS BACK FILL, AS APPROVED.
6. THE CONTRACTOR SHALL USE HDPE PLASTIC PIPE OR RCP PIPE AS SHOWN ON PLANS.

D. STANDARD NOTES FOR CONSTRUCTION DRAWINGS:

- 1. CONTRACTOR SHALL BE RESPONSIBLE FOR PROTECTING, MAINTAINING, AND RESTORING BACKSLOPE DRAINAGE SYSTEMS.
2. ALL DISTURBED AREAS WITHIN THE SUBDIVISION, EXCEPT THE CHANNEL BOTTOM, SHALL BE FERTILIZED SEED.
3. ALL BACKFILL SHALL BE STRICTLY ACCORDING TO DETAILS, SPECIFICATION OR GEOTECHNICAL RECOMMENDATIONS, AS APPROVED BY ENGINEER.
4. CONTRACTOR SHALL BE RESPONSIBLE FOR EXCAVATING CHANNEL FLOWLINE TO DESIGN ELEVATIONS AS SHOWN ON PLANS AND DOWNSTREAM AS NECESSARY TO ENSURE NO WATER IN STORM SEWER DURING "DRY" CONDITIONS.
5. CONTRACTOR SHALL BE RESPONSIBLE FOR MAINTAINING FLOW IN CHANNEL DURING CONSTRUCTION AND RESTORING CHANNEL TO ORIGINAL CONDITION.

E. UTILITIES

1. CENTERPOINT ENERGY

WARNING: OVERHEAD ELECTRICAL FACILITIES

A. OVERHEAD LINES MAY EXIST ON THE PROPERTY. WE HAVE ATTEMPTED TO MARK THOSE LINES SINCE THEY ARE CLEARLY VISIBLE, BUT YOU SHOULD LOCATED THEM PRIOR TO BEGINNING ANY CONSTRUCTION. TEXAS LAW, SECTION 752, HEALTH & SAFETY CODE, FORBIDS ALL ACTIVITIES IN WHICH PERSONS OR THINGS MAY COME WITHIN SIX (6) FEET OF LIVE OVERHEAD HIGH VOLTAGE LINES. PARTIES RESPONSIBLE FOR THE WORK, INCLUDING CONTRACTORS, ARE LEGALLY RESPONSIBLE FOR THE SAFETY OF CONSTRUCTION WORKERS UNDER THIS LAW. THIS LAW CARRIES BOTH CRIMINAL AND CIVIL LIABILITY. TO ARRANGE FOR LINES TO BE TURNED OFF OR REMOVED, CALL CENTERPOINT ENERGY, AT (713) 207-7777.

CAUTION: UNDERGROUND GAS FACILITIES

- A. LOCATIONS OF CENTERPOINT ENERGY MAIN LINES, (TO INCLUDE GAS TRANSMISSION, AND/OR INDUSTRIAL GAS SUPPLY CORP. WHERE APPLICABLE), ARE SHOWN IN AN APPROXIMATE LOCATION ONLY. SERVICE LINES ARE USUALLY NOT SHOWN. THE CONTRACTOR SHALL CONTACT THE UTILITY COORDINATING COMMITTEE AT (713) 223-4567 OR 1-800-669-8344 A MINIMUM OF 48 HOURS PRIOR TO CONSTRUCTION TO HAVE MAIN AND SERVICE LINES FIELD LOCATED.
B. WHEN CENTERPOINT ENERGY PIPE LINE MARKINGS ARE NOT VISIBLE, CALL (713)-967-8037 FROM 7:00 AM TO 4:30 PM FOR STATUS OF LINE LOCATION REQUEST BEFORE EXCAVATION BEGINS.
C. WHEN EXCAVATING WITHIN EIGHTEEN INCHES (18") OF THE INDICATED LOCATION OF CENTERPOINT ENERGY FACILITIES, ALL EXCAVATION MUST BE ACCOMPLISHED USING NON-MECHANIZED EXCAVATION PROCEDURES.
D. WHEN CENTERPOINT ENERGY FACILITIES ARE EXPOSED, SUFFICIENT SUPPORT MUST BE PROVIDED TO FACILITIES TO PREVENT EXCESSIVE STRESS ON THE PIPING.
E. THE CONTRACTOR IS FULLY RESPONSIBLE FOR ANY DAMAGES CAUSED BY HIS FAILURE TO EXACTLY LOCATE AND PRESERVE THESE UNDERGROUND FACILITIES.

F. OTHER:

- 1. LOCATION OF ALL EXISTING UNDERGROUND UTILITIES SHOWN ON PLANS IS NOT GUARANTEED TO BE COMPLETE OR DEFINITE. THE APPROXIMATE LOCATIONS OF KNOWN EXISTING UTILITIES ARE SHOWN. CONTRACTOR SHALL DETERMINE THE EXACT SIZE AND HORIZONTAL AND VERTICAL LOCATIONS IN THE FIELD. THE CONTRACTOR SHALL NOTIFY ALL OF THE PROPER GOVERNING AUTHORITIES, (STATE, COUNTY OR CITY) AT LEAST 48 HOURS PRIOR TO COMMENCING WORK.
2. ANY PERMANENT RELOCATION OF AN EXISTING UTILITY NOT SHOWN ON THE DRAWINGS SHALL BE APPROVED BY THE ENGINEER PRIOR TO RELOCATION AND SHALL CONFORM TO THE APPLICABLE STANDARDS OF GOVERNING AUTHORITIES.
3. CONTRACTOR SHALL PROTECT EXISTING UNDERGROUND FACILITIES DURING INSTALLATION OF PROPOSED WORK.
4. IN THE EVENT THAT ANY CONTAMINATED MATERIALS OF SUSPECT CONTAMINATED MATERIALS ARE ENCOUNTERED DURING CONSTRUCTION ACTIVITIES, THE CONTRACTOR SHALL CEASE OPERATIONS IN THAT AREA AND IMMEDIATELY NOTIFY THE ENGINEER.
5. ALL CONSTRUCTION SHALL CONFORM TO THE STANDARDS OF THE GOVERNMENTAL AGENCY HAVING JURISDICTION.
6. ALL PAVEMENT SHALL CONFORM WITH THE STANDARDS OF THE GOVERNMENTAL AGENCY HAVING JURISDICTION.
7. ALL STORM SEWERS SHALL BE CONSTRUCTED OF REINFORCED CONCRETE PIPE (RCP) ASTM C-76, CLASS III, EXCEPT FOR ALUMINIZED STEEL PIPE FOR OUTFALLS. (SEE DETAILS FOR BEDDING).
8. STEEL METAL PIPE SHALL BE ALUMINIZED STEEL AASHTO M274 TYPE 2 MIN. 0.052 THICKNESS.
9. ALL GRAVITY SANITARY SEWERS SHALL BE CONSTRUCTED OF PVC PIPE (ASTM D-3034, SDR 26), UNLESS OTHERWISE NOTED ON THE DRAWINGS.
10. ALL FORCE MAIN SANITARY SEWERS SHALL BE CONSTRUCTED OF PVC PIPE (ASTM D-3034, SDR 26), UNLESS OTHERWISE NOTED ON THE DRAWINGS.
11. ALL SANITARY SEWERS AND WATER MAINS SHALL HAVE SIX (6) INCHES OF SAND BACKFILL BOTH UNDER AND OVER PIPE WITH DETECTOR TAPE (METALLIC) INSTALLED 1.5' BELOW FINISH GRADE.
12. BACKFILL WITH CEMENT STABILIZED SAND WHEN SANITARY SEWER CROSSES OVER STORM SEWER (SPACE BETWEEN STORM AND SANITARY SEWERS).
13. ALL SEWERS UNDER OR WITHIN ONE (1) FOOT OF PROPOSED OR FUTURE PAVEMENT SHALL BE BACKFILLED WITH 1 1/2 SACK CEMENT STABILIZED SAND TO WITHIN ONE (1) FOOT OF SUBGRADE.
14. COST OF SPECIAL BACKFILL AND BEDDING IS INCIDENTAL TO THE UNIT PRICE BID PER LINEAR FOOT, NO EXTRA PAY.
15. WATER MAINS SHALL BE C-900 PVC PIPE BEARING THE NSF-PWSEAL AND FITTINGS SHALL BE DUCTILE IRON MECHANICAL JOINT WITH NON-CORRODING HARDWARE INCLUDING MEGA-LUG RESTRAINTS CONFORMING TO AWWA CL-110 OR C-153.
16. FIRE HYDRANTS SHALL BE "MUELLER IMPROVED" OR APPROVED EQUAL.
17. MINIMUM OF SIX (6) INCHES OF CLEARANCE SHALL BE MAINTAINED BETWEEN WATER MAIN CROSSING OF OTHER UTILITIES.
18. ALL PROPOSED PIPE STUB-OUTS FROM STORM MANHOLES OR INLETS ARE TO BE PLUGGED WITH EIGHT (8) INCH BRICK WALLS UNLESS OTHERWISE NOTED.
19. THE CONTRACTOR SHALL NOTIFY THE CITY OR GOVERNMENTAL AGENCY HAVING JURISDICTION, 48 HOURS IN ADVANCE OF COMMENCING CONSTRUCTION.
20. GUIDELINES SET FORTH IN THE MANUAL ON UNIFORM TRAFFIC CONTROL DEVICES SHALL BE OBSERVED.
21. ALL SANITARY SEWERS SHALL BE CONSTRUCTED IN ACCORDANCE WITH TCEQ "RULES AND REGULATIONS FOR PUBLIC WATER SYSTEMS".
22. CONTRACTOR SHALL OBTAIN ALL CONSTRUCTION PERMITS REQUIRED TO THE STANDARDS OF THE GOVERNMENTAL AGENCY HAVING JURISDICTION.
23. SANITARY MANHOLES WITHIN THE FLOOD PLAIN SHALL BE WATERPROOFED AND VENTED WITH RISER ABOVE FLOOD PLAIN OR RIMS SET ABOVE THE 100 YEAR FLOOD ELEVATION.
24. WHERE A NEW POTABLE WATERLINE CROSSES A NEW, NON-PRESSURE RATED WASTEWATER MAIN OR LATERAL AND A STANDARD LENGTH OF THE WASTEWATER PIPE IS LESS THAN 18 FEET IN LENGTH, THE POTABLE WATER PIPE SEGMENT SHALL BE CENTERED OVER THE WASTEWATER LINE. THE MATERIALS AND METHOD OF INSTALLATION SHALL CONFORM WITH ONE OF THE FOLLOWING OPTIONS.

- (I) WITHIN NINE FEET HORIZONTALLY OF EITHER SIDE OF THE WATERLINE, THE WASTEWATER PIPE AND JOINTS SHALL BE CONSTRUCTED WITH PIPE MATERIAL HAVING A MINIMUM PRESSURE RATING OF AT LEAST 150 PSI. AN ABSOLUTE MINIMUM VERTICAL SEPARATION DISTANCE OF TWO FEET SHALL BE PROVIDED. THE WASTEWATER MAIN OR LATERAL SHALL BE LOCATED BELOW THE WATERLINE.
(II) ALL SECTIONS OF WASTEWATER MAIN OR LATERAL WITHIN NINE FEET HORIZONTALLY OF THE WATERLINE SHALL BE ENCASED IN AN 18-FOOT (OR LONGER) SECTION OF PIPE. FLEXIBLE ENCASING PIPE SHALL HAVE A MINIMUM PIPE STIFFNESS OF 115 PSI AT 5.0% DEFLECTION. THE ENCASING PIPE SHALL BE CENTERED ON THE WATERLINE AND SHALL BE AT LEAST TWO NOMINAL PIPE DIAMETERS LARGER THAN THE WASTEWATER MAIN OR LATERAL. THE SPACE AROUND THE CARRIER PIPE SHALL BE SUPPORTED AT FIVE-FOOT (OR LESS) INTERVALS WITH SPACERS OR BE FILLED TO THE SPRINGLINE WITH WASHED SAND. EACH END OF THE CASING SHALL BE SEALED WITH WATERTIGHT NON-SHRINK CEMENT GROUT OR A MANUFACTURED WATERTIGHT SEAL. AN ABSOLUTE MINIMUM SEPARATION DISTANCE OF SIX INCHES BETWEEN THE ENCASEMENT PIPE AND THE WATERLINE SHALL BE PROVIDED. THE WASTEWATER LINE SHALL BE LOCATED BELOW THE WATERLINE.

(II) WHEN A NEW WATERLINE CROSSES UNDER A WASTEWATER MAIN OR LATERAL, THE WATERLINE SHALL BE ENCASED AS DESCRIBED FOR WASTEWATER MAINS OR LATERALS IN SUBCLASS (II) OF THIS CLAUSE OR CONSTRUCTED OF DUCTILE IRON OR STEEL PIPE WITH MECHANICAL OR WELDED JOINTS AS APPROPRIATE. AN ABSOLUTE MINIMUM SEPARATION DISTANCE OF ONE FOOT BETWEEN THE WATERLINE AND THE WASTEWATER MAIN OR LATERAL SHALL BE PROVIDED. BOTH THE WATERLINE AND WASTEWATER MAIN OR LATERAL MUST PASS A PRESSURE AND LEAKAGE TEST AS SPECIFIED IN AWWA C600 STANDARDS.

- 25. COST OF TRENCH SAFETY SYSTEMS AS REQUIRED BY OSHA FOR DEPTHS OVER FIVE (5) FEET IS INCIDENTAL TO THE PROJECT.
26. WATER LINES ARE TO BE CONSTRUCTED TYPICALLY 4 FEET DEEP TO THE TOP OF THE LINE FROM THE FINISHED CURB ELEVATION OR NATURAL GROUND. LINES MAY BE SAGGED OR RAISED WITHIN THE RANGE OF 3-6 FEET TO AVOID UTILITY CONFLICTS WATER LINE DEFLECTIONS SHALL NOT EXCEED THE PIPE MANUFACTURES RECOMMENDATIONS.
27. ALL SLEEVES TO BE FOUR (4) INCH SCHEDULE 40 PVC SLEEVES TO BE EIGHTEEN (18) INCHES BELOW THE BOTTOM OF THE PAVEMENT BASE MATERIAL. STUB OUT THREE (3) FEET BEYOND CURB AND MARK SLEEVES LOCATIONS ON CURB.
28. THERE SHALL BE A MINIMUM HORIZONTAL DISTANCE OF FOUR (4) FEET CLEARANCE BETWEEN ALL WATER LINES AND SANITARY SEWER LINES THAT ARE SDR 26, AND A NINE (9) FOOT CLEARANCE BETWEEN ALL WATER LINES AND SANITARY SEWER LINES THAT ARE SDR 35. (SEE DETAIL)
29. ALL JOINTS OF DUCTILE IRON PIPE BELOW GROUND WILL BE M.J. WITH PIPE RESTRAINTS.
30. ALL SIGNAGE AND/OR TRAFFIC CONTROL DEVICES SHALL BE APPROVED BY HARRIS COUNTY PRIOR TO CONSTRUCTION.

NOTE: IT SHALL BE THE RESPONSIBILITY OF THE CONTRACTOR TO LOCATE ALL UTILITIES IN THE ROAD R.O.W. PRIOR TO CONSTRUCTION. (TEXAS ONE CALL 1-800-545-6005)

NOTE: CONTRACTOR SHALL ADJUST ALL WATER VALVES AND STORM SEWER MANHOLES TO MATCH FINAL GRADES. SEE ALL GRADING PLANS SHEETS.

NOTE: CONTRACTOR SHALL VERIFY ALL WATER, SANITARY SEWER AND STORM SEWER LINES PRIOR TO WORKING IN ANY AREA. SEE TOPO MAP AND REFERENCE DRAWINGS.

NOTE: THIS DEVELOPMENT HAS BEEN DESIGNED TO NOT IMPEDE, IMPOUND, OR BLOCK THE NATURAL FLOW OF DRAINAGE FROM OR ACROSS ADJACENT AND CONTIGUOUS PROPERTIES.

NOTE: ALL FUTURE SITE AND BUILDINGS PROJECTS WILL REQUIRE CIVIL/SITE DRAWING APPROVAL AND CHANGES TO THE PLATS MAY BE REQUIRED AS A PART OF THE REVIEW PROCESS.


ALL PIPE PLACEMENT AND JOINTING WILL BE CONSTRUCTED STRICTLY IN ACCORDANCE WITH THE MANUFACTURES' REQUIREMENTS AND SPECIFICATIONS.

STORM SEWER PIPE — HDPE N-12, PVC SDR35 OR RCP CLASS III (RUBBER GASKET)— EXCEPT IF NOTED OTHERWISE
POTABLE WATER — 3" AND SMALLER — SCH 80 PVC
4" AND LARGER — C-900, DR 18- 150 PSI
SANITARY SEWER — GRAVITY, PVC SDR 26
CULVERT PIPE — RCP CLASS IV 18"


THE OWNER WILL SET UP THE NECESSARY WATER ACCOUNTS AND PURCHASE THE WATER METERS AND METER BOXES. THE CONTRACTOR WILL PICK UP THE METERS AND BOXES AT THE CITY AND DELIVER THEM TO THE JOBSITE. THE CONTRACTOR WILL MAKE THE NECESSARY TAPS AND INSTALL THE METERS AS REQUIRED BY HARRIS COUNTY.

ONE- CALL NOTIFICATION SYSTM
CALL BEFORE YOU DIG!!!
(713) 223-4567 (In Houston, TX)
(New Statewide Number Outside Houston)
1-800-545-6005

KEY PLAN (NOT TO SCALE)

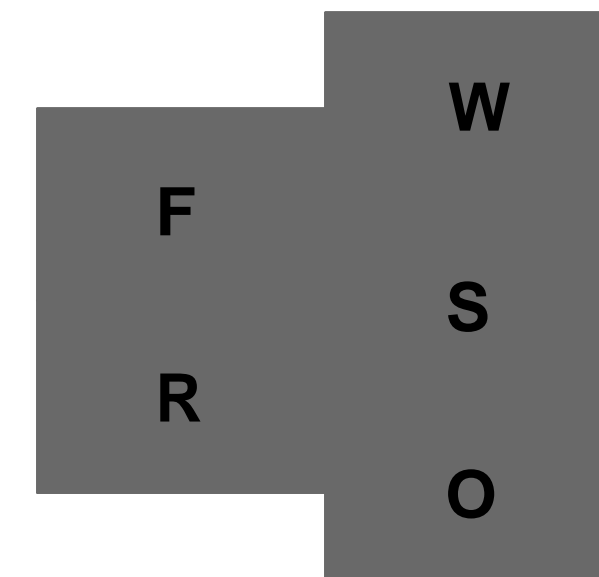

REVISION HISTORY
ADDENDUM NO. 3 10-07-2020

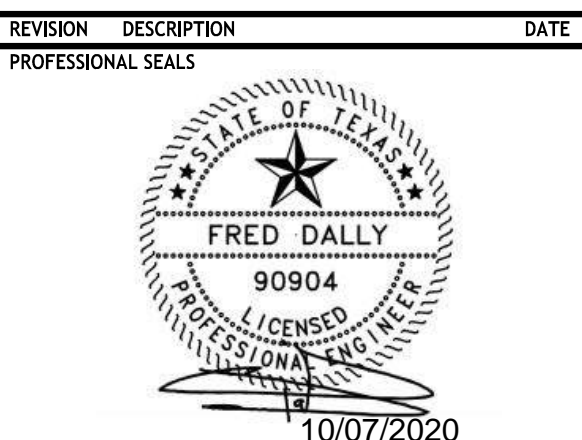

GENERAL NOTES

Table with columns: DRAWN BY (JDM), CHECKED BY (JDM), PROJECT NUMBER (418198), PROJECT ABBREVIATION (GC-RB8), ORIGINAL ISSUE DATE (07 OCT 2020), ISSUE FOR PERMIT.

C8.0-PH2
SHEET NUMBER

Page Southerland Page, Inc.
 1100 Louisiana, Suite One
 Houston, TX 77002
 page@psp.com
 TEL: 713.871.8484
 FAX: 713.871.8440

Civil Engineering
 Dally & Associates
 5800 Richmond Avenue
 Suite 460
 Houston, TX 77042
 713.337.8881


MEP Engineering
 Page
 1100 Louisiana
 Suite One
 Houston, TX 77002
 713.871.8484

Landscape Architecture
 Knudson, LP
 8588 Katy Freeway
 Suite 441
 Houston, TX 77024
 713.463.8200

Galveston County Road & Bridge Department Facilities PH2

5115 Texas Highway 3
 Dickinson, TX

REVISION	DESCRIPTION	DATE
1	ADDENDUM NO. 3	10-07-2020



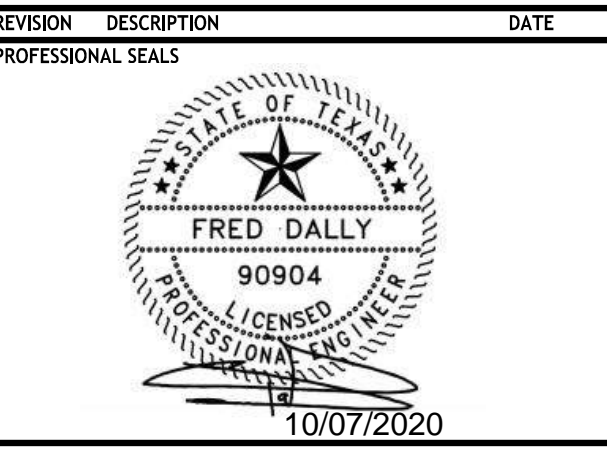


REVISION	DESCRIPTION	DATE
1	PAVEMENT DETAILS	07 OCT 2020

C9.0-PH2

SHEET NUMBER

**ONE- CALL NOTIFICATION SYSTM
 CALL BEFORE YOU DIG!!!**
 (713) 223-4567 (In Houston, TX)
 (New Statewide Number Outside Houston)
 1-800-545-6005

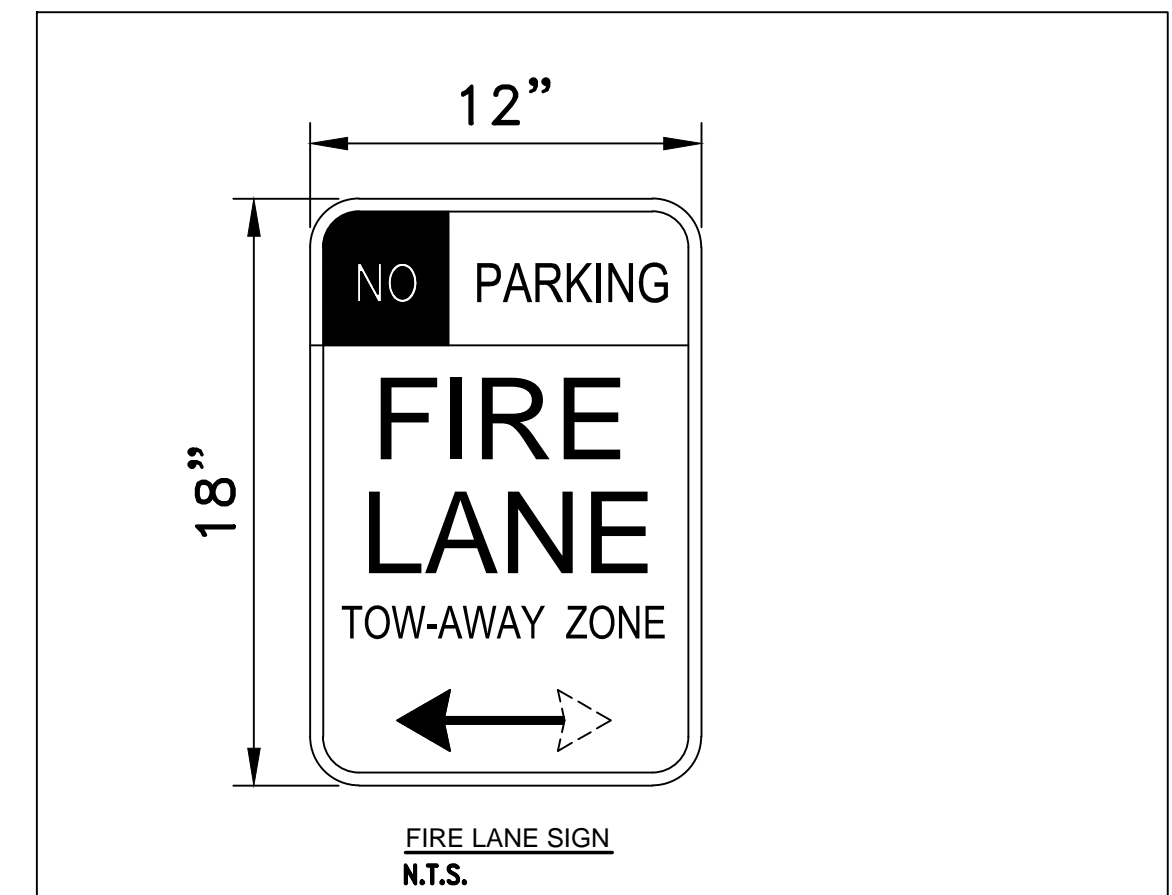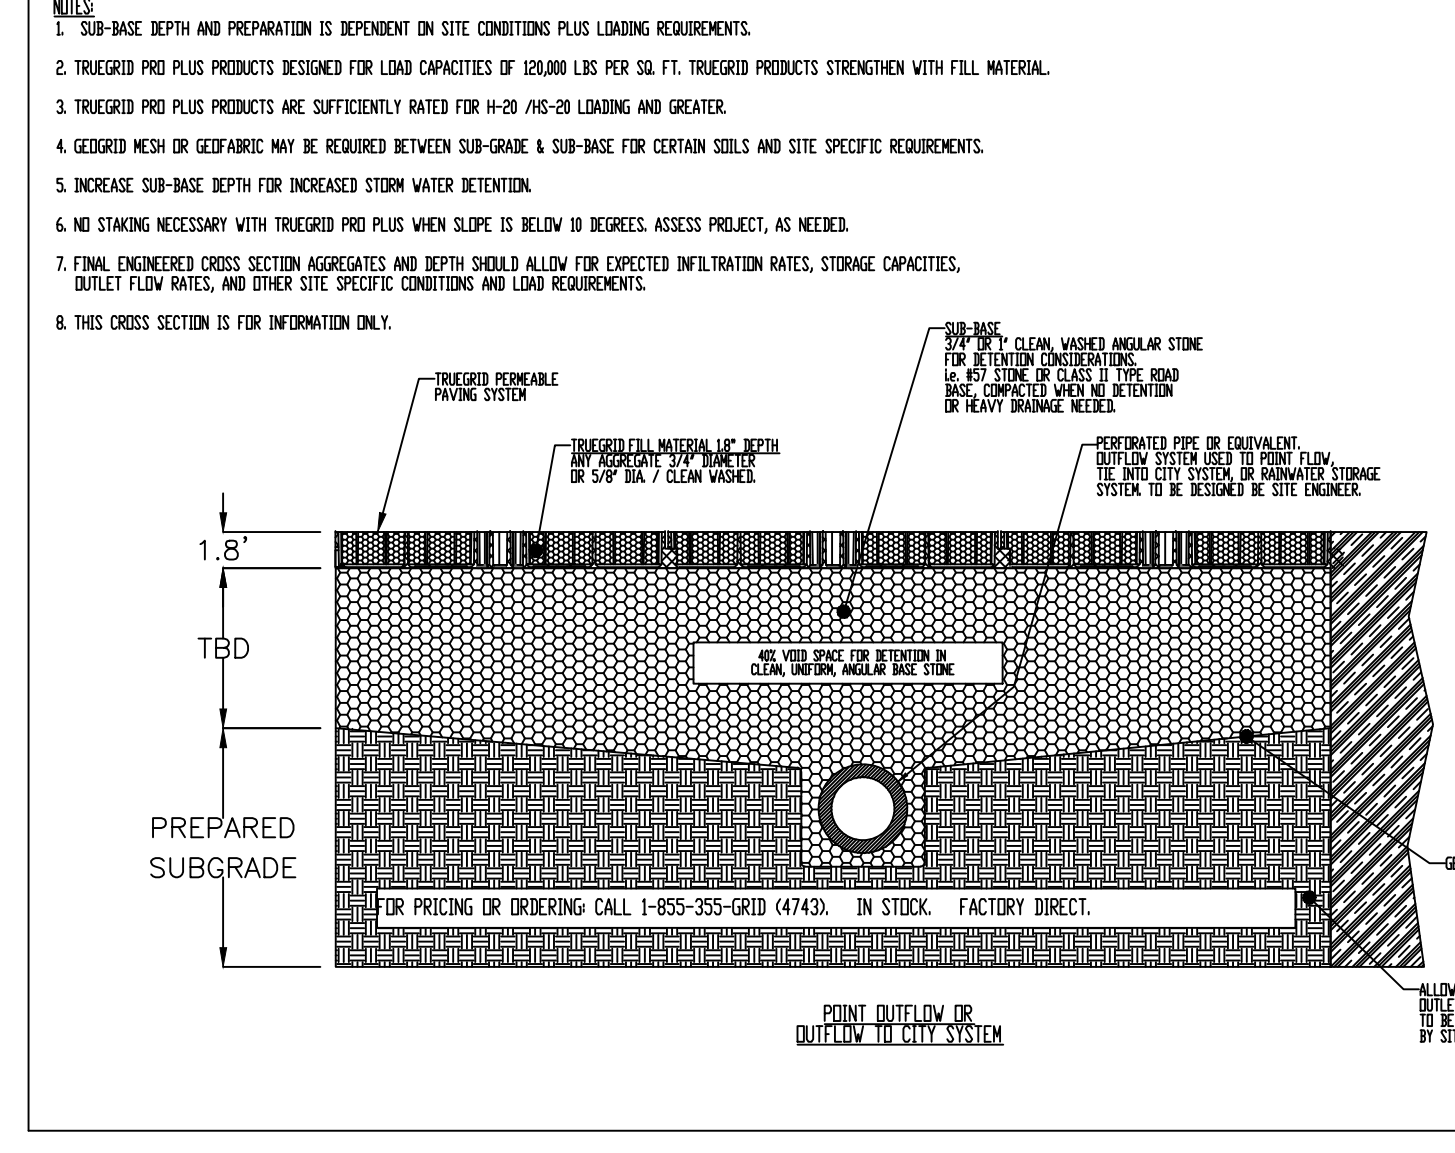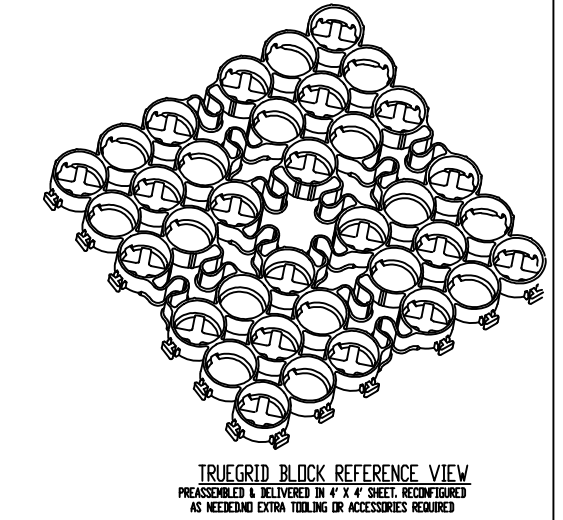

AT THE BEGINNING AND END OF THE FIRE LANE, THE SIGN SHALL HAVE A SINGLE HEADED ARROW POINTING IN THE DIRECTION THE REGULATION IS IN EFFECT. THE INTERMEDIATE SIGN SHALL HAVE DOUBLE HEADED ARROWS POINTING IN BOTH DIRECTIONS.

THE MAXIMUM SPACING OF THE SIGNS SHALL BE 75' CONTINGENT UPON TRAFFIC ENGINEER'S REVIEW APPROVAL.



THE SIGNS SHALL BE SET AT AN ANGLE OF NOT LESS THAN 30° NOR MORE THAN 45° WITH THE CURB OR LINE OF TRAFFIC FLOW.

THE CLEARANCE TO THE BOTTOM OF THE SIGN SHALL BE 7 FEET. THERE SHALL BE NO OTHER SIGNS ATTACHED TO THE SIGN OR THE SIGN POLE.

THE SIGN PLATE SHALL BE A MINIMUM OF 12"x18" WITH A THICKNESS OF 0.80".






FIRE LANE DETAILS AND NOTES
 SCALE: N.T.S.

NOTE:
 FIRE LANES: SIGNS SHALL BE POSTED ON ONE OR BOTH SIDES OF THE FIRE LANE. WHERE A SIGN CAN NOT BE ERRECTED, THE FIRE LANES SHALL BE MARKED USING THE APPROVED METHOD OF 6-INCH RED STRIPES WITH 4-INCH WHITE LETTERS STATING "FIRE LANE NO PARKING" AND SHALL CONTINUE ALONG THE RED STRIPES EVERY 15 FEET INTERVALS.

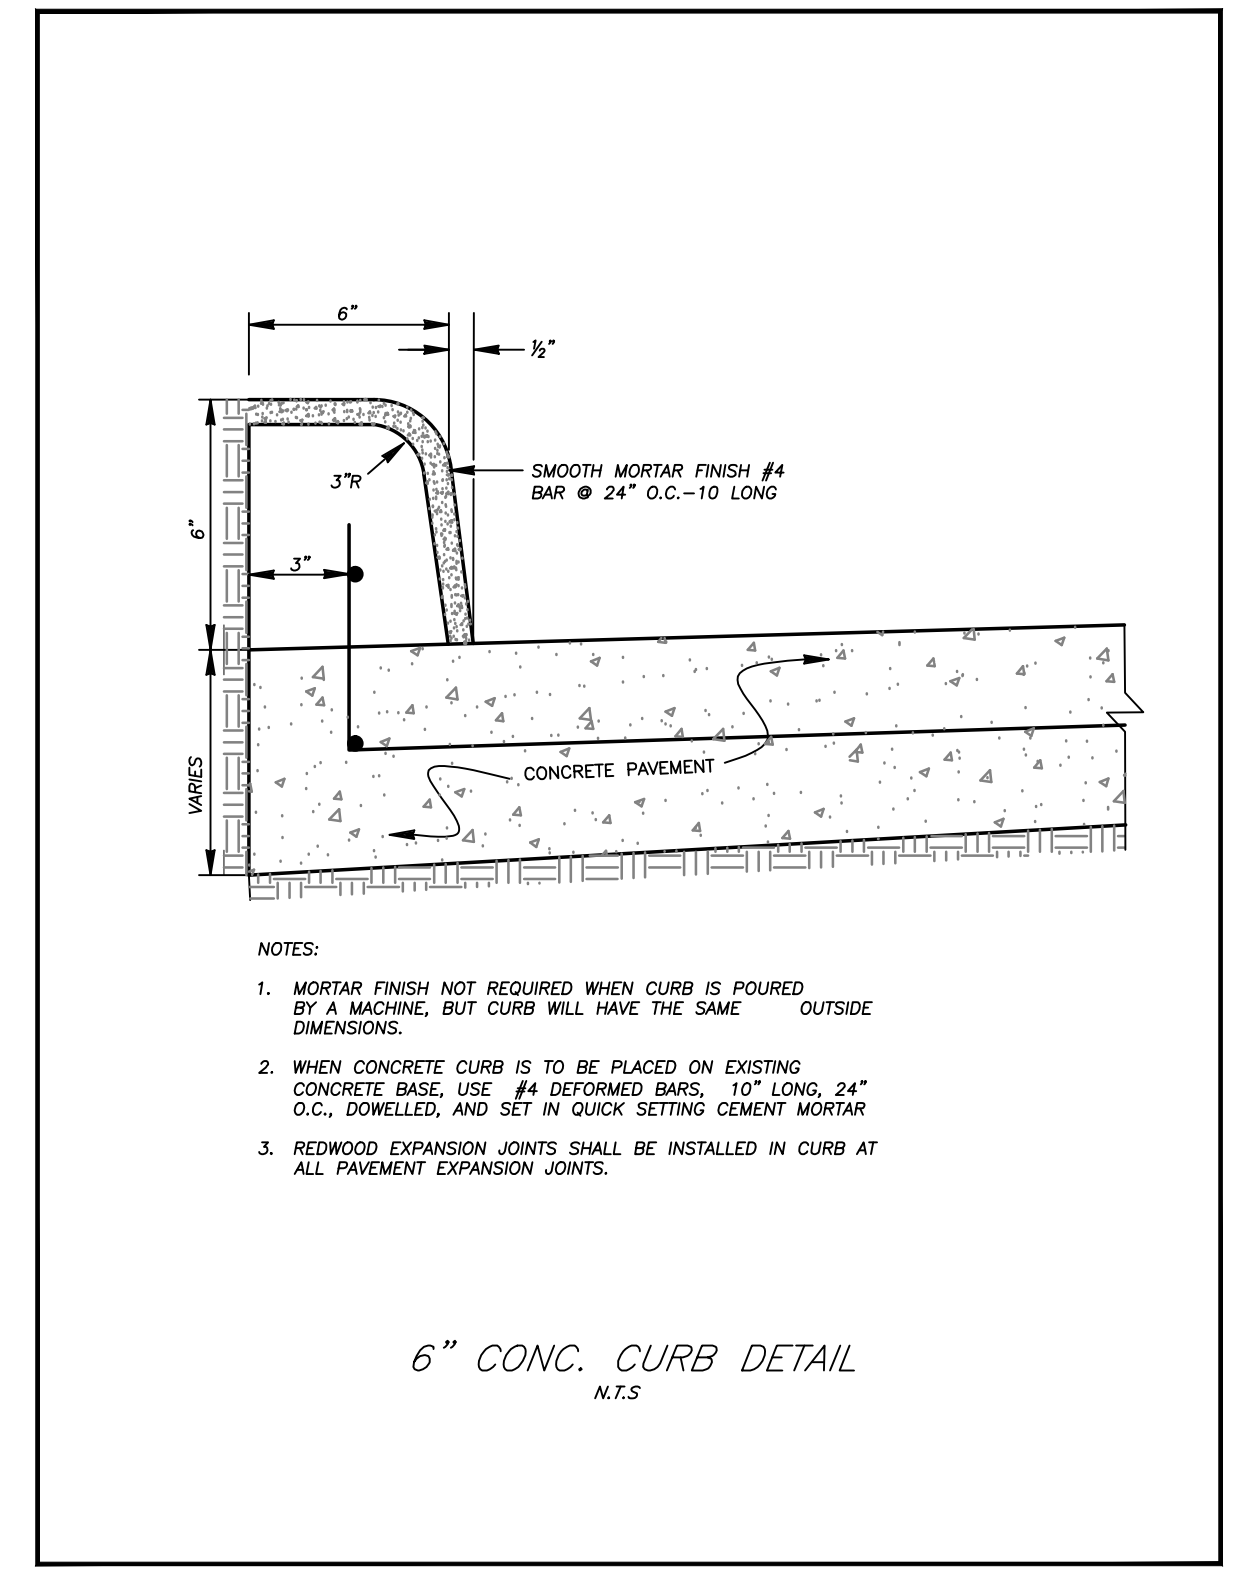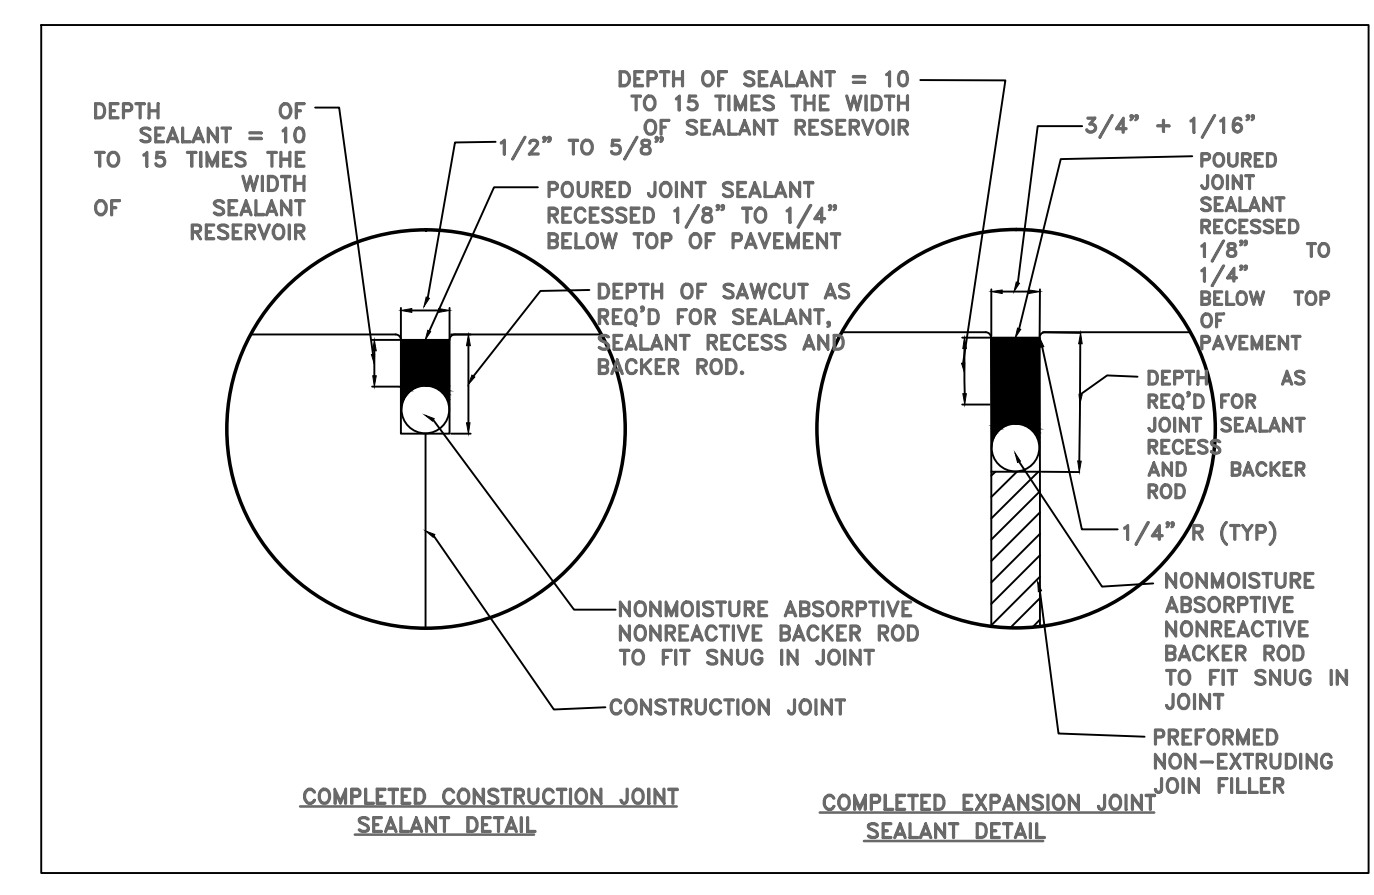

NOTES:











- MORTAR FINISH NOT REQUIRED WHEN CURB IS POURED BY A MACHINE, BUT CURB WILL HAVE THE SAME OUTSIDE DIMENSIONS.

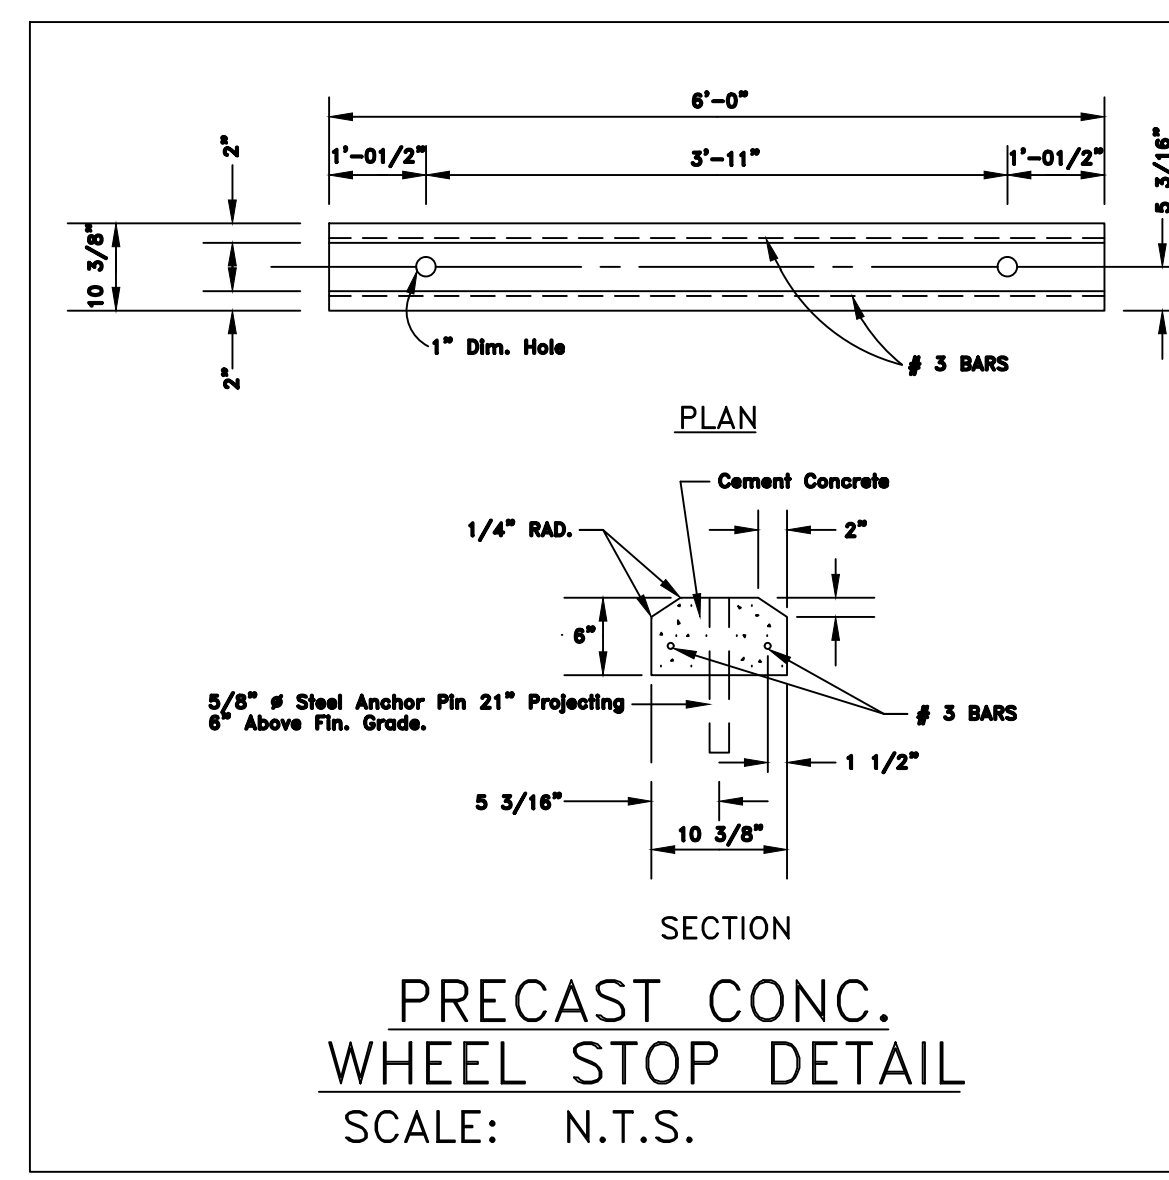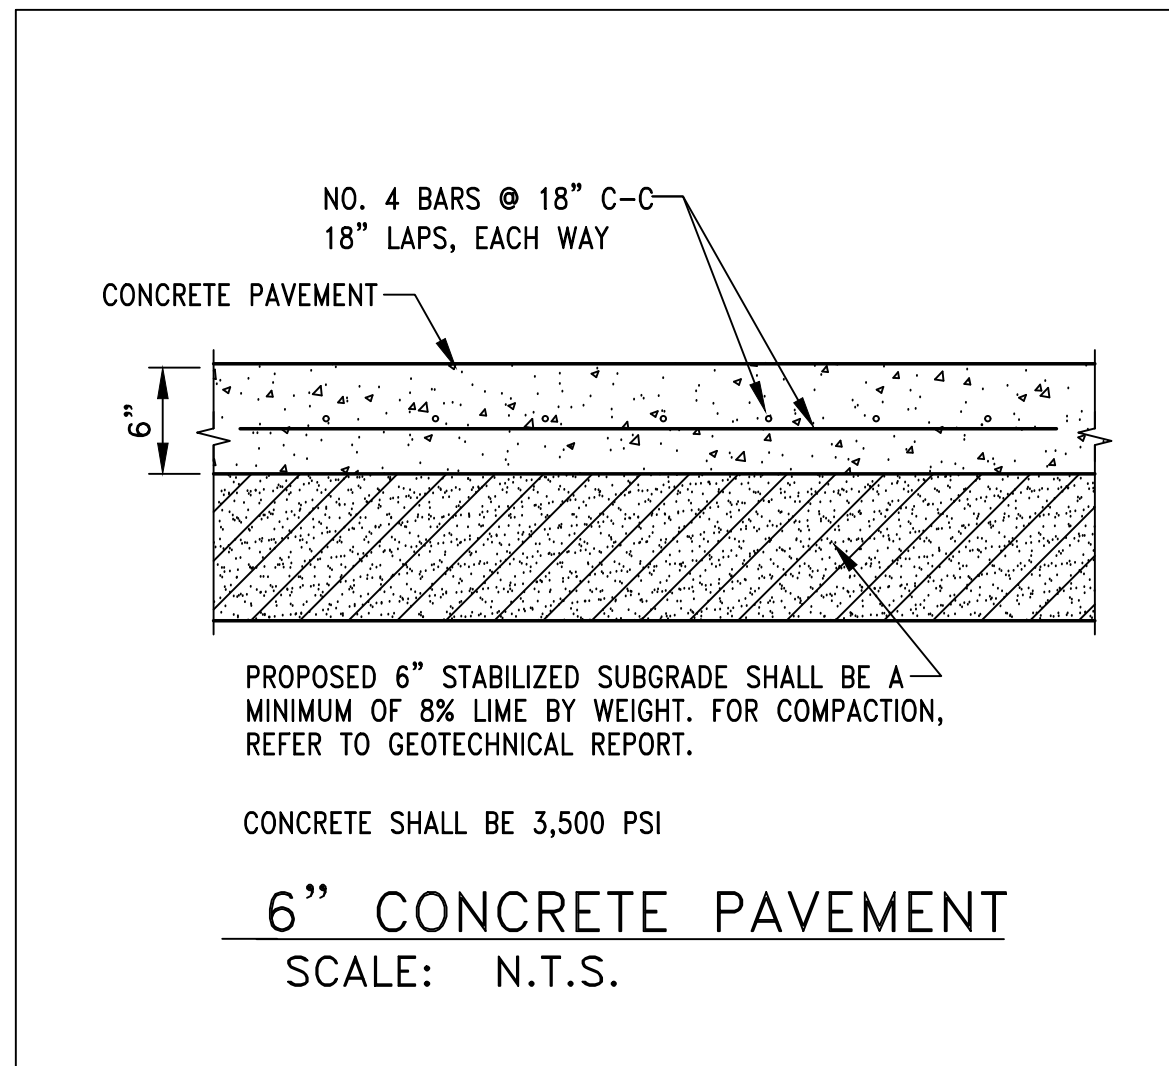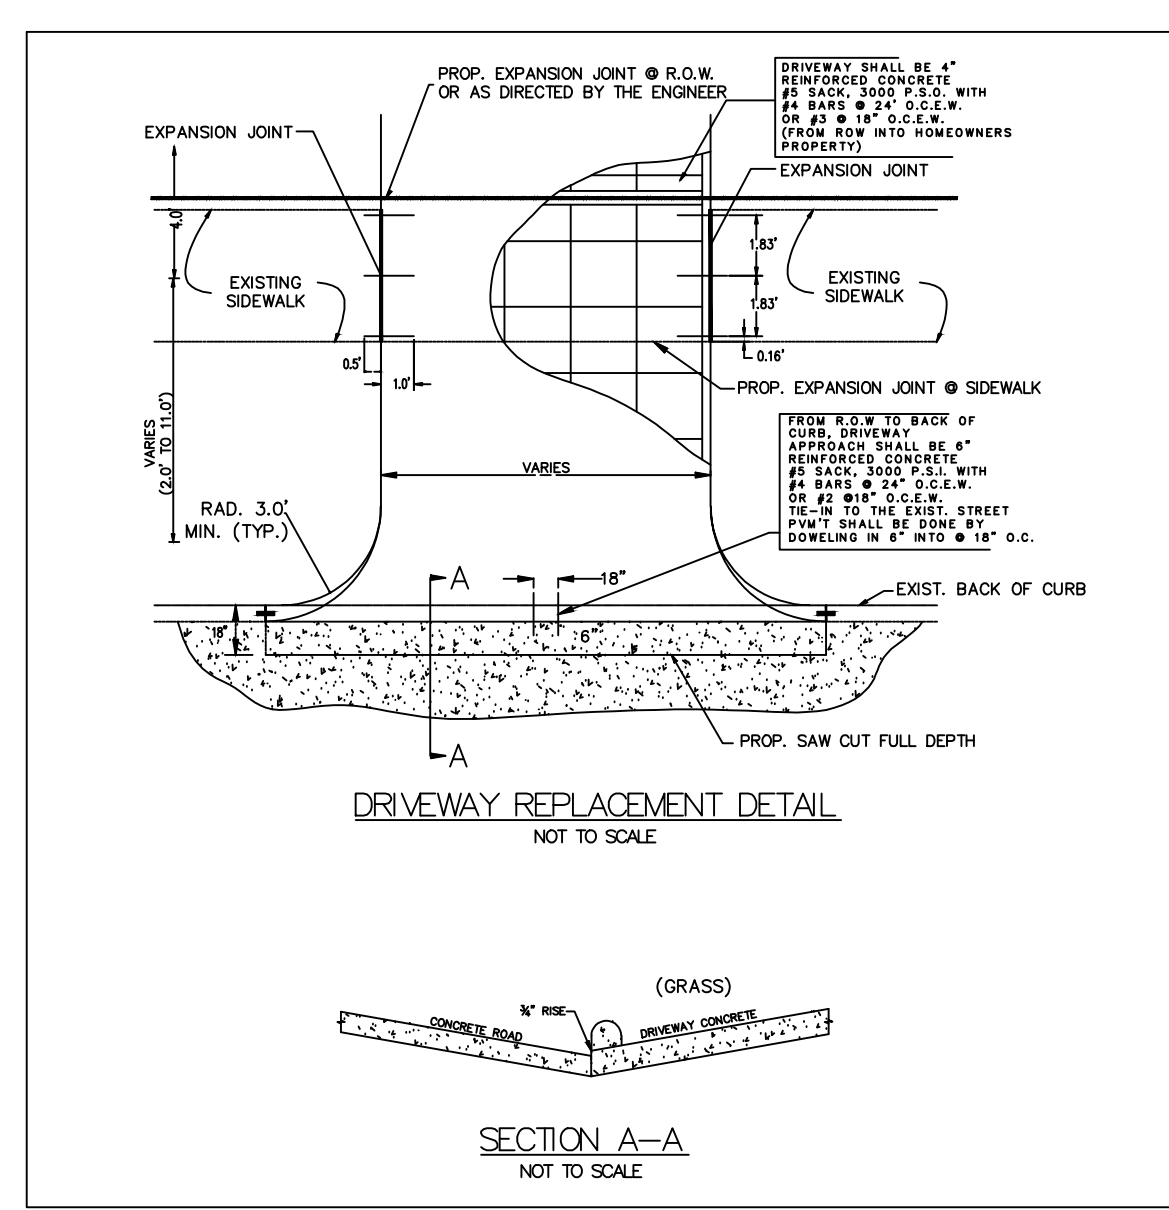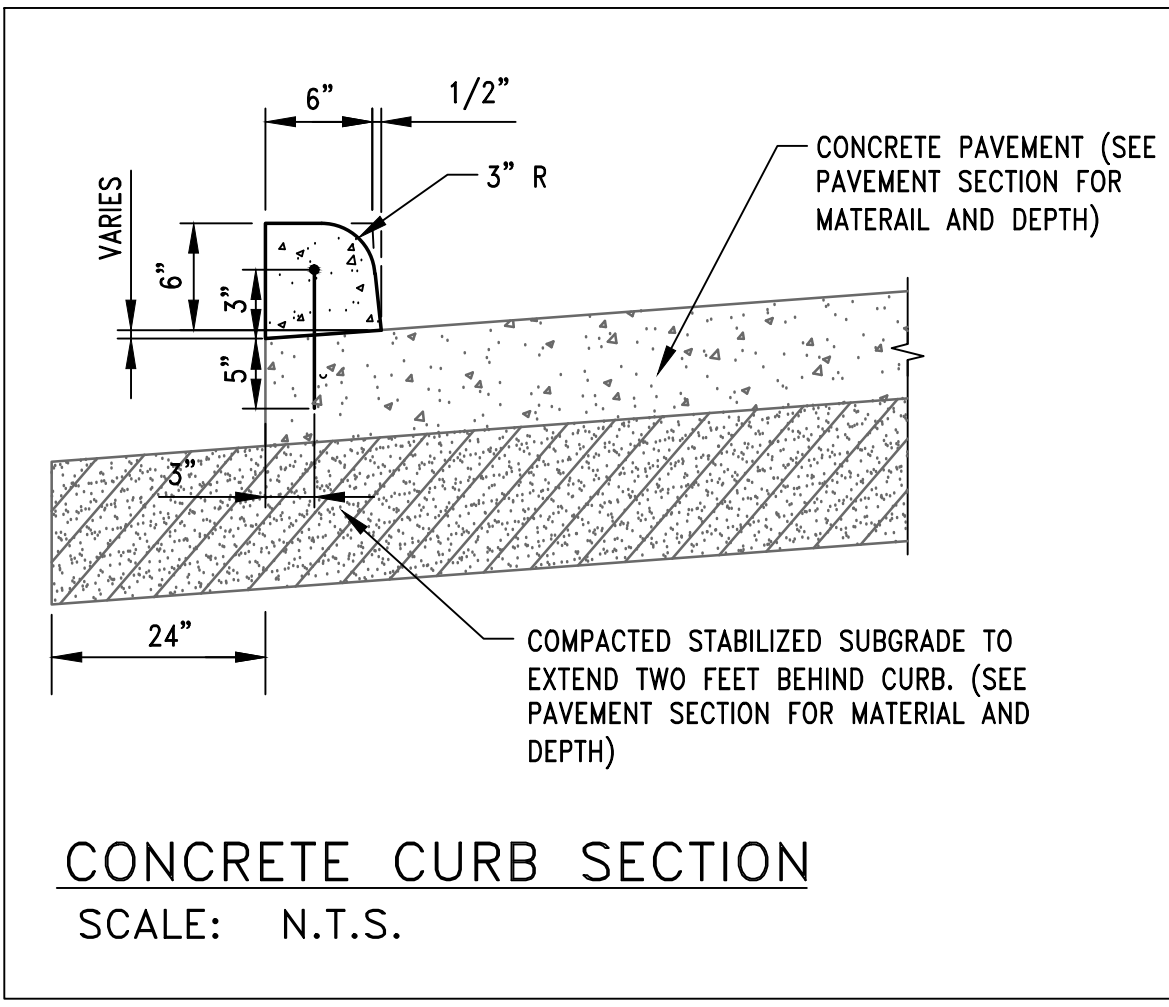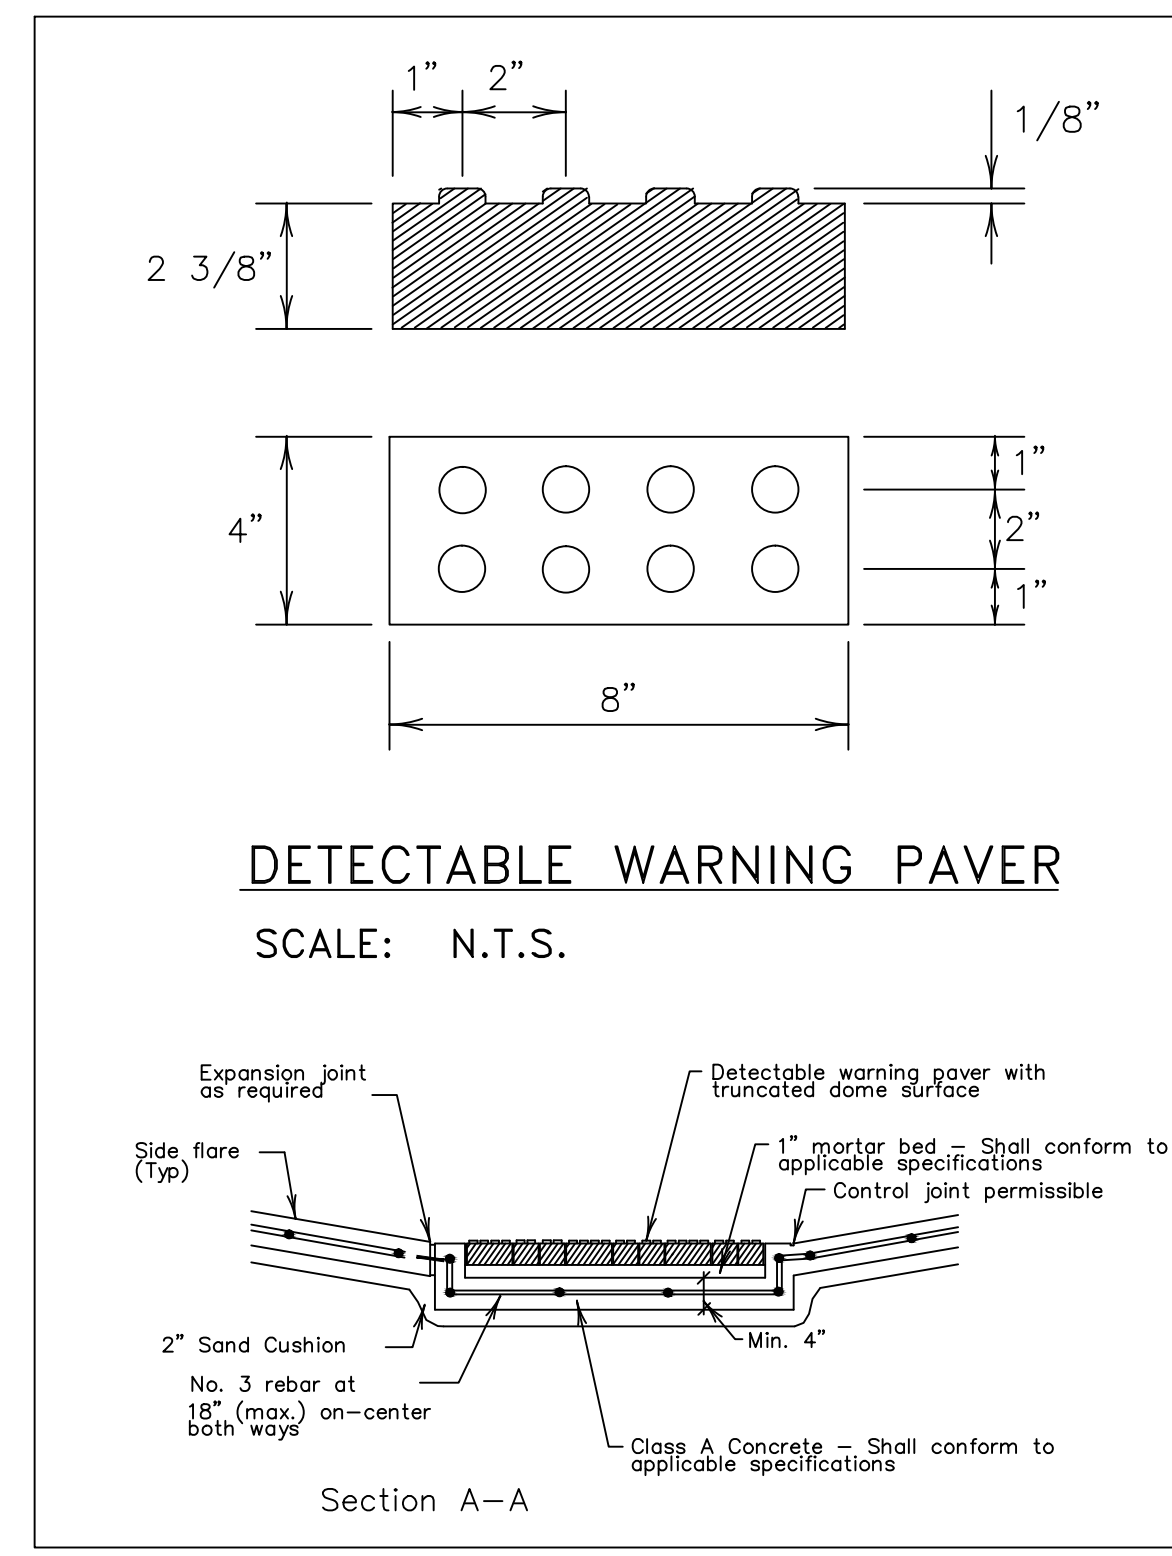

DRIVEWAY PAVEMENT CONSTRUCTION TABLE
 N.T.S.

REINFORCED CONCRETE PAVEMENT	3000 PSI MIN.
RESIDENTIAL	4" MINIMUM
COMMERCIAL	6" MINIMUM
INDUSTRIAL	8" MINIMUM
CEMENT STABILIZED SAND	2-3% C.T.
RESIDENTIAL	4" MINIMUM
COMMERCIAL	6" MINIMUM
INDUSTRIAL	8" MINIMUM

STANDARD DRIVEWAY CONSTRUCTION TABLE & NOTES
 N.T.S.

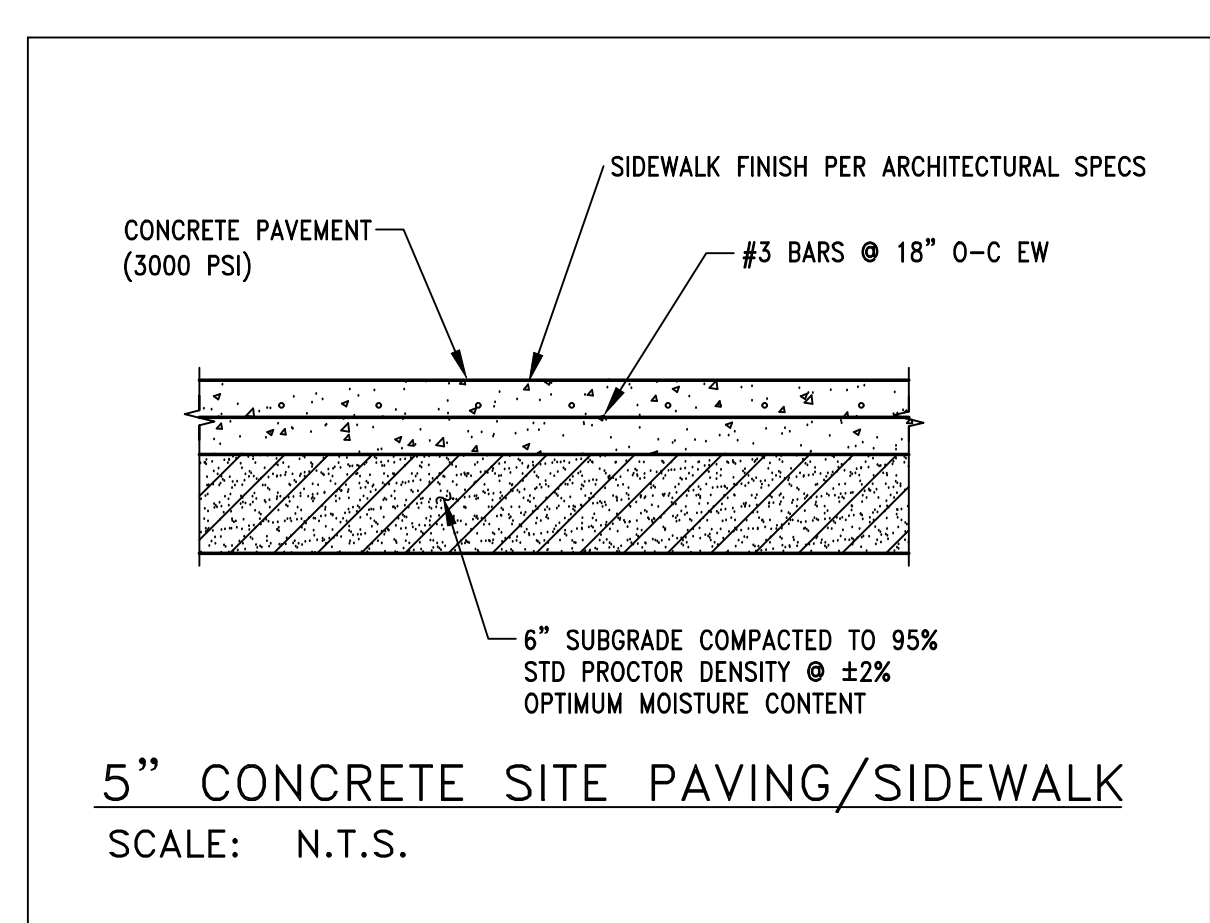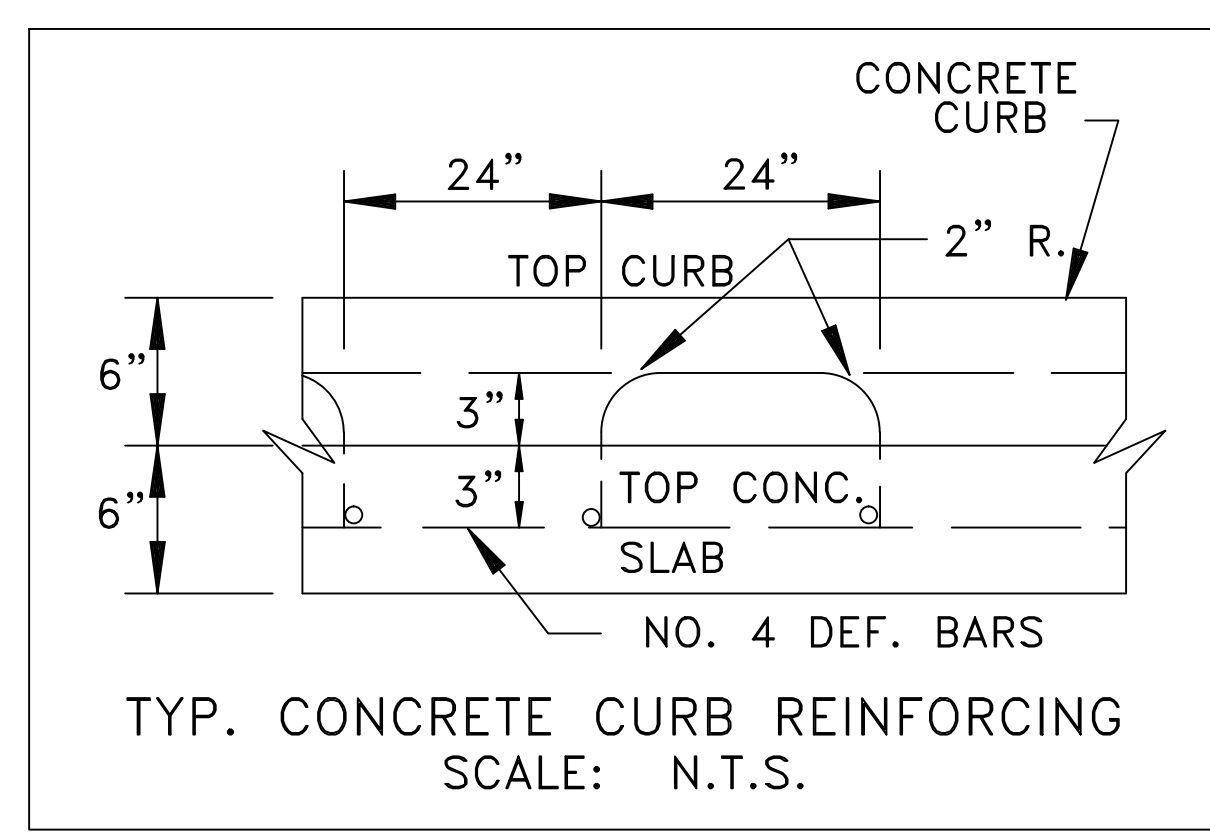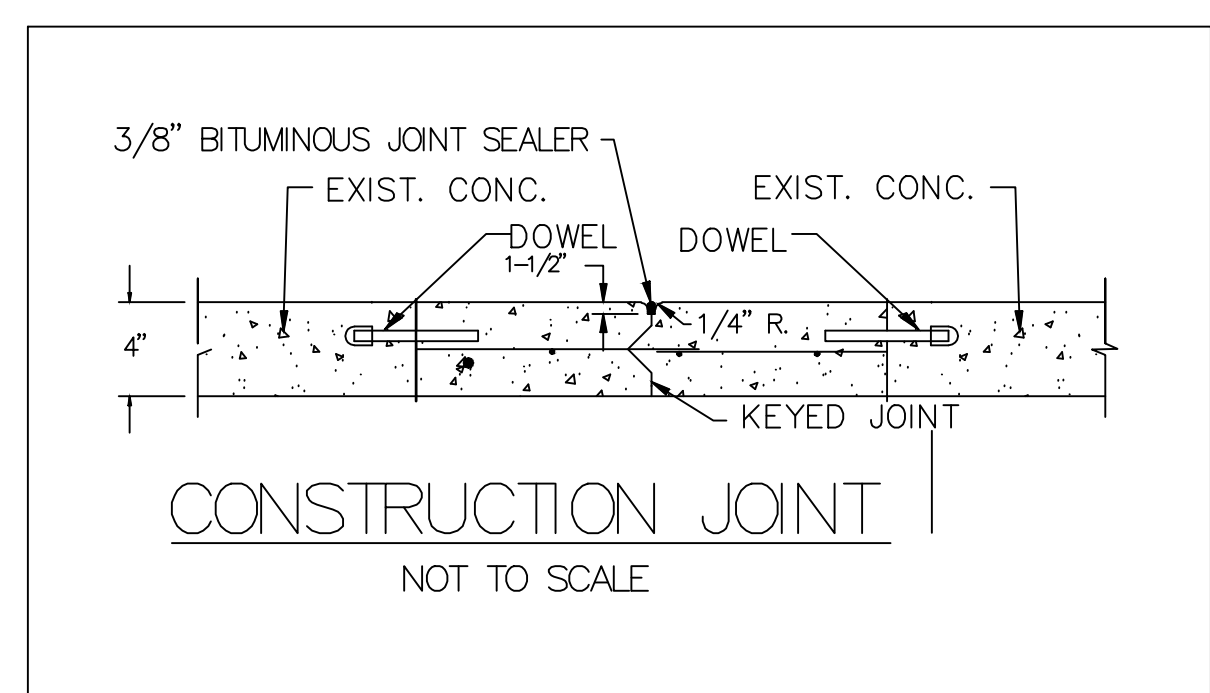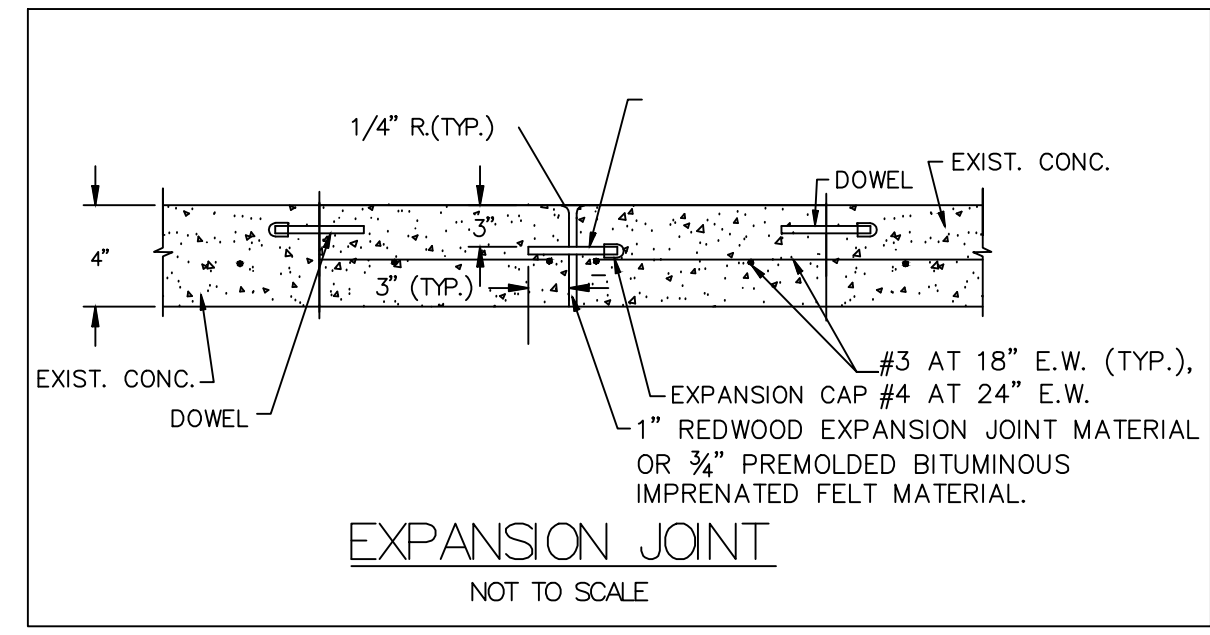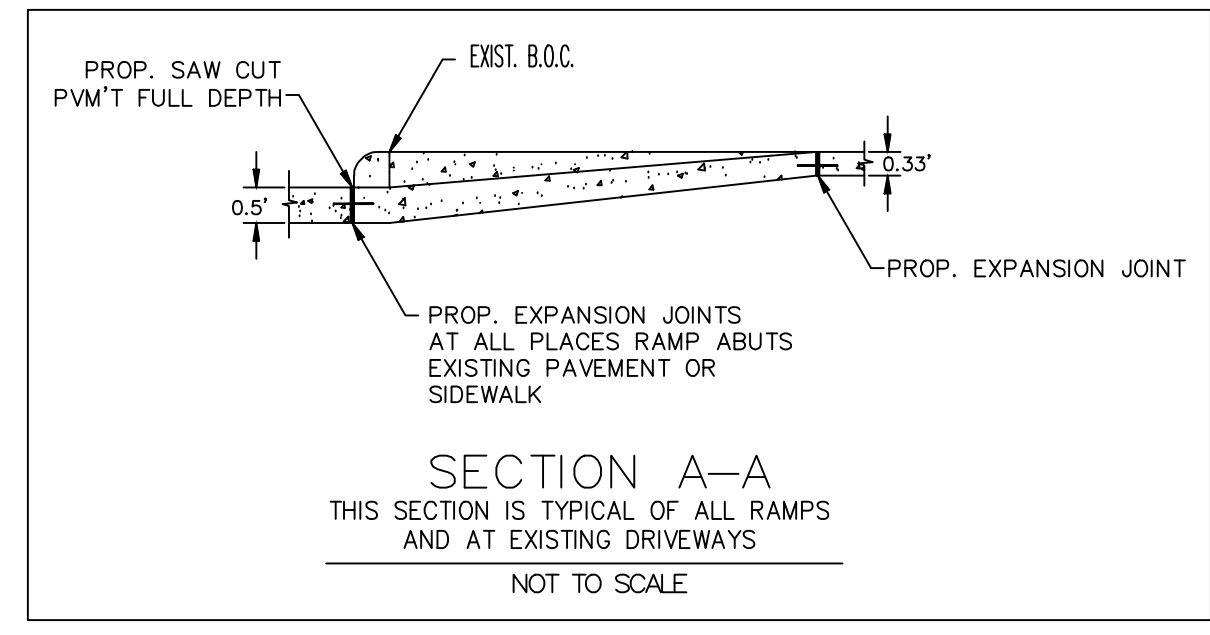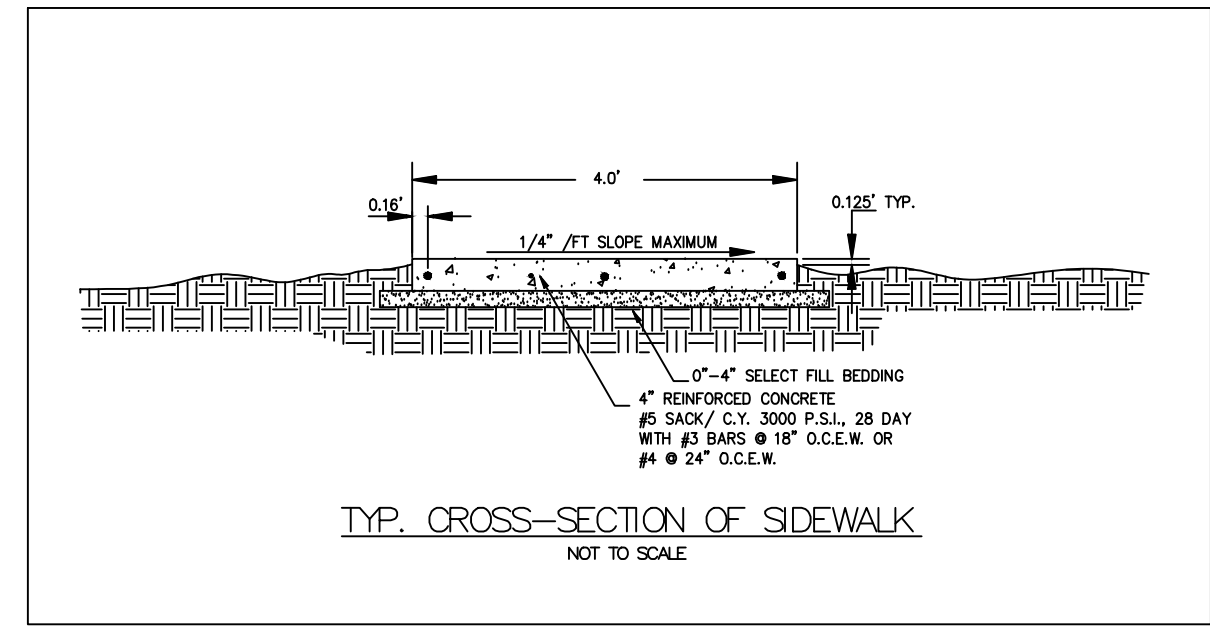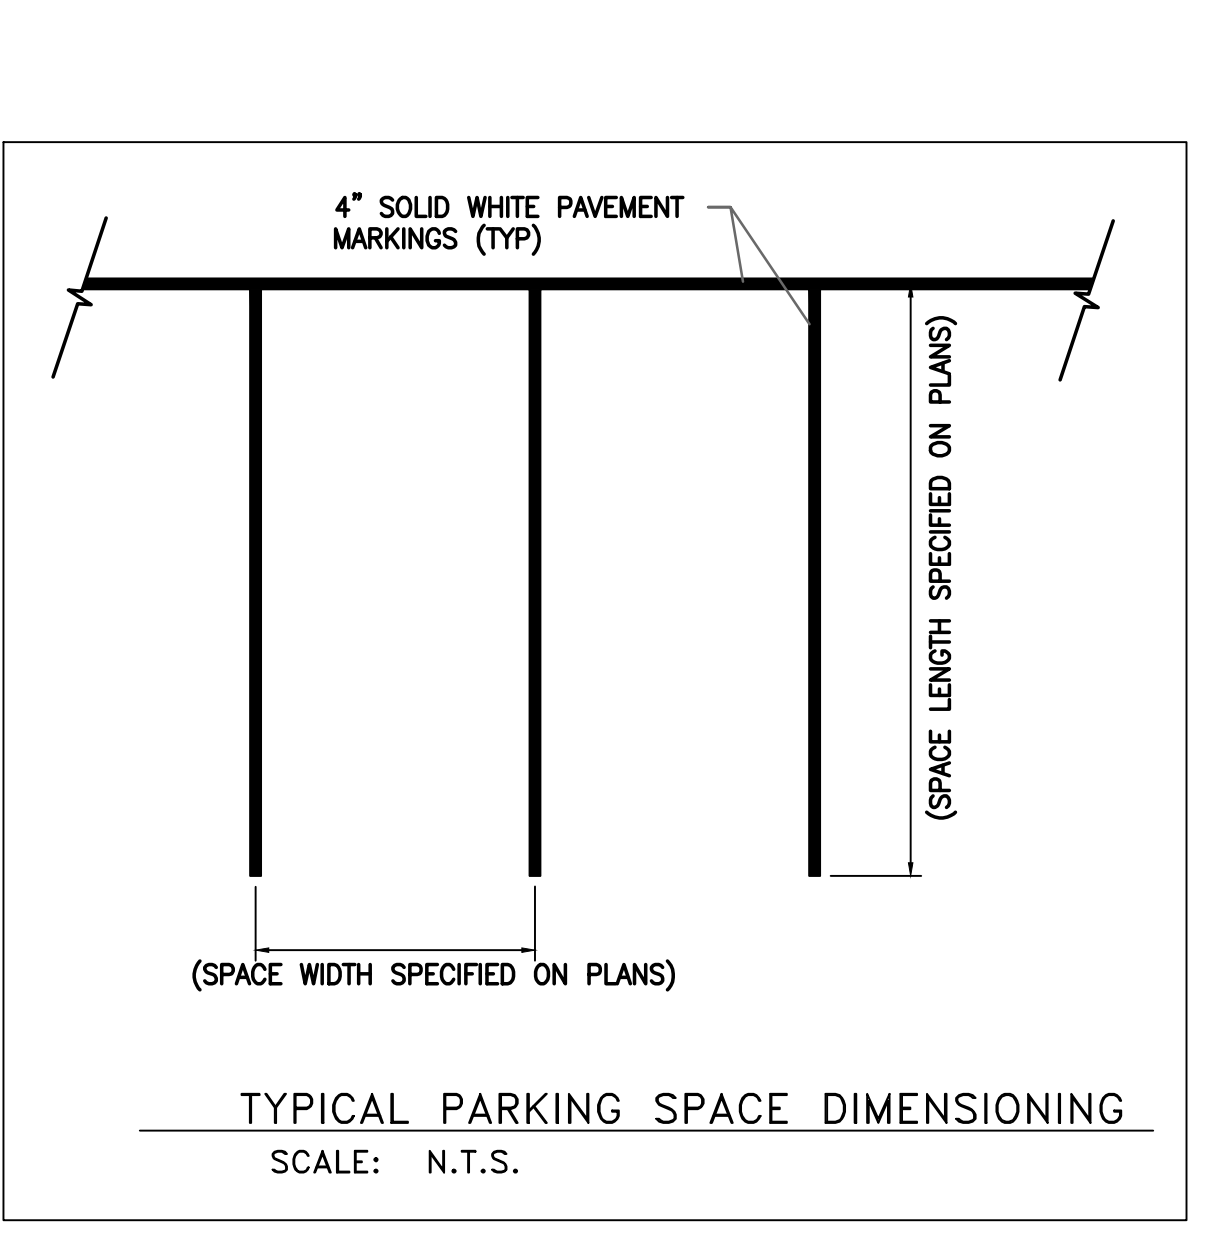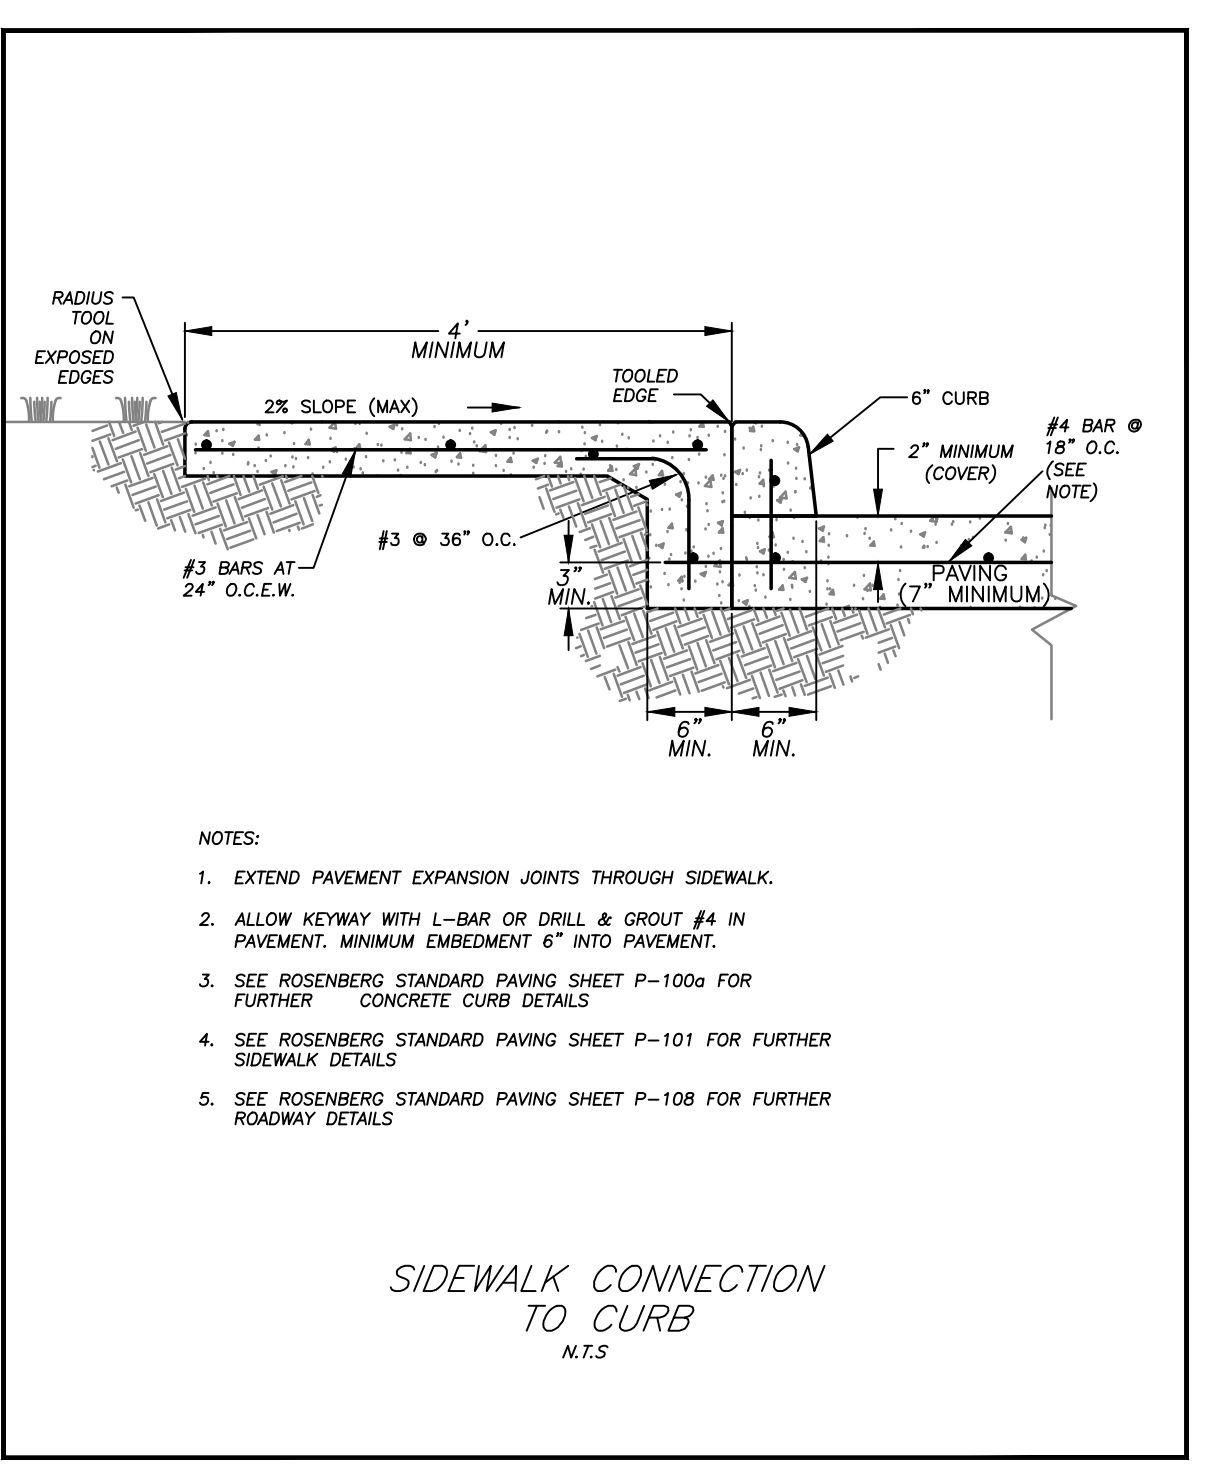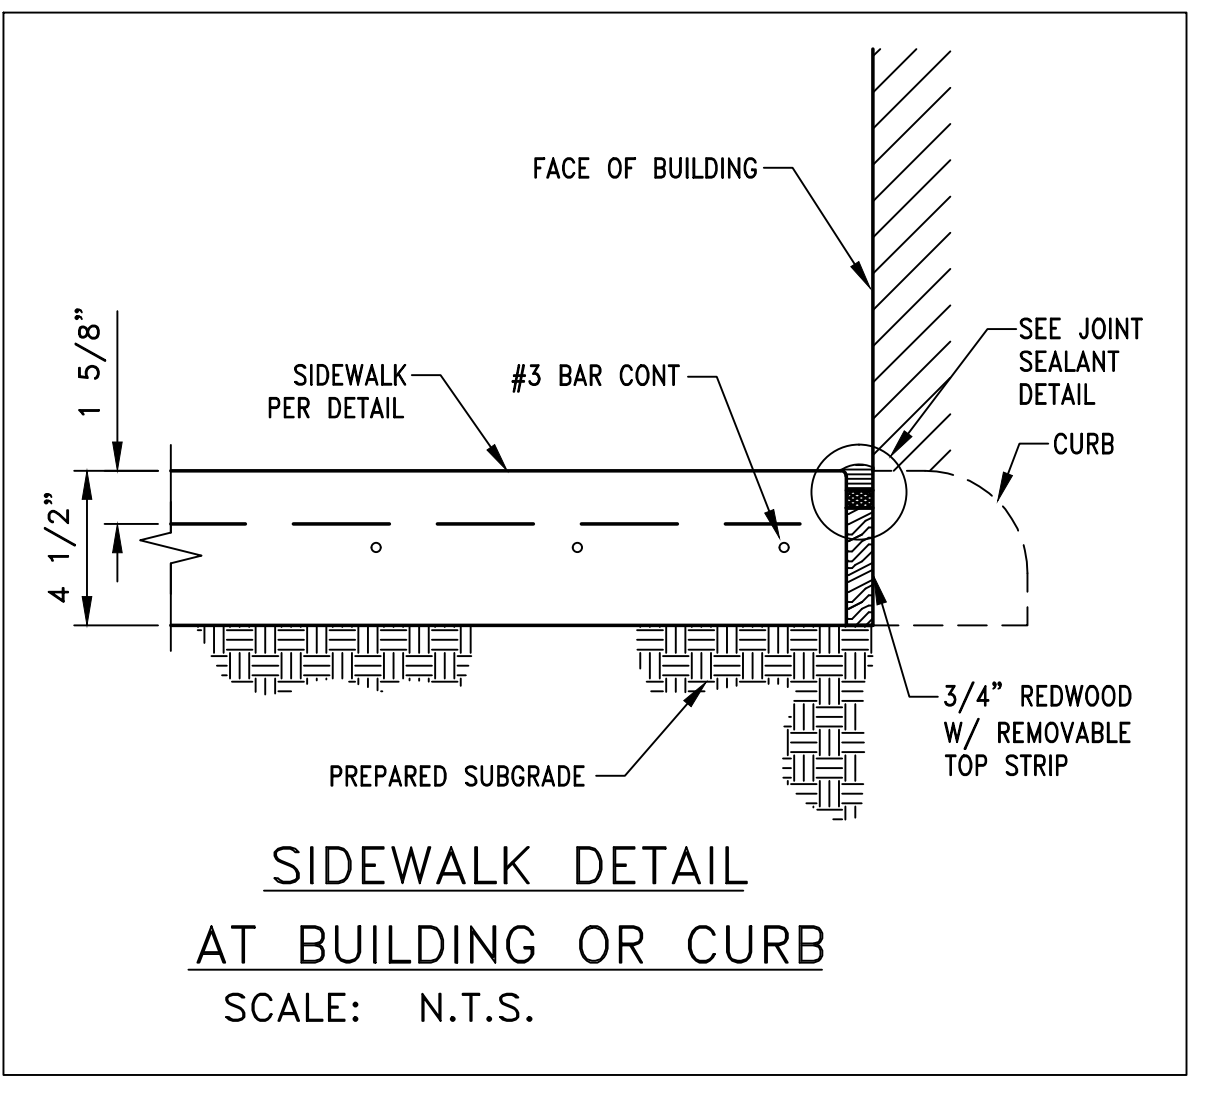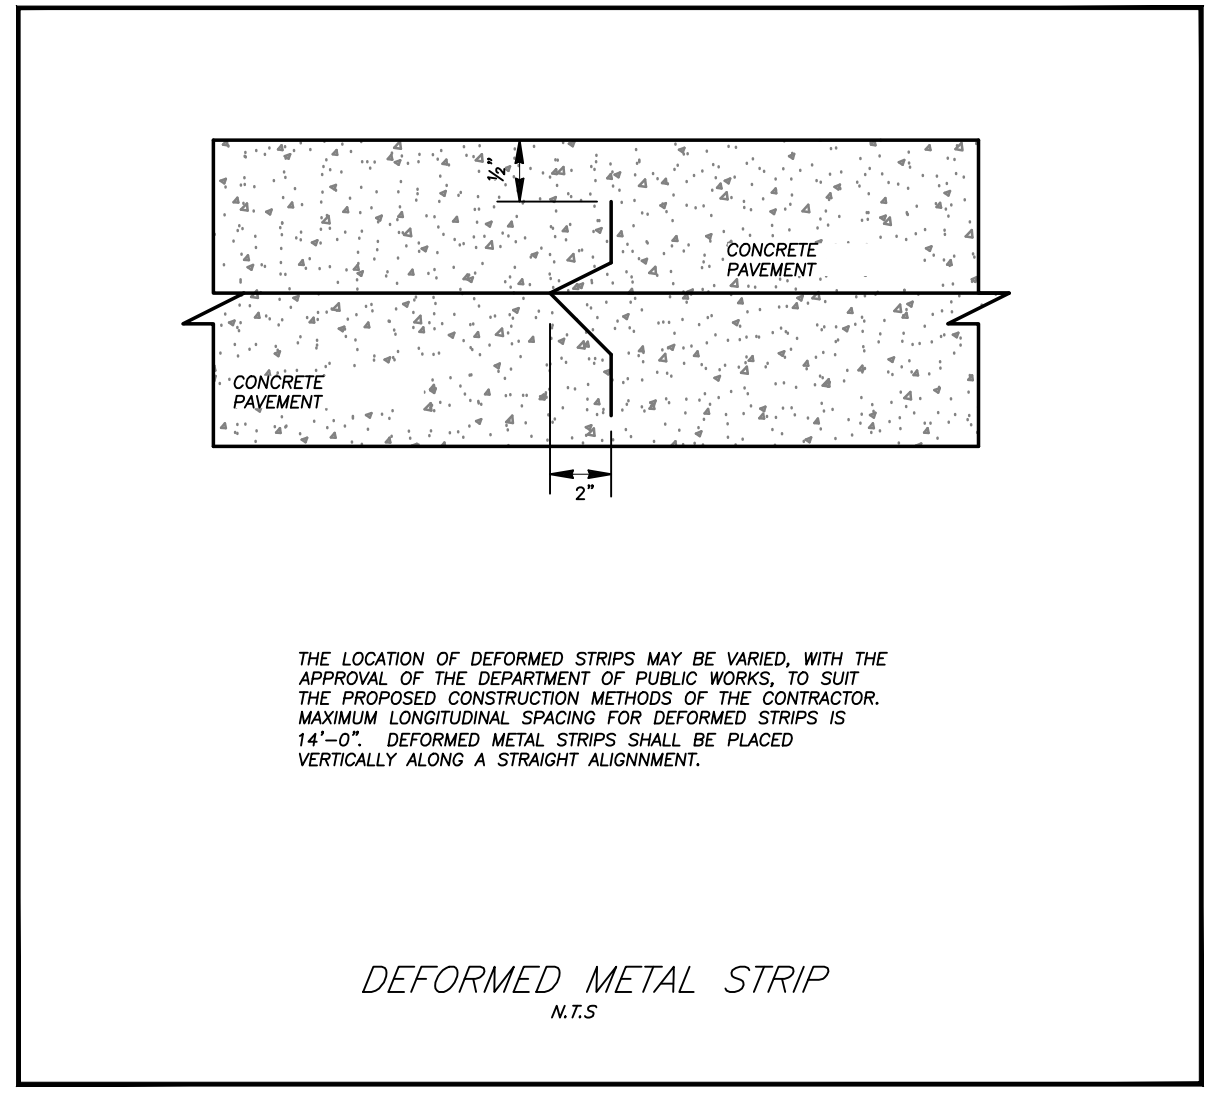

Page Sutherland Page, Inc.
1100 Louisiana, Suite One
Houston, TX 77002
page@pspi.com

TEL: 713 871 8484
FAX: 713 871 8440

ARCHITECTURE / ENGINEERING / INTERIORS / PLANNING / CONSULTING
Austin / Dallas / Denver / Dubai / Houston / Mexico City /
San Francisco / Washington DC / International Affiliate Offices

Civil Engineering
Dally & Associates
9800 Richmond Avenue
Suite 460
Houston, TX 77042
713 337 8881


MEP Engineering
Page
1100 Louisiana
Suite One
Houston, TX 77002
713 871 8484

Landscape Architecture
Knudson, LP
8588 Katy Freeway
Suite 411
Houston, TX 77024
713 463 8200

Galveston County
Road & Bridge Department Facilities PH2
5115 Texas Highway 3
Dickinson, TX

REVISION	DESCRIPTION	DATE
1	ISSUED FOR CONSTRUCTION	10-07-2020

REVISION	DESCRIPTION	DATE
2	ISSUED FOR CONSTRUCTION	10-07-2020

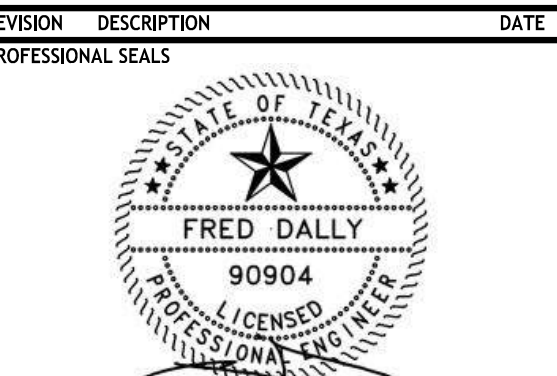

10/07/2020

STORM DRAIN DETAILS




DRAWN BY	CHECKED BY
JDM	JDM

PROJECT NUMBER	PROJECT ABBREVIATION
418198	GC-RGB

ISSUE FOR PERMIT	DATE
ISSUE FOR PERMIT	07 OCT 2020

SHEET NUMBER

C10.0-PH2

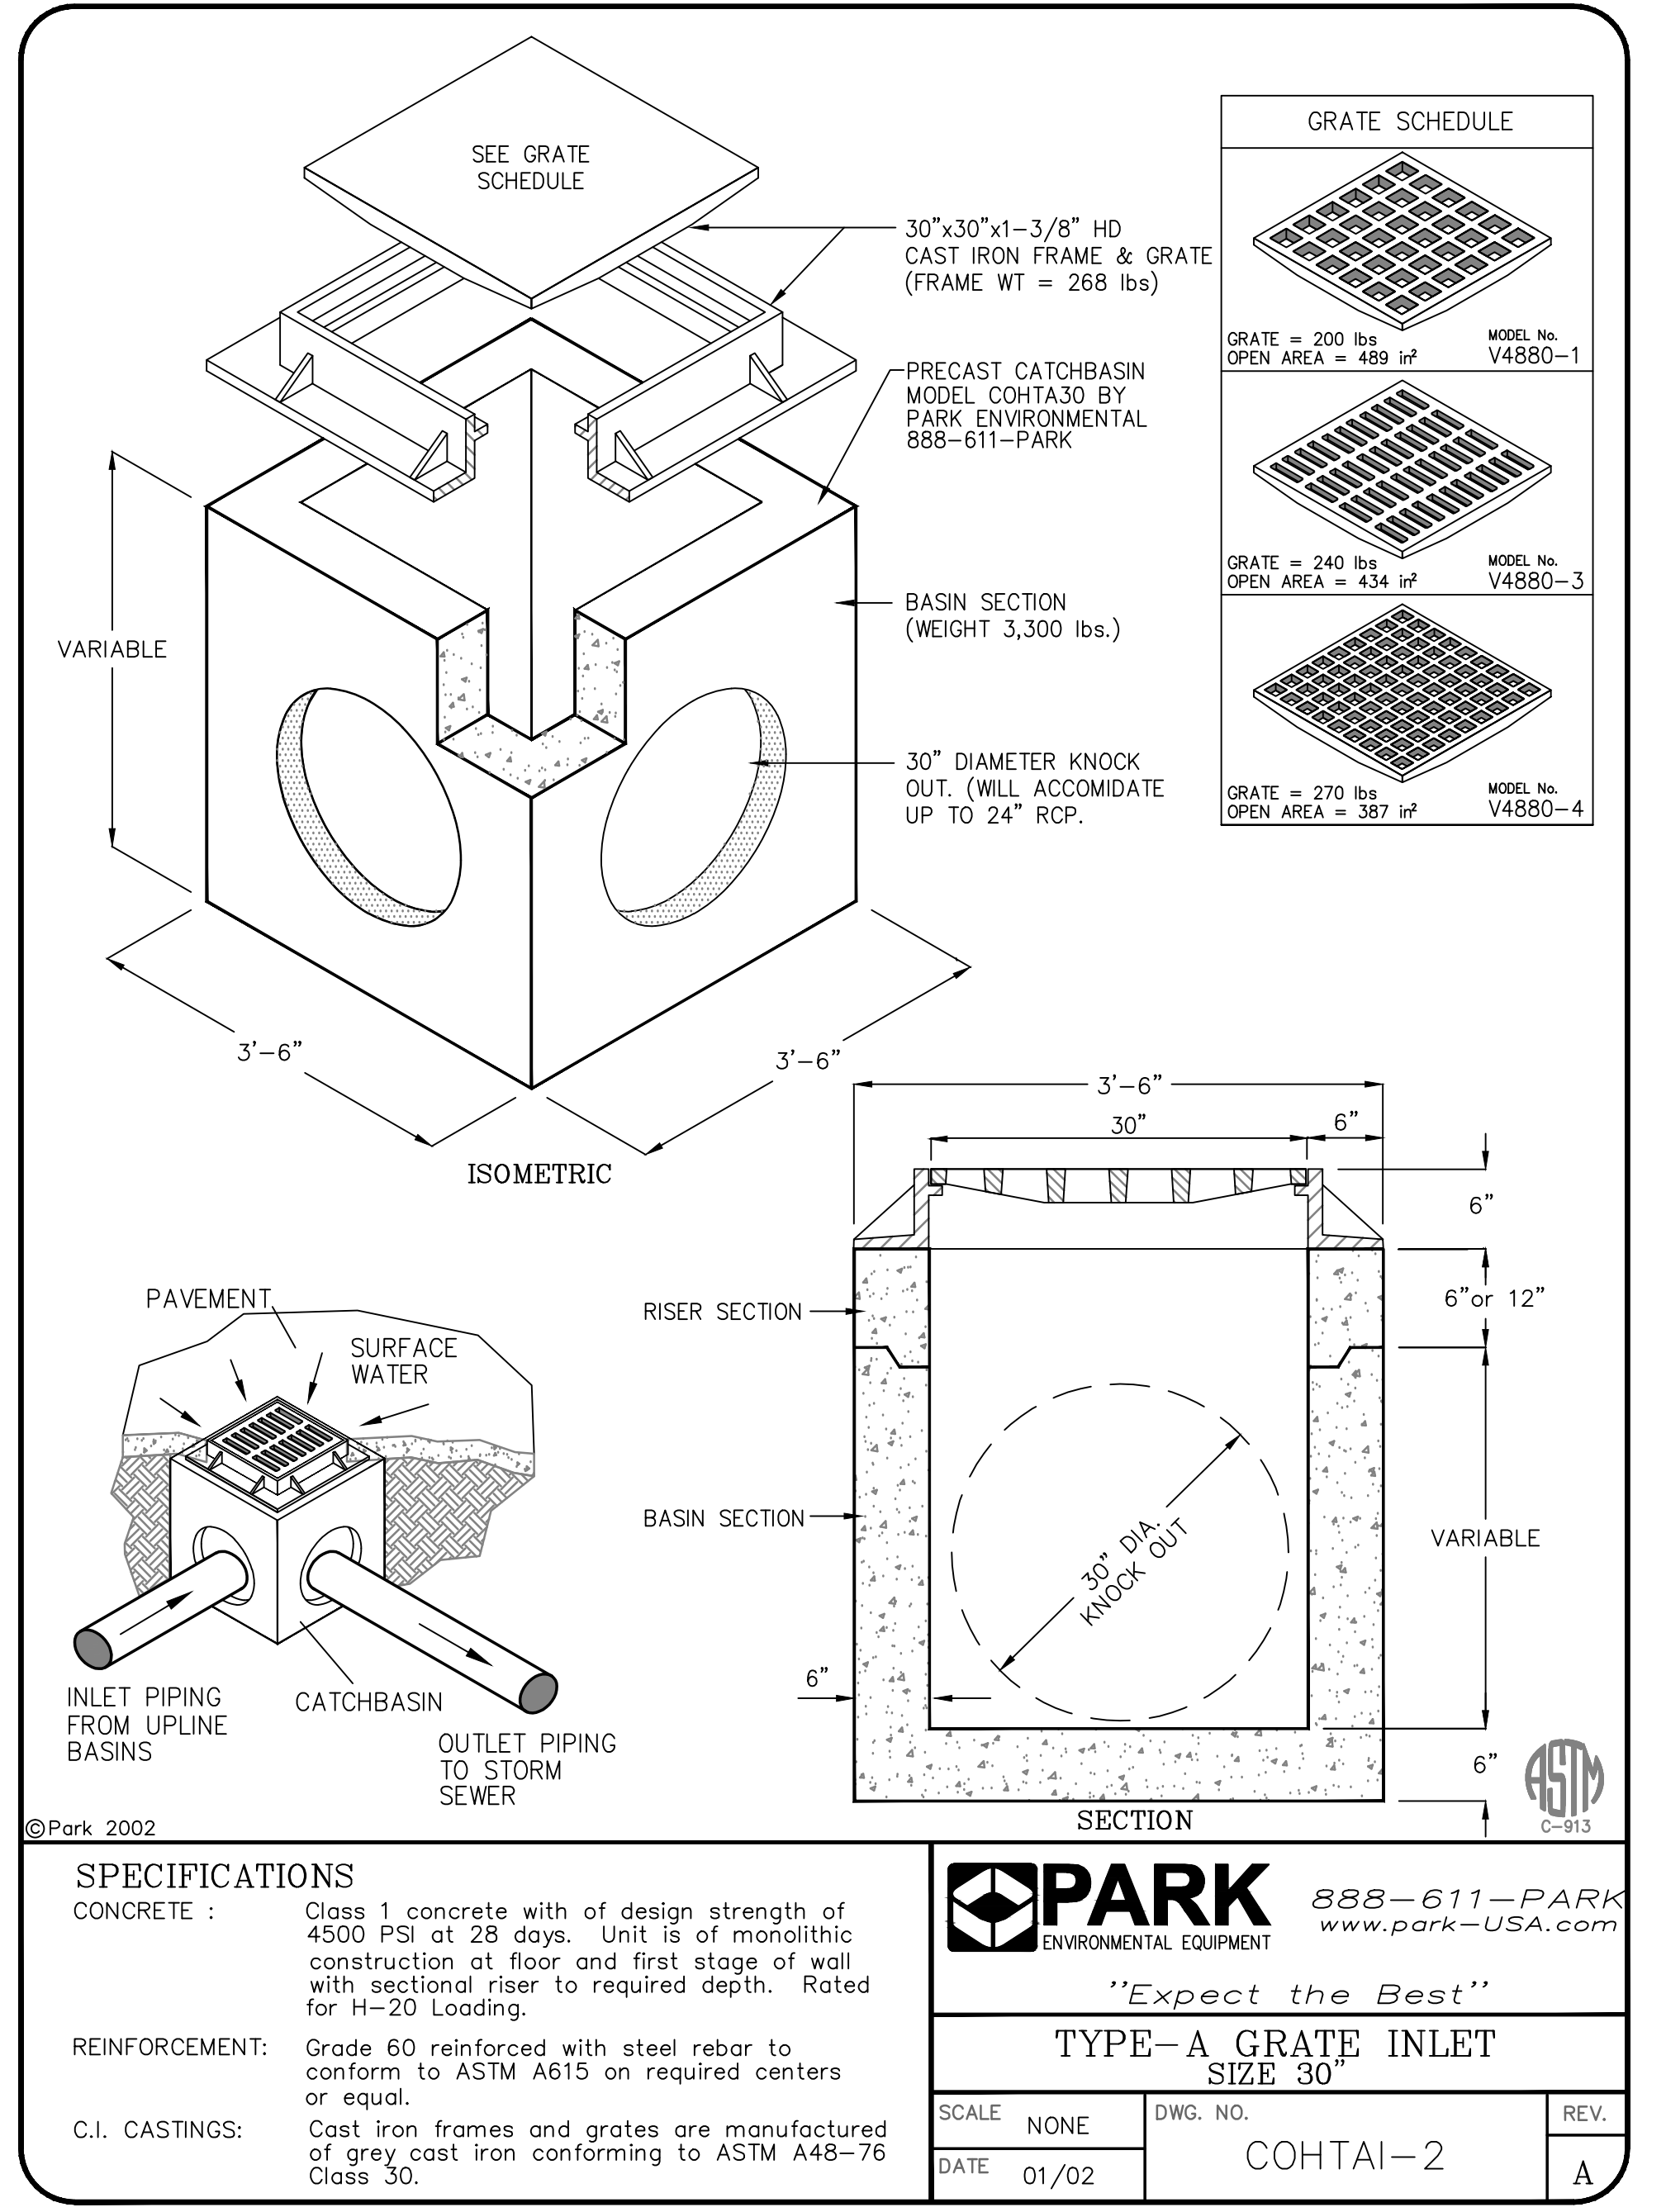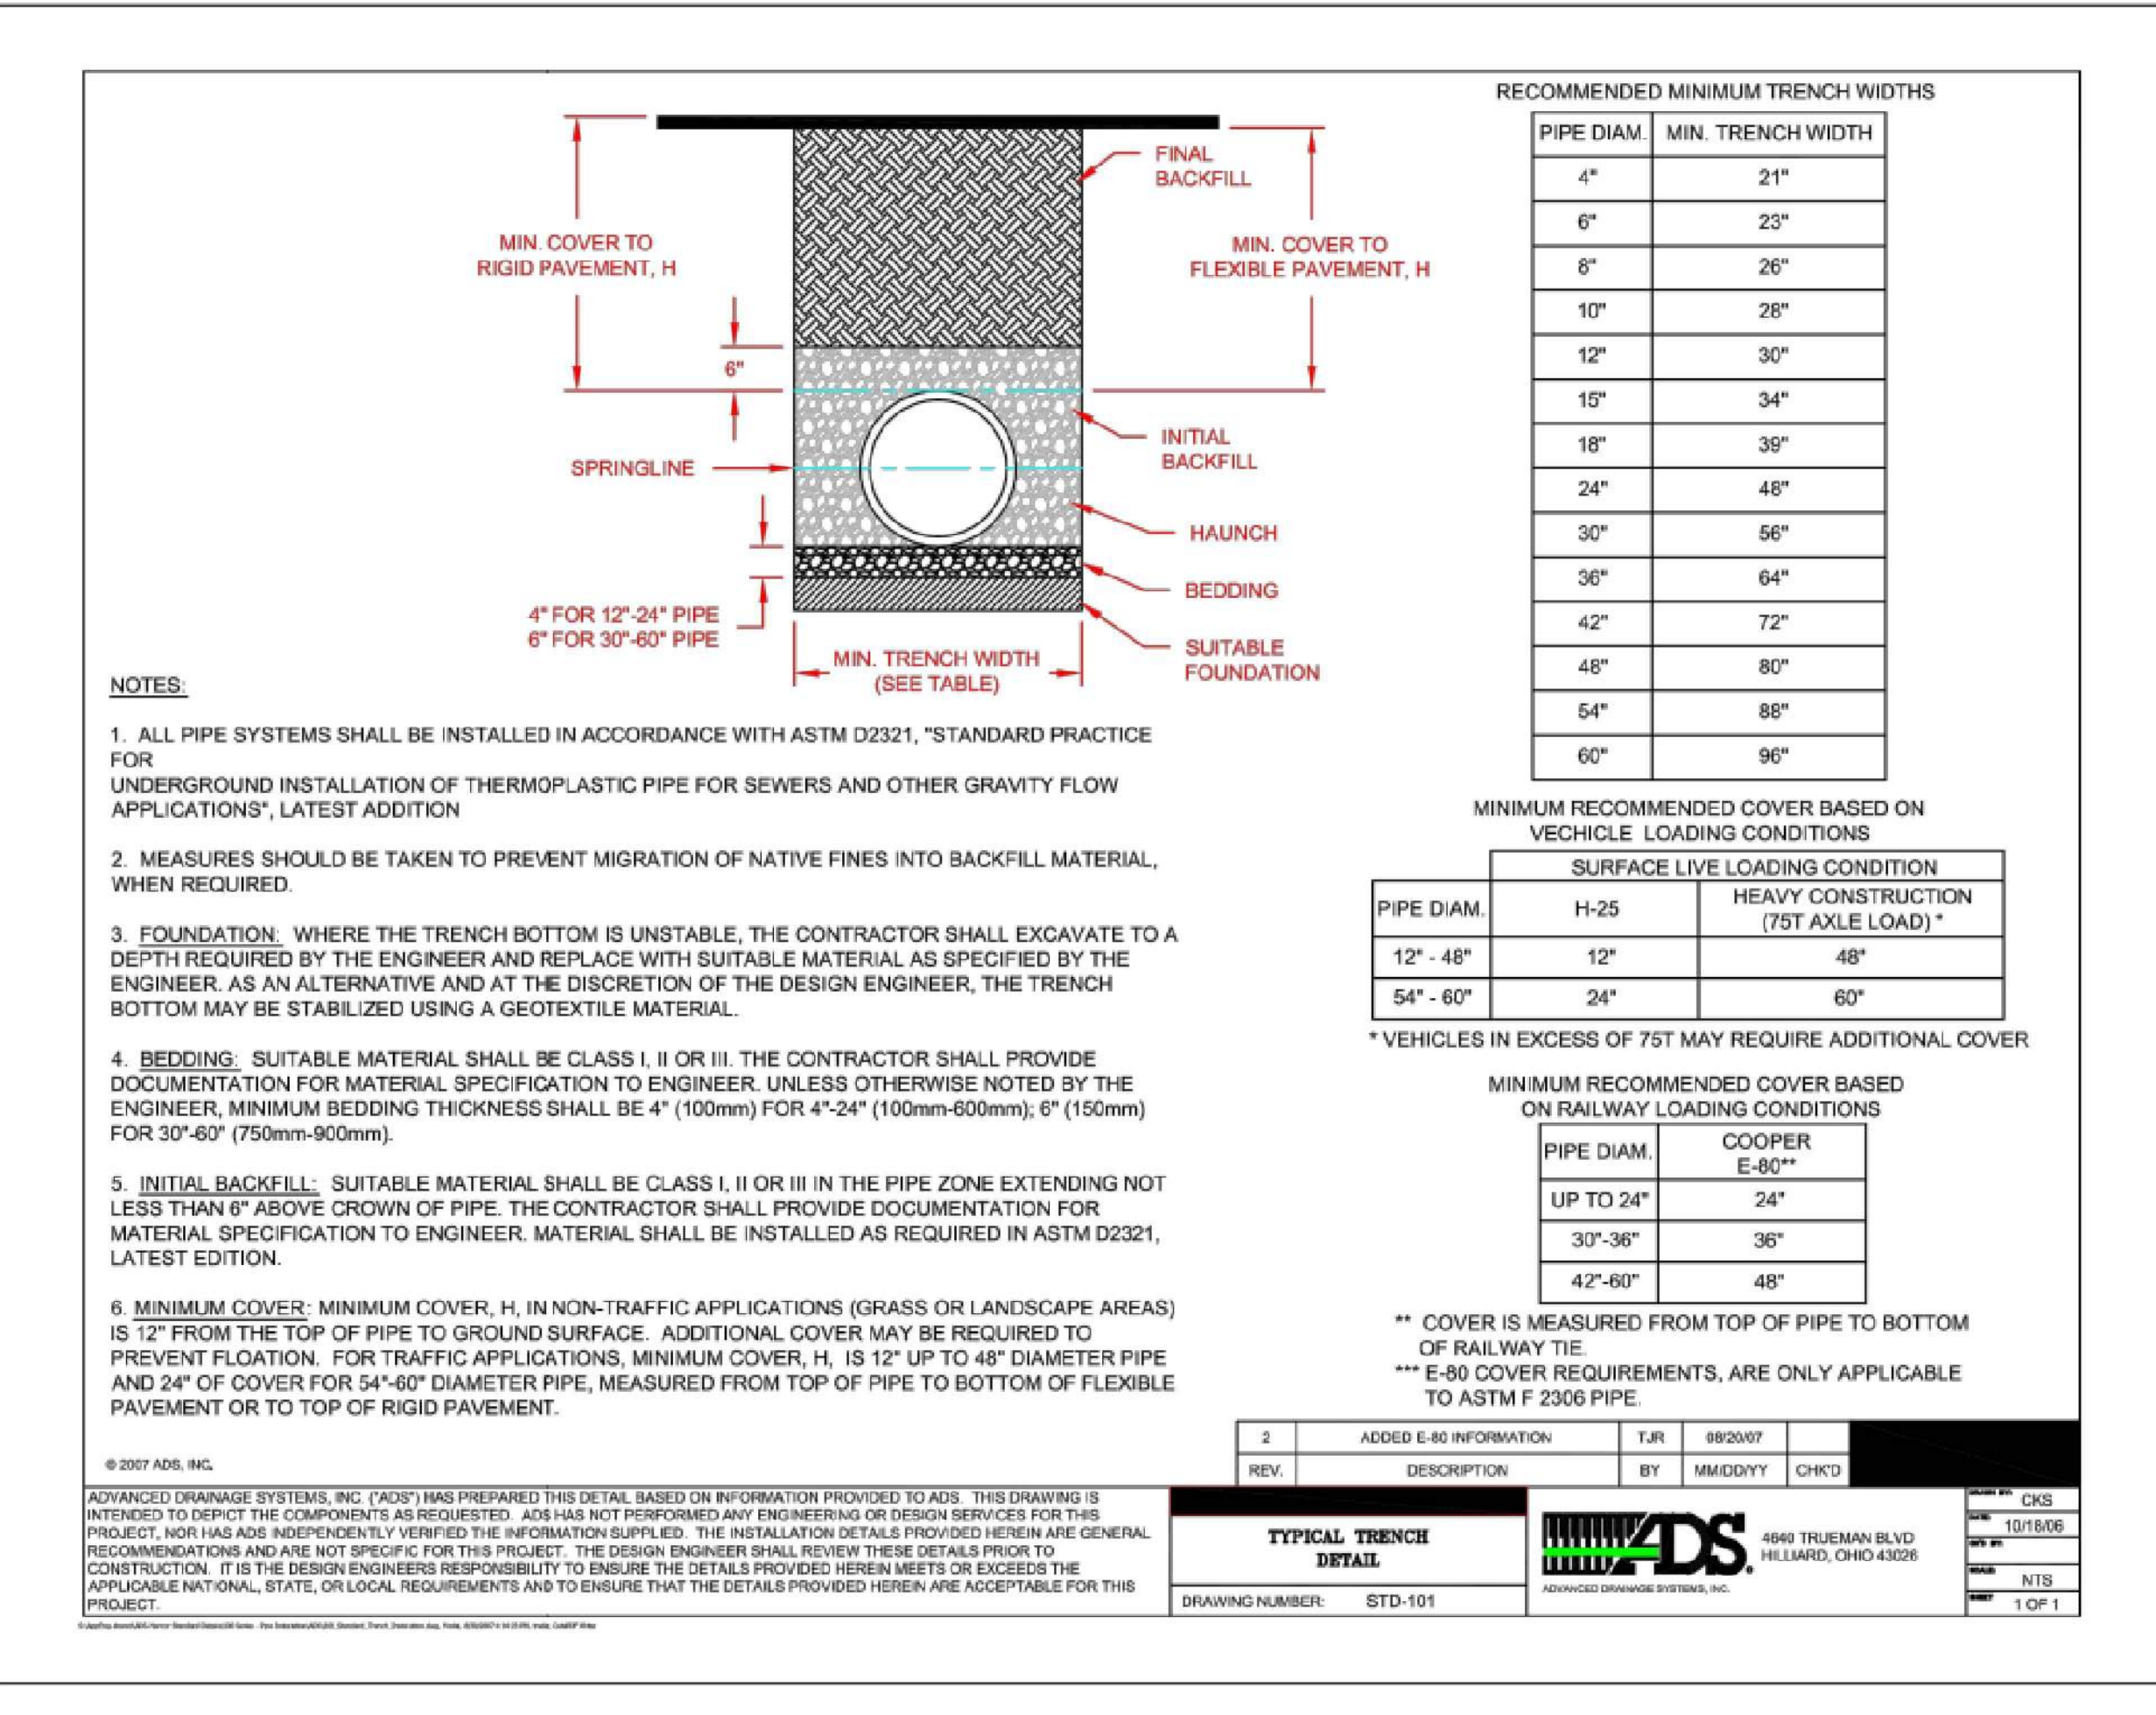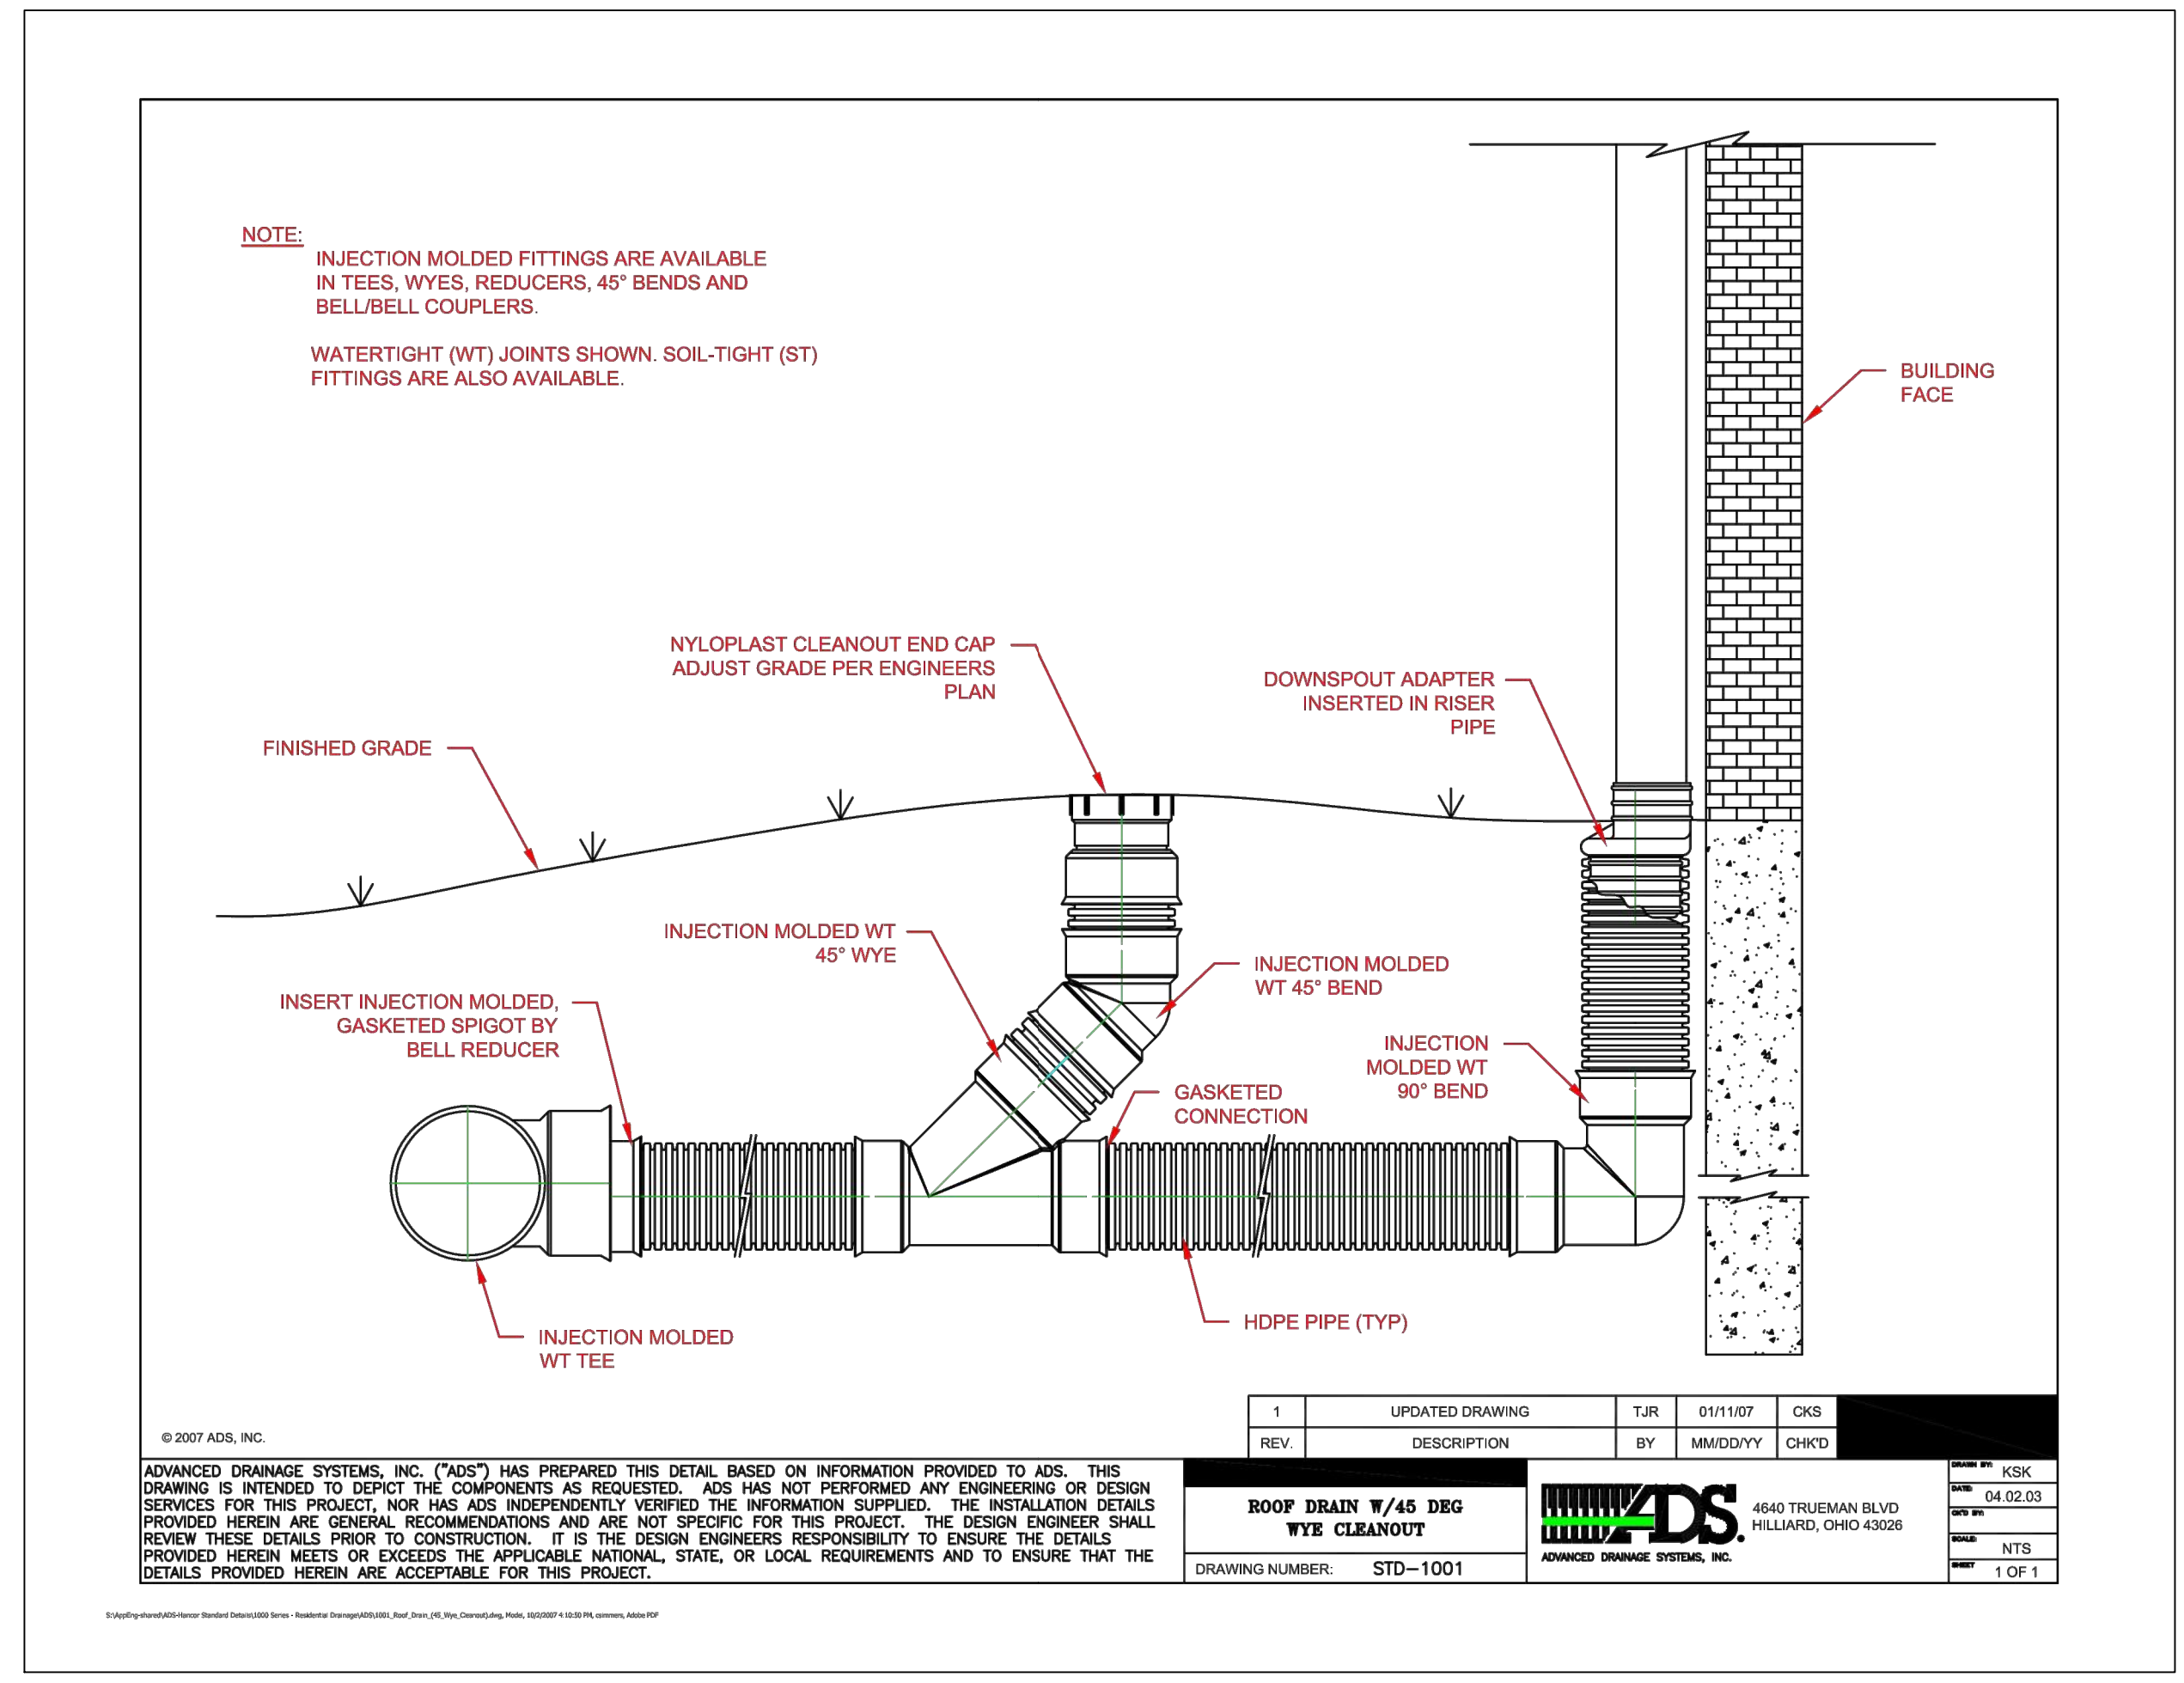

ADS N-12® ST IB PIPE (PER AASHTO) SPECIFICATION

SCOPE
This specification describes 4- through 60-inch (100 to 1500 mm) ADS N-12 ST IB pipe (per AASHTO) for use in gravity flow drainage applications.

PIPE REQUIREMENTS
N-12 ST IB pipe (per AASHTO) shall have a smooth interior and annular exterior corrugations.
• 4- through 10-inch (100 to 250 mm) shall meet AASHTO M252, Type S
• 12- through 60-inch (300 to 1500 mm) shall meet AASHTO M294, Type S or ASTM F2306
• Manning's "n" value for use in design shall be 0.012

JOINT PERFORMANCE
Pipe shall be joined using a bell-and-spigot joint meeting AASHTO M252, AASHTO M294, or ASTM F2306. The joint shall be soil-tight and gaskets, when applicable, shall meet the requirements of ASTM F477. Gaskets will be installed by the pipe manufacturer and covered with a removable wrap to ensure the gasket is free from debris. A joint lubricant supplied by the manufacturer shall be used on the gasket and bell during assembly.

FITTINGS
Fittings shall conform to AASHTO M252, AASHTO M294 or ASTM F2306. Bell and spigot connections shall utilize a spun-on or welded bell and valley or saddle gasket meeting the soil-tight joint performance requirements of AASHTO M252, AASHTO M294 or ASTM F2306.

MATERIAL PROPERTIES
Virgin material for pipe and fitting production shall be high-density polyethylene conforming with the minimum requirements of cell classification 424420C for 4- through 10-inch (100 to 250 mm) diameters, or 435400C for 12- through 60-inch (300 to 1500 mm) diameters, as defined and described in the latest version of ASTM D3350, except that carbon black content should not exceed 4%. The 12- through 60-inch (300 to 1500 mm) virgin pipe material shall comply with the notched constant ligament-stress (NCLS) test as specified in Sections 9.5 and 5.1 of AASHTO M294 and ASTM F2306, respectively.

INSTALLATION
Installation shall be in accordance with ASTM D2321 and ADS published installation guidelines, with the exception that minimum cover in trafficked areas for 4- through 48-inch (100 to 1200 mm) diameters shall be one foot (0.3 m) and for 54- and 60-inch (1350-1500 mm) diameters, the minimum cover shall be 2 feet (0.6 m) in single run applications. Backfill for minimum cover situations shall consist of Class 1, Class 2 (minimum 90% SPD) or Class 3 (minimum 90% SPD) material. Maximum fill heights depend on embedment material and compaction level; please refer to Technical Note 2.01. Contact your local ADS representative or visit our website at www.ads-pipe.com for a copy of the latest installation guidelines.

PIPE DIMENSIONS

Nominal Pipe I.D., in. (mm)	4 (100)	6 (150)	8 (200)	10 (250)	12 (300)	15 (375)	18 (450)	24 (600)	30 (750)	36 (900)	42 (1050)	48 (1200)	54 (1350)	60 (1500)
Nominal Pipe O.D., in. (mm)	4.8 (122)	6.9 (175)	9.1 (231)	11.4 (290)	14.5 (368)	18 (457)	22 (559)	28 (711)	36 (914)	42 (1050)	48 (1200)	54 (1350)	61 (1549)	67 (1702)
Perforations	All diameters available with or without perforations.													


*Check with sales representative for availability by region.
**Pipe O.D. values are provided for reference purposes only, values stated for 12- through 60-inch are ±1 inch. Contact a sales representative for exact values.

ADS Terms and Conditions of Sale are available on the ADS website, www.ads-pipe.com
The ADS logo, the Green Stripe, and N-12® are registered trademarks of Advanced Drainage Systems, Inc. © 2010 Advanced Drainage Systems, Inc. BRD 10-08-11 07/12 M1




Advanced Drainage Systems, Inc.
4640 Trueman Blvd., Hilliard, OH 43026
1-800-821-6710 www.ads-pipe.com

**Galveston County
Road & Bridge Department Facilities PH2**
5115 Texas Highway 3
Dickinson, TX

**TYPICAL DETAILS WATER AND
SANITARY SEWER (SDR 26/SDR 35)**

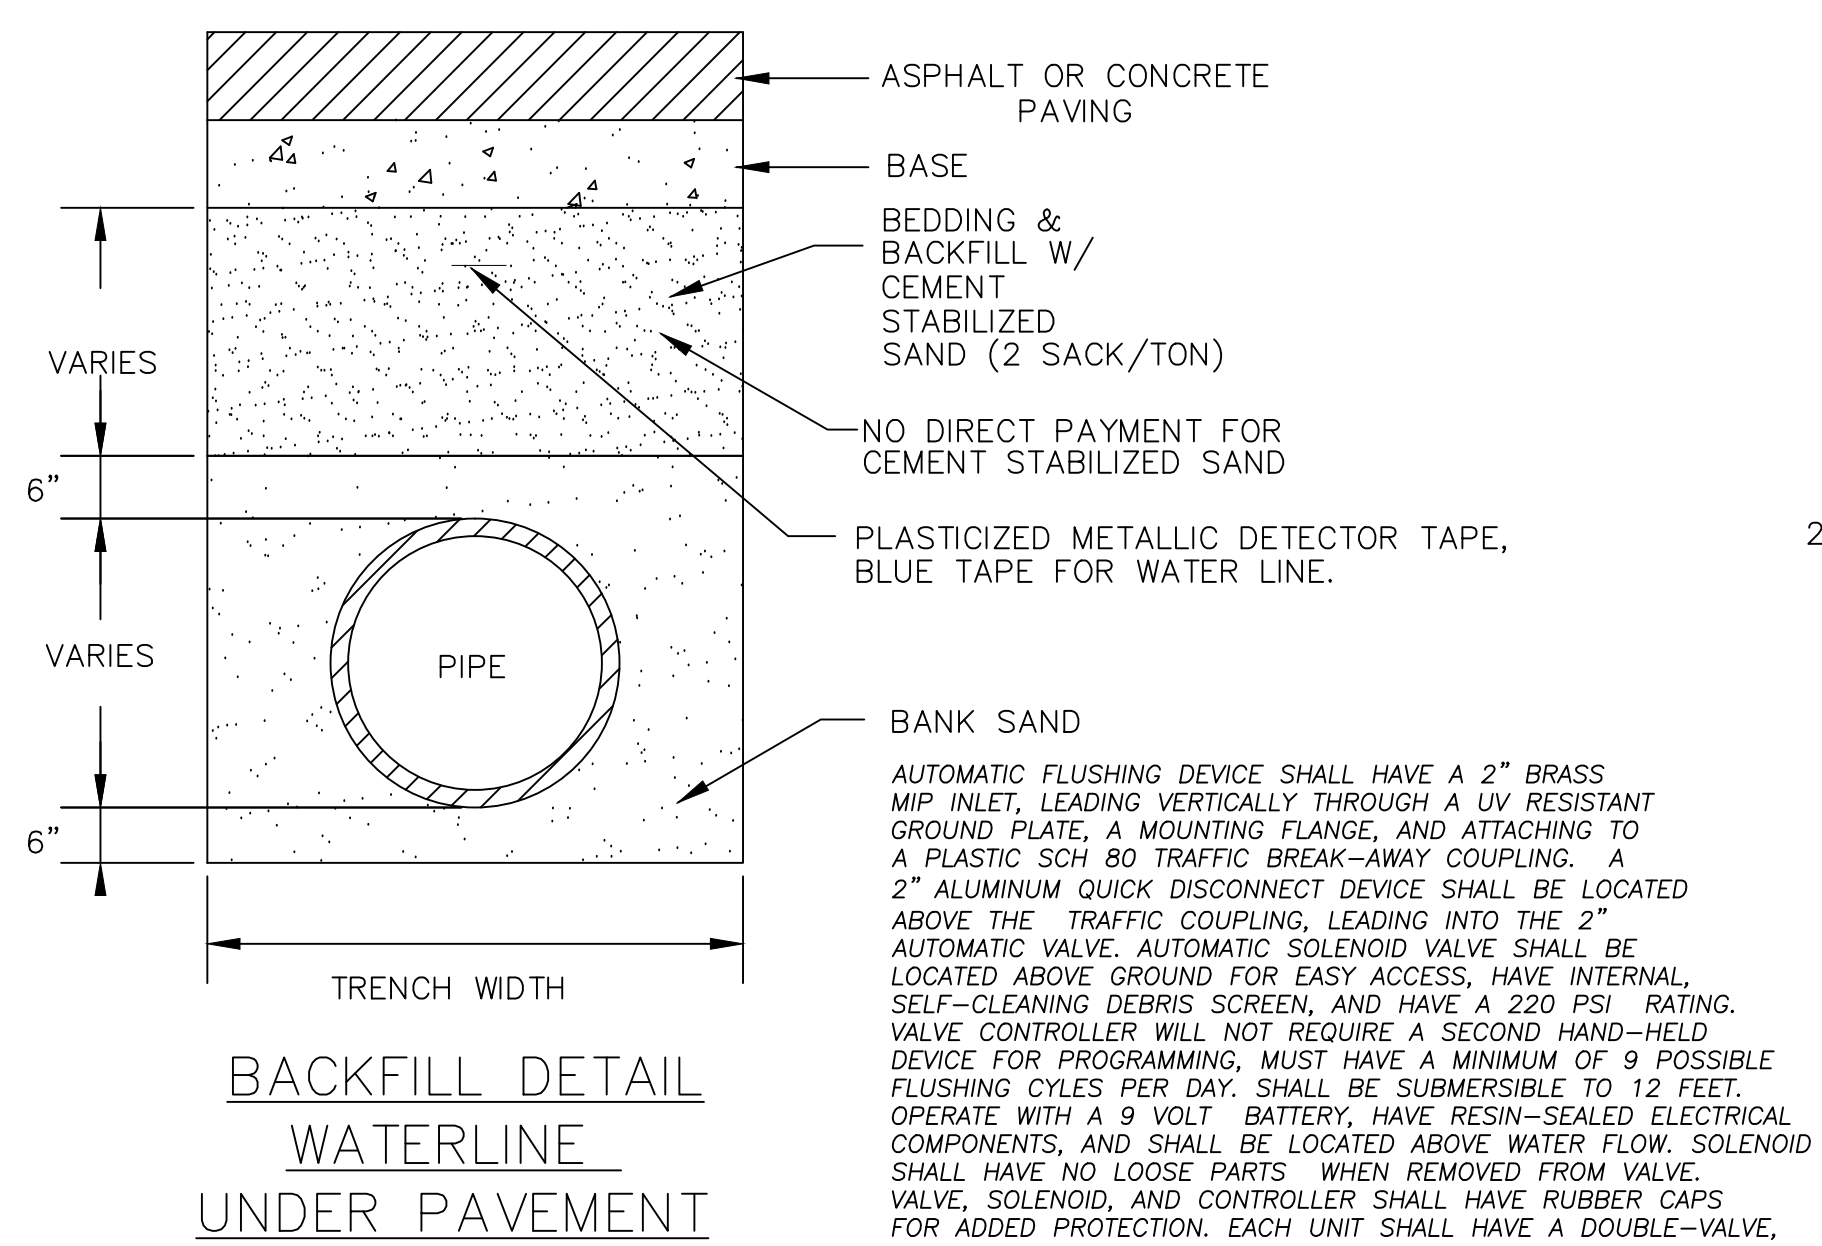

ASPHALT OR CONCRETE PAVING
BASE
BEDDING & BACKFILL W/ CEMENT STABILIZED SAND (2 SACK/TON)
NO DIRECT PAYMENT FOR CEMENT STABILIZED SAND
PLASTICIZED METALLIC DETECTOR TAPE, BLUE TAPE FOR WATER LINE.
PIPE
BANK SAND
AUTOMATIC FLUSHING DEVICE SHALL HAVE A 2" BRASS MIP INLET, LEADING VERTICALLY THROUGH A UV RESISTANT GROUND PLATE, A MOUNTING FLANGE, AND ATTACHING TO A PLASTIC SCH 80 TRAFFIC BREAK-AWAY COUPLING. A 2" ALUMINUM QUICK DISCONNECT DEVICE SHALL BE LOCATED ABOVE GROUND FOR EASY ACCESS. HAVE INTERNAL SELF-CLEANING DEBRIS SCREEN, AND HAVE A 220 PSI RATING. VALVE CONTROLLER WILL NOT REQUIRE A SECOND HAND-HELD DEVICE FOR PROGRAMMING. MUST HAVE A MINIMUM OF 9 POSSIBLE FLUSHING CYCLES PER DAY. SHALL BE SUBMERSIBLE TO 12 FEET. SHALL HAVE NO LOOSE PARTS WHEN REMOVED FROM VALVE. OPERATE WITH A 9 VOLT BATTERY. HAVE RESIN-SEALED ELECTRICAL COMPONENTS, AND SHALL BE LOCATED ABOVE WATER FLOW. SOLENOID VALVE, SOLENOID, AND CONTROLLER SHALL HAVE RUBBER CAPS FOR ADDED PROTECTION. EACH UNIT SHALL HAVE A DOUBLE-VALVE THROUGH HOLES LOCATED NEAR GROUNDLINE. ALL ABOVE-GROUND COMPONENTS SHALL BE CONTAINED WITHIN A UV-RESISTANT LOCKING DOMED COVER. AS MANUFACTURED BY KUPPERLE FOUNDRY COMPANY, ST. LOUIS, MO, 1-800-231-3990, OR APPROVED EQUAL.

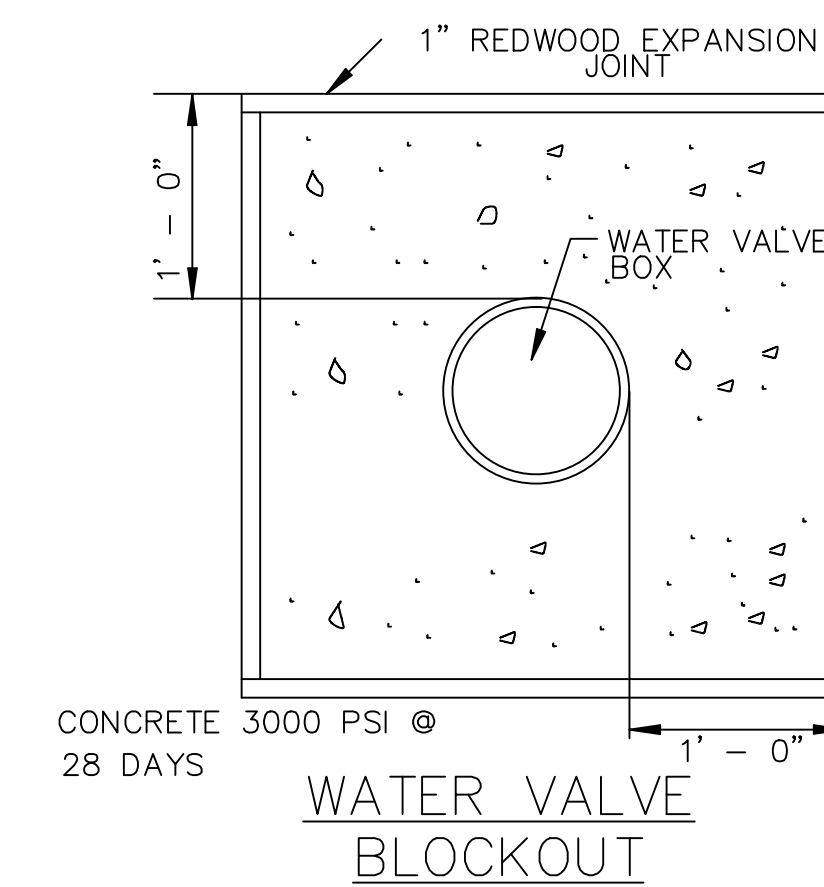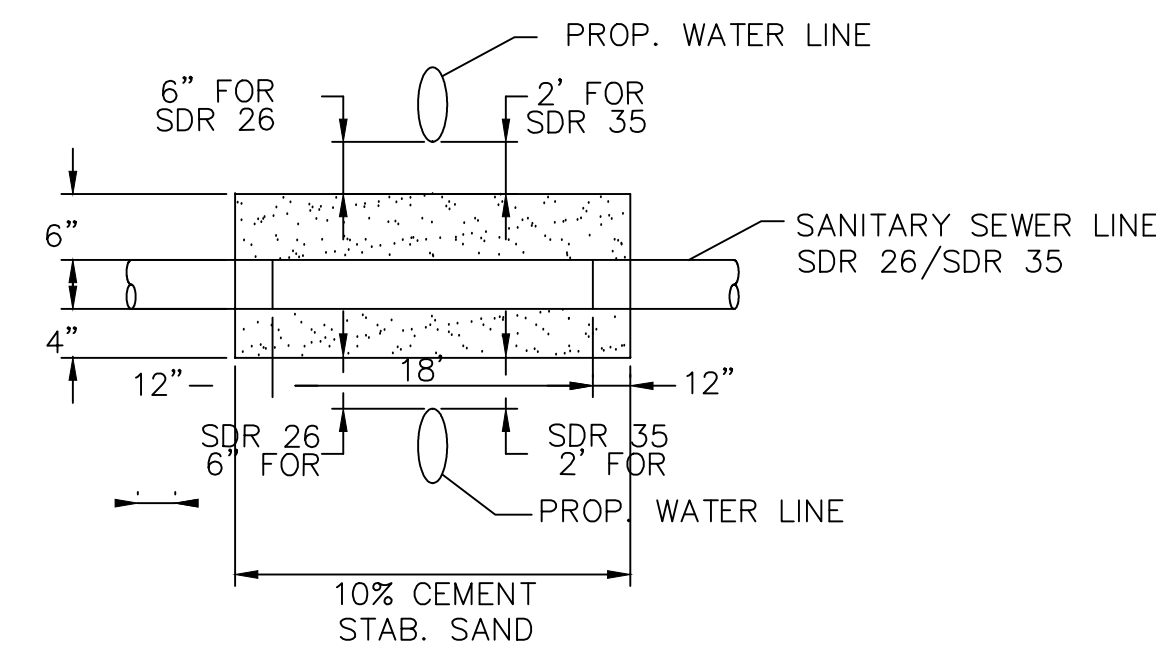
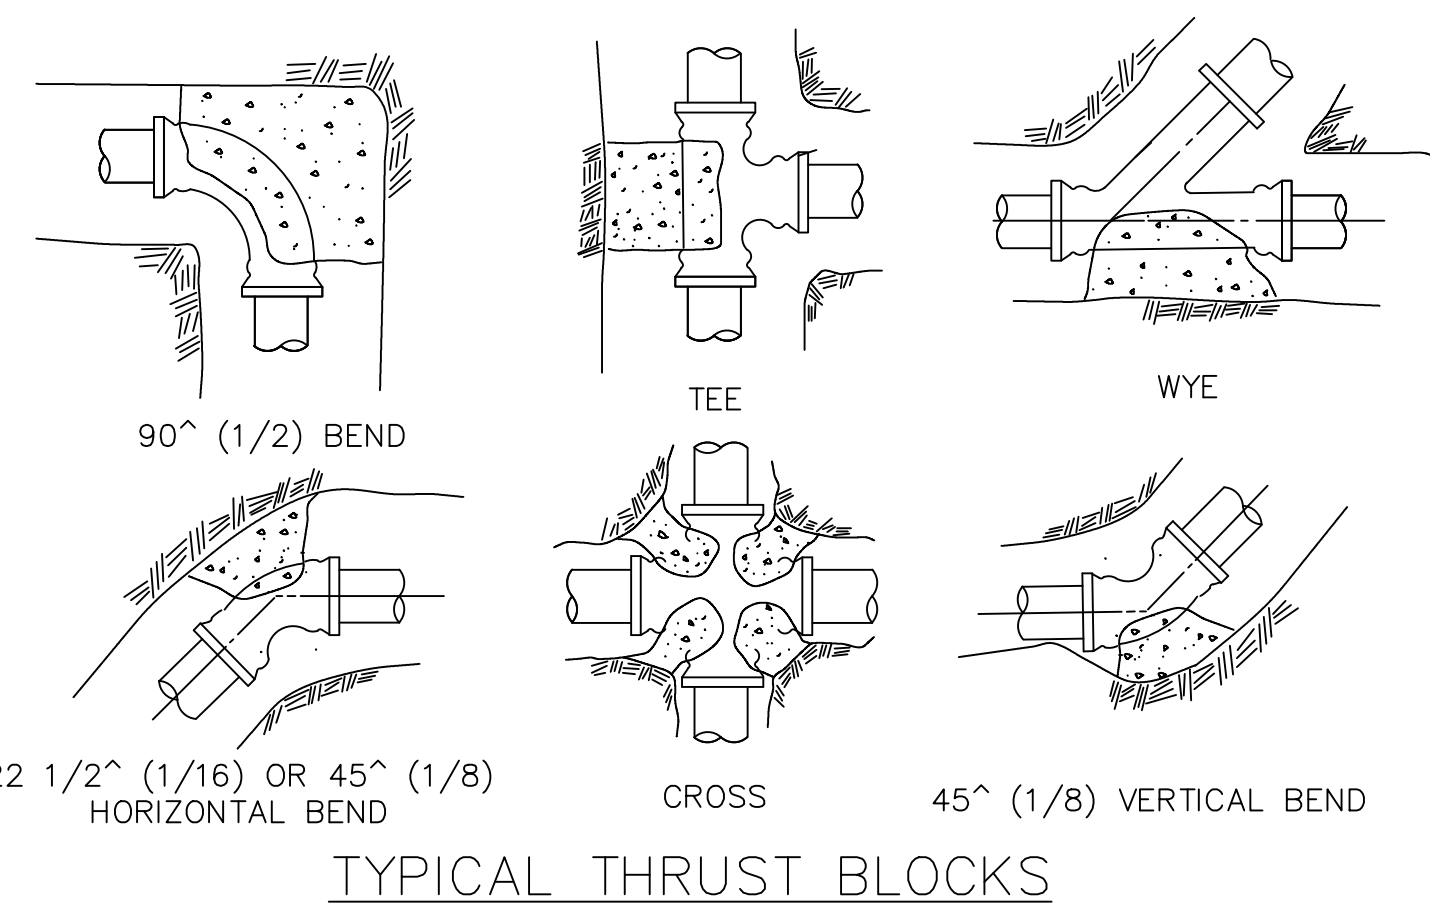


MINIMUM DIMENSIONS FOR THRUST BLOCKS

FITTING SIZE	TEES & PLUGS		90 BEND		45 BENDS & WYES	
	H	W	H	W	H	W
4"	1'-7"	1'-2"	1'-9"	1'-6"	1'-8"	0'-10"
6"	2'-0"	1'-11"	2'-5"	2'-2"	1'-10"	1'-7"
8"	2'-8"	2'-8"	3'-2"	3'-0"	2'-5"	2'-1"
10"	3'-4"	3'-3"	4'-0"	3'-10"	3'-0"	2'-9"
12"	4'-0"	3'-10"	4'-8"	4'-8"	3'-8"	3'-3"
14"	5'-5"	3'-10"	6'-6"	4'-11"	4'-9"	3'-6"
20"	5'-0"	5'-0"	8'-0"	6'-0"	5'-0"	4'-0"
24"	6'-0"	6'-0"	7'-0"	7'-0"	5'-0"	5'-0"
30"	7'-6"	7'-6"	8'-0"	8'-0"	6'-3"	6'-3"


REDUCERS & 22 1/2 BENDS

FITTING SIZE	REDUCERS & 22 1/2 BENDS		11 1/2 BENDS	
	H	W	H	W
4"	1'-7"	0'-6"	0'-8"	0'-6"
6"	1'-9"	0'-10"	1'-0"	0'-8"
8"	1'-9"	1'-6"	1'-0"	1'-0"
10"	2'-2"	1'-11"	1'-6"	1'-0"
12"	2'-7"	2'-3"	2'-0"	1'-0"
14"	3'-5"	2'-5"	2'-0"	1'-6"
20"	3'-6"	3'-0"	3'-0"	2'-0"
24"	4'-6"	3'-0"	3'-0"	3'-0"
30"	4'-9"	4'-6"	3'-3"	3'-3"

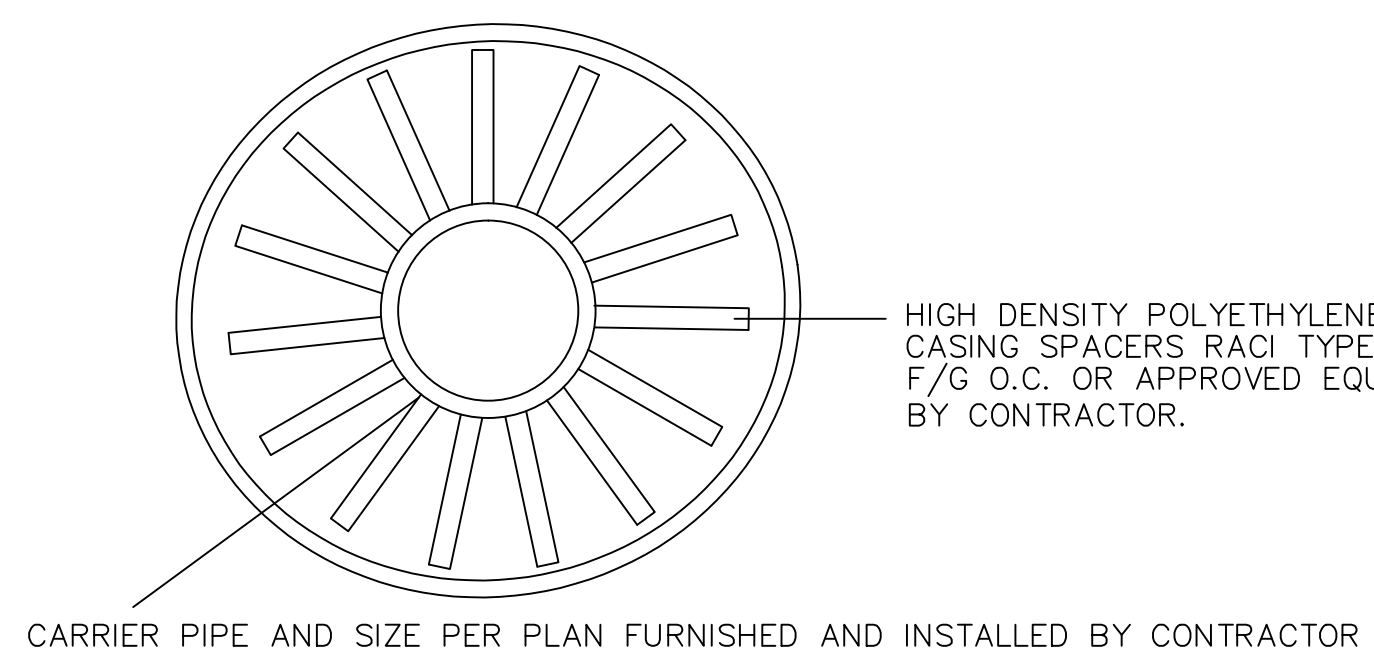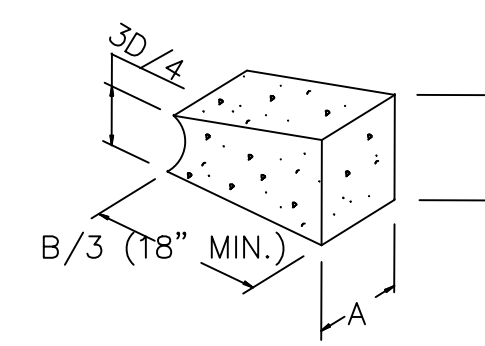


RACI CASING SPACERS


DR 18 C900 PVC PIPE		SDR 35 PVC SEWER PIPE	
PIPE SIZE	STEEL CASING DIA.	PIPE SIZE	STEEL CASING DIA.
4"	10"	6"	10"
6"	12"	8"	12"
8"	14"	10"	14"
10"	16"	12"	16"
12"	20"	15"	22"
14"	22"	18"	24"
16"	24"		

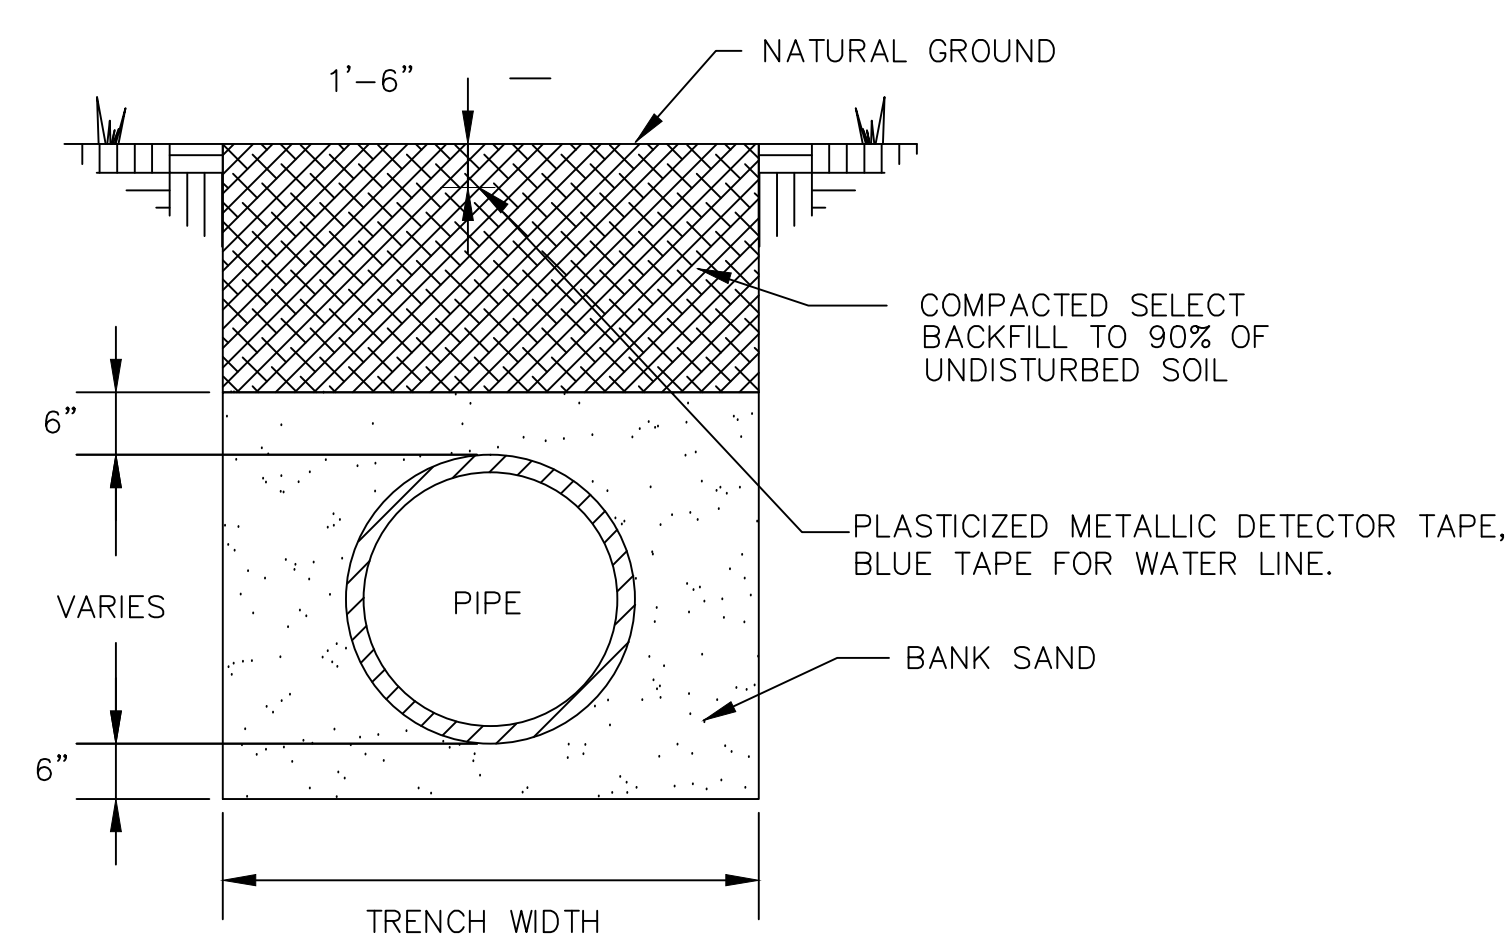

BACKFILL
DETAIL
NOT UNDER
PAVEMENT

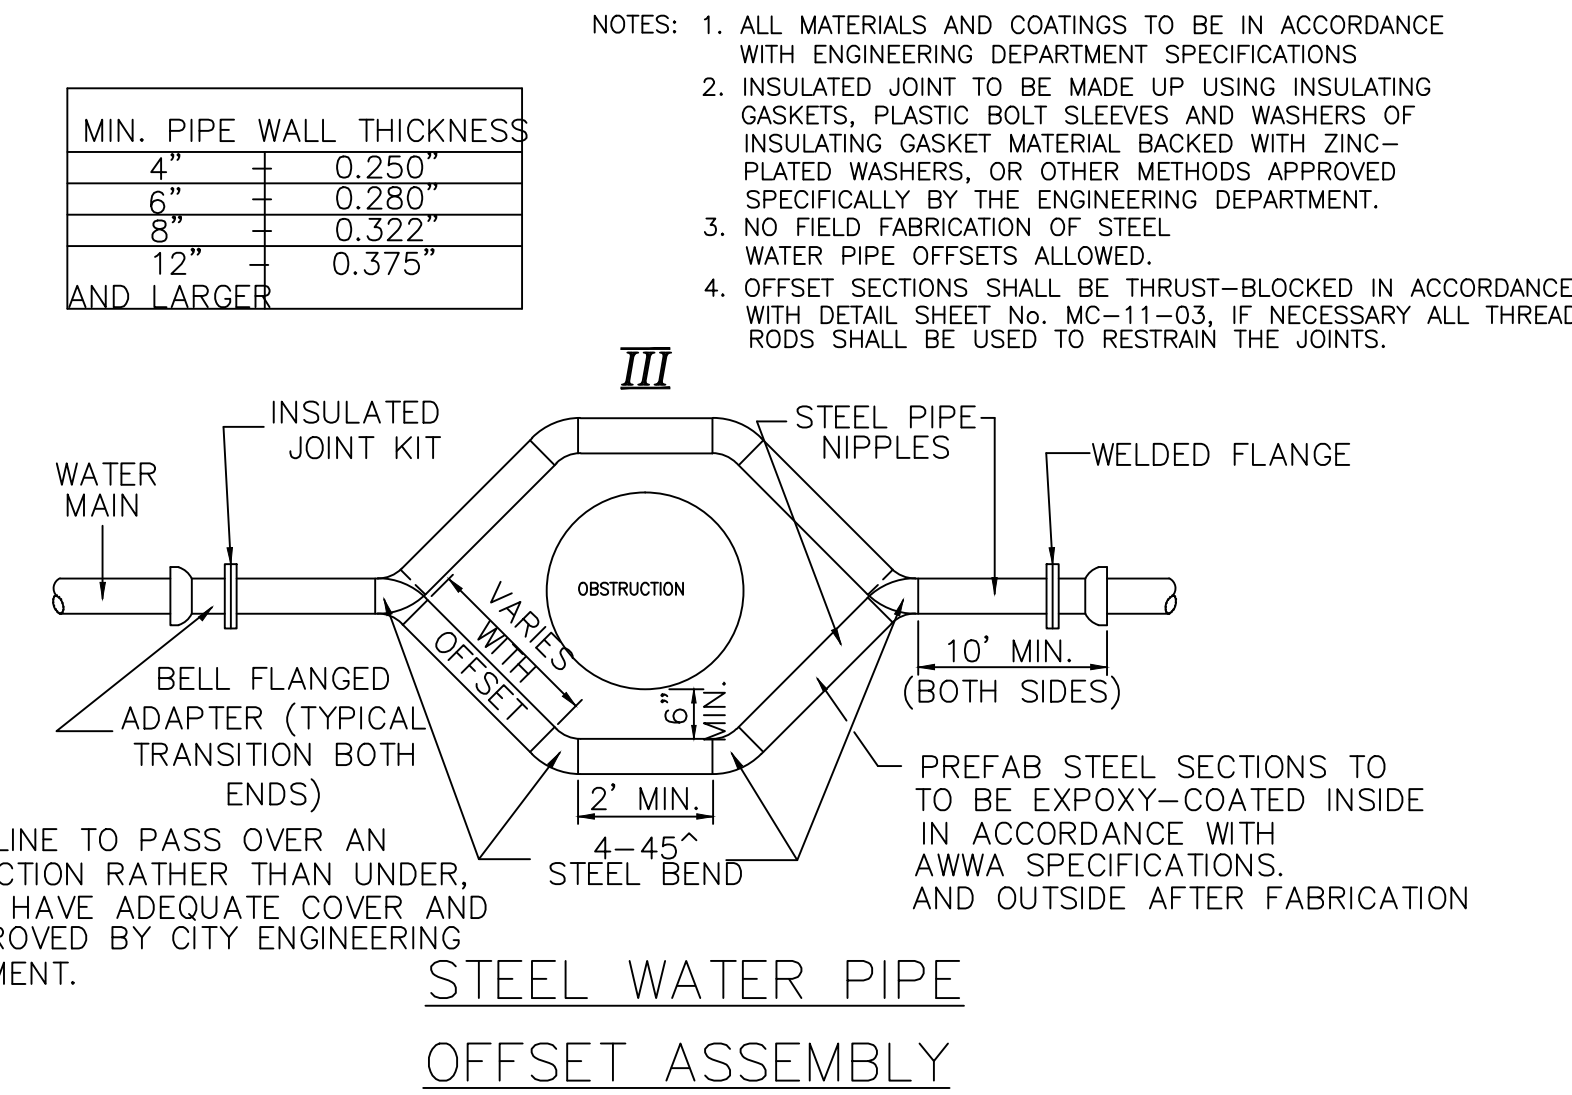


- NOTES:
1. ALL MATERIALS AND COATINGS TO BE IN ACCORDANCE WITH ENGINEERING DEPARTMENT SPECIFICATIONS
 2. INSULATED JOINT TO BE MADE UP USING INSULATING GASKETS, PLASTIC BOLT SLEEVES AND WASHERS OF INSULATING GASKET MATERIAL BACKED WITH ZINC-PLATED WASHERS, OR OTHER METHODS APPROVED SPECIFICALLY BY THE ENGINEERING DEPARTMENT.
 3. NO FIELD FABRICATION OF STEEL WATER PIPE OFFSETS ALLOWED.
 4. OFFSET SECTIONS SHALL BE THRUST-BLOCKED IN ACCORDANCE WITH DETAIL SHEET No. MC-11-03, IF NECESSARY ALL THREAD RODS SHALL BE USED TO RESTRAIN THE JOINTS.

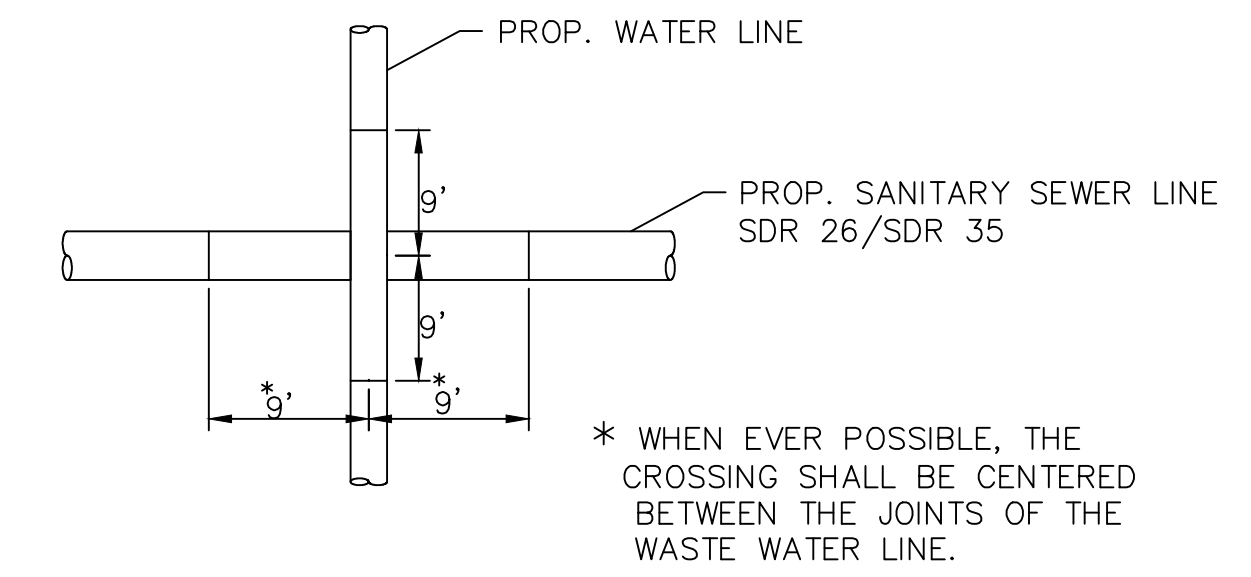

* WHEN EVER POSSIBLE, THE CROSSING SHALL BE CENTERED BETWEEN THE JOINTS OF THE WASTE WATER LINE.

ONE-CALL NOTIFICATION SYSTEM
CALL BEFORE YOU DIG!!!
(713) 223-4567 (In Houston, TX)
(New Statewide Number Outside Houston)
1-800-545-6005

KEY PLAN (NOT TO SCALE)

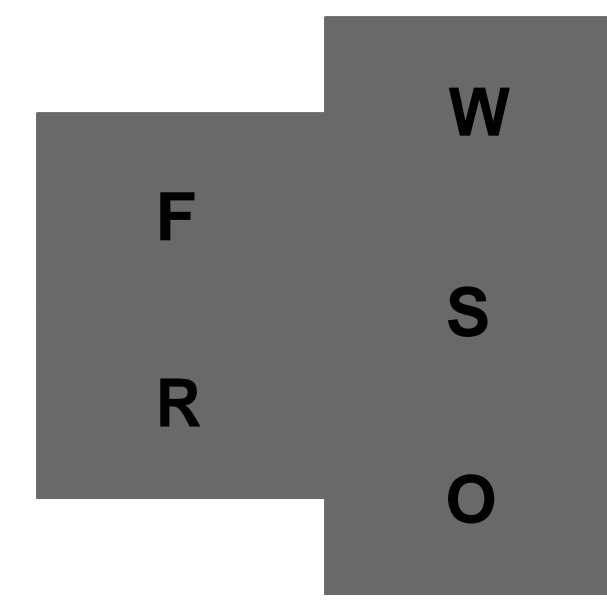

REVISION HISTORY

NO.	DESCRIPTION	DATE
1	ADDENDUM NO. 3	10-07-2020

PROFESSIONAL SEALS

WATER DETAILS

DRAWN BY: JDM
PROJECT NUMBER: 418198
ORIGINAL ISSUE: 07 OCT 2020

CHECKED BY: JDM
PROJECT ABBREVIATION: GC-R&B
DATE: 07 OCT 2020

C11.0-PH2

SHEET NUMBER

Galveston County
Road & Bridge Department Facilities PH2
5115 Texas Highway 3
Dickinson, TX

REVISION	DESCRIPTION	DATE
1	ADDENDUM NO. 3	10-07-2020

REVISION	DESCRIPTION	DATE

ONE-CALL NOTIFICATION SYSTEM
CALL BEFORE YOU DIG!!!
(713) 223-4567 (In Houston, TX)
(800) 486-6666 (Outside Houston)
1-800-545-6005

PROFESSIONAL SEALS

10/07/2020

SANITARY SEWER DETAILS

DRAWN BY: JDM
PROJECT NUMBER: 418198
ORIGINAL ISSUE DATE: 07/02/2020


CHECKED BY: JDM
PROJECT ABBREVIATION: GC-RGB
DATE: 07/02/2020

FRED DAILY
90904
LICENSED PROFESSIONAL ENGINEER


SHEET NUMBER: C12.0-PH2

NOTES:


- THIS DETAIL MAY BE USED ONLY FOR DRY STABLE TRENCH CONDITION. SEE SPECIFICATIONS FOR REQUIREMENTS IN OTHER CONDITIONS.
- MIN TRENCH WIDTH SHALL BE PIPE OD PLUS AN ALLOWANCE "A" FOR THE NOMINAL PIPE SIZE:
NOMINAL PIPE SIZE "A"
18" TO 30" 24"
OVER 30" 36"
- MAX TRENCH WIDTH SHALL BE NOT GREATER THAN MIN TRENCH WIDTH PLUS 24 INCHES, UNLESS OTHERWISE NOTED.
- MIN. BEDDING DEPTH SHALL BBE 12 INCHES.
- ALTERNATIVE EMBEDMENT BACKFILL MATERIALS FOR FORCE MAINS MAY BE ALLOWED

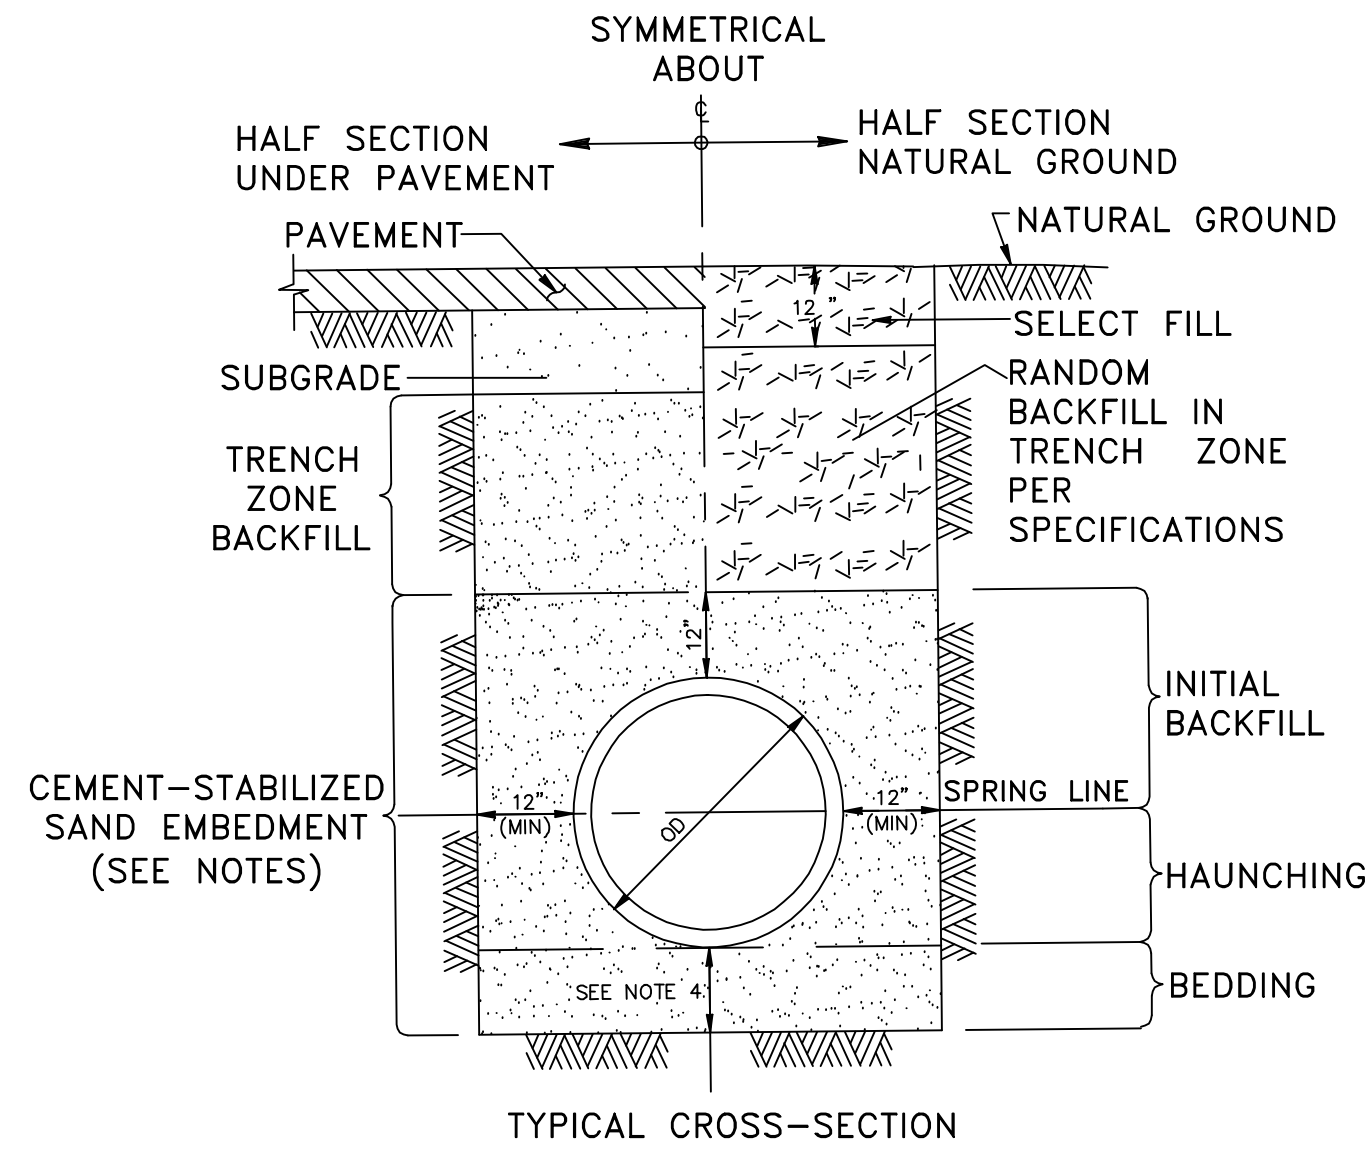

SANITARY SEWER BEDDING & BACKFILL

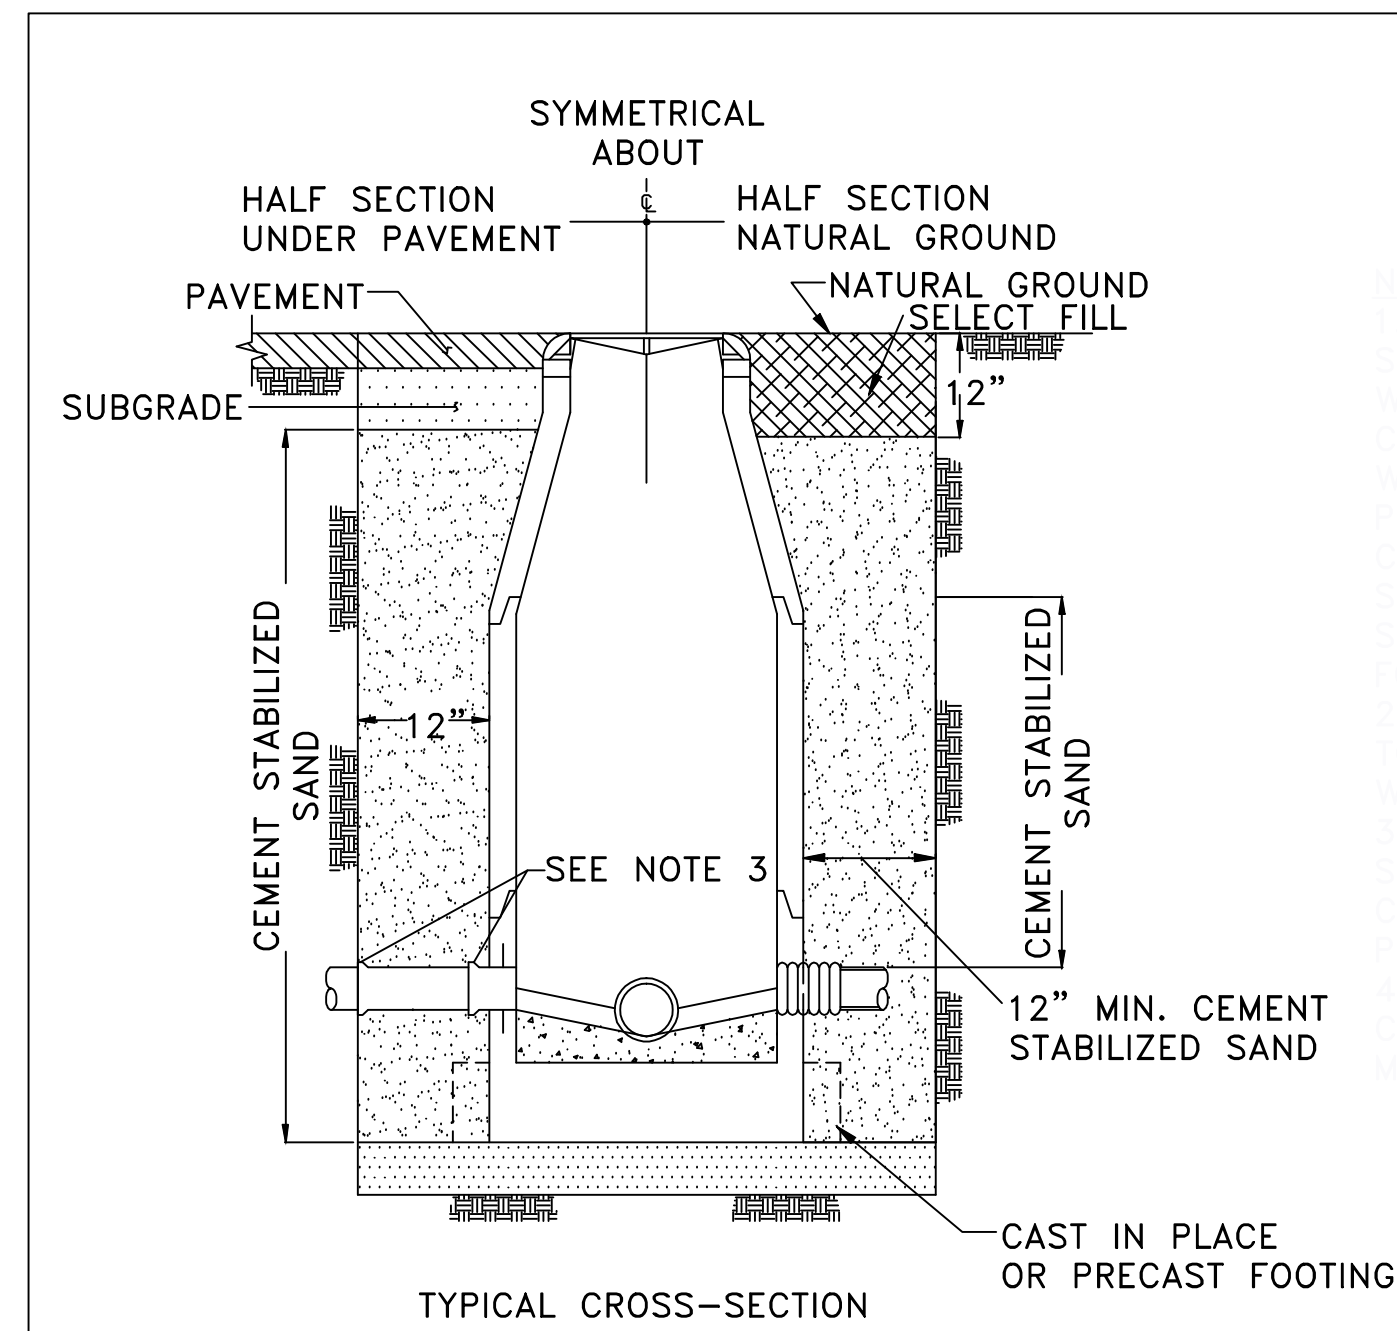

SANITARY SEWER MANHOLE

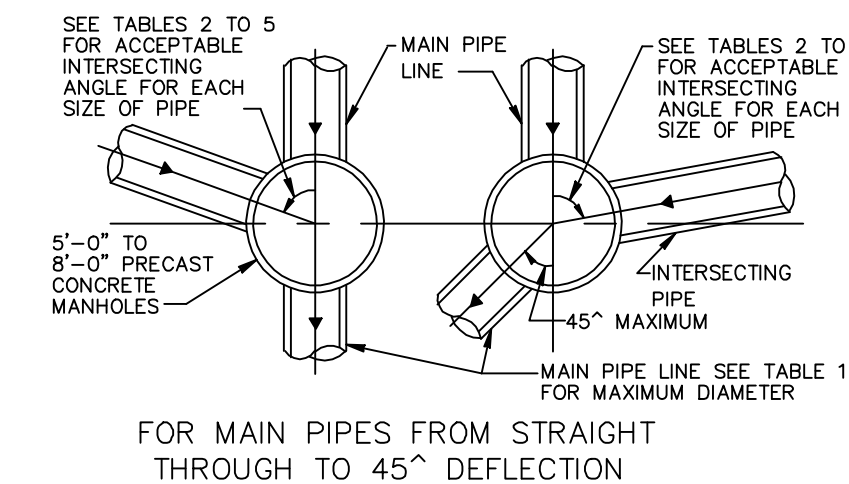

NOTES ON USE OF STANDARD DETAIL SAN-015

TABLE 3
MINIMUM ANGLE AND INTERSECTING PIPE ID SIZES FOR 6"-0" DIA MANHOLE

INTERSECTING PIPE ID SIZES (INCHES)	MINIMUM INTERSECTING ANGLE IN DEGREES FOR VARIOUS MAIN PIPE ID SIZES IN INCHES											
	8"	10"	12"	15"	18"	21"	24"	27"	30"	33"	36"	42"
8	40	42	45	48	51	54	57	61	63	67	70	78
10		44	47	50	53	56	59	62	65	69	72	79
12			50	54	56	60	62	66	68	72	76	83
15				57	59	62	65	69	71	75	78	85
18					62	65	68	71	74	78	81	88
21						68	71	74	77	81	84	91
24							74	77	80	84	87	94
27								83	85	89	92	99
30									88	91	94	101
33										92	95	102
36											96	103
42												107

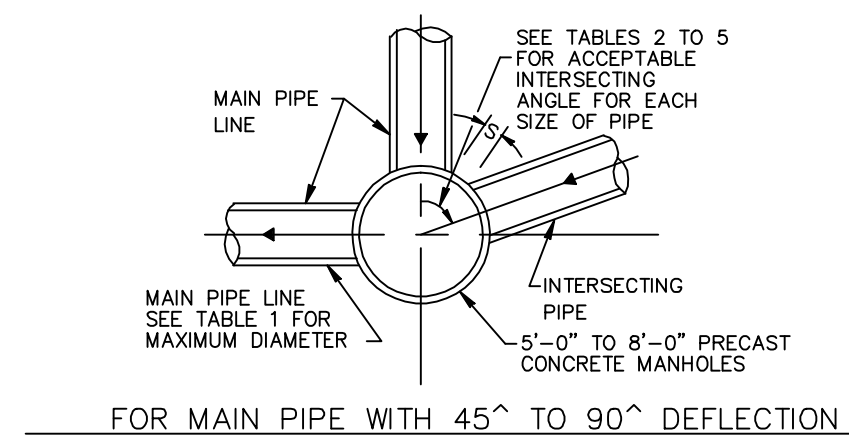


TABLE 4
MINIMUM ANGLE AND INTERSECTING PIPE ID SIZES FOR 7"-0" DIA MANHOLE

INTERSECTING PIPE ID SIZES (INCHES)	MINIMUM INTERSECTING ANGLE IN DEGREES FOR VARIOUS MAIN PIPE ID SIZES IN INCHES												
	8"	10"	12"	15"	18"	21"	24"	27"	30"	33"	36"	42"	48"
8	35	36	39	42	44	47	49	52	54	57	59	65	71
10		38	40	43	45	48	50	53	55	59	61	67	73
12			43	46	48	51	53	56	58	61	64	70	76
15				48	50	53	55	58	61	64	66	72	78
18					50	53	55	58	61	63	66	72	81
21						58	60	63	66	69	74	81	89
24							63	66	69	71	77	85	93
27								70	72	76	78	84	96
30									78	81	85	89	101
33										86	88	92	104
36											90	94	106
42												98	110
48													114

TABLE 1
MAXIMUM MAIN PIPE DIAMETER (I.D.) IN INCHES

MANHOLE DIAMETER	STRAIGHT THROUGH TO 45° DEFLECTION	WITH 90° DEFLECTION	TABLE TO BE USED
5	36	27	2
6	42	33	3
7	48	36	4
8	60	42	5

NOTES TO SPECIFIER:

- " " INDICATES THAT A SPECIAL DESIGN OR THE NEXT LARGER MANHOLE SIZE SHALL BE USED.
- TABLES 2 TO 5 ARE BASED ON A MIN SEPARATION DISTANCE "S" OF 15.5" OR INTERSECTION PIPE OD/2, WHICHEVER IS GREATER BETWEEN MAIN AND INTERSECTING PIPES ALONG THE MANHOLE INSIDE WALL ARC.
- PIPE WALL THICKNESS USED IN TABLES 2 TO 5 ARE BASED ON RCP. THE DESIGN ENGINEER MAY CALCULATE TO SEE IF THINNER WALL PIPES CAN MEET THE SEPARATION CRITERIA FOR ANGLES SMALLER THAN THE TABLES ALLOW.
- LIMITATIONS TO BASE HEIGHT ARE BASED ON RESISTING BUOYANT UPLIFT FORCES BASED ON WATER AT GROUND SURFACE AND A SAFETY FACTOR OF 1.20.
- A SPECIAL DESIGN IS REQUIRED IF MANHOLE ID IS GREATER THAN 8 FT.

5'-0" TO 8'-0" DIAMETER PRECAST CONCRETE MANHOLE NOTES N.T.S

TABLE 5
MINIMUM ANGLE AND INTERSECTING PIPE ID SIZES FOR 8"-0" DIA MANHOLE

INTERSECTING PIPE ID SIZES (INCHES)	MINIMUM INTERSECTING ANGLE IN DEGREES FOR VARIOUS MAIN PIPE ID SIZES IN INCHES													
	8"	10"	12"	15"	18"	21"	24"	27"	30"	33"	36"	42"	48"	60"
8	30	33	35	38	40	42	44	46	48	51	53	58	63	67
10		33	35	38	40	42	44	46	48	51	53	58	63	67
12			38	40	42	44	46	48	51	53	55	60	65	71
15				42	44	46	48	51	53	55	58	62	67	73
18					46	48	51	53	55	58	60	64	70	75
21						51	53	55	57	60	62	67	72	77
24							55	57	59	62	64	69	74	79
27								61	63	66	68	73	78	83
30									67	70	72	77	82	87
33										74	76	81	86	91
36											81	86	91	96
42												88	93	98
48													95	100
60														107


TABLE 2
MINIMUM ANGLE AND INTERSECTING PIPE ID SIZES FOR 5'-0" DIA MANHOLE

INTERSECTING PIPE ID SIZES (INCHES)	MINIMUM INTERSECTING ANGLE IN DEGREES FOR VARIOUS MAIN PIPE ID SIZES IN INCHES								
	8"	10"	12"	15"	18"	21"	24"	27"	36"
8	48	50	54	58	61	64	68	71	76
10		53	57	61	64	68	71	76	79
12			61	65	68	72	75	80	83
15				68	71	75	79	83	87
18					75	79	82	87	90
21						83	86	90	94
24							90	94	98
27								96	100
30									103
33									
36									


*NOT APPLICABLE (INTERSECTING PIPE GREATER THAN MAIN PIPE)




PLAN VIEW FRAME AND COVER SCALE: 1" = 1'-0"

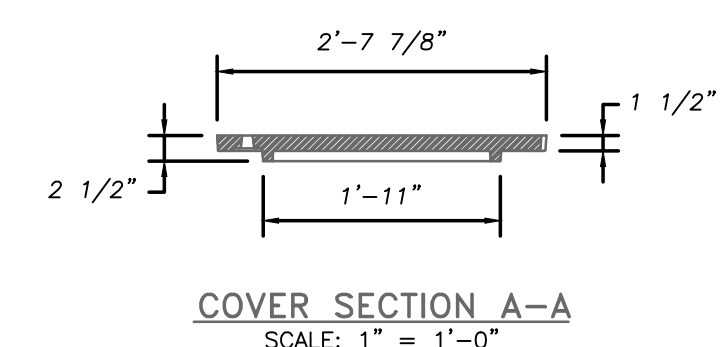

COVER SECTION A-A SCALE: 1" = 1'-0"

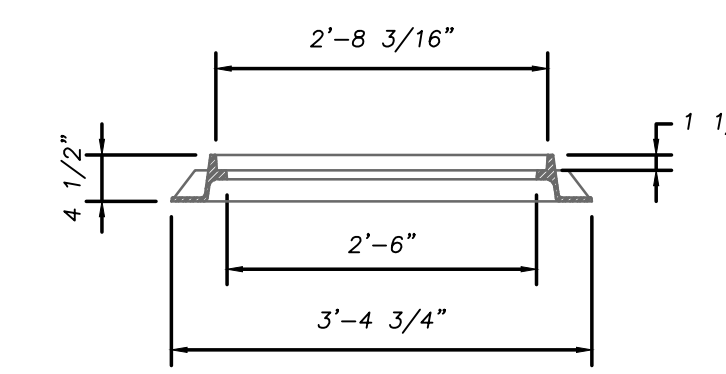


FRAME SECTION A-A SCALE: 1" = 1'-0"

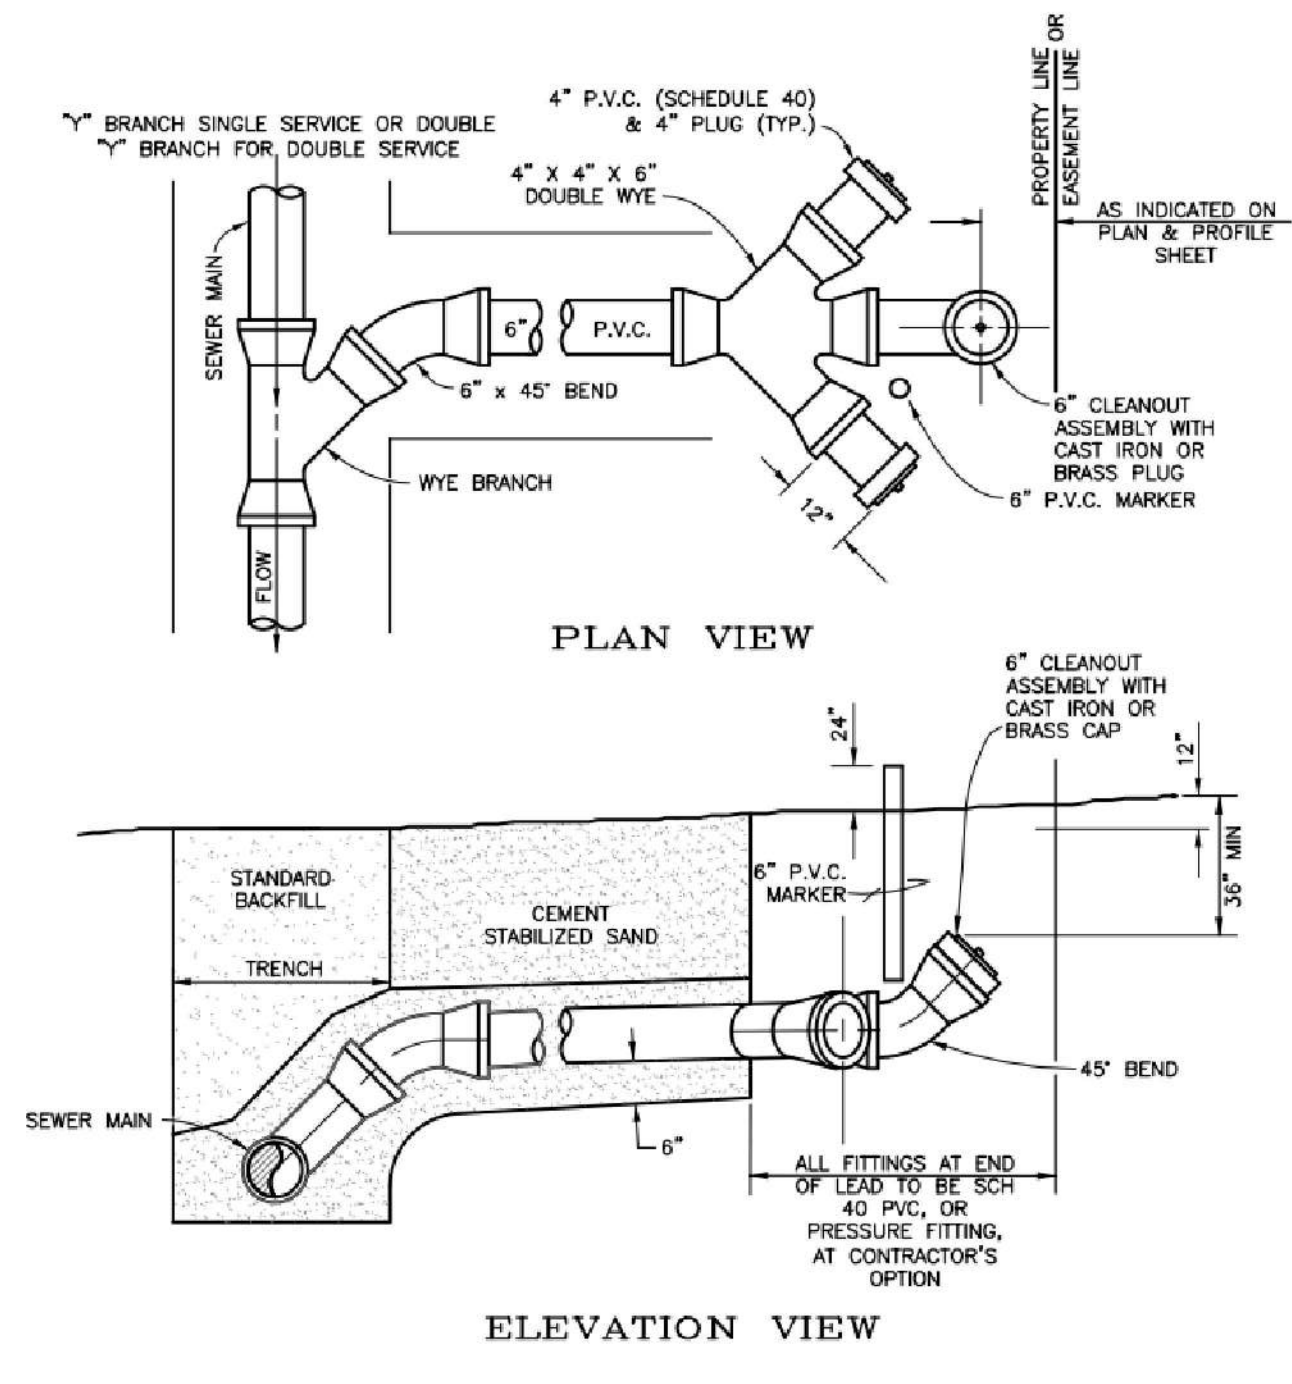


ELEVATION VIEW

SANITARY SEWER SERVICE CONNECTION


- NOTES:
- DEPTH MANHOLE DETERMINES SECTIONS REQUIRED.
 - PRECAST CONCRETE RINGS SHALL BE PROVIDED FOR A COMBINED ADJUSTMENT HEIGHT OF AT LEAST 12". THE TOTAL HEIGHT OF THE ADJUSTMENT RINGS SHALL NOT EXCEED 1'-6".
 - MANHOLE WALL THICKNESS FOR DEPTH EXCEEDING 12'0" SHALL BE 12" THICK.
 - MANHOLE DROP AND INTERSECTING PIPES SHALL BE INSTALLED ONLY WHEN CALLED FOR IN PLAN AND PROFILE DRAWING.
 - SEAT MANHOLE FRAME IN SEALANT PER CITY OF LA PORTE STANDARD SPECIFICATION.
 - ECCENTRIC PRECAST CONCRETE MANHOLE MAY BE USED.
 - OMIT CEMENT MORTAR WHEN MANHOLE IS LOCATED IN PAVED AREAS.
 - MIN. REINFORCING IN THE PRECAST CONCRETE BASE SHALL BE #5@ 8 EW.
 - PROVIDED BACKFILL TO MATCH ADJACENT PIPE TRENCH BACKFILL PER CITY OF LA PORTE STANDARD SPECIFICATION.
 - TEE INCLUDED IN PRICE OF DROP.
 - HORSE-SHOE SHAPED OPENINGS OR BREAKOUT OPENINGS SHALL NOT BE ACCEPTED.

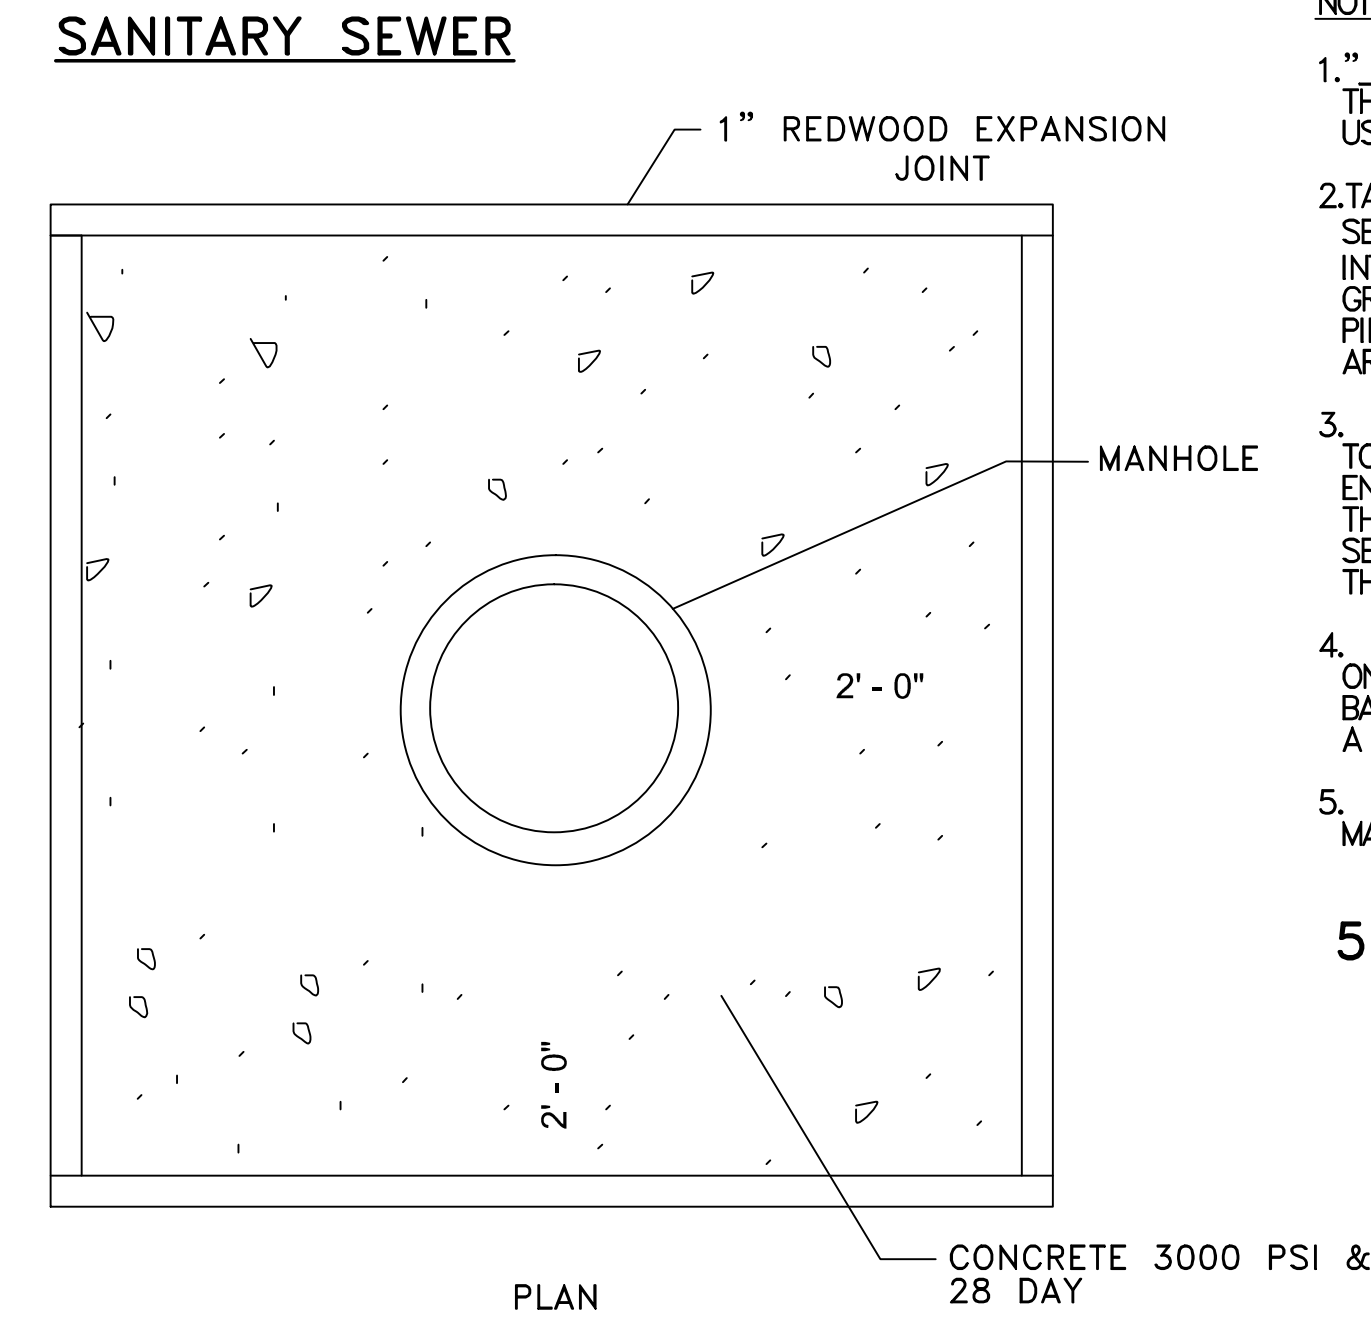

STANDARD MANHOLE BREAKOUT FOR CONCRETE PAVEMENT

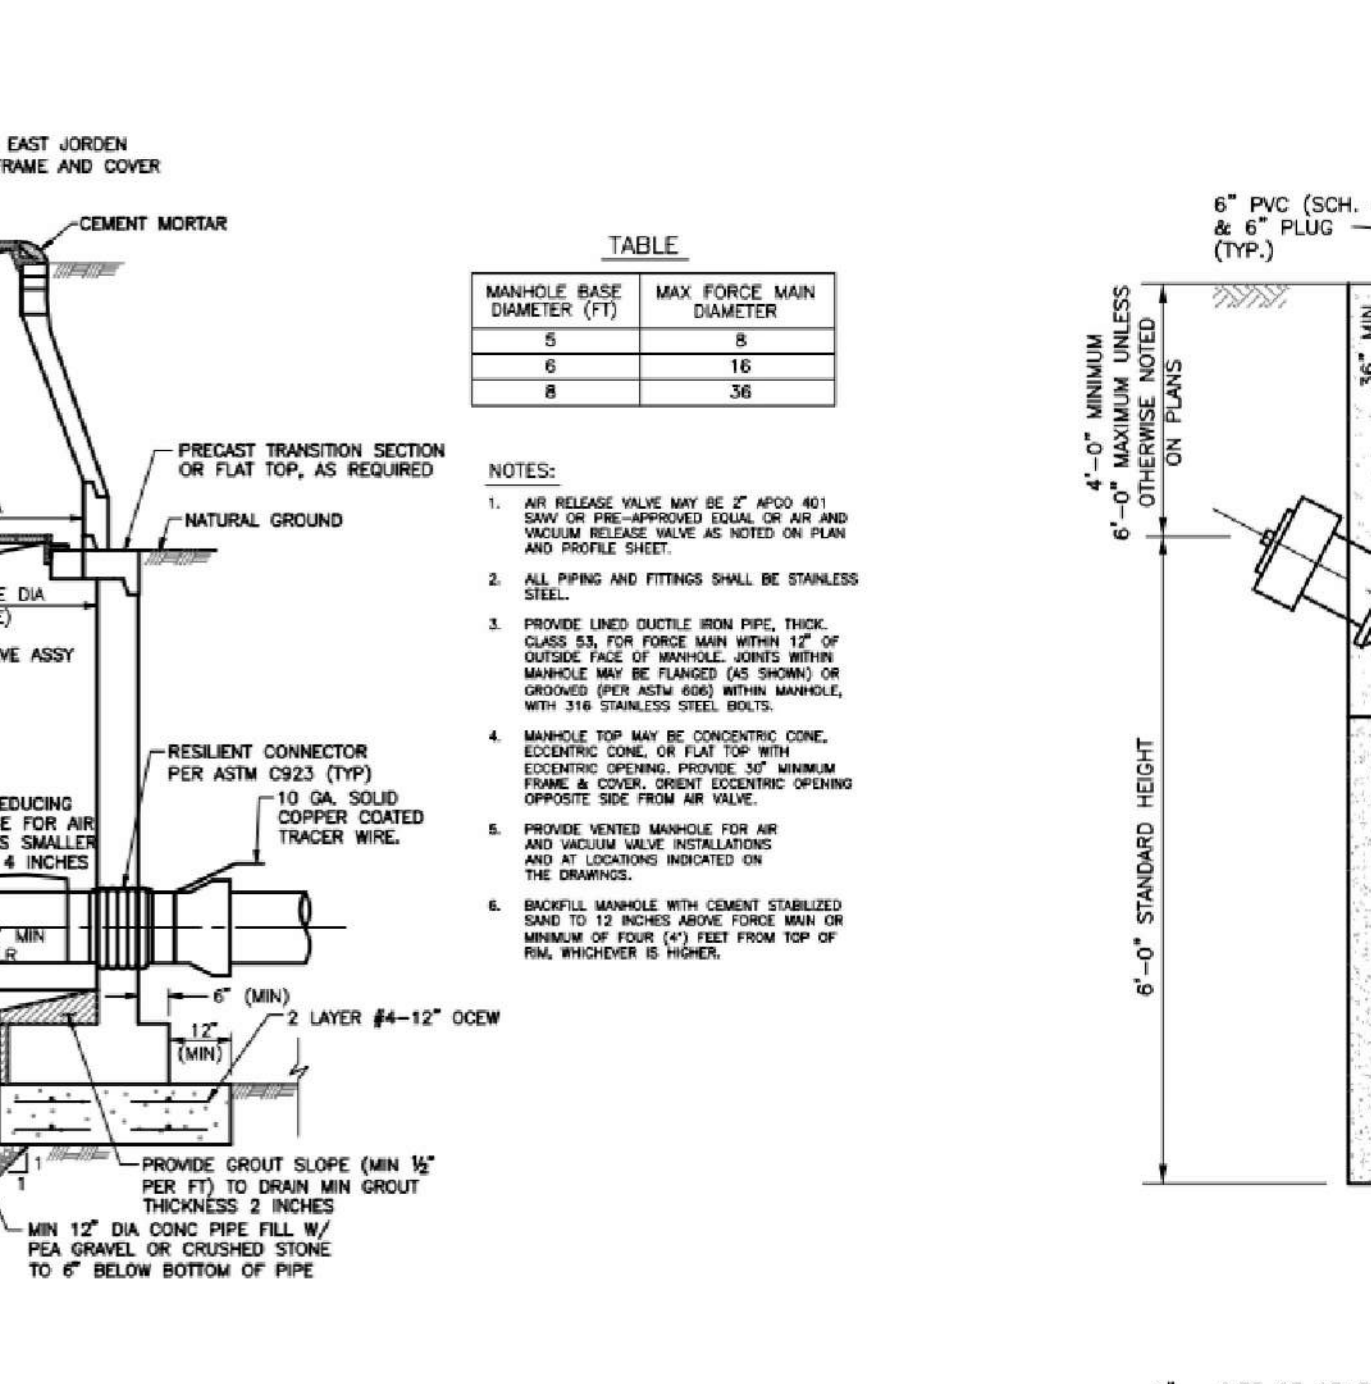

SANITARY SEWER AIR RELEASE OR AIR/VACUUM RELEASE VALVE MANHOLE

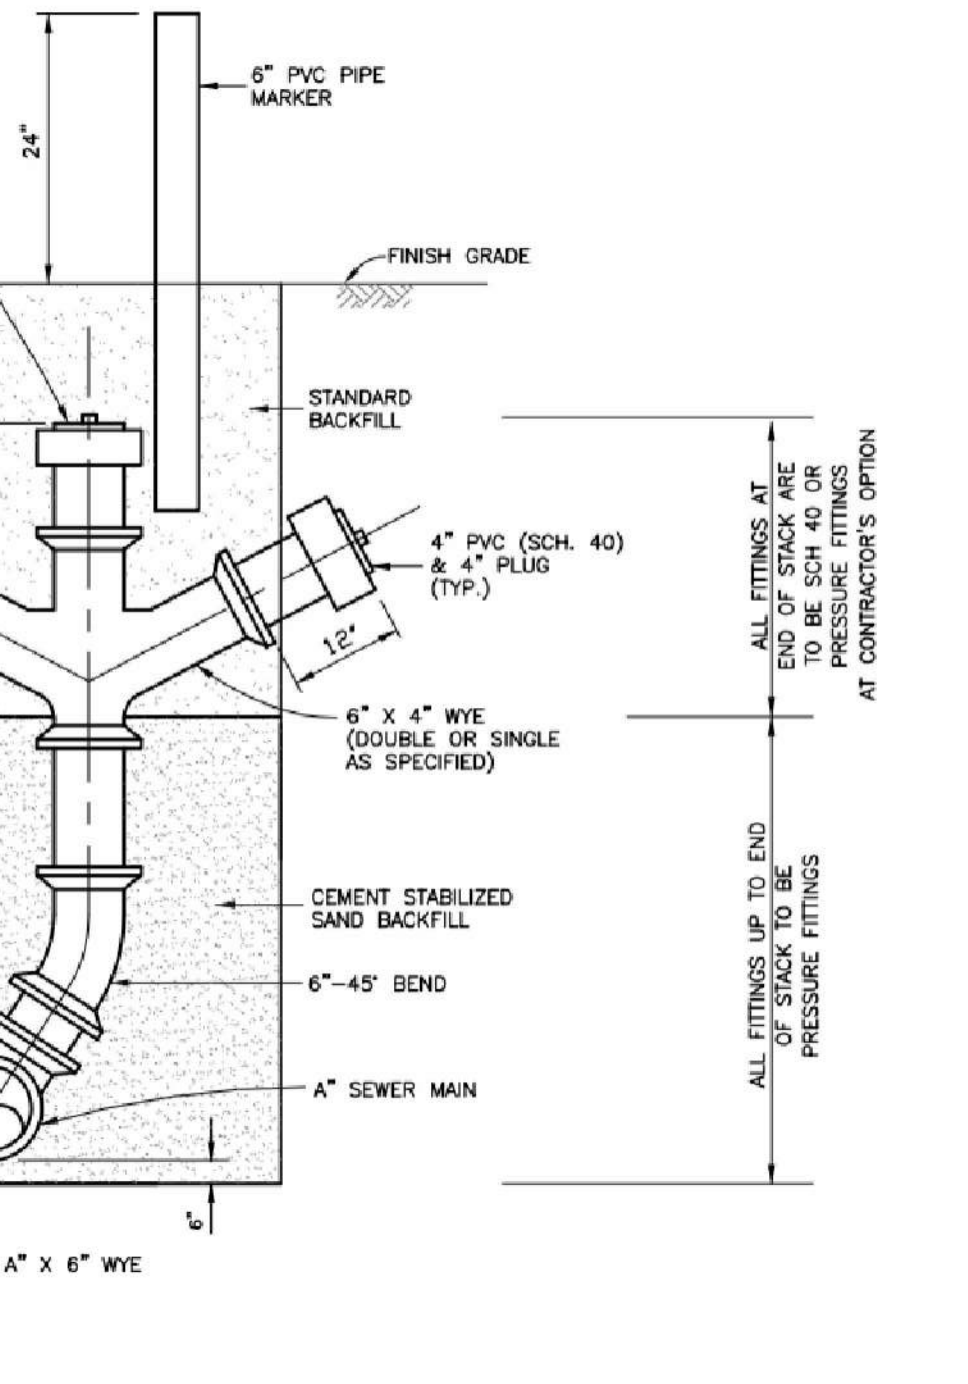

SANITARY SEWER STACK





Engineering Data



MANUFACTURED BY: PARK

MODEL: GOS-1

SAND/OIL SEPARATOR

ONE-CALL NOTIFICATION SYSTEM
CALL BEFORE YOU DIG!!!
(713) 223-4567 (In Houston, TX)
(800) 486-6666 (Outside Houston)
1-800-545-6005

**Galveston County
Road & Bridge Department Facilities PH2**
5115 Texas Highway 3
Dickinson, TX

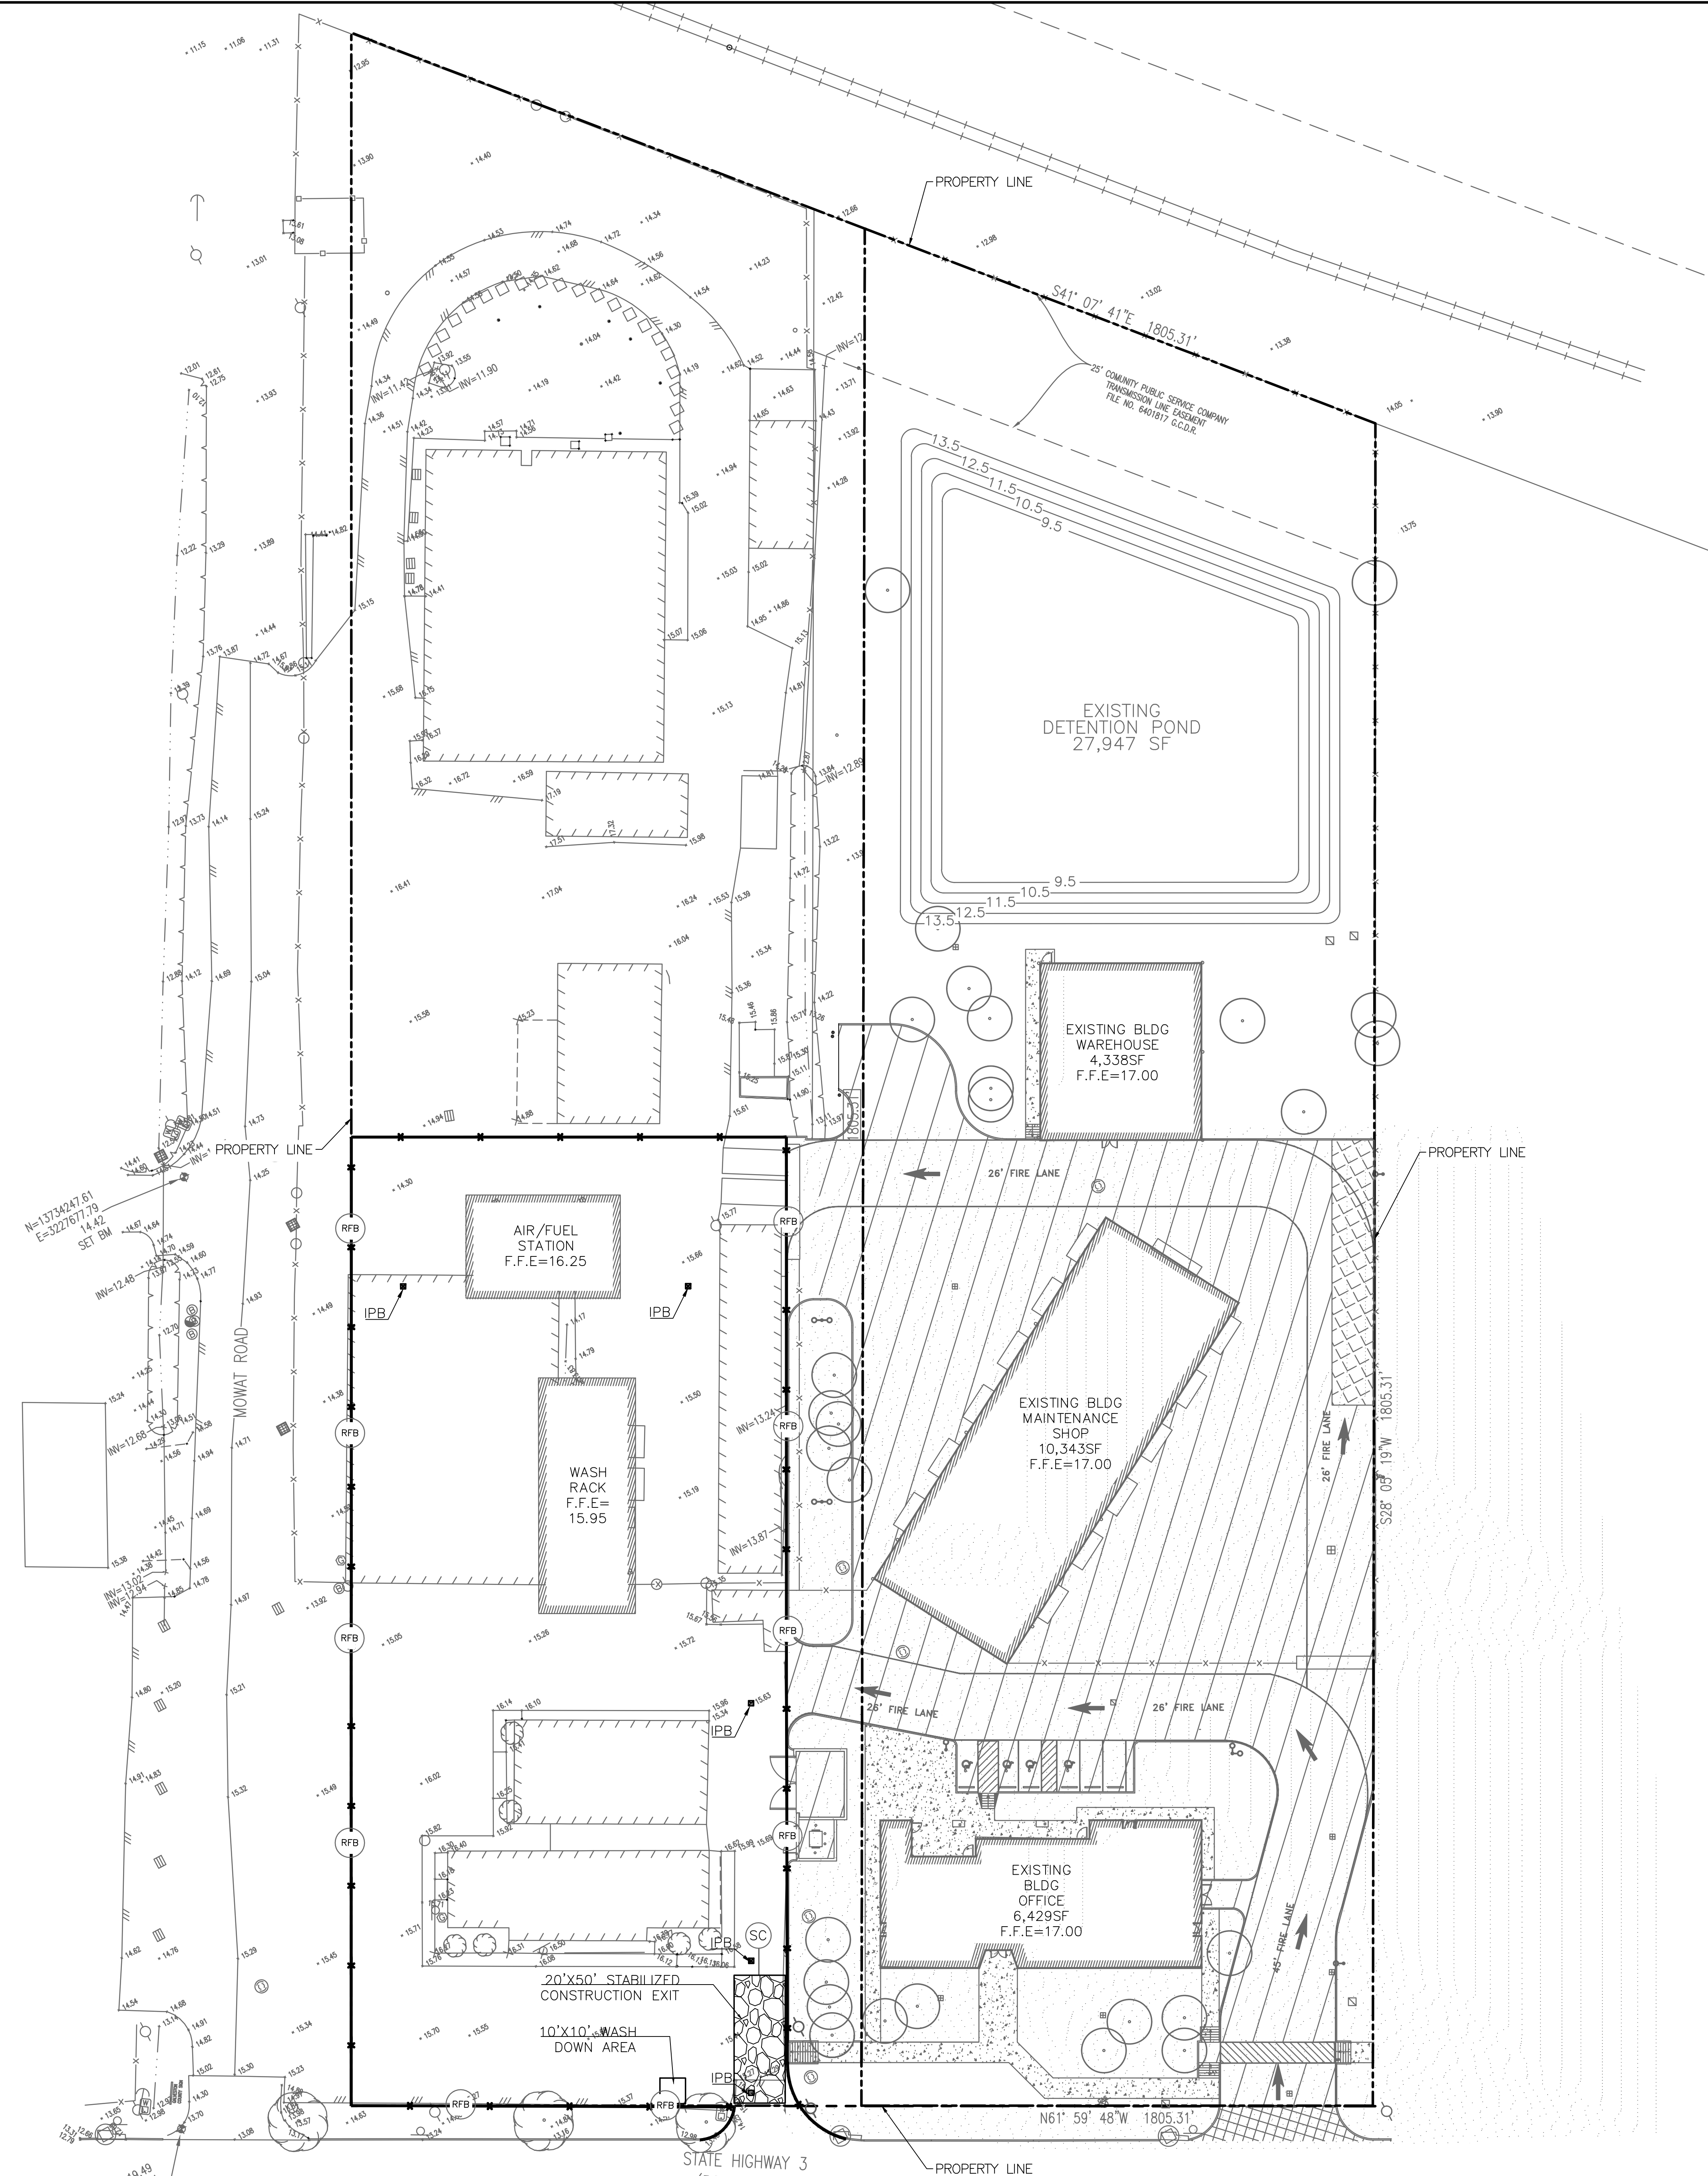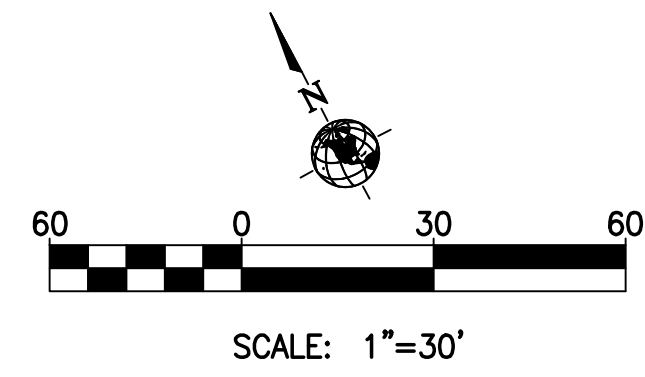

SWPPP LEGEND

- REINFORCED FILTER FABRIC BARRIER AT LEAST 2' BEHIND BACK OF CURB/PAVEMENT
- STABILIZED CONSTRUCTION EXIT.
- INLET PROTECTION BARRIER (IPB).
- WASH DOWN AREA.

SWPPP CONSTRUCTION NOTES


1. CONTRACTOR SHALL IMPLEMENT INLET PROTECTION DEVICES AND REINFORCED FILTER FABRIC BARRIER ALONG ROAD AND SIDE DITCHES AT LOCATION SHOWN ON THE TYPICAL STORM WATER POLLUTION PREVENTION (SWPPP) PLANS TO KEEP SILT AND /OR EXCAVATED MATERIALS FROM ENTERING INTO THE STORM WATER INLETS AND DITCHES EVENTUALLY POLLUTING THE RECEIVING STORM.
2. DURING THE EXCAVATION PHASE OF THE PROJECT, CONTRACTOR SHALL SCHEDULE THE WORK IN SHORT SEGMENTS SO THAT EXCAVATED MATERIAL CAN BE QUICKLY HAULED AWAY FROM THE SITE AND TO PREVENT IT FROM STAYING UNCOLLECTED ON THE EXISTING PAVEMENT. ANY LOOSE EXCAVATED MATERIAL WHICH FALLS ON PAVEMENTS OR DRIVEWAYS SHALL BE SWEEPED BACK INTO THE EXCAVATED AREA.
3. CONTRACTOR SHALL CLEAN UP THE EXISTING STREET INTERSECTIONS AND DRIVEWAYS DAILY, AS NECESSARY, TO REMOVE ANY EXCESS MUD, SILT OR ROCK TRACKED FROM THE EXCAVATED AREA.
4. CONTRACTOR SHALL FOLLOW GOOD HOUSEKEEPING PRACTICES DURING THE CONSTRUCTION OF THE PROJECT ALWAYS CLEANING UP DIRT AND LOOSE MATERIAL AS CONSTRUCTION PROGRESSES.
5. CONTRACTOR TO INSPECT AND MAINTAIN THE AREAS LISTED BELOW AT LEAST ONCE EVERY FOURTEEN (14) CALENDAR DAYS AND WITHIN 24 HOURS OF THE END OF A STORM EVENT OF 0.5 INCHES OR GREATER.
 - DISTURBED AREAS OF THE CONSTRUCTION SITE THAT HAVE NOT BEEN FINALLY STABILIZED.
 - AREAS USED FOR STORAGE OF MATERIALS THAT ARE EXPOSED TO PRECIPITATION.
 - STRUCTURAL CONTROL MEASURES.
 - LOCATIONS WHERE VEHICLES ENTER OR EXIT THE SITE.
6. CONTRACTOR TO BE RESPONSIBLE TO MAINTAIN EXISTING DITCHES AND/OR CULVERTS FOR UNOBSTRUCTED DRAINAGE AT ALL TIMES. WHERE SODDING IS DISTURBED BY EXCAVATION OR BACKFILLING OPERATIONS, SUCH AREAS SHALL BE REPLACED BY SEEDING OR SODDING.
SLOPES 4:1 OR STEPPER SHALL BE REPLACED BY CLOCK SODDING.

CONCRETE TRUCK/EQUIPMENT WASH OUT

1. CONTRACTOR(S) SHALL NOT WASH OUT CONCRETE TRUCKS OR EQUIPMENT INTO STREET DEAD ENDS, RIGHT-OF-WAYS, GUTTERS, STORM SEWER INLETS, WATERWAYS, CREEKS OR ANY LOCATION WHERE THE MATERIALS COULD REACH THE STORM SEWER (MS4) SYSTEM. ROCKED CUL-DE-SACS ARE NOT APPROVED WASH OUT AREAS. ALL DEPOSITED MATERIALS SHALL BE REMOVED AND PROPERLY DISPOSED OF AT THE COMPLETION OF WORK.
2. WASH OUT CONCRETE TRUCKS AND/OR EQUIPMENT ONLY IN A DESIGNATED, CONFINED WASHOUT AREA WHERE THE WATER WILL FLOW INTO A TEMPORARY PIT IN A DIRT AREA OR ONTO STOCKPILES OF AGGREGATE BASE OR SAND. THIS AREA MUST BE AN IDENTIFIED LOCATION.
3. COLLECT AND RETURN SWEEPINGS FROM EXPOSED AGGREGATE CONCRETE TO A STOCKPILE OR DISPOSE OF THE WASTE IN A TRASH CONTAINER.

**ONE- CALL NOTIFICATION SYSTEM
CALL BEFORE YOU DIG!!!**
(713) 223-4567 (In Houston, TX)
(New Statewide Number Outside Houston)
1-800-545-6005

KEY PLAN (NOT TO SCALE)

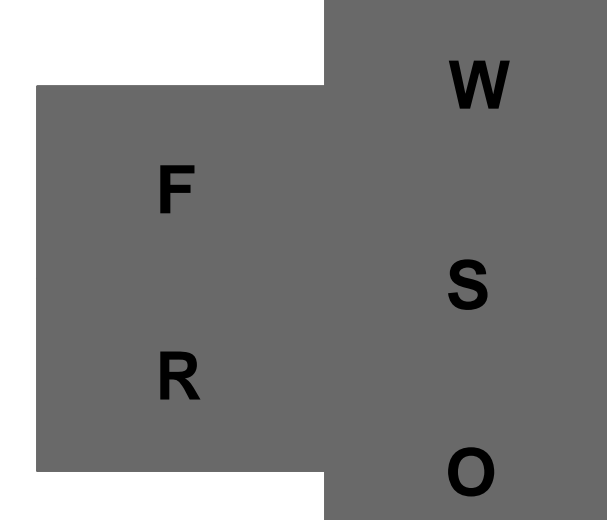

REVISION HISTORY	
ADDENDUM NO. 3	10-07-2020

REVISION	DESCRIPTION	DATE
PROFESSIONAL SEALS		


10/07/2020

SWPPP PLAN

DRAWN BY JDM	CHECKED BY JDM
PROJECT NUMBER 418198	PROJECT ABBREVIATION GC-PB2
ORIGINAL ISSUE ISSUE FOR PERMIT	DATE 07 OCT 2020

C13.0-PH2
SHEET NUMBER



Galveston County
Road & Bridge Department Facilities PH2
5115 Texas Highway 3
Dickinson, TX

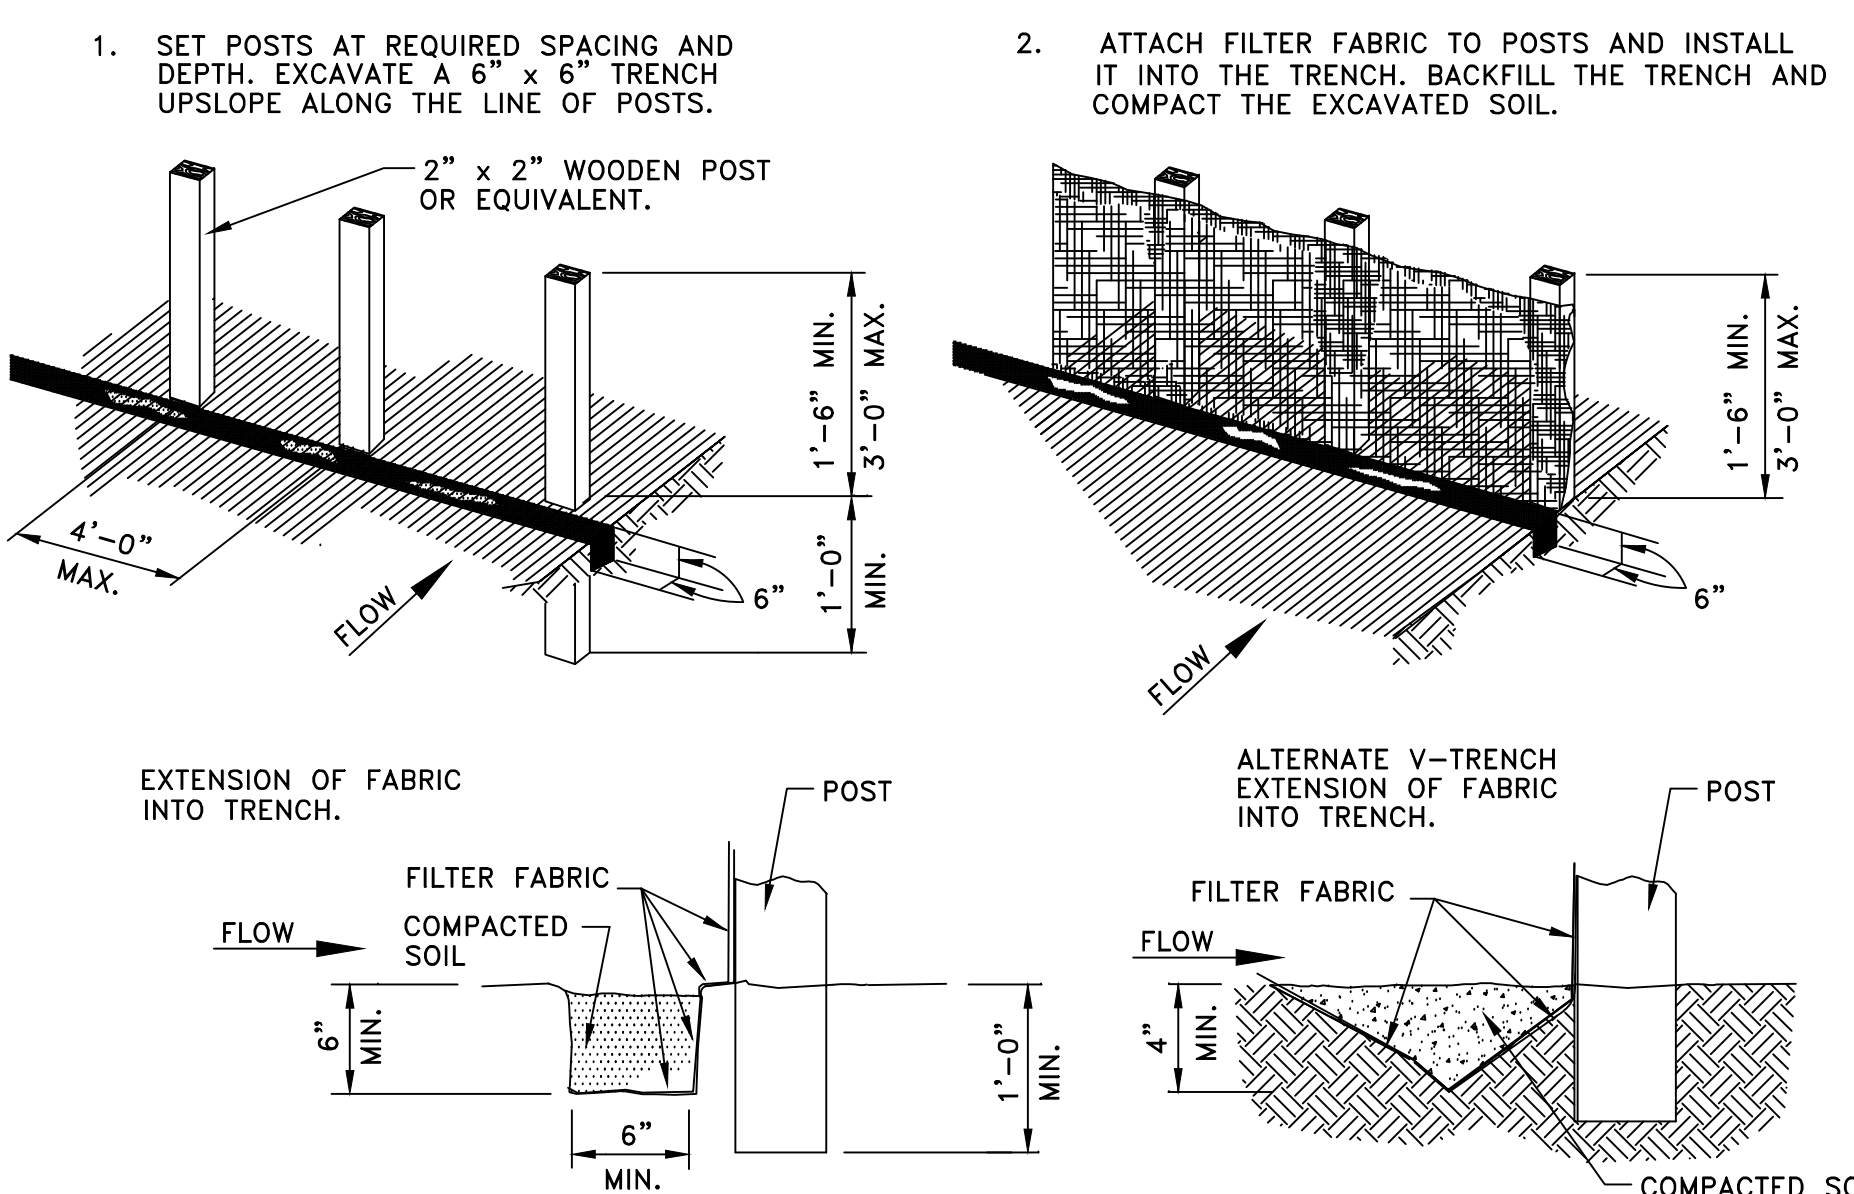

GENERAL NOTES:

1. SET POSTS AT 4- FEET MAXIMUM SPACING. IF FACTORY PREASSEMBLED FENCE WITH SUPPORT NETTING IS USED, SPACING OF POST MAY BE INCREASED TO 8 FEET MAXIMUM.
2. WHEN TWO SECTIONS OF FILTER FABRIC ADJOIN EACH OTHER, OVERLAP 6 INCHES AT THE POST, FOLD TOGETHER, AND ATTACH TO THE POSTS.
3. REMOVE SEDIMENT DEPOSITS WHEN SILT DEPTH REACHES ONE-THIRD OF THE HEIGHT OF THE FENCE.



FILTER FABRIC FENCE

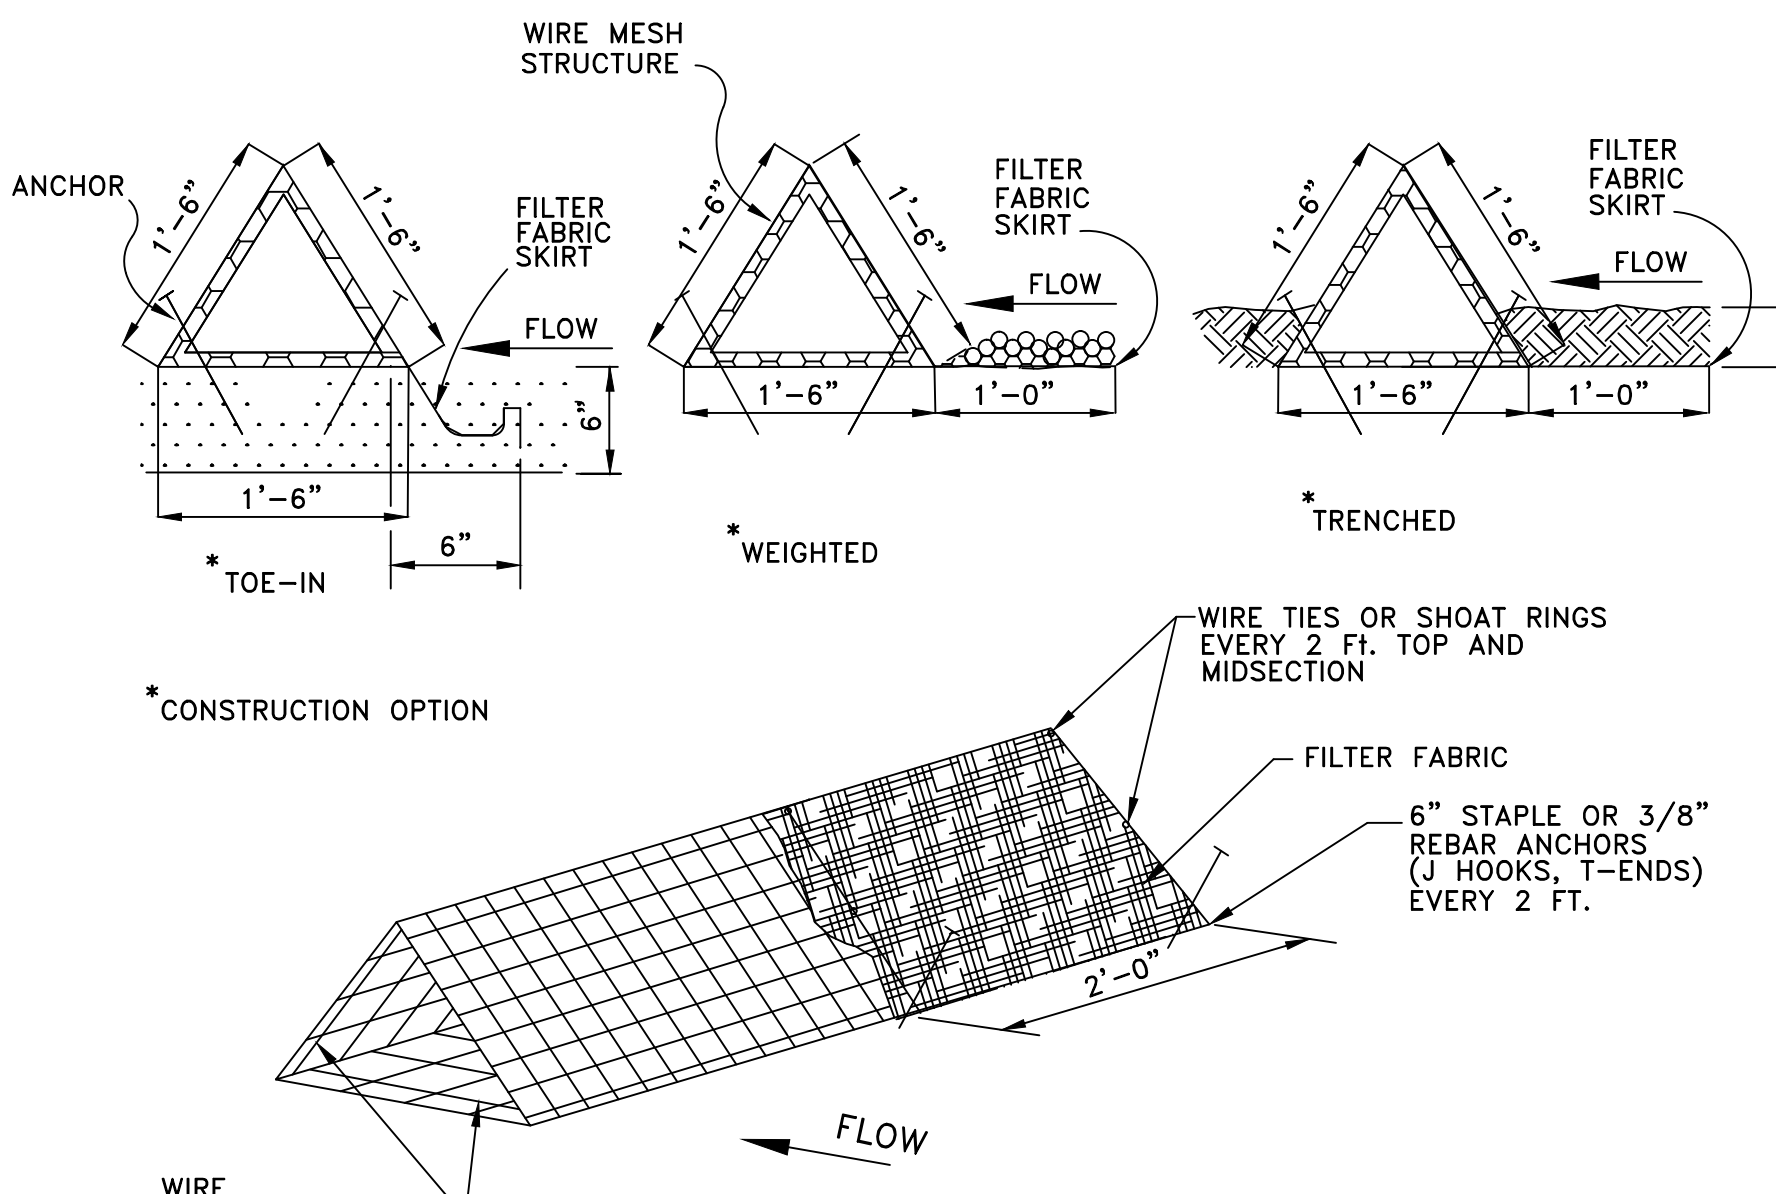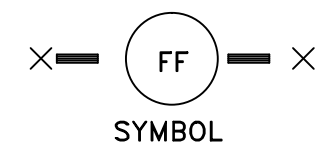

GENERAL NOTES:

1. PLACE BARRIER IN A ROW WITH ENDS TIGHTLY ABUTTING THE ADJACENT BARRIER.
2. USING ONE CONTINUOUS SECTION OF FILTER FABRIC, WRAP FABRIC AROUND WIRE MESH AND EXTEND FABRIC TO FORM SKIRT ON THE UPSTREAM SIDE.
3. WEIGHT SKIRT WITH A CONTINUOUS LAYER OF 3-INCH TO 5-INCH OPEN GRADED ROCK, OR TOE IN SKIRT WITH SIX INCHES WITH MECHANICALLY COMPACTED MATERIAL.
4. SECURELY ANCHOR BARRIER AND SKIRT IN PLACE USING 6-INCH WIRE STAPLES ON 2-FOOT CENTERS ON BOTH EDGES, OR STAKE USING 18-INCH BY 3/8 INCH REBARS (T-ENDS, J-HOOKS).
5. FILTER FABRIC SHALL BE LAPPED OVER ENDS 6 INCHES TO COVER SEGMENT JOINTS. FASTEN JOINTS WITH GALVANIZED SHOAT RINGS OR EQUIVALENT.
6. THE BARRIER STRUCTURE SHALL BE WELDED WIRE MESH, 18 INCHES ON EACH SIDE.



TRIANGULAR FILTER FABRIC FENCE

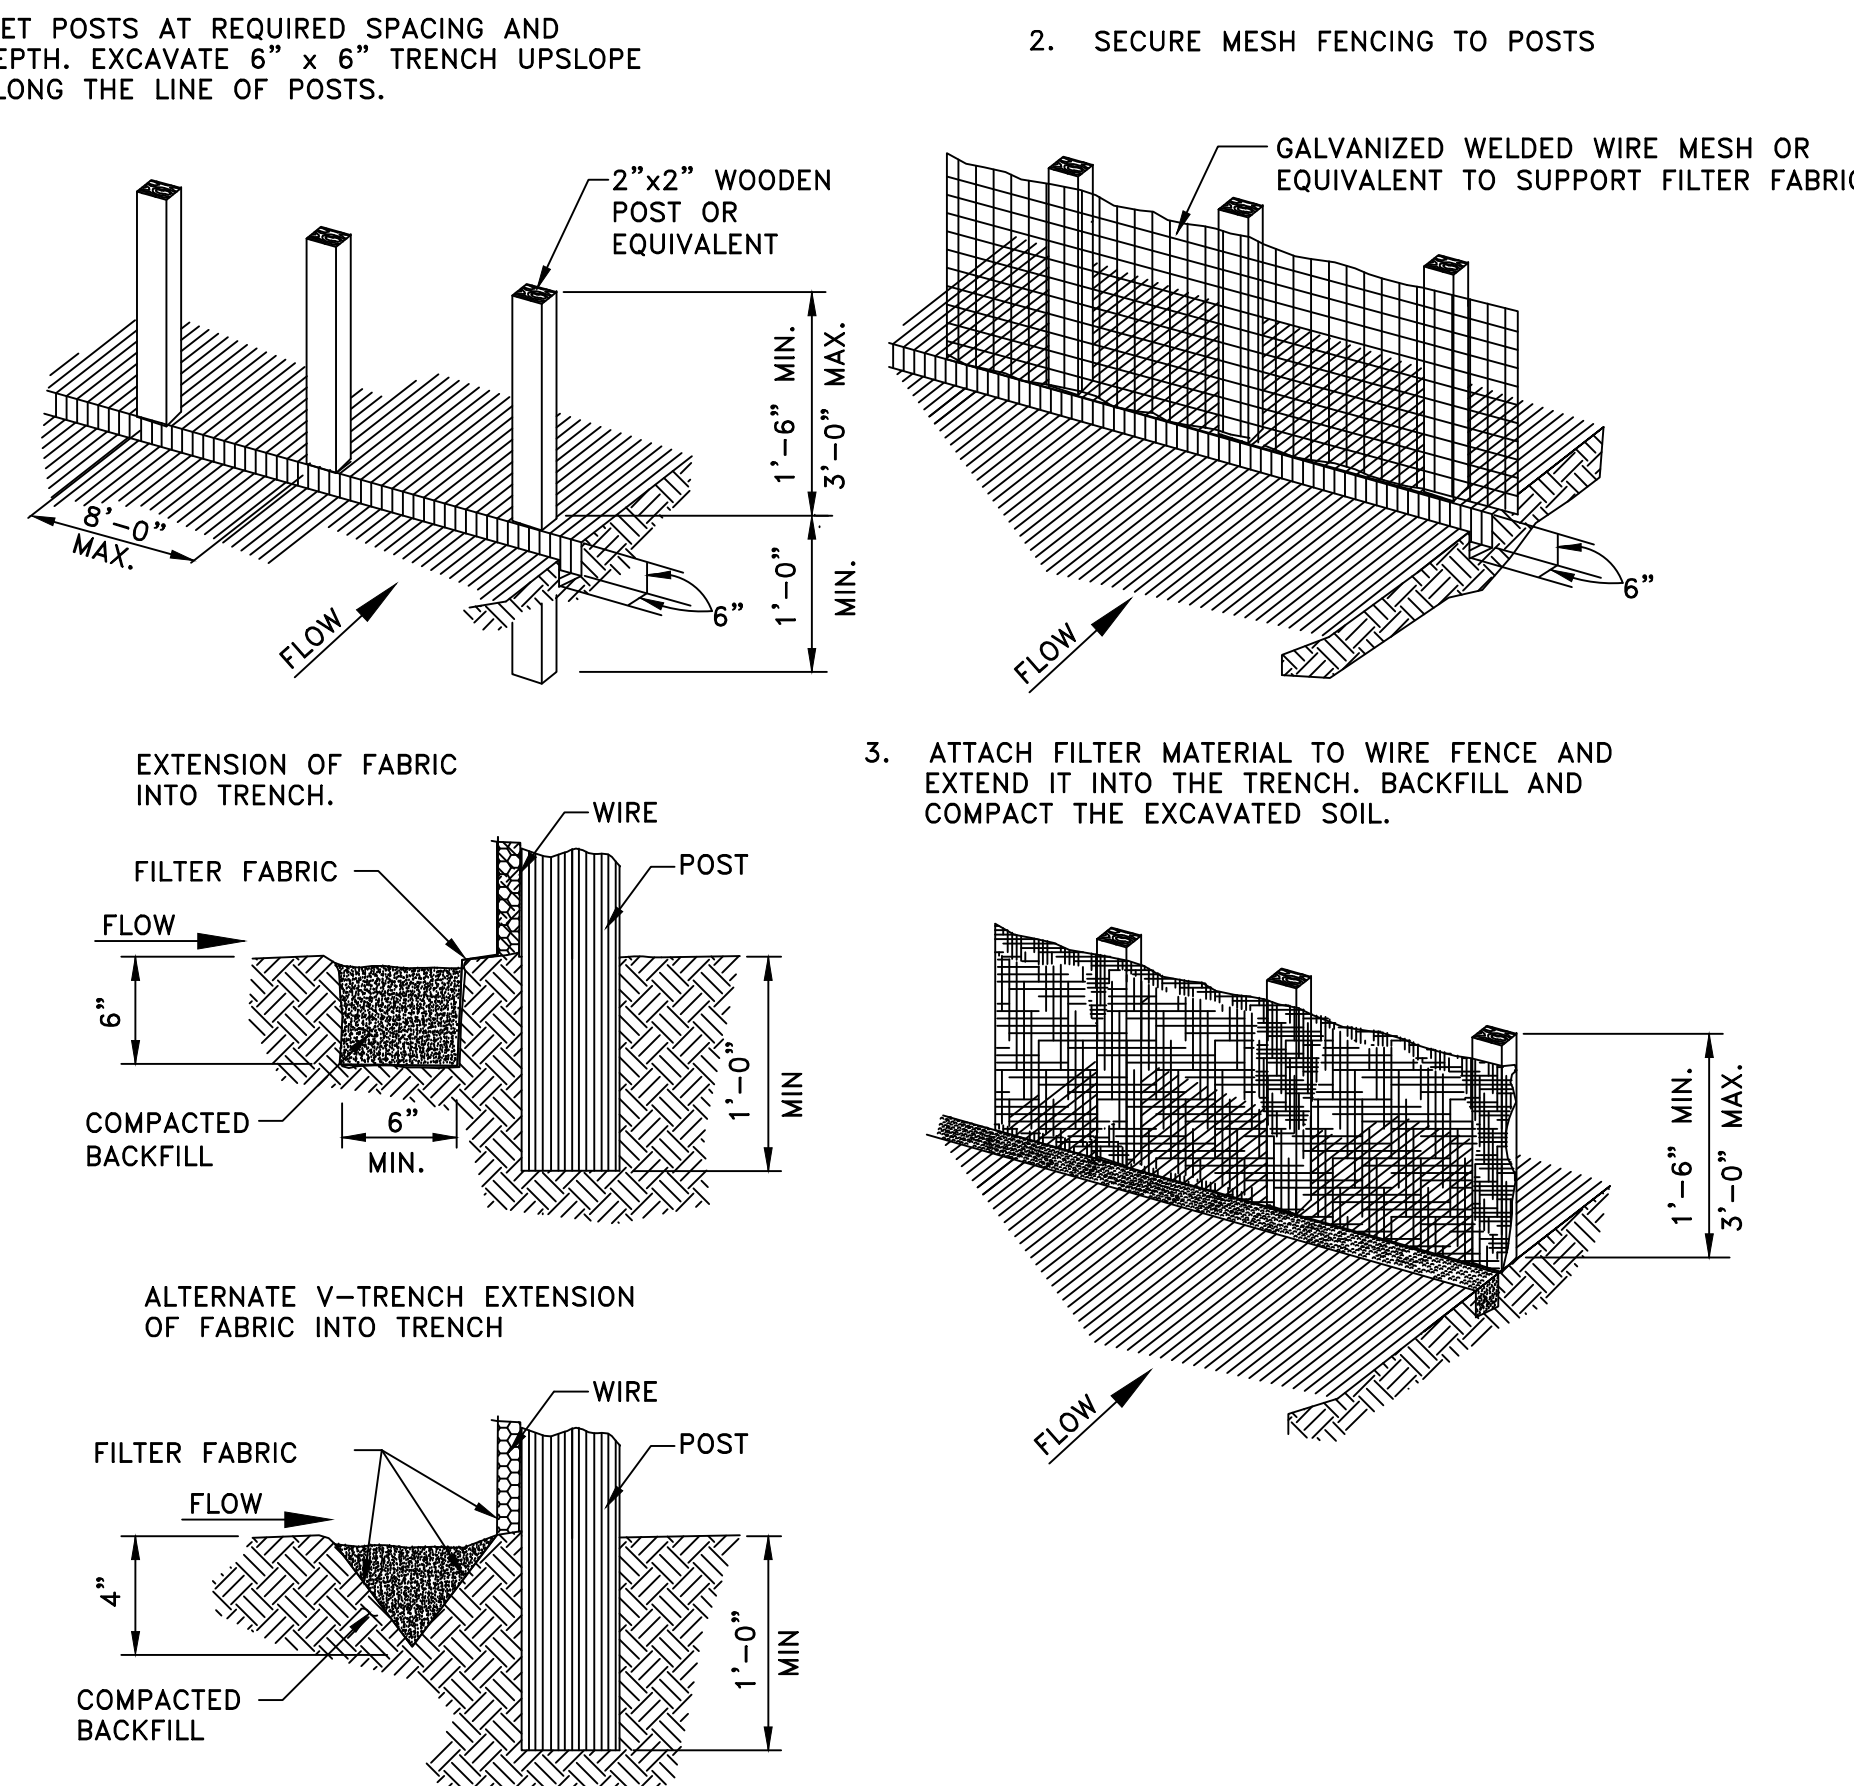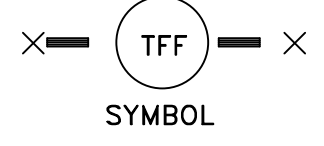

GENERAL NOTES:


1. SECURELY FASTEN MESH FENCING TO POSTS WITH STAPLES OR TIE WIRES.
2. SECURELY FASTEN FILTER FABRIC TO MESH FENCING.
3. WHEN TWO SECTIONS OF FILTER FABRIC ADJOIN EACH OTHER, OVERLAP 6 INCHES AT A POST, FOLD TOGETHER, AND ATTACH TO A POST.
4. REMOVE SEDIMENT DEPOSITS WHEN SILT REACHES ONE-THIRD OF THE HEIGHT OF THE FENCE IN DEPTH.

REINFORCED FILTER FABRIC BARRIER

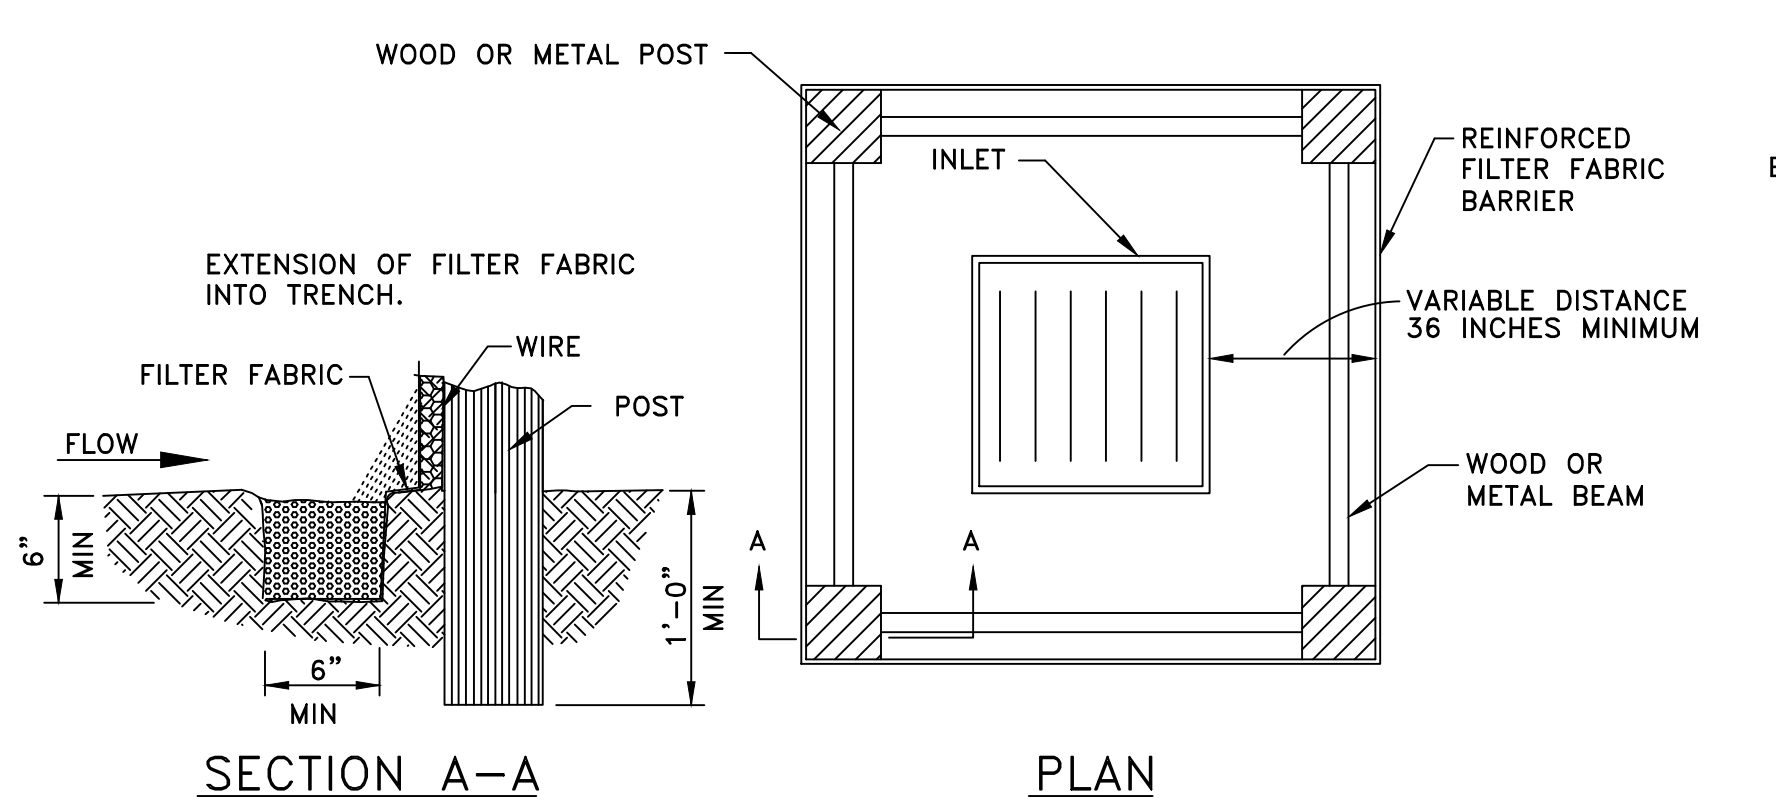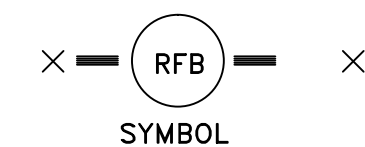

SECTION A-A

PLAN


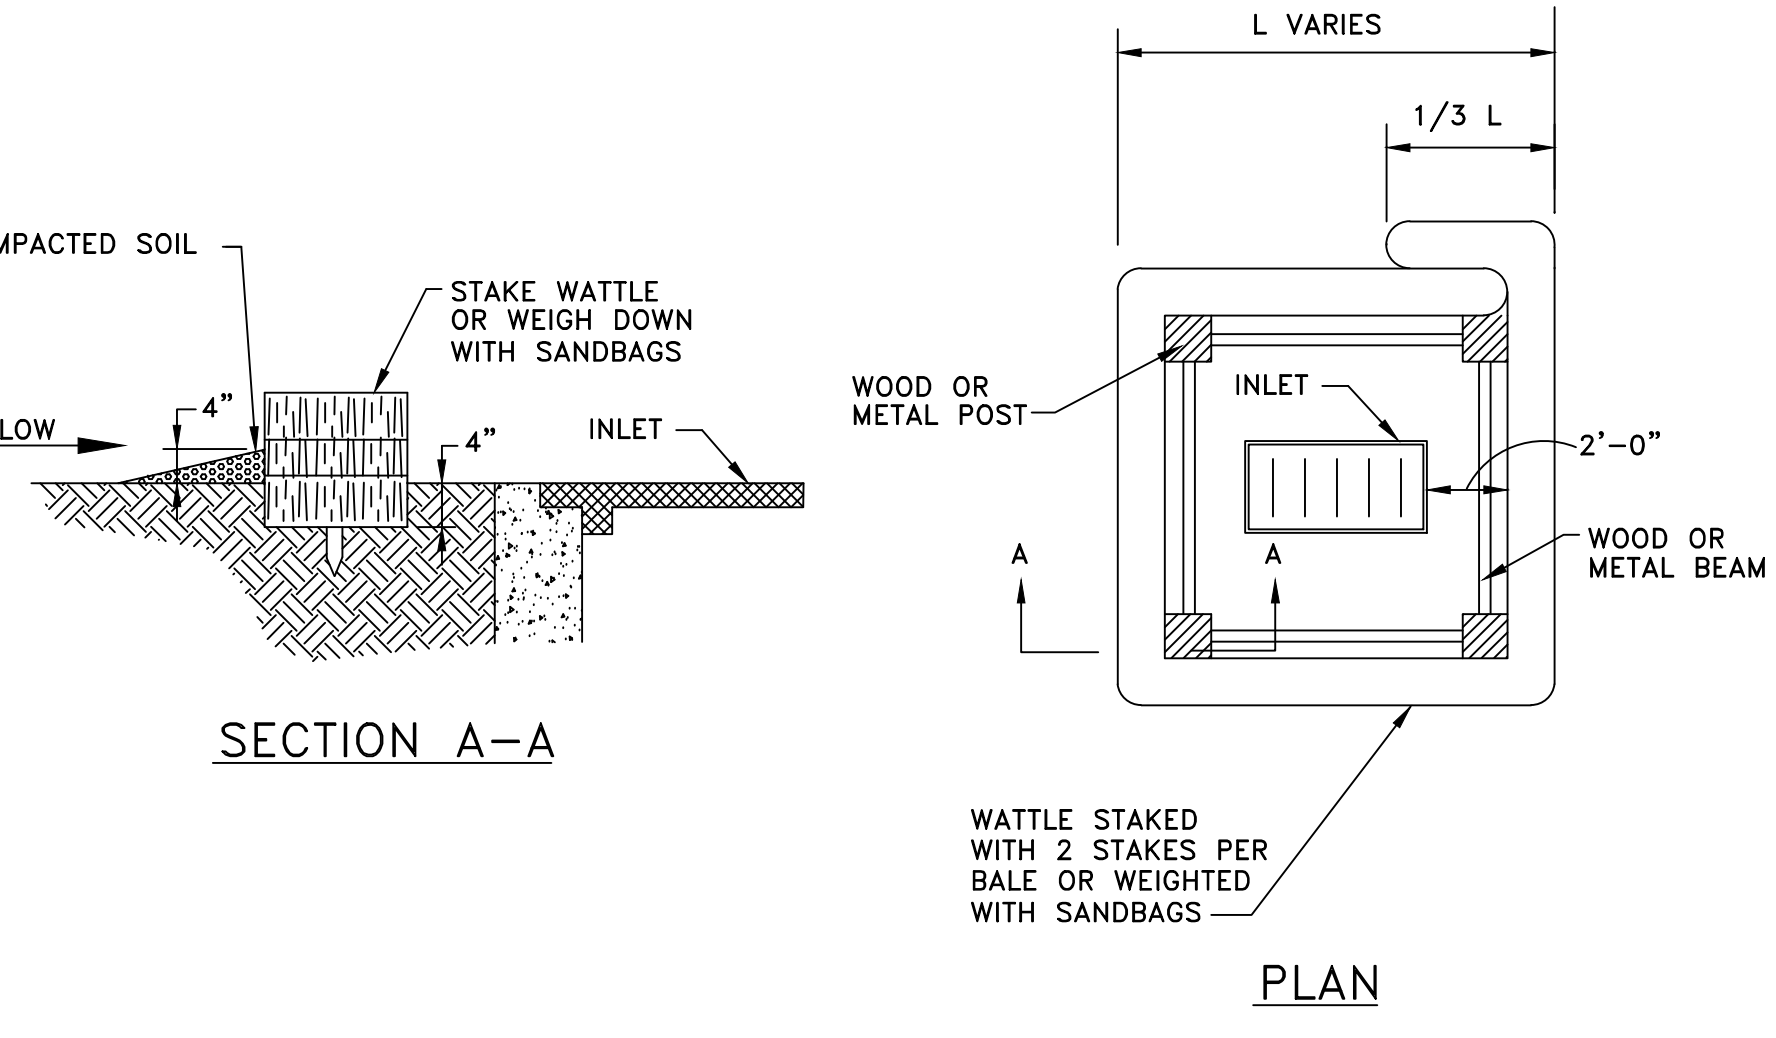


SECTION A-A

PLAN

NOTE: TYPICALLY STRAW BALES ARE NOT RECOMMENDED FOR INLET PROTECTION BARRIERS.



INLET PROTECTION BARRIERS FOR STAGE I INLETS

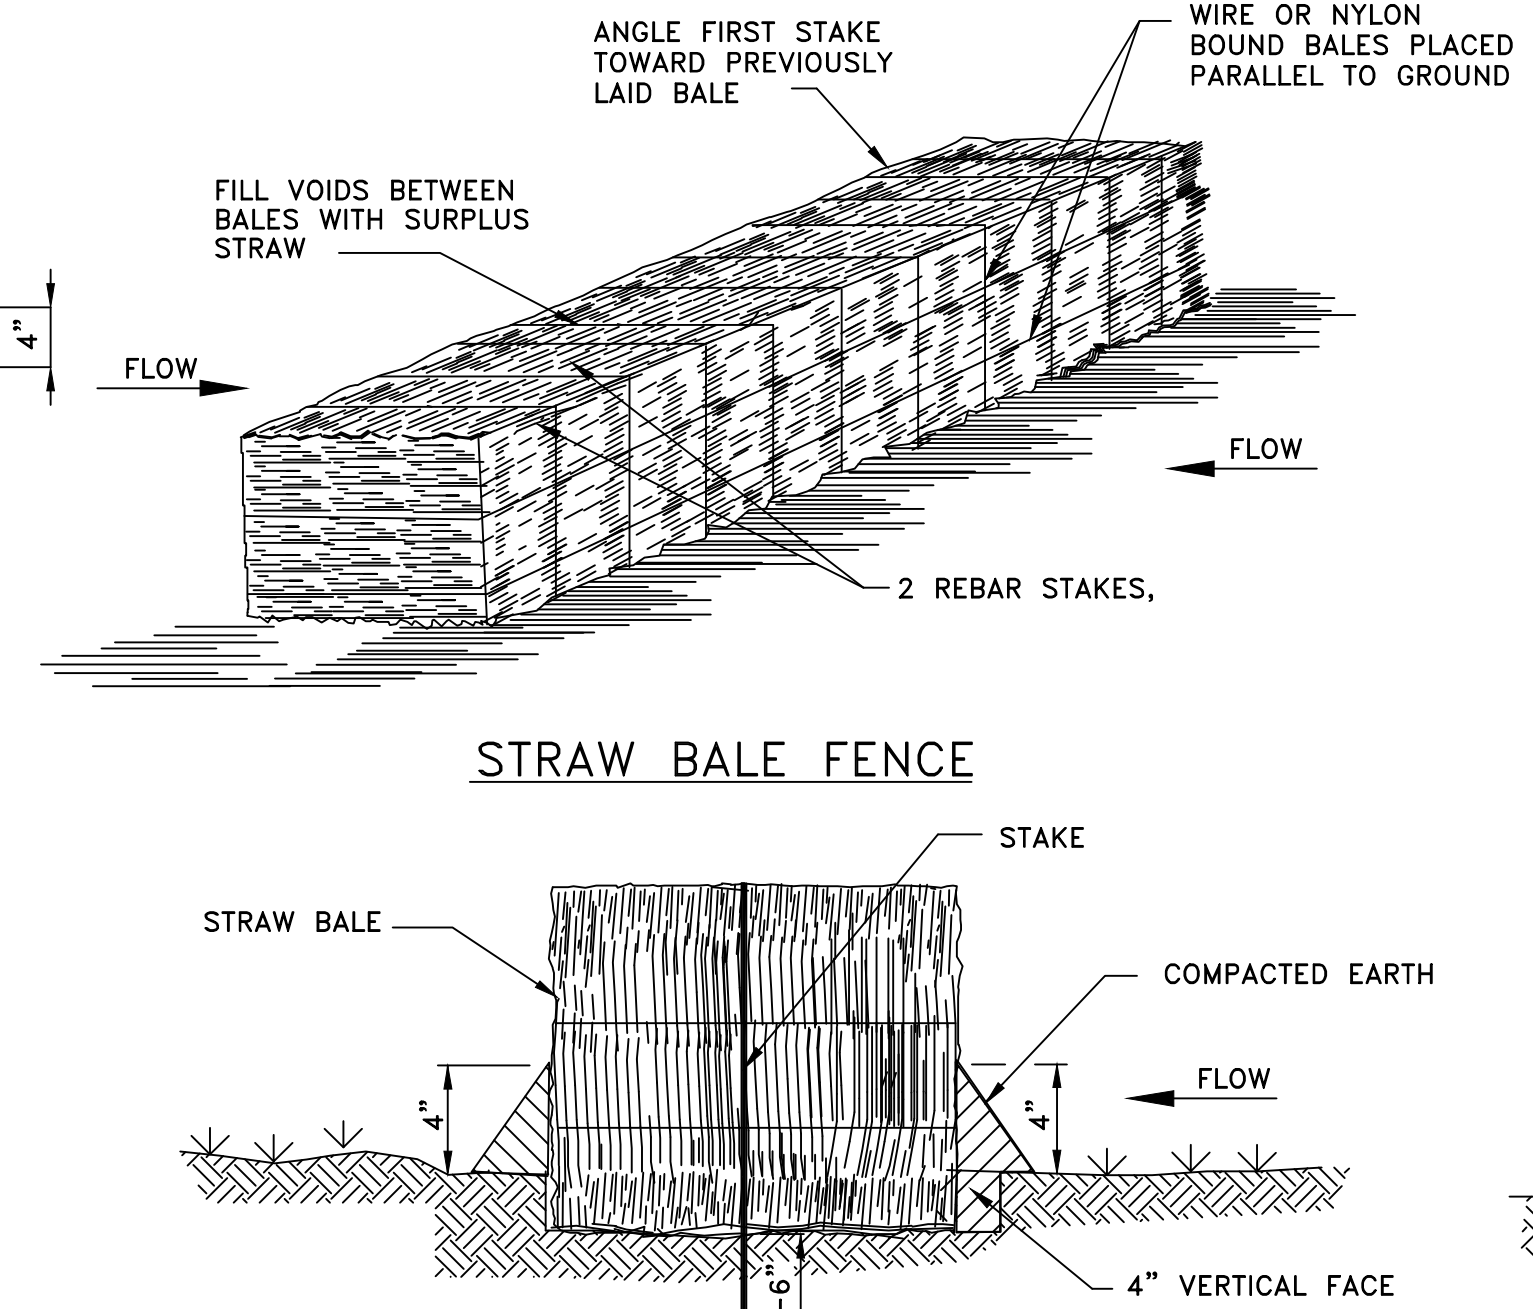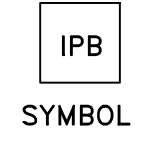


GENERAL NOTES:

1. LIMIT USE TO ONSITE SWALES FOR PURPOSES OF LOW FLOW VELOCITY DISSIPATION FOR EROSION CONTROL. USE STRAW BALE FENCES TO TREAT OVERLAND FLOW ONLY. DO NOT USE STRAW BALE FENCES TO TREAT FLOW IN CHANNELS.
2. PLACE BALES IN A ROW WITH ENDS TIGHTLY ABUTTING ADJACENT BALES. FILL THE VOIDS BETWEEN BALES WITH SURPLUS STRAW. PLACE BALES WITH BINDING PARALLEL TO GROUND SURFACE.
3. IMBED EACH BALE AT LEAST 4 INCHES IN THE SOIL.
4. SECURELY ANCHOR BALES IN PLACE BY REBAR STAKES. DRIVE STAKES THROUGH THE BALES AND AT LEAST 18 INCHES INTO THE GROUND. ANGLE THE STAKE IN EACH BALE TOWARD THE PREVIOUS BALE TO FORCE THE BALES TOGETHER.
5. BIND BALES WITH WIRE OR NYLON ROPE TIED ACROSS THE STRAW BALES.
6. REPLACE WITH NEW STRAW BALE FENCE EVERY TWO MONTHS.
7. WATTLES STAKED INTO THE GROUND ARE A PREFERRED SUBSTITUTE FOR STRAW BALE FENCES.

STRAW BALE FENCE

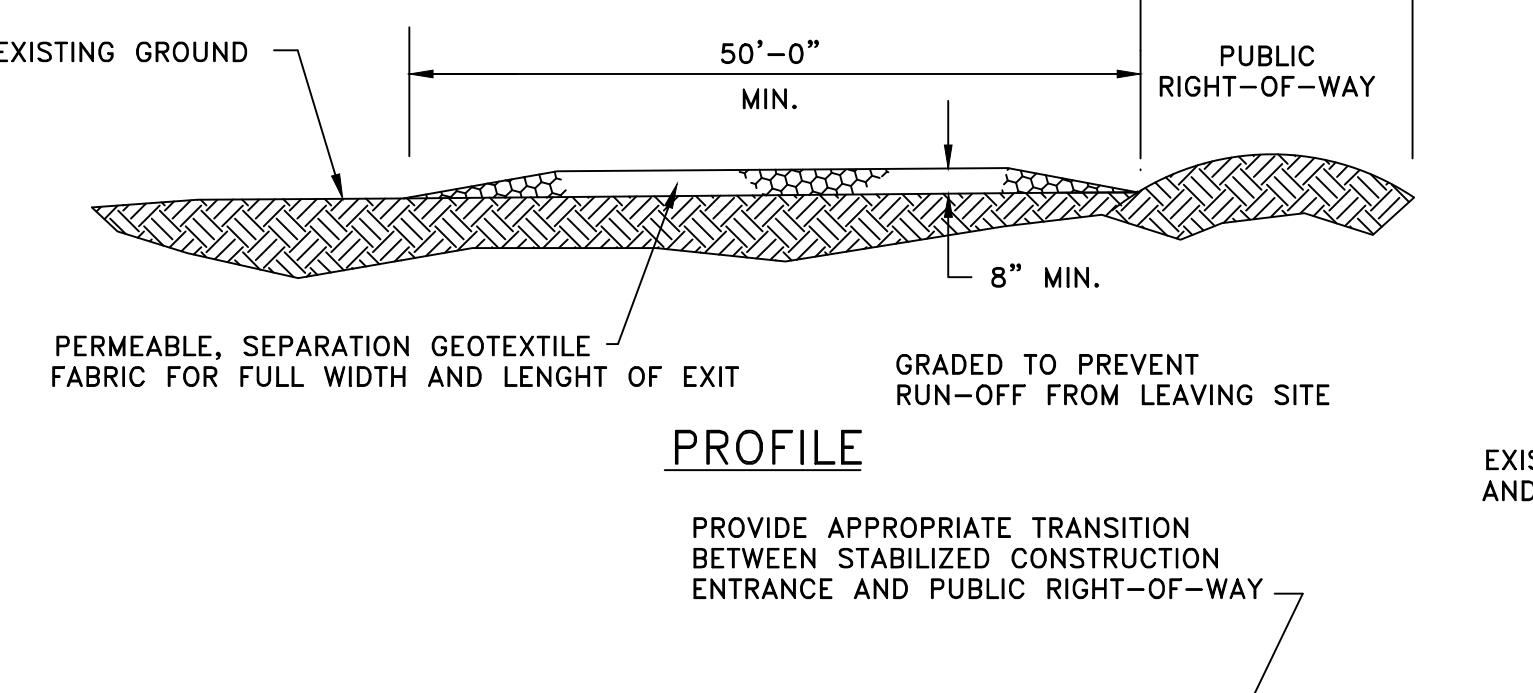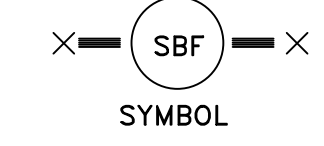

PROFILE

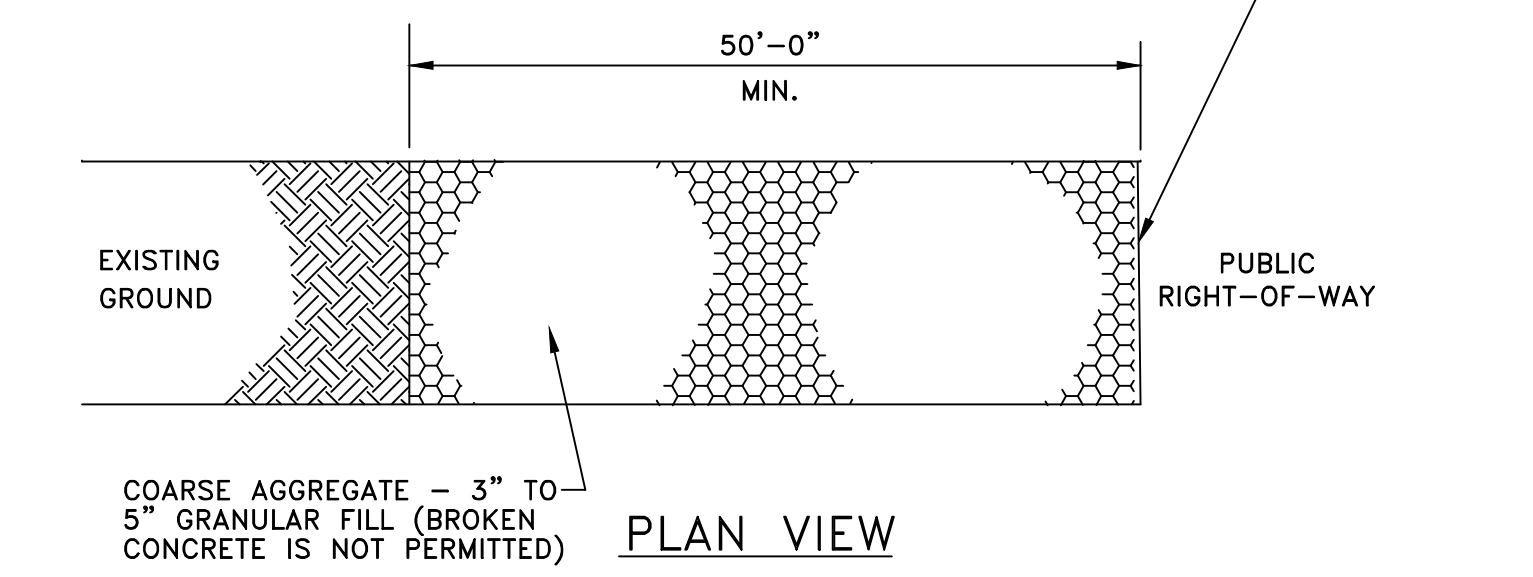


PLAN VIEW


GENERAL NOTES:

1. MINIMUM LENGTH IS AS SHOWN ON CONSTRUCTION DRAWINGS OR 50 FEET, WHICHEVER IS MORE.
2. CONSTRUCT AND MAINTAIN CONSTRUCTION EXIT WITH CONSTANT WIDTH ACROSS ITS LENGTH, INCLUDING ALL POINTS OF INGRESS OR EGRESS.
3. UNLESS SHOWN ON THE CONSTRUCTION DRAWINGS, STABILIZATION FOR OTHER AREAS WILL HAVE THE SAME AGGREGATE THICKNESS AND WIDTH REQUIREMENTS AS THE STABILIZED CONSTRUCTION EXIT.
4. WHEN SHOWN ON THE CONSTRUCTION DRAWINGS, WIDEN OR LENGTHEN STABILIZED AREA TO ACCOMMODATE A TRUCK WASHING AREA. PROVIDE OUTLET SEDIMENT TRAP FOR THE TRUCK WASHING AREA.
5. PROVIDE PERIODIC TOP DRESSING WITH ADDITIONAL COARSE AGGREGATE TO MAINTAIN THE REQUIRED DEPTH OR WHEN SURFACE BECOMES PACKED WITH MUD.
6. PERIODICALLY TURN AGGREGATE TO EXPOSE A CLEAN DRIVING SURFACE.
7. ALTERNATIVE METHODS OF CONSTRUCTION INCLUDE
-CEMENT STABILIZED SOIL: COMPACTED CEMENT STABILIZED SOIL, LIMESTONE AGGREGATE, OR OTHER FILL MATERIAL IN AN APPLICATION OF THICKNESS OF 8 INCHES.
-WOOD MATS: OAK OR OTHER HARDWOOD TIMBERS PLACED EDGE TO EDGE AND ACROSS SUPPORT WOODEN BEAMS WHICH ARE PLACED ON TOP OF EXISTING SOIL IN AN APPLICATION THICKNESS OF 6 INCHES.
-STEEL MATS: PERFORATED MATS PLACED ACROSS PERPENDICULAR SUPPORT MEMBERS.


STABILIZED CONSTRUCTION ACCESS

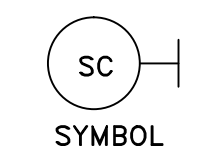

INLET PROTECTION BARRIERS FOR STAGE II INLETS

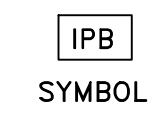



SYMBOL

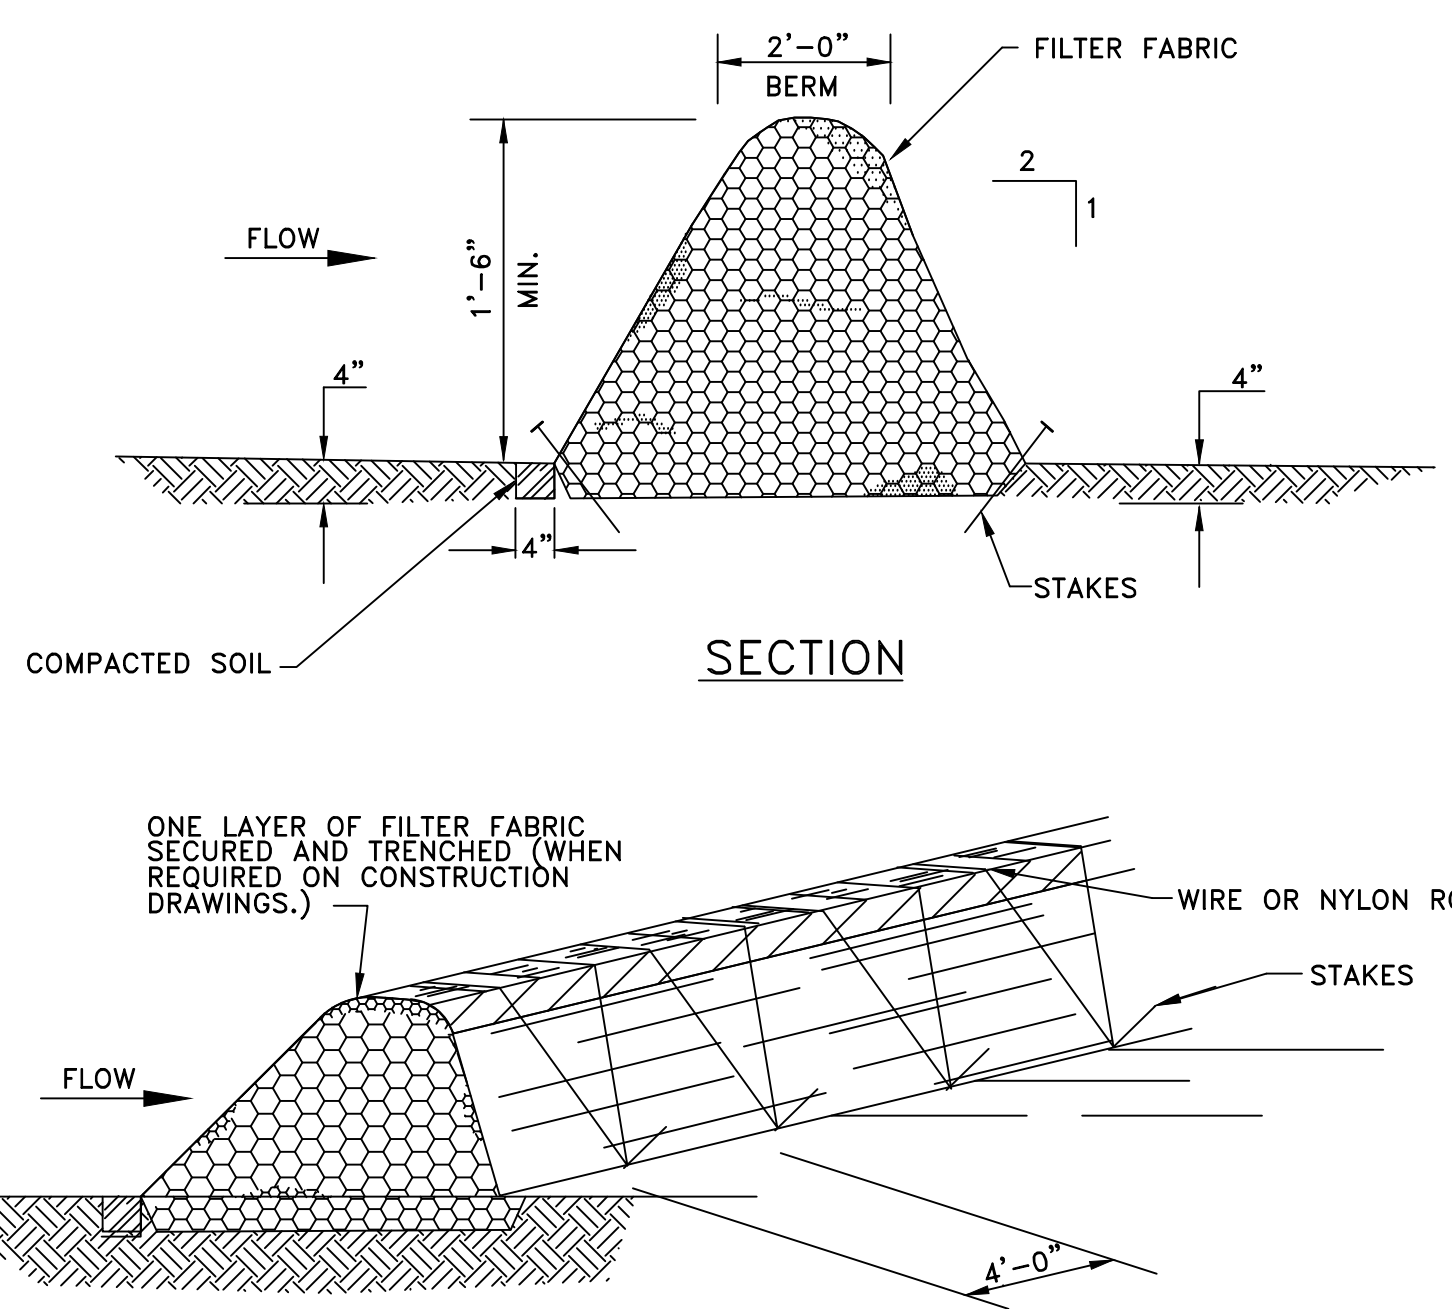

GENERAL NOTES:

1. LIMIT USE TO ONSITE SWALES FOR PURPOSES OF LOW FLOW VELOCITY DISSIPATION FOR EROSION CONTROL. USE BRUSH BERMS TO TREAT OVERLAND FLOW ONLY. DO NOT USE BRUSH BERMS TO TREAT FLOW IN CHANNELS.
2. PLACE WOODY BRUSH AND BRANCHES HAVING A DIAMETER OF LESS THAN 2 INCHES WITH A 6-INCH OVERLAP. AVOID INCORPORATION OF ANNUAL WEEDS AND SOIL INTO BRUSH BERM.
3. MINIMUM HEIGHT OF THE BRUSH BERM IS 18 INCHES, MEASURED FROM THE TOP OF THE EXISTING GROUND AT THE UPSLOPE TOE TO THE TOP OF THE BERM.
4. HAND PLACE BRUSH BERMS ALONG CONTOUR LINES. MACHINE PLACEMENT OF BRUSH BERMS IS NOT PERMITTED.
5. IMBED BRUSH BERM AT LEAST 4 INCHES INTO THE SOIL.
6. ANCHOR BRUSH BERMS USING WIRE OR NYLON ROPE ACROSS THE BERM WITH A MINIMUM TENSION OF 50 POUNDS.
7. SECURELY TIE ROPE TO 18-INCH REBAR STAKES DRIVEN INTO THE GROUND ON 4-FOOT CENTERS ON BOTH SIDES OF THE BERM.
8. PERFORM MAINTENANCE AS NEEDED.

BRUSH BERM

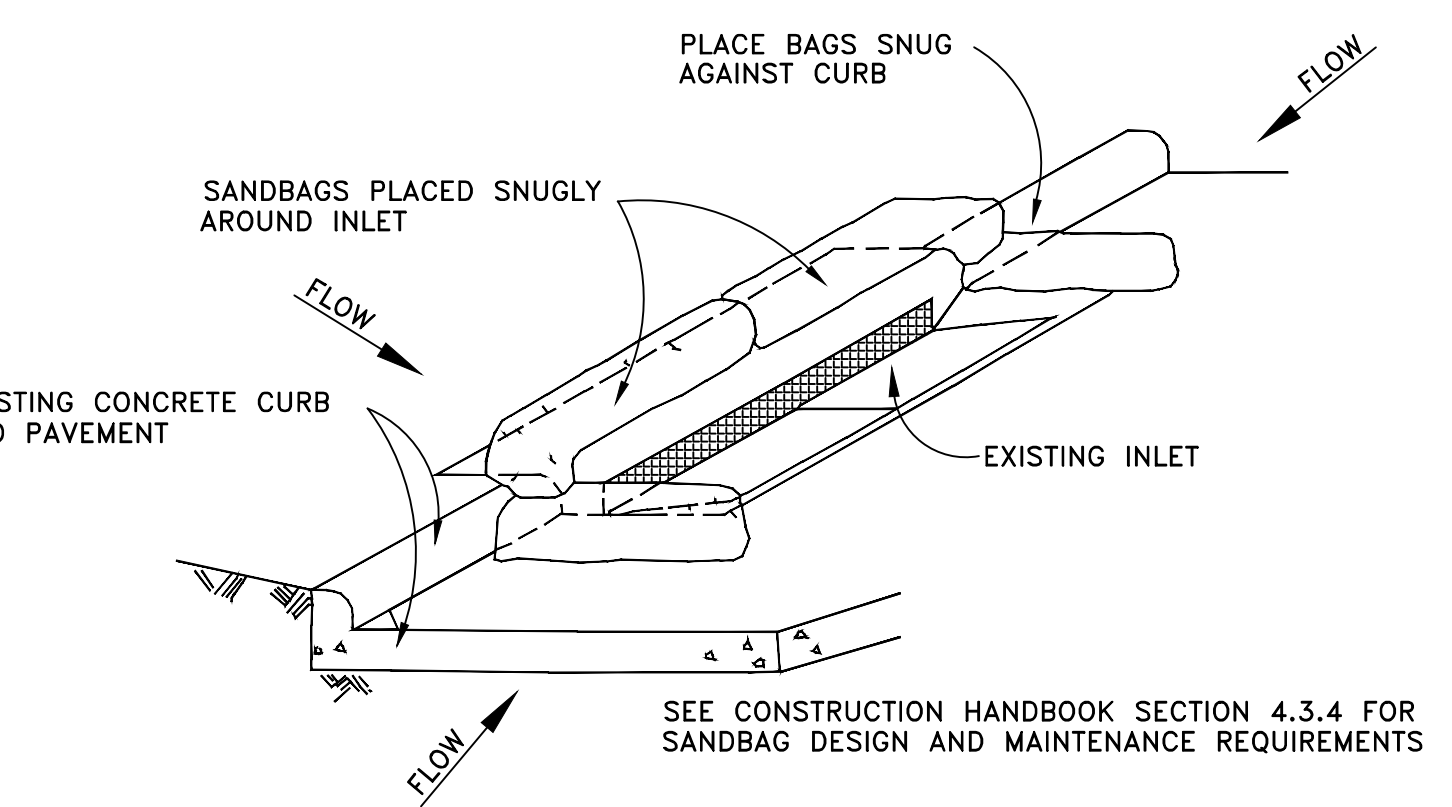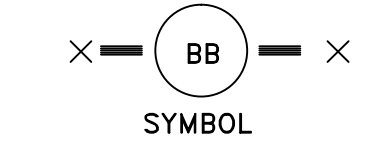

GENERAL NOTES:

1. BAGS OR WATTLES CAN BE USED FOR THIS APPLICATION.
2. PROVIDE WOVEN OR UNWOVEN GEOTEXTILE FILTER FABRIC FOR BAGS.
3. PROVIDE COARSE SAND AND AGGREGATE MIX FOR FILL MATERIAL FOR BAGS. USE ONLY PARTICLES CONSISTING OF CLEAN, HARD, DURABLE MATERIALS FREE FROM ADHERENT COATINGS, SALT, ALKALI, DIRT, CLAY, LOAM, SHALE, SOFT OR FLAKY MATERIALS, OR ORGANIC AND INJURIOUS MATTER.
4. REMOVE SEDIMENT DEPOSIT WHEN THE SEDIMENT HAS ACCUMULATED TO ONE-THIRD THE HEIGHT OF THE BARRIER.

ONE- CALL NOTIFICATION SYSTM
CALL BEFORE YOU DIG!!!
(713) 223-4567 (In Houston, TX)
(New Statewide Number Outside Houston)
1-800-545-6005

KEY PLAN (NOT TO SCALE)

W
F
S
R
O

REVISION HISTORY		
NO.	DESCRIPTION	DATE
1	ADDENDUM NO. 3	10-07-2020

PROFESSIONAL SEALS

10/07/2020

SWPPP DETAILS

DRAWN BY	CHECKED BY
JDM	JDM
PROJECT NUMBER 418198	PROJECT ABBREVIATION GC-REB
ORIGINAL ISSUE	DATE 07 OCT 2020
ISSUE FOR PERMIT	


C14.0-PH2
SHEET NUMBER

GALVESTON COUNTY ROAD & BRIDGE DEPARTMENT FACILITIES - PHASE 3


5115 TX- 3 DICKINSON, TX 77539

ISSUE FOR PERMIT

3 ADDENDUM NO.3 10/07/2020

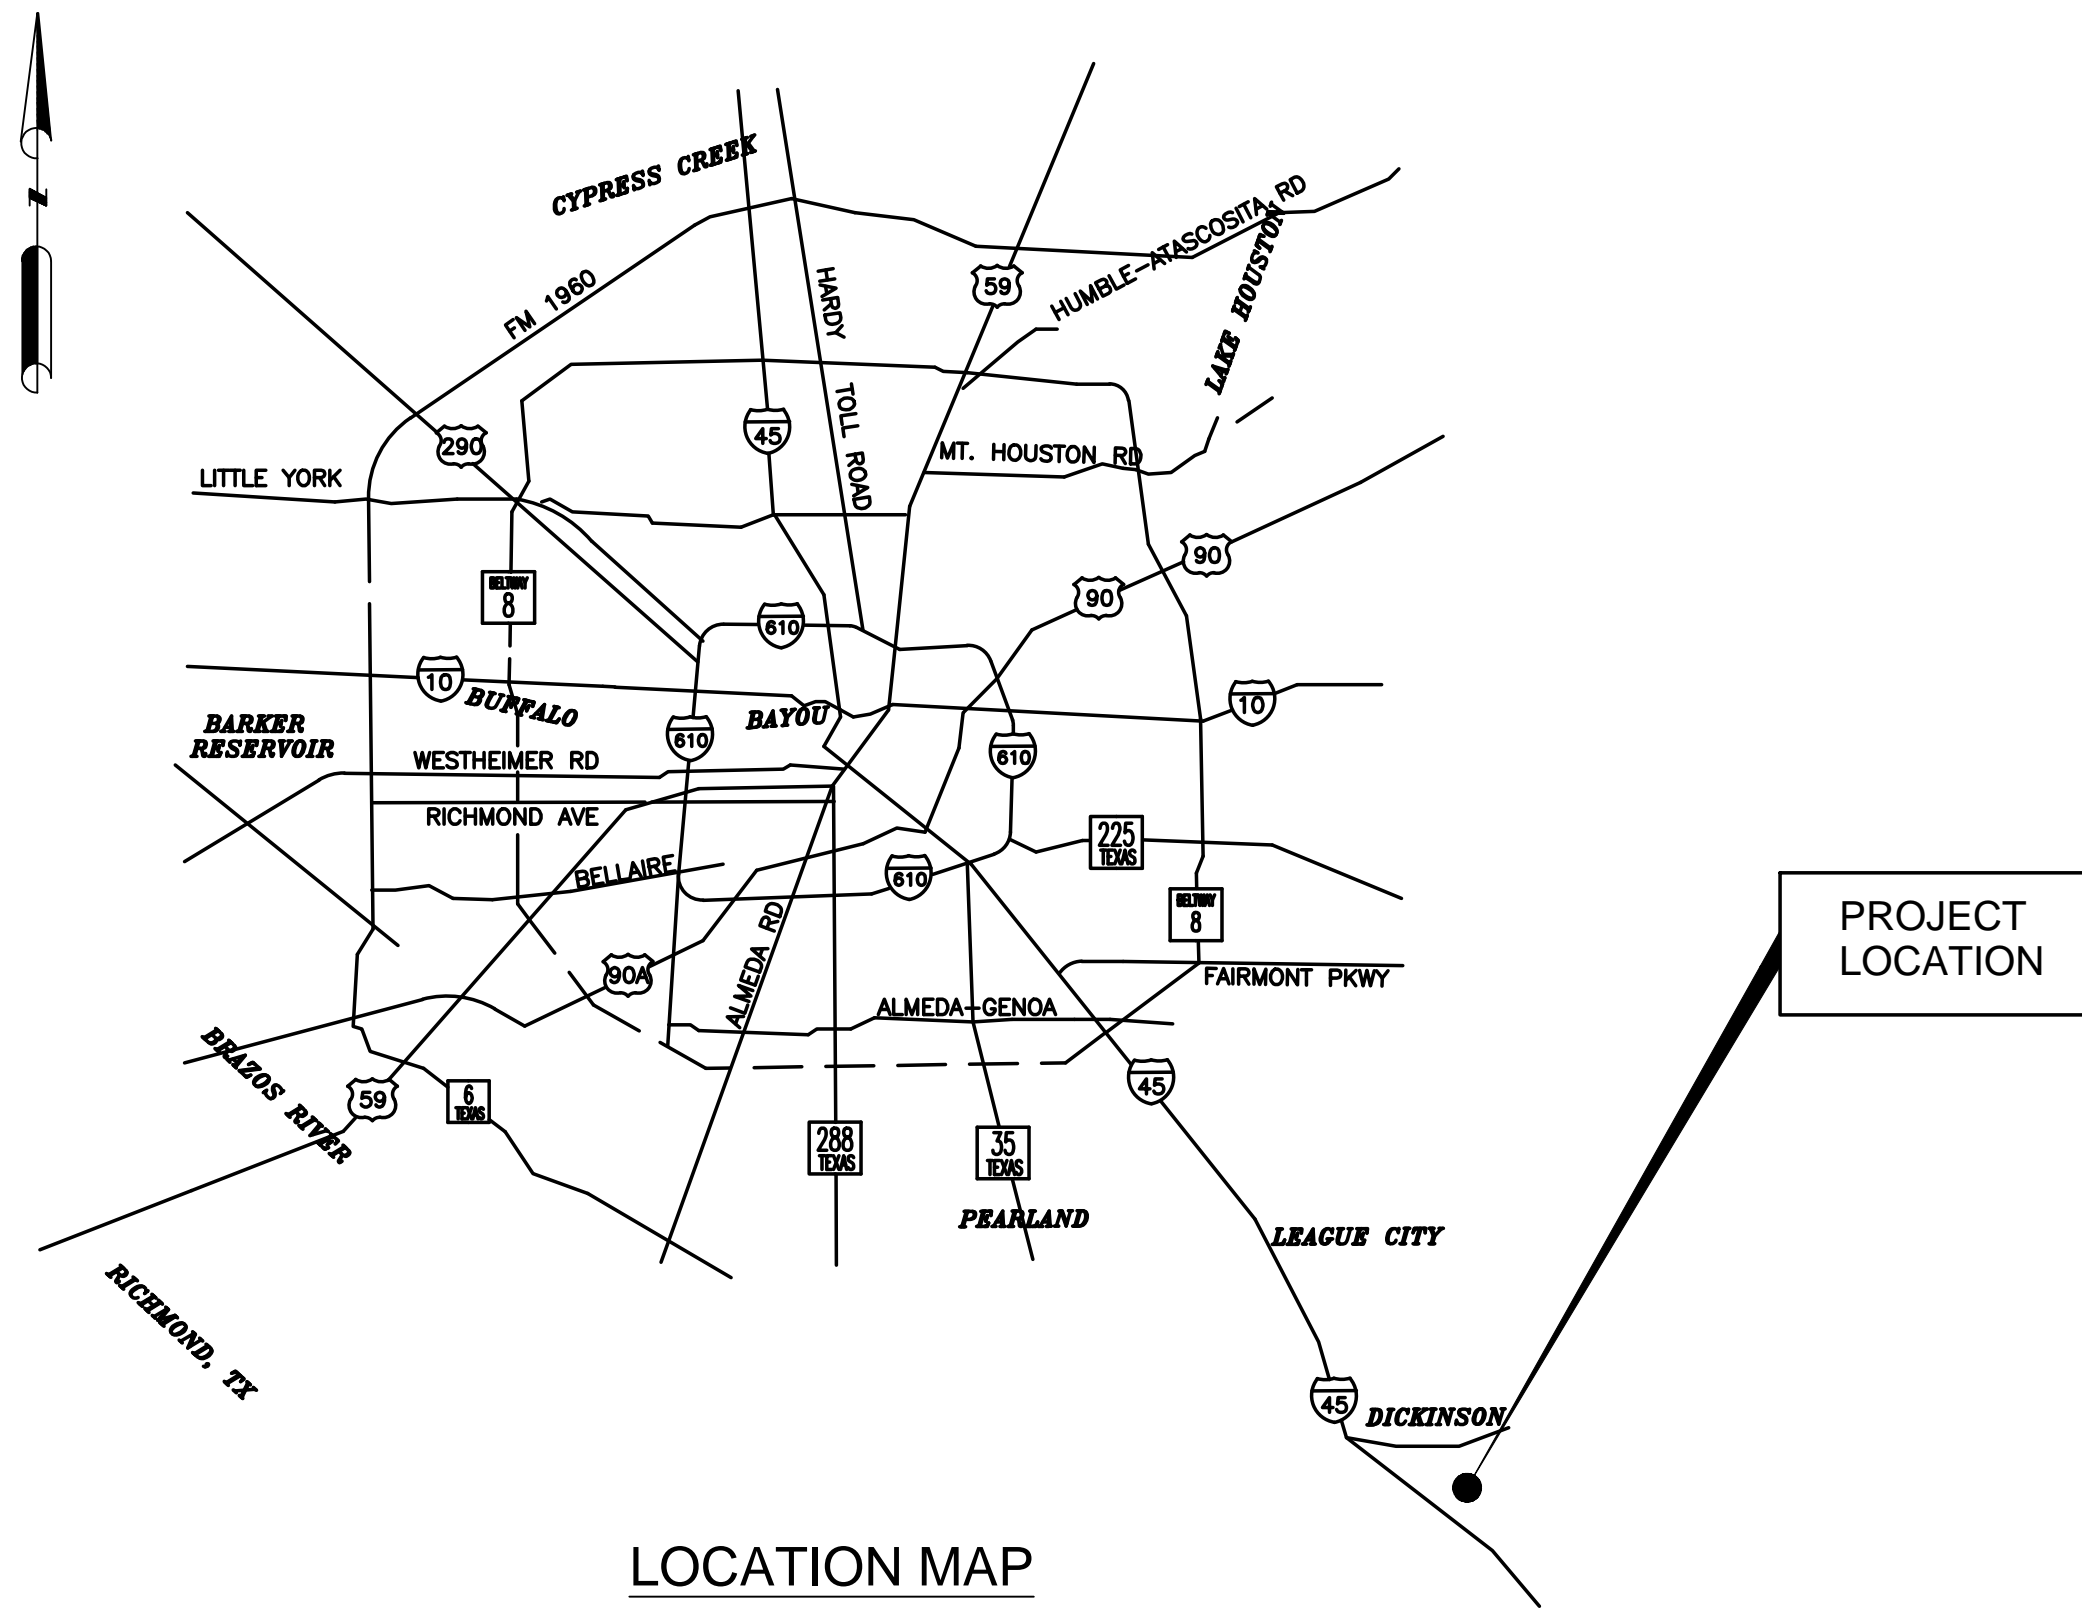

LOCATION MAP

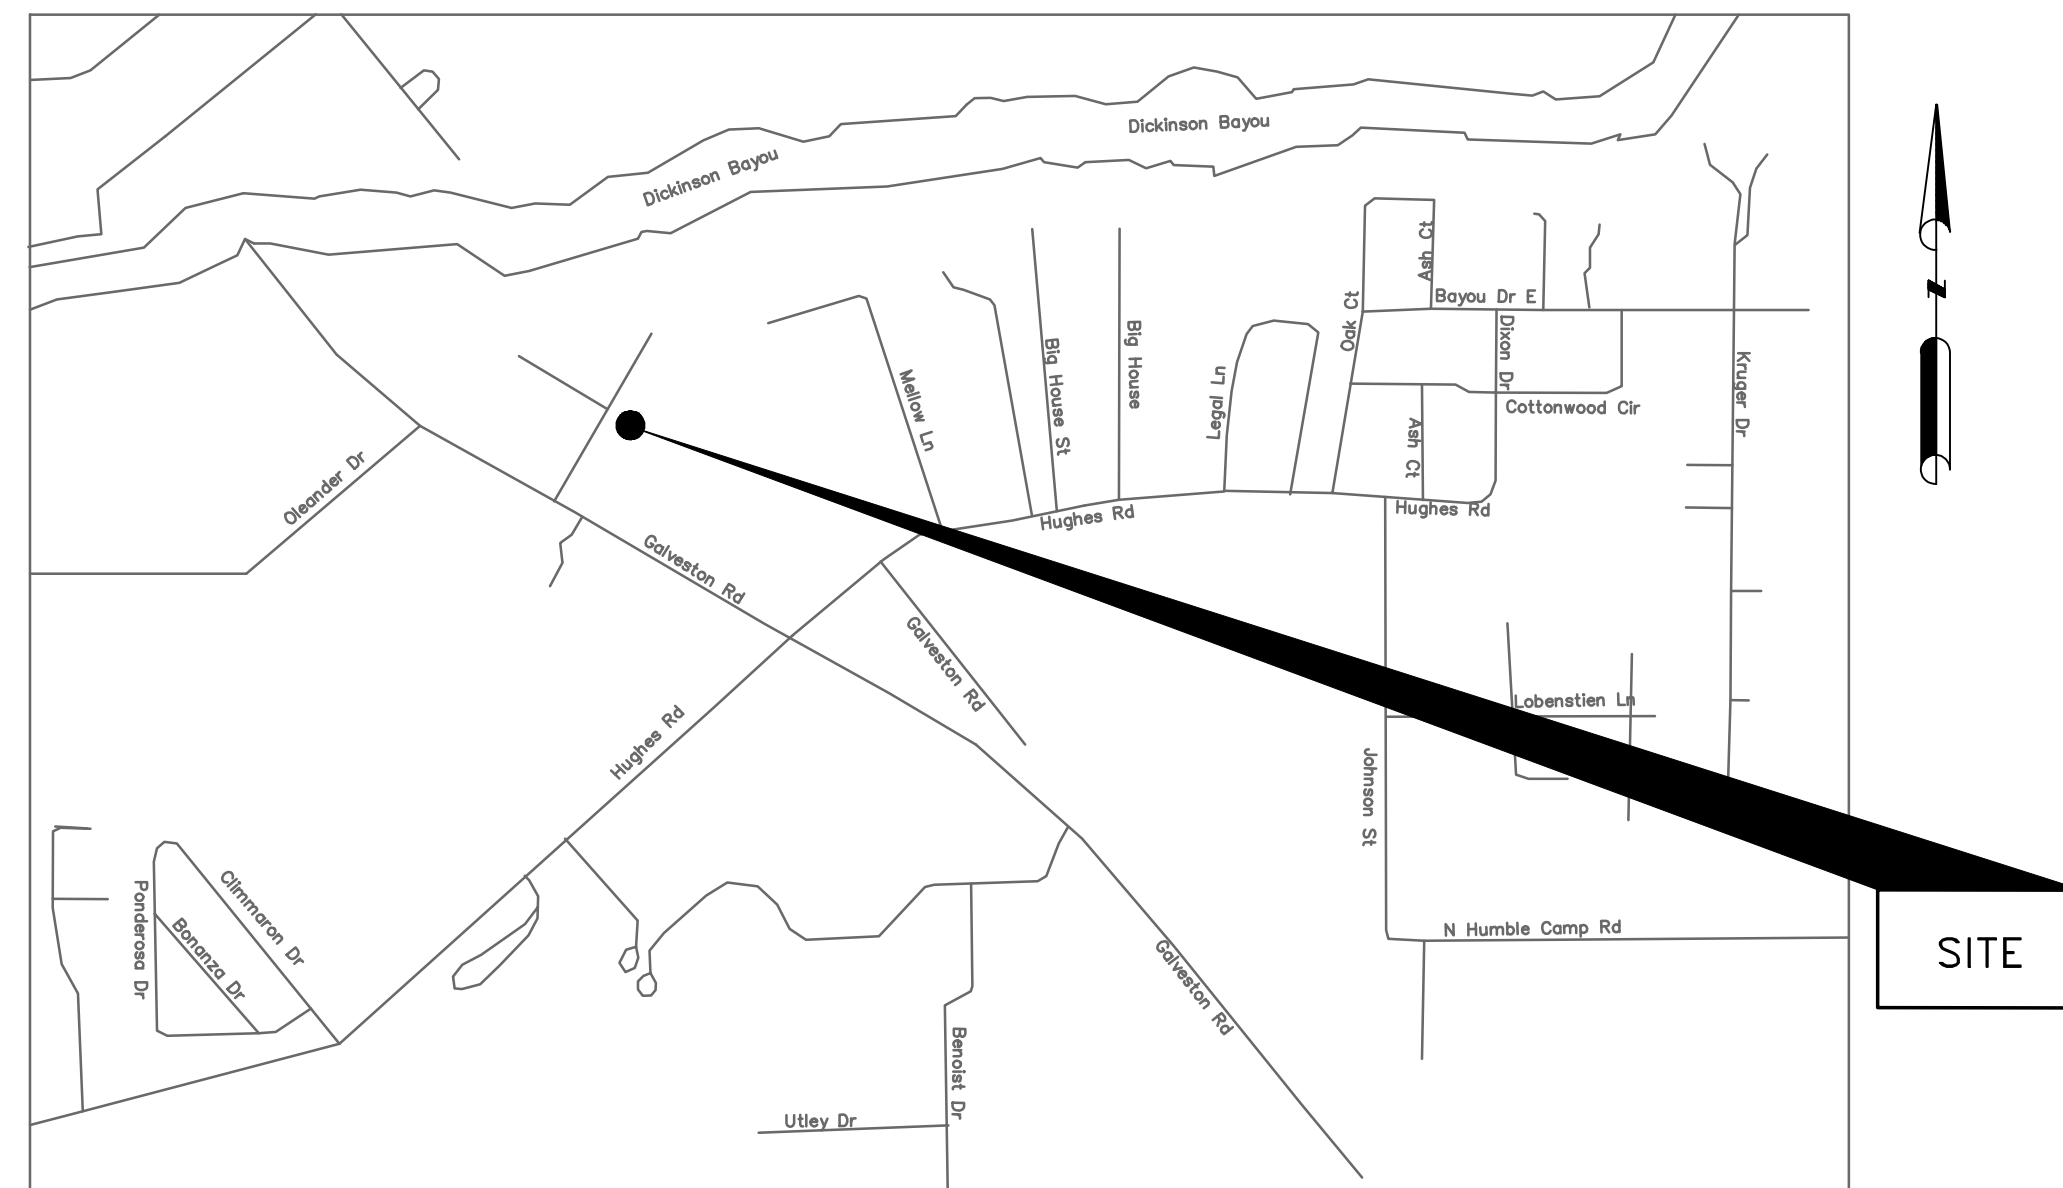

VICINITY MAP
N.T.S.
KEY MAP: 190-A

CIVIL ENGINEER:

DALLY+ASSOCIATES, INC.

TBPE FIRM REGISTRATION #3426

9800 RICHMOND AVENUE, SUITE 460
HOUSTON, TX 77042
(713) 337 8881
www.dallyassociates.com

Project Manager: Jose Diego Monroy, CFM
Project Engineer: Fred Dally, P.E.

OCTOBER 07, 2020

CIVIL SHEET INDEX

SHEET #	SHEET NAME
C1.0-PH3	COVER SHEET
C2.0-PH3	TOPOGRAPHIC SURVEY
C3.0-PH3	DEMOLITION PLAN
C4.0-PH3	PAVING PLAN
C5.0-PH3	LAYOUT PLAN
C6.0-PH3	GRADING PLAN
C7.0-PH3	GENERAL NOTES
C8.0-PH3	PAVEMENT DETAILS
C9.0-PH3	SWPP PLAN
C10.0-PH3	SWPPP DETAILS

ONE- CALL NOTIFICATION SYSTEM
CALL BEFORE YOU DIG!!
(713) 223-4567 (In Houston, Tx)
(New Statewide Number Outside Houston)
1-800-545-6005

GALVESTON COUNTY
ROAD & BRIDGE
DEPARTMENT FACILITIES PH3
5115 TX-3
DICKINSON, TX 77539

COVER SHEET

TBPE FIRM REGISTRATION #3426

DRAWING SCALE

DESIGNED BY: JDM

CHECKED BY: JDM

DATE: 10/07/2020



3 C1.0-PH3

10/07/2020

NO.	DATE	REVISIONS
3	10/07/20	ADDENDUM NO.3

GENERAL NOTES.

1. According to the Federal Emergency Management Agency (FEMA) Flood Insurance Rate Map (FIRM) for Galveston County, Texas, Map No. 485470095 C dated May 2, 1983 This properties lies within "Zone C" of the flood insurance rate map and does not lie within a special flood hazard area.
This flood statement does not imply that the property or structures thereon will be free from flooding or flood damage. On rare occasions floods can and will occur in areas not shown on the flood insurance rate map. The actual location of the flood zone as determined by scaling from said FEMA map, & Services assumes no liability as to the accuracy of the location of the flood zone.
This flood statement shall not create liability on the part of KM Surveying, LLC.
2. This survey has been prepared for the sole purpose of the transaction described in the above mentioned Commitment for title insurance and the parties listed therein. This survey is not to be used for any subsequent transactions.
3. This survey does not determine the location of wetlands, fault lines, toxic waste, cemeteries, landfills, dumps or any other environmental issues.
4. Interek Surveying & Services has not been provided with construction plans showing the location of underground utilities. Underground utilities may exist which are not shown hereon.
5. Readily visible improvements/utilities were located with this survey, no subsurface probing, excavation or exploration was performed Interek Surveying & Services.
6. This exhibit has been prepared without benefit of current title report. There may be easements, setbacks, and other matters of record not shown hereon, the surveyor has not abstract the property.
7. Reference is made to a Survey of a 3.193-acre (139,093 sq. ft.) Tract situated at the intersection of State Highway 3 (ROW VARIES) and Highway 100, Galveston County, Texas, dated 12/12/2018. Prepared by Weisser Engineering Co. Job. No. GD404 and in the field book 3510.


LEGEND:

- ⊙ BOLLARD
- ⊕ BENCHMARK
- ⊖ INLET
- ⊗ GAS METER
- ⊘ GAS VALVE
- ⊙ GUY/ANCHOR
- ⊚ STORM MANHOLE
- ⊛ POWER POLE
- ⊜ WATER MH
- ⊝ WATER METER
- ⊞ DECIDUOUS TREE

PROJECT SITE

AP.png

Vehicle Map
N.T.S.

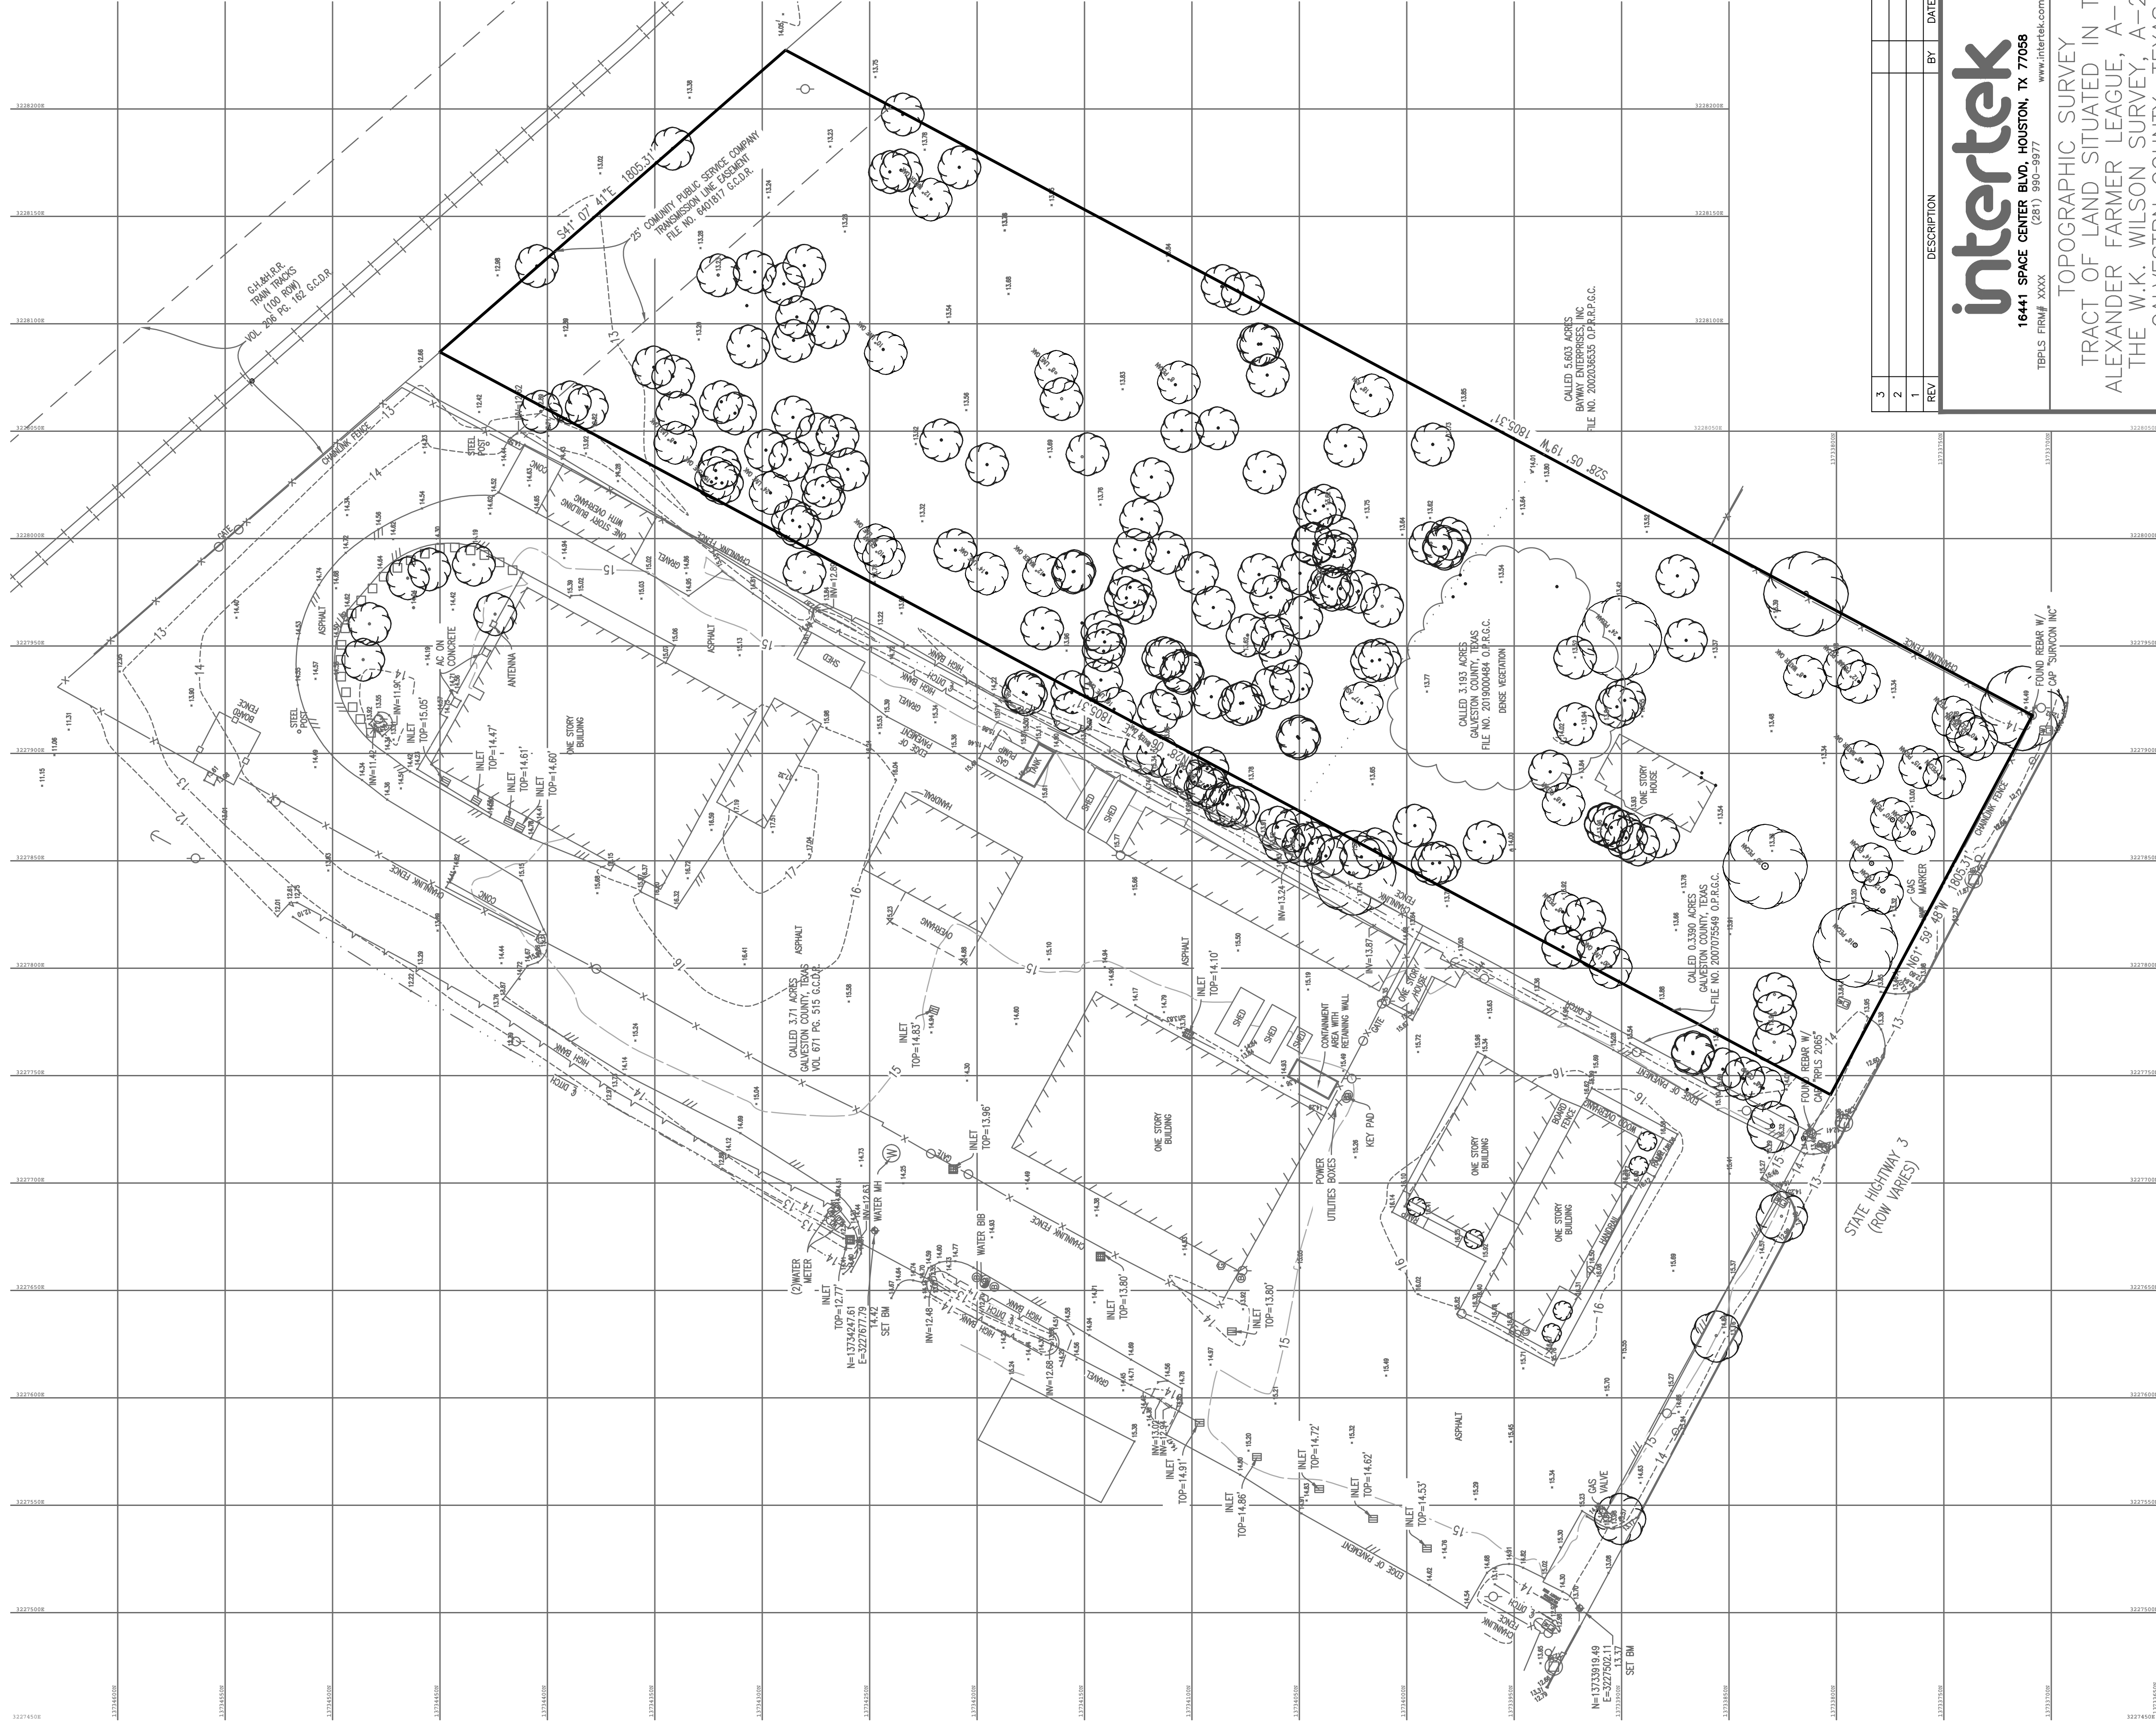

REV	DESCRIPTION	BY	DATE
3			
2			
1			



intertek
16441 SPACE CENTER BLVD., HOUSTON, TX 77058
TBPLS FIRM# XXXX www.intertek.com

TOPOGRAPHIC SURVEY
TRACT OF LAND SITUATED IN THE
ALEXANDER FARMER LEAGUE, A-11 &
THE W.K. WILSON SURVEY, A-205
GALVESTON COUNTY, TEXAS

DATE: November 8, 2019 SURVEYED: MR
DRAWN: MR
DWG: psi - Iss - 19113 topo 071720 BAREGREDT
JOB NO.: 19113
SCALE: 1" = 40'
SHEET NO.: 1 OF 1

C2.0-PH3

Galveston County
Road & Bridge Department Facilities PH3
5115 Texas Highway 3
Dickinson, TX

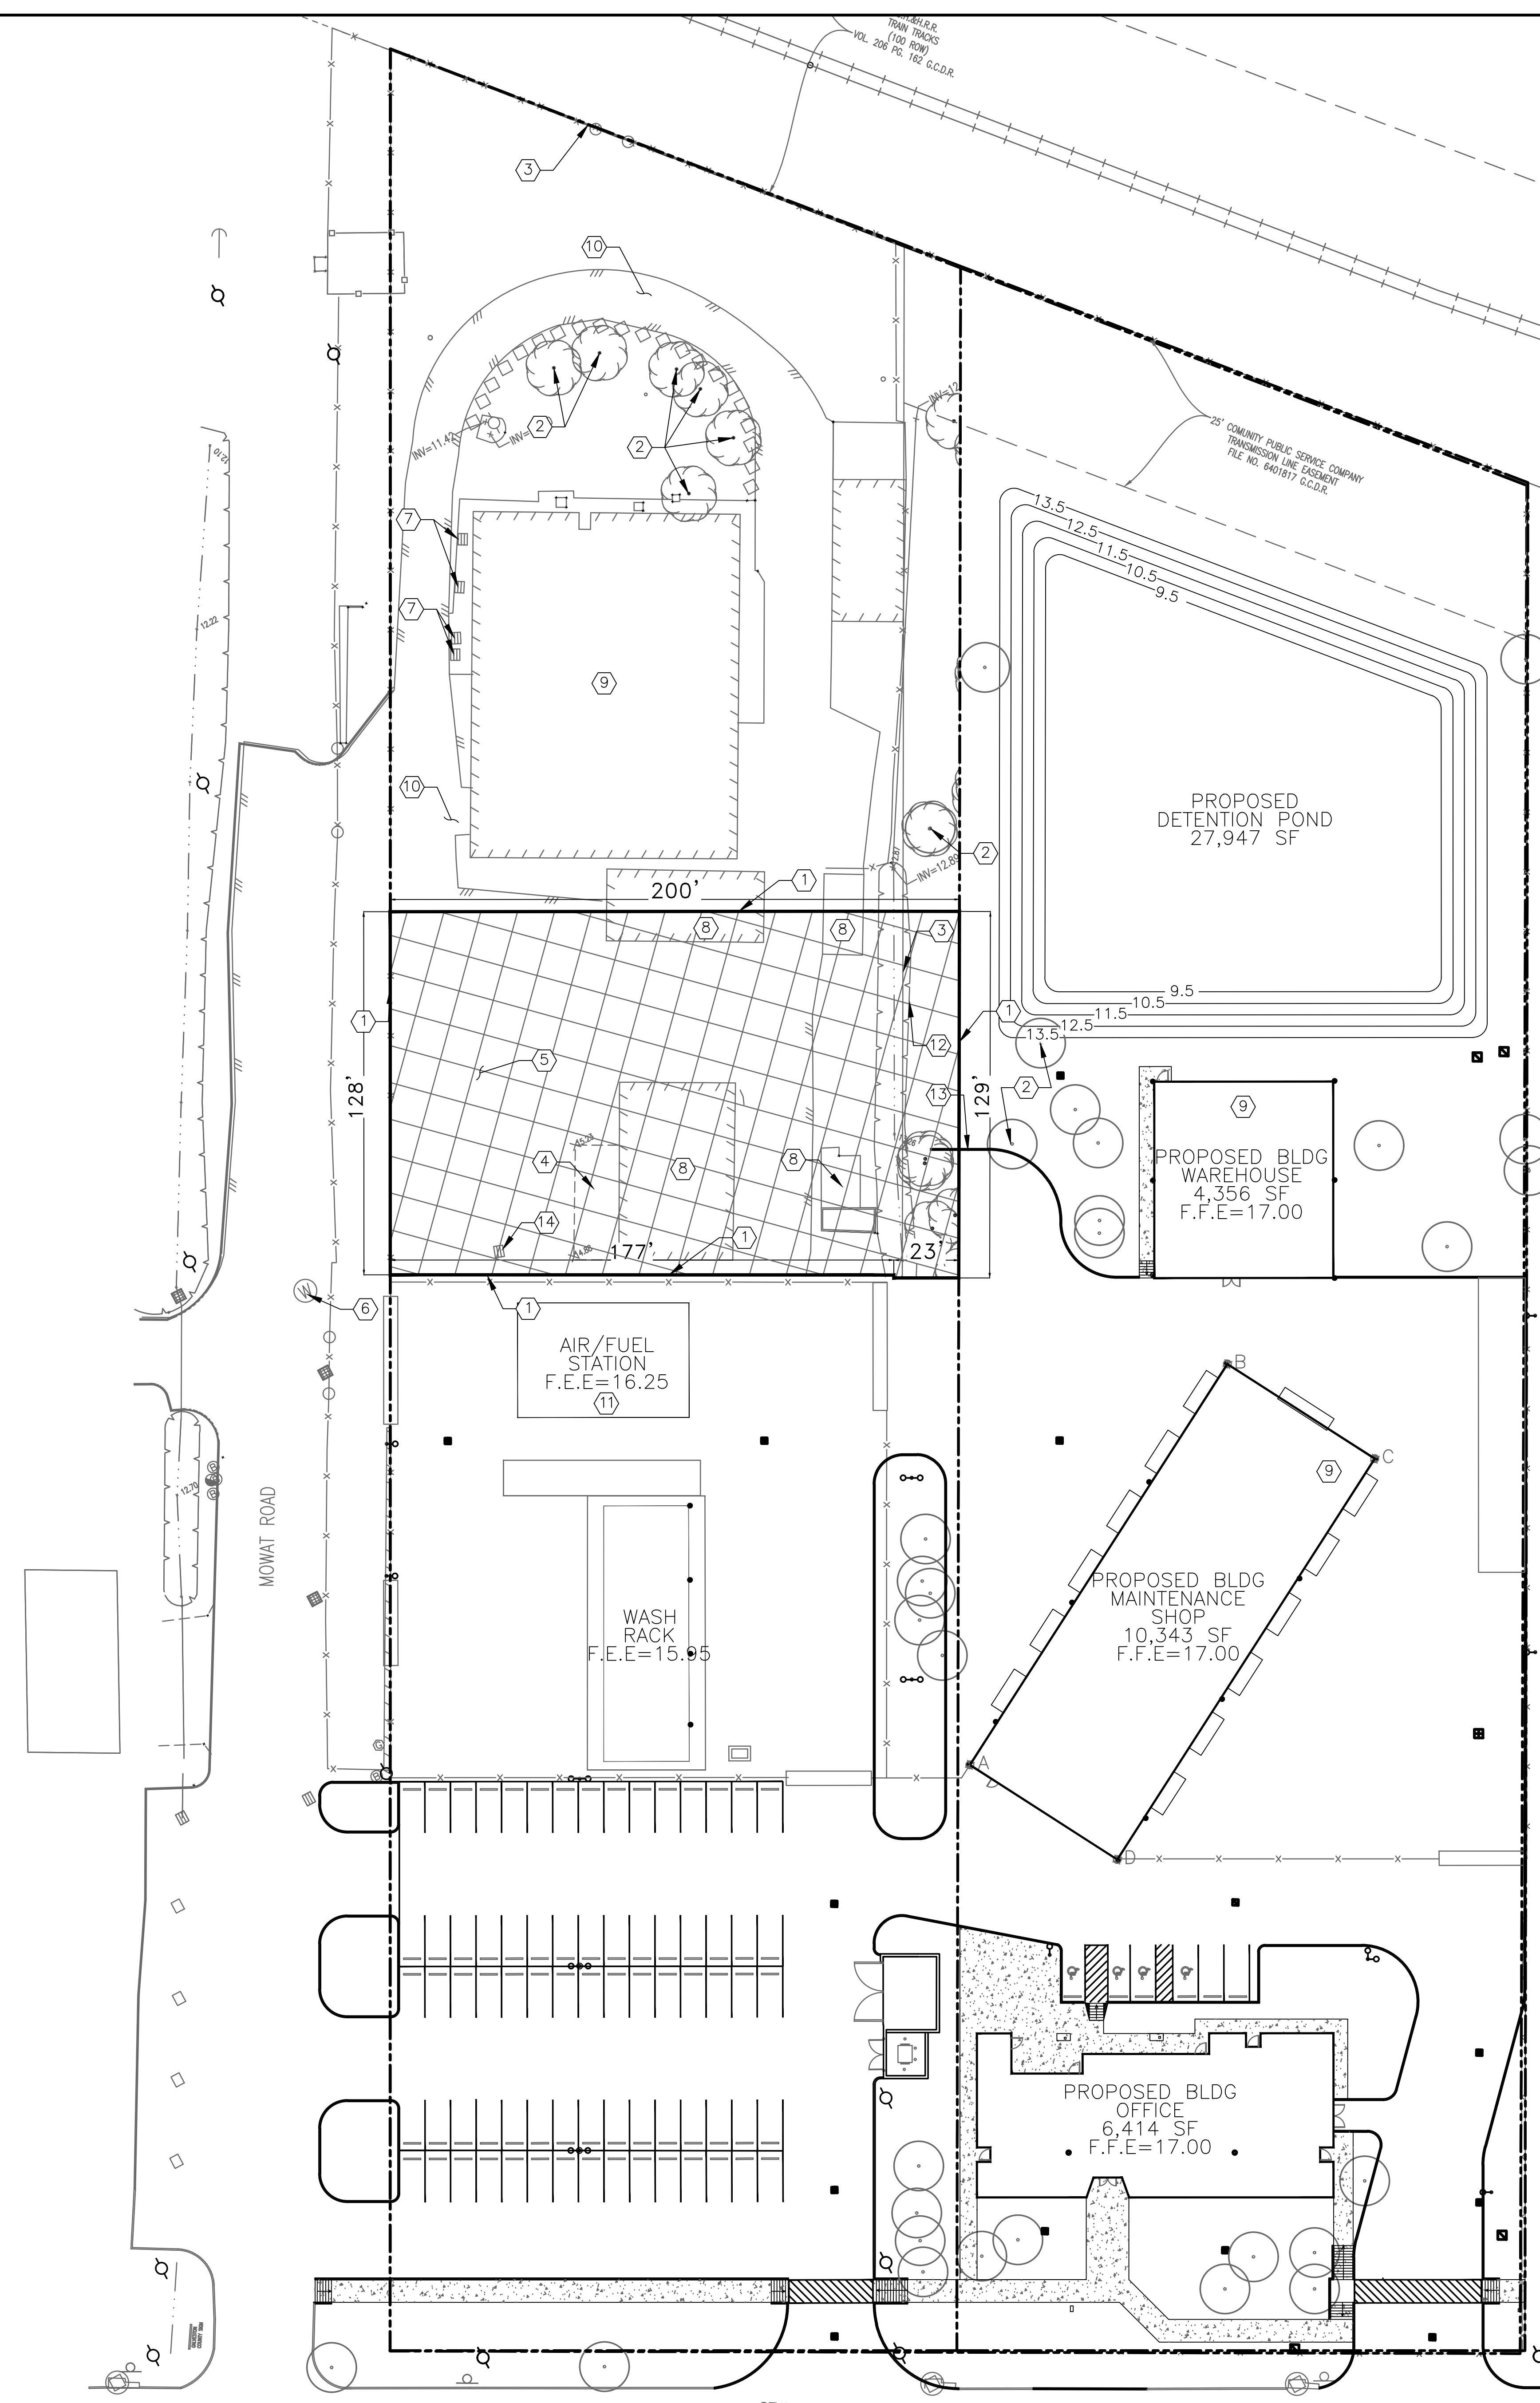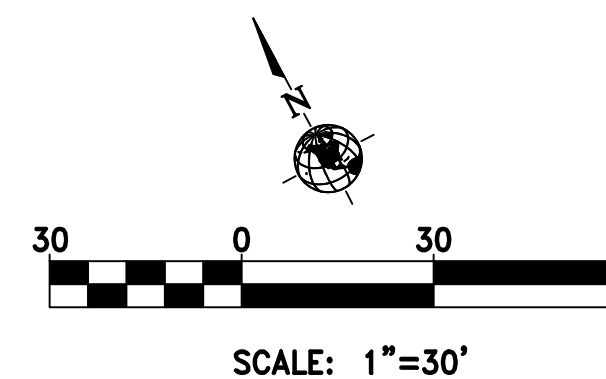

DEMOLITION NOTES TO CONTRACTOR

1. ALL ITEMS DESIGNATED TO BE REMOVE SHALL BECOME THE PROPERTY OF THE CONTRACTOR.
2. THE CONTRACTOR AND OWNER SHALL COORDINATE WITH CENTERPOINT FOR TERMINATION OF POWER AND GAS SERVICES TO THE SITE OR NEW SERVICES. THIS WORK WILL BE PROVIDED BY CENTERPOINT AND SHALL BE SCHEDULE AS ONE OF THE FIRST ITEMS OF BUSINESS.
3. THE CONTRACTOR SHALL BE PROVIDE AN APPROVED TRAFFIC CONTROL PLAN TO PERFORM ANY WORK PROPER SIGNAGE.
4. WHEN EXISTING SIDEWALK IS CLOSED FOR CONSTRUCTION, CONTRACTOR SHALL BARRICADE THAT AREA AND PROVIDE SAFE ALTERNATE PATH FOR PEDESTRIAN WITH PROPER SIGNAGE.
5. ALL TRAFFIC SIGNAGE WITHIN THE ROW SHALL BE PROTECTED INPLACE AT ALL TIMES. ANY DAMAGE TO THEN SHALL BE REPAIRED IMMEDIATELY. DURING THE CONSTRUCTION, SAFE OPERATION OF PEDESTRIAN OR VEHICULAR TRAFFIC, CONTRACTOR SHALL PROVIDE A CERTIFIED FLAGGER OR PEACE OFFICER UNTIL THAT SIGN IS RESTORED TO EXISTING CONDITION.
6. CONTRACTOR SHALL REPAIR ANY ITEMS DAMAGE DURING CONSTRUCTION TO ITS EXISTING CONDITION.
7. PRIOR TO ANY DEMOLITION WORK, THE CONTRACTOR SHALL LOCATED AS WELL CAPPED. ALL UTILITIES THAT ARE SHOWN SHALL BE LOCATED AS WELL AND CAPPED. ALL UTILITIES NOT SHOW SHALL BE LOCATED AS WELL CAPPED. UTILITIES THAT ARE SHOWN ON PLANS ARE APPROXIMATE LOCATION ONLY.
8. THE CONTRACTOR SHALL BE RESPONSIBLE FOR PROVIDING POSITIVE DRAINAGE ON SITE DURING ALL CONSTRUCTION ACTIVITIES.
9. THE CONTRACTOR SHALL ENTER & EXIT THE SITE THROUGH EXISTING DRIVEWAY.
10. CAUTION. THERE ARE OVERHEAD POWERLINES WITH IN THE WORK AREA. CONTRACTOR SHALL FOLLOW CITY, STATE AND FEDERAL GUIDELINES WHEN WORKING AROUND EXISTING POWER LINES.

DEMOLITION KEY NOTES


- 1 LIMITS OF DEMOLITION.
- 2 EXISTING TREE TO REMAIN. PROTECT IN-PLACE.
- 3 EXISTING CHAINLINK FENCE TO BE REMOVED.
- 4 EXISTING CONCRETE PAVEMENT TO BE REMOVED.
- 5 EXISTING ASPHALT PAVEMENT TO BE REMOVED.
- 6 EXISTING SANITAY SEWER MANHOLE TO REMAIN. PROTECT IN-PLACE.
- 7 EXISTING STORM DRAIN INLET TO REMAIN. PROTECT IN-PLACE.
- 8 EXISTING BUILDING TO BE REMOVED.
- 9 EXISTING BUILDING TO REMAIN.
- 10 EXISTING ASPHALT PAVEMENT TO REMAIN. PROTECT IN-PLACE.
- 11 EXISTING AIR/FUEL STATION TO REMAIN. PROTECT IN-PLACE.
- 12 EXISTING DITCH TO BE REMOVED.
- 13 EXISTING CURB TO REMAIN. PROTECT IN-PLACE.
- 14 EXISTING STORM DRAIN INLET TO BE REMOVED.

DEMOLITION HATCH LEGEND




ONE- CALL NOTIFICATION SYSTM
CALL BEFORE YOU DIG!!!
(713) 223-4567 (In Houston, Tx)
(New Statewide Number Outside Houston)
1-800-545-6005

KEY PLAN (NOT TO SCALE)

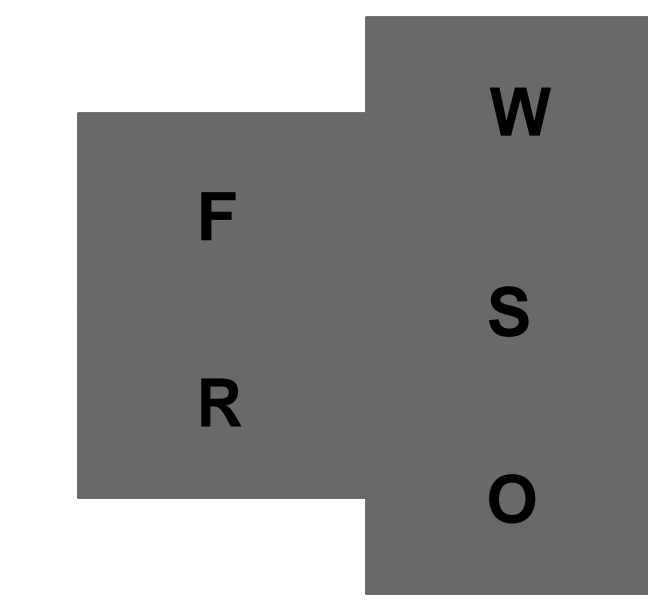


REVISION HISTORY		
REVISION	DESCRIPTION	DATE
ADDENDUM NO. 3		10-07-2020






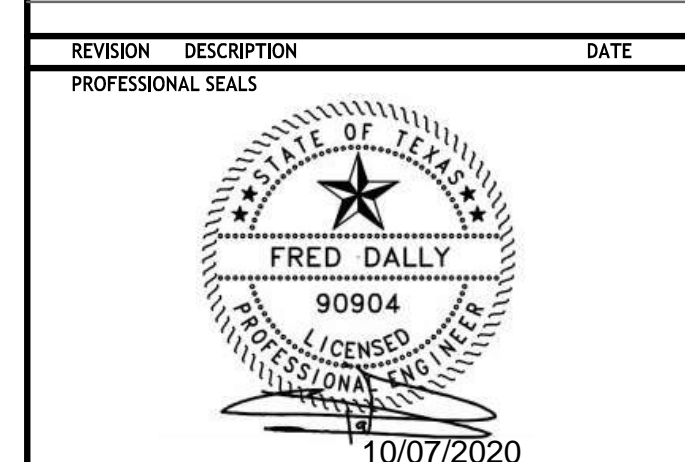




DEMOLITION PLAN	
DRAWN BY	CHECKED BY
JDM	JDM
PROJECT NUMBER 418198	PROJECT ABBREVIATION GC_R&B
ORIGINAL ISSUE	DATE
ISSUE FOR PERMIT	07 OCT 2020

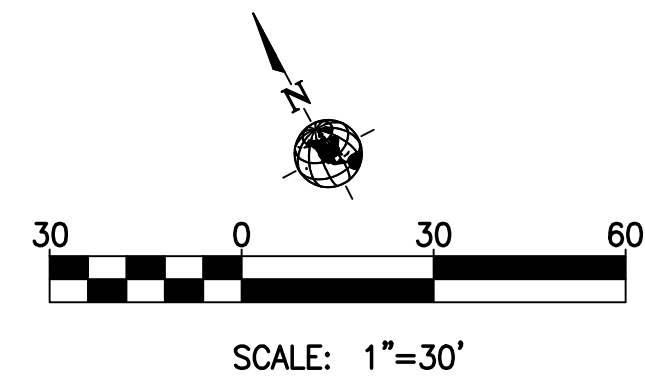
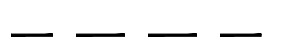

C3.0-PH3
SHEET NUMBER

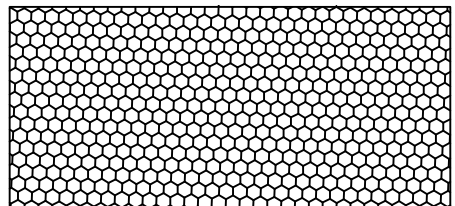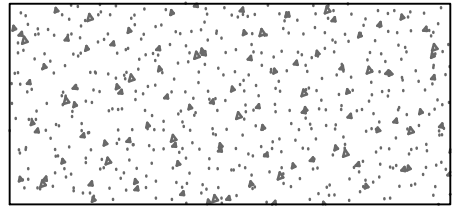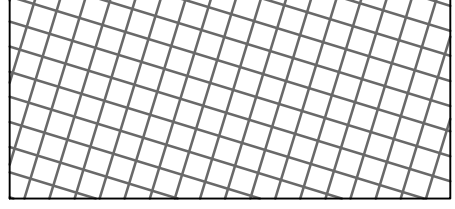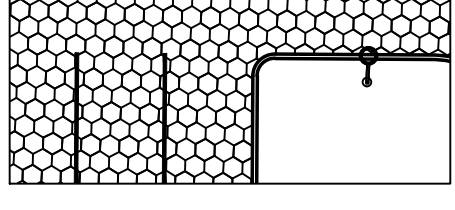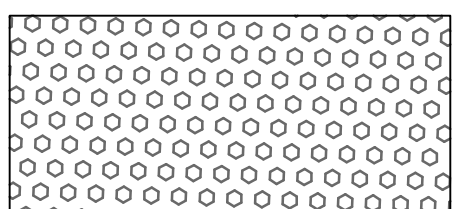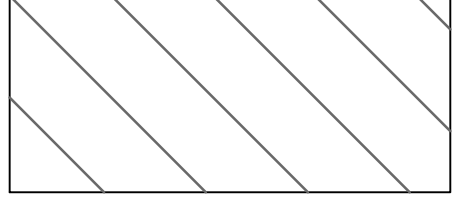



HATCH LEGEND:

-  PROPOSED TRUE-GRID PRO PLUS APPROX: 21,221 SQFT
-  EXISTING 4.5" THICK CONCRETE FOR SIDEWALK APPROX: 7,123 SQFT
RE: C-9.0 PAVEMENT DETAILS
-  EXISTING 6" THICK CONCRETE FOR DRIVEWAY APPROX: 1,444 SQFT
RE: C-9.0 PAVEMENT DETAILS
-  6" TALL CURB REF. SECTION
-  EXISTING TRUE-GRID PRO PLUS APPROX: 23,865 SQFT
-  6" THICK CONCRETE PAVING APPROX: 30,938 SQFT
RE: C-9.0 PAVEMENT DETAILS
-  EXISTING PAVEMENT APPROX: 46,728 SQFT
-  7" THICK CONCRETE PAVING APPROX: 1,699 SQFT
RE: C-9.0 PAVEMENT DETAILS

LEGEND:


-  PROPOSED SAWCUTTING JOINT
-  PROPOSED EXPANSION JOINT
-  AREA NOT IN SCOPE

*NOTE: SEE PAVING DETAILS FOR JOINT SECTIONS

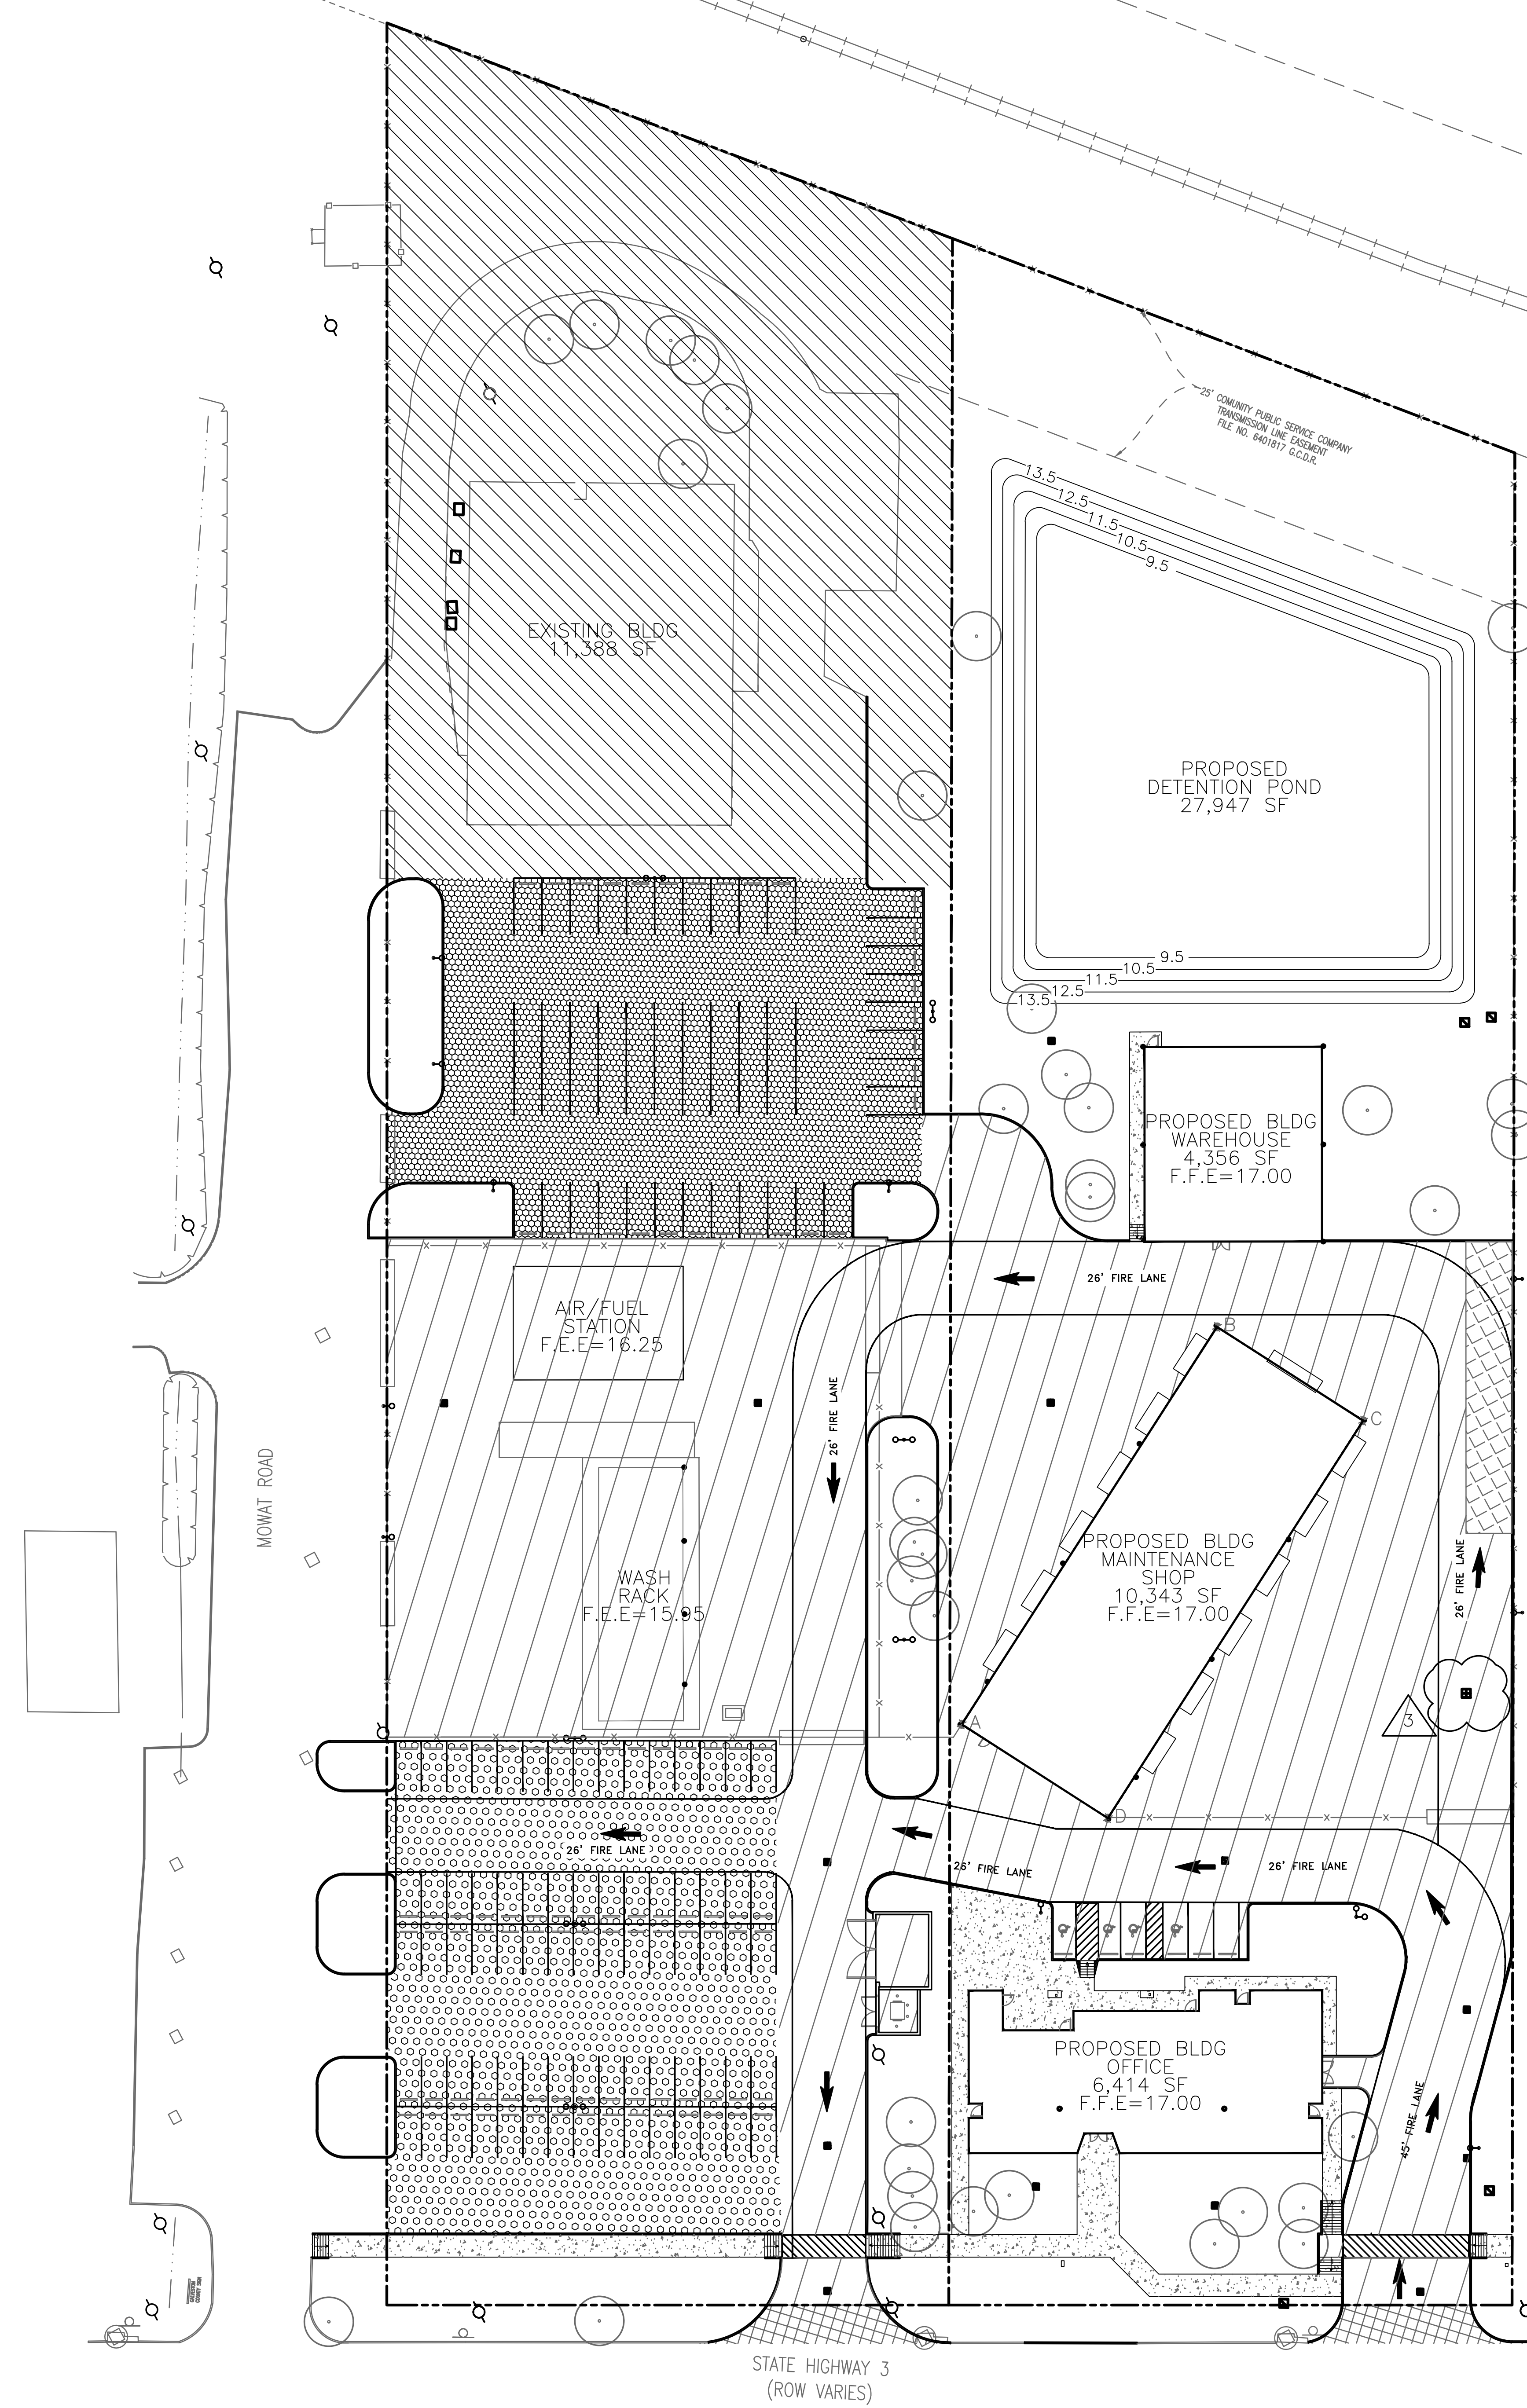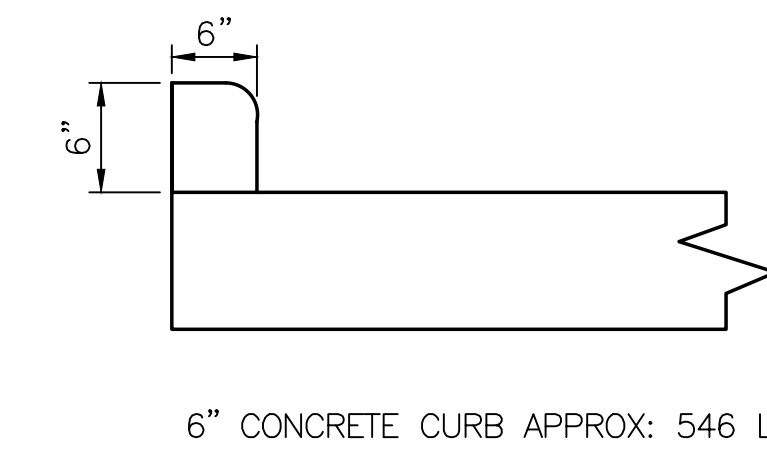

**ONE-CALL NOTIFICATION SYSTEM
CALL BEFORE YOU DIG!!!**
(713) 223-4567 (In Houston, TX)
(New Statewide Number Outside Houston)
1-800-545-6005

KEY PLAN (NOT TO SCALE)

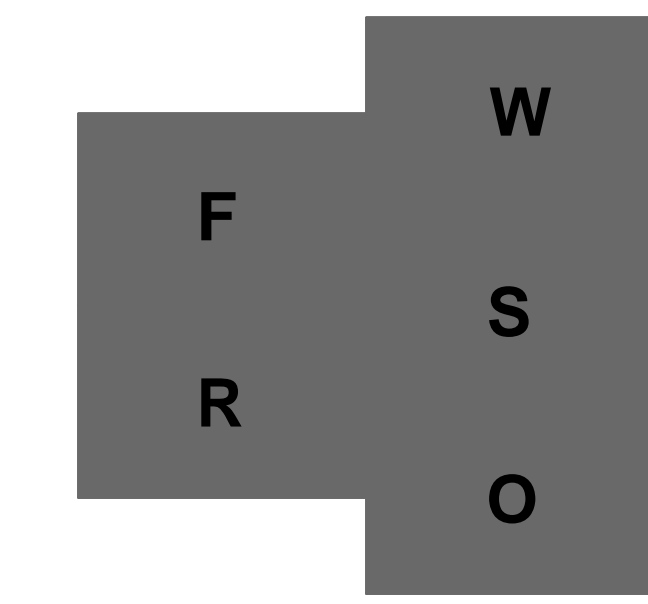

**Galveston County
Road & Bridge Department Facilities PH3**
5115 Texas Highway 3
Dickinson, TX

REVISION HISTORY		
NO.	DESCRIPTION	DATE
1	ADDENDUM NO. 3	10-07-2020

REVISION	DESCRIPTION	DATE


PROFESSIONAL SEALS

PAVING PLAN

DRAWN BY JDM	CHECKED BY JDM
PROJECT NUMBER 418198	PROJECT ABBREVIATION GC-R&B
ORIGINAL ISSUE ISSUE FOR PERMIT	DATE 07 OCT 2020

C4.0-PH3
SHEET NUMBER

Galveston County
Road & Bridge Department Facilities PH3
5115 Texas Highway 3
Dickinson, TX

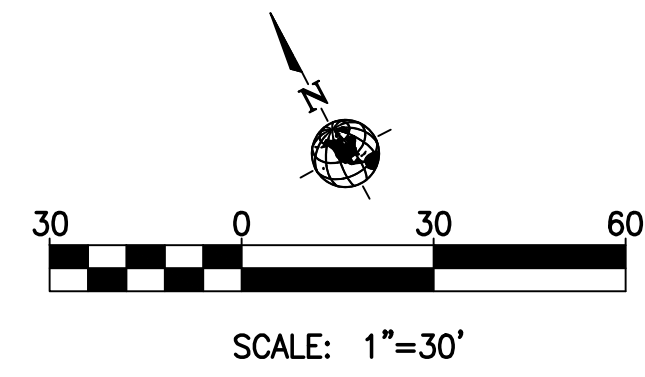



SITE LAYOUT NOTES

1. THE HORIZONTAL AND VERTICAL LOCATION OF EXISTING SUBSURFACE UTILITIES HAVE BEEN DETERMINED FROM DATA PROVIDED BY OTHERS. IT WILL BE THE RESPONSIBILITY OF THE CONTRACTOR TO PROTECT ALL EXISTING UTILITIES WITHIN THE AREA OF CONSTRUCTION THAT ARE TO REMAIN IN SERVICE. CONTRACTOR SHALL VERIFY SIZE AND LOCATION OF ALL UTILITIES PRIOR TO CONSTRUCTION.
2. ALL DIMENSIONS ARE FROM FACE OF CURB UNLESS OTHERWISE NOTED.
3. ALL DIMENSIONS ARE TO FACE OF BUILDING. REFER TO ARCHITECTURAL PLANS FOR BUILDING DIMENSIONS.
4. REFER TO ARCHITECTURAL PLANS FOR ALL STAIRS, HANDICAPPED RAMP AND RETAINING WALL DETAILS.
5. REFER TO LANDSCAPE ARCHITECT PLANS FOR DETAILS AND DIMENSIONS OF LANDSCAPE AND HARDSCAPE AREAS.

LAYOUT KEY NOTES


- ① PROPOSED 6" CONCRETE CURB PER PAVEMENT DETAILS.
- ② PROPOSED 4" YELLOW STRIPING PER PAVEMENT DETAILS TYP.
- ③ PROPOSED LIGHT POLE; REFER TO MEP DRAWINGS FOR LAYOUT AND SPECIFICATIONS.
- ④ PROPOSED WHEEL STOP.
- ⑤ PROPOSED CHAIN - LINK FENCE
- ⑥ PROPOSED GATE BY OTHERS.

HATCH LEGEND

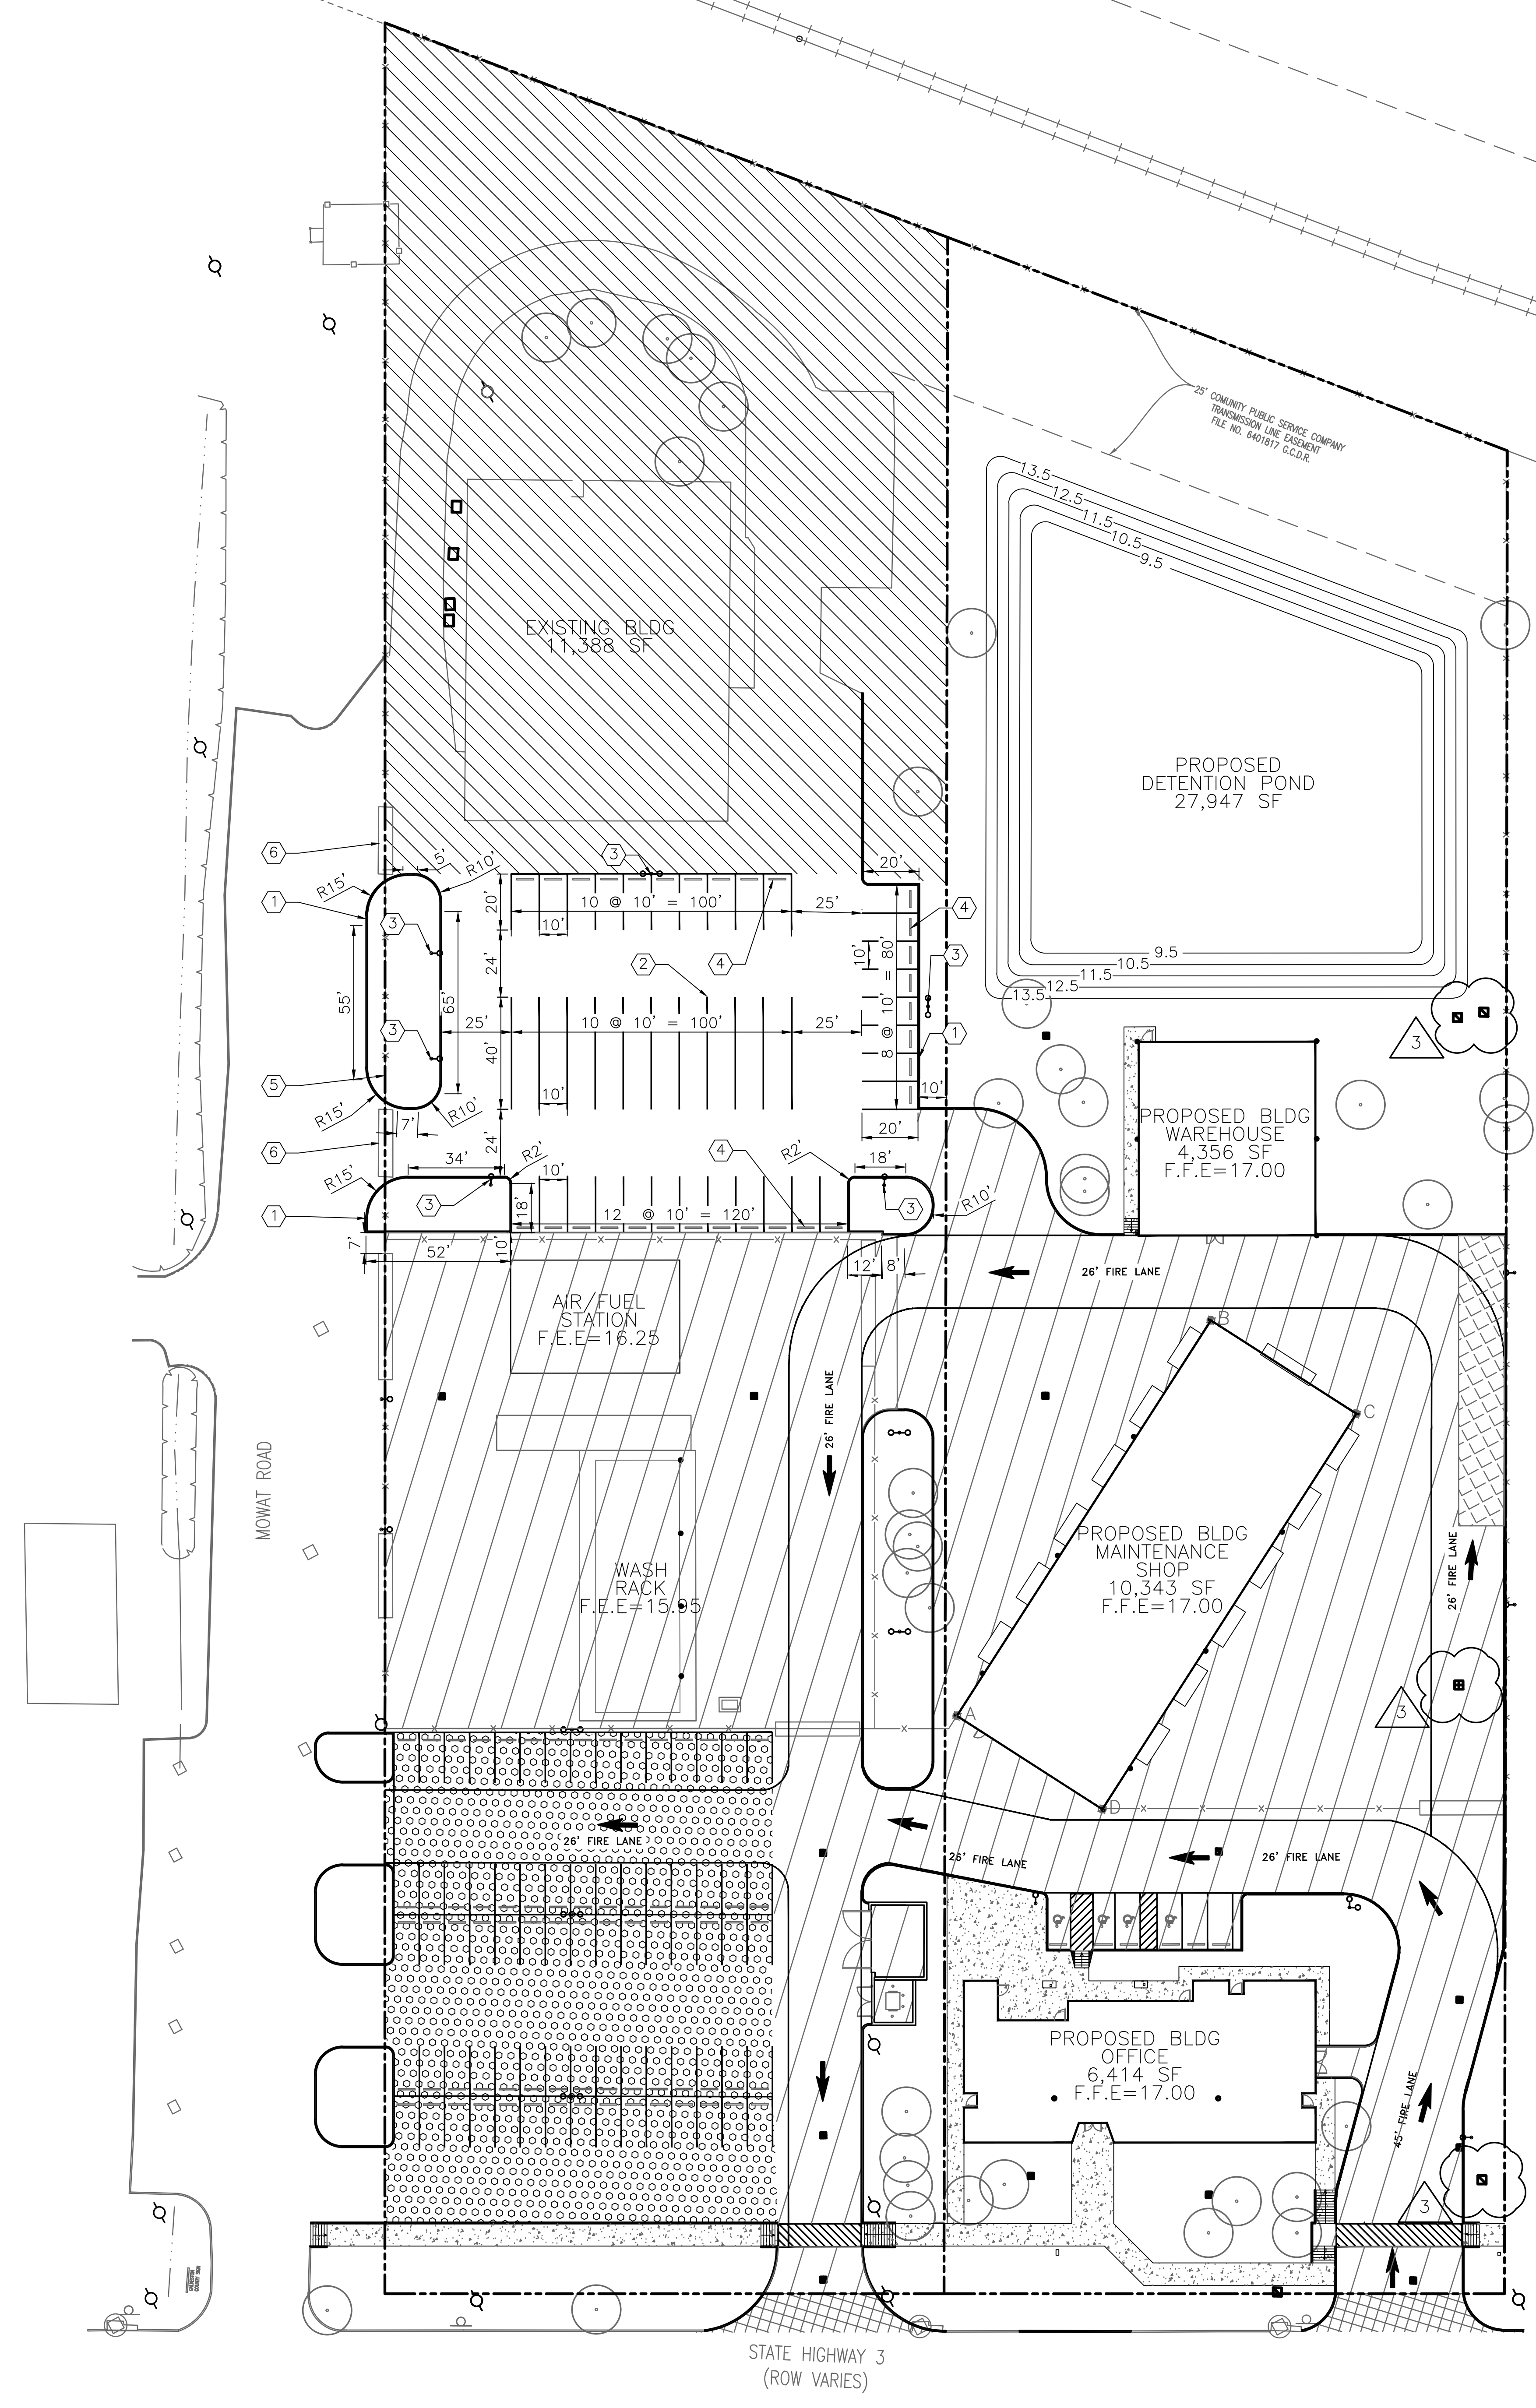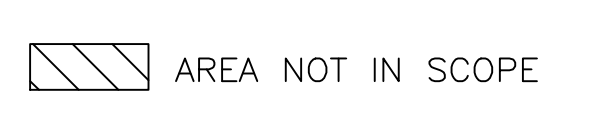

ONE- CALL NOTIFICATION SYSTEM
CALL BEFORE YOU DIG!!!
(713) 223-4567 (In Houston, Tx)
(New Statewide Number Outside Houston)
1-800-545-6005

KEY PLAN (NOT TO SCALE)

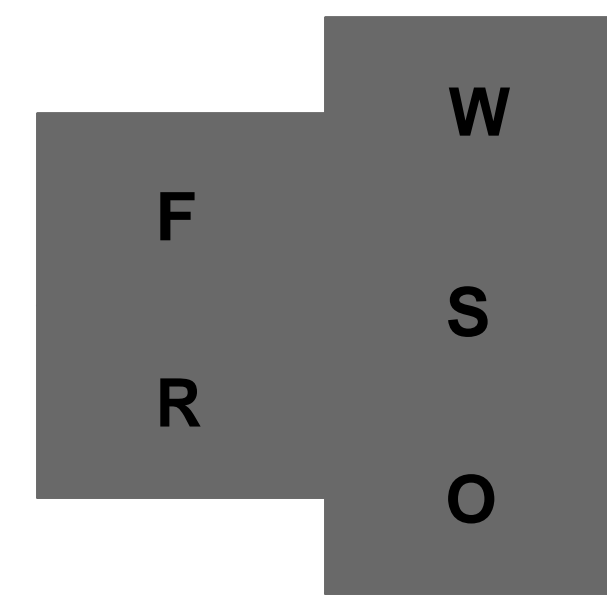

REVISION HISTORY		
NO.	DESCRIPTION	DATE
1	ADDENDUM NO. 3	10-07-2020


REVISION	DESCRIPTION	DATE

PROFESSIONAL SEALS

LAYOUT PLAN


DRAWN BY JDM	CHECKED BY JDM
PROJECT NUMBER 418198	PROJECT ABBREVIATION GC_R&B
ORIGINAL ISSUE ISSUE FOR PERMIT	DATE 07 OCT 2020

C5.0-PH3
SHEET NUMBER

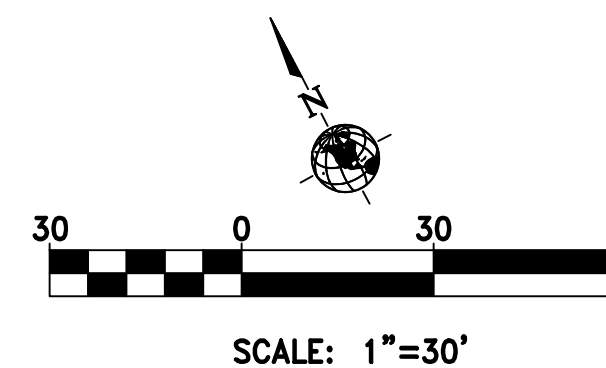

Page Southerland Page, Inc.
 1100 Louisiana, Suite One
 Houston, TX 77002
 pagesp.com
 TEL: 713.871.8484
 FAX: 713.871.8440
 ARCHITECTURE / ENGINEERING / INTERIORS / PLANNING / CONSULTING
 Austin / Dallas / Denver / Dubai / Houston / Mexico City /
 San Francisco / Washington DC / International Affiliate Offices

Civil Engineering
 Dally & Associates
 9800 Richmond Avenue
 Suite 460
 Houston, TX 77042
 713.337.8881
 MEP Engineering
 Page
 1100 Louisiana
 Suite One
 Houston, TX 77002
 713.871.8484
 Landscape Architecture
 Knudson, LP
 8588 Katy Freeway
 Suite 441
 Houston, TX 77024
 713.463.8200
 Structural Engineering
 Dally & Associates
 9800 Richmond Avenue
 Suite 460
 Houston, TX 77042
 713.337.8881
 Low Voltage & Security
 4b Technology Group, LLC
 390 Glenborough Dr.
 Suite 290
 Houston, TX 77067
 832.249.9379

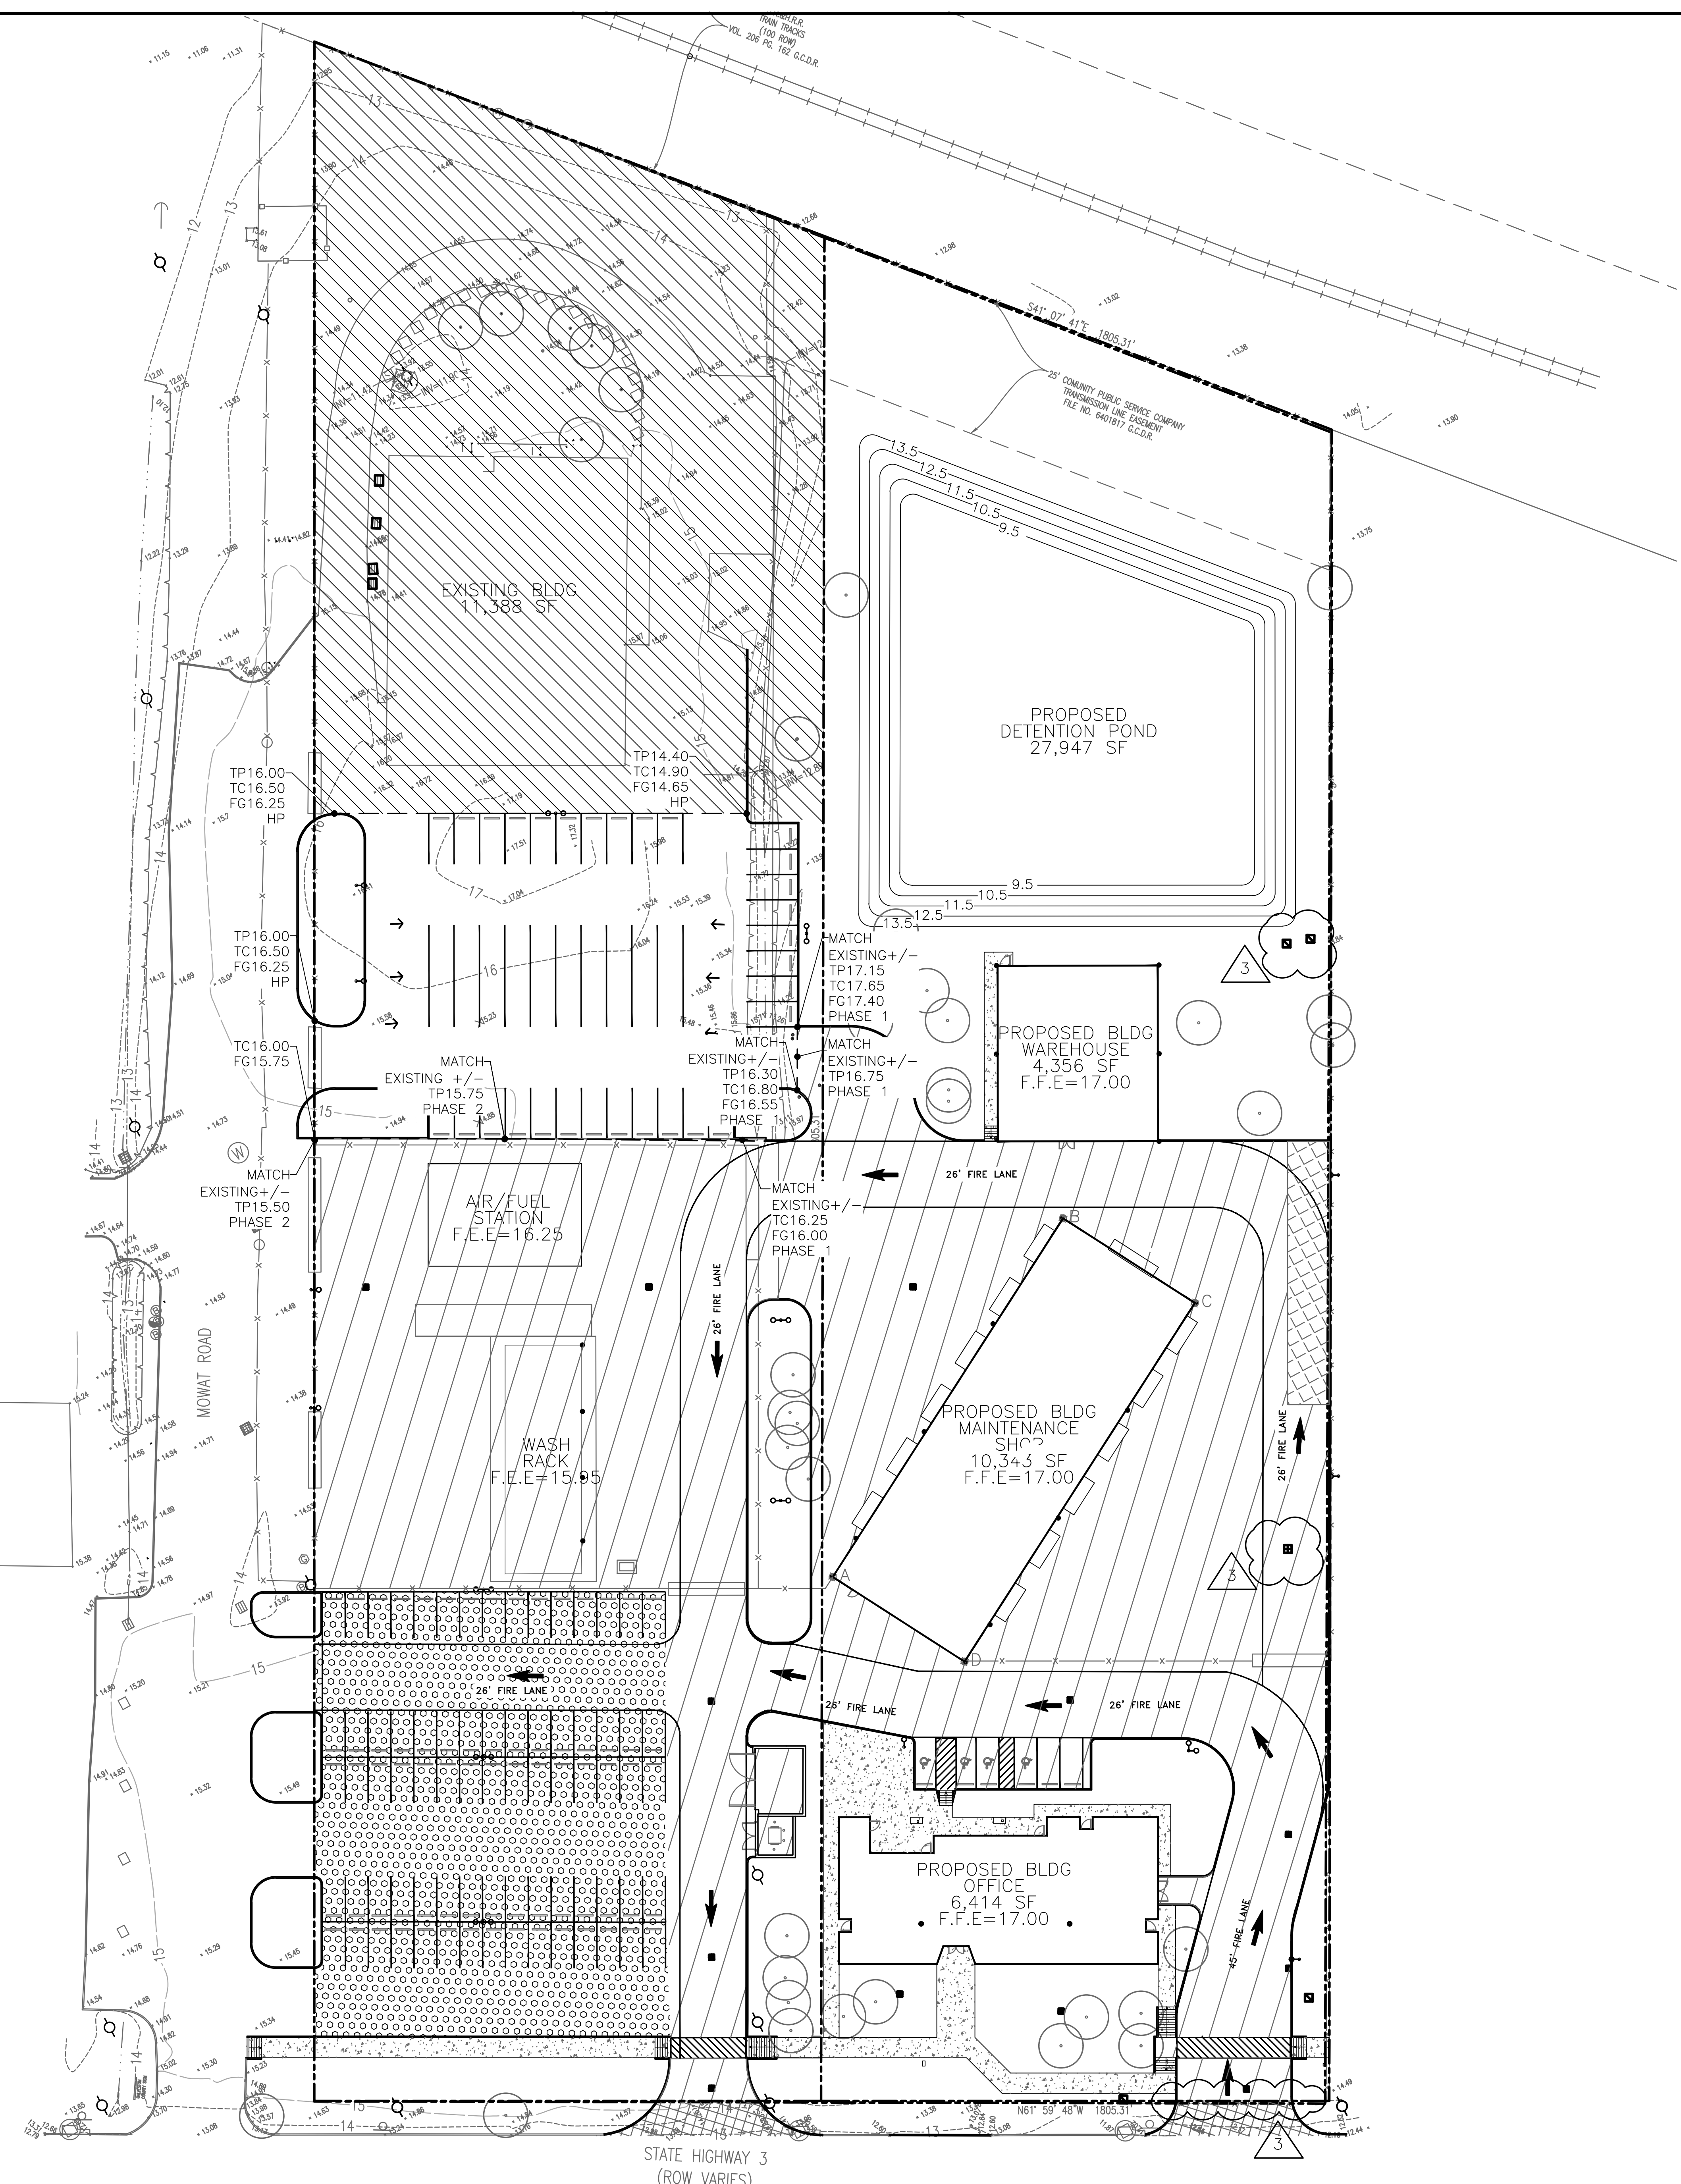

GRADING PLAN NOTES

1. REFER TO GEOTECHNICAL REPORT FOR ALL COMPACTION AND MOISTURE CONTENT REQUIREMENTS.
2. IT WILL BE THE RESPONSIBILITY OF THE CONTRACTOR TO PROTECT ALL MANHOLES, CLEANOUTS, VALVE BOXES, FIRE HYDRANTS, ECT. WITHIN THE AREA OF CONSTRUCTION THAT ARE TO REMAIN. THEY MUST BE ADJUSTED TO PROPER LINE AND GRADE BY THE CONTRACTOR PRIOR TO AND AFTER THE PLACING OF PAVING AND GRADING. AT NO ADDITIONAL COST TO THE OWNER.
- 3.
4. ALL INLETS AND MANHOLES SHALL MEET THE REQUIREMENTS OF THE LOCAL GOVERNING AGENCY.
5. SIDEWALKS SHALL HAVE A SLOPE NO GRATER THAN 5% AND A CROSS SLOPE NOT GRATER THAN 2%, UNLESS OTHERWISE.

ABBREVIATIONS

- TW TOP OF WALL
- TP TOP OF PAVEMENT ELEVATION
- TC TOP OF CURB ELEVATION
- TG TOP OF GRATE ELEVATION (STORM DRAIN INLET)
- FG FINISHED GRADE ELEVATION
- FFE FINISHED FLOOR ELEVATION
- BFE BASE FLOOD ELEVATION
- FL FLOWLINE ELEVATION


HATCH LEGEND

- CONSTRUCT 5" CONCRETE SIDEWALK OVER COMPACTED SUB-GRADE PER GEOTECHNICAL. ENGINEER'S RECOMMENDATIONS
- AREA NOT IN SCOPE


Galveston County
Road & Bridge Department Facilities PH3
 5115 Texas Highway 3
 Dickinson, TX

REVISION HISTORY		
NO.	DESCRIPTION	DATE
1	ADDENDUM NO. 3	10-07-2020

ONE- CALL NOTIFICATION SYSTM
 CALL BEFORE YOU DIG!!!
 (713) 223-4567 (In Houston, Tx)
 (New Statewide Number Outside Houston)
 1-800-545-6005

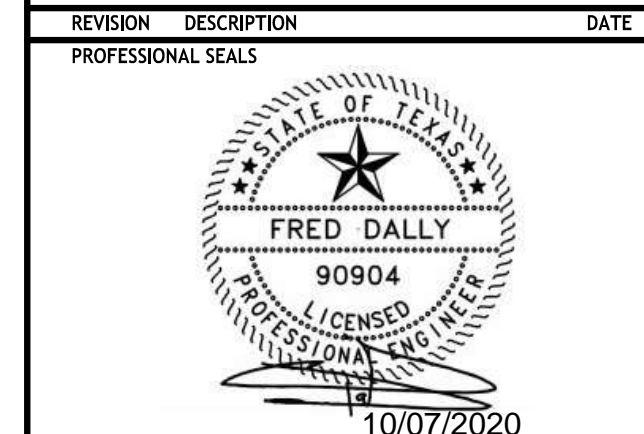

KEY PLAN (NOT TO SCALE)

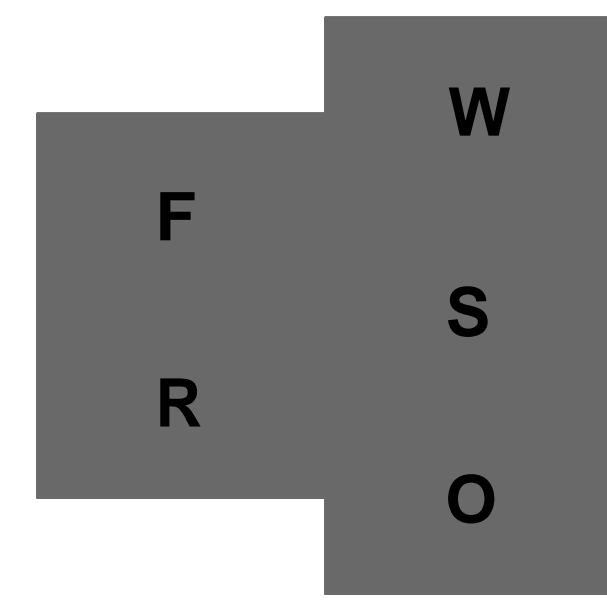

GRADING PLAN	
DRAWN BY JDM	CHECKED BY JDM
PROJECT NUMBER 418198	PROJECT ABBREVIATION GC-R&B
ORIGINAL ISSUE ISSUE FOR PERMIT	DATE 07 OCT 2020
C6.0-PH3	
SHEET NUMBER	

Galveston County
Road & Bridge Department Facilities PH3
5115 Texas Highway 3
Dickinson, TX

A. GENERAL CONSTRUCTION NOTES:

- 1. CONTRACTOR SHALL FIELD VERIFY EXISTING CONDITIONS BEFORE BEGINNING CONSTRUCTION.
2. CONTRACTOR SHALL BE RESPONSIBLE FOR PROVIDING REQUIRED SECURITY TO PROTECT HIS OWN PROPERTY, EQUIPMENT AND WORK IN PROGRESS.
3. CONTRACTOR IS RESPONSIBLE FOR CLEANING OF STREETS CAUSED BY ASSOCIATED CONSTRUCTION AT CLOSE OF EACH WORK DAY.
4. PAVED SURFACES SHALL BE PROTECTED FROM DAMAGE BY TRACKED EQUIPMENT.
5. CONTRACTOR WILL PAY ALL COST TO REPLACE IRON RODS OR OTHER LAND BOUNDARY MARKERS DISTURBED DURING CONSTRUCTION. A REGISTERED LAND SURVEYOR WILL BE USED TO RESET DISTURBED BOUNDARY MARKERS.
6. THE CONTRACTOR SHALL BE RESPONSIBLE FOR MAINTAINING AN UPDATE REDLINED "RECORD" SET OF CONSTRUCTION DRAWINGS ON SITE FOR INSPECTION BY THE ENGINEER.
7. CONTRACTOR SHALL PROVIDE ORANGE FENCING OR BARRICADES TO PROTECT PEDESTRIANS FROM ENTERING WORK AREAS.
8. CONTRACTOR MUST PROVIDE FENCING AROUND OPEN EXCAVATIONS AREA AT ALL TIMES.
9. REFER TO THE SWPPP GENERAL NOTES FOR PROPER MEASURES AND CONTROLS.

B. PAVEMENT

- 1. EXISTING PAVEMENTS, CURBS, SIDEWALKS, AND DRIVEWAYS DAMAGE OR REMOVED DURING CONSTRUCTION SHALL BE REPLACED TO ORIGINAL CONDITION OR BETTER, IN ACCORDANCE WITH THE GOVERNMENT AGENCY HAVING JURISDICTION.
2. THE SUBGRADE SHALL BE BROUGHT TO THE LINES AND GRADES AS SHOWN ON THE DRAWINGS.
3. WHENEVER UNSUITABLE MATERIAL IS ENCOUNTERED AND CANNOT BE HANDLED BY THE EXCAVATION OR EMBANKMENT REQUIREMENTS, THEN THE UNSUITABLE MATERIAL SHALL BE EXCAVATED TO A DEPTH DEEMED SUFFICIENT BY THE ENGINEER AND THE EXCAVATED MATERIAL SHALL BE DISPOSED OF OFF THE JOB SITE. THE EXCAVATED AREA SHALL BE FILLED WITH SELECT FILL PER STANDARDS OF THE GOVERNMENT AGENCY HAVING JURISDICTION.
4. SURPLUS EXCAVATED EARTHEN MATERIAL BECOMES THE PROPERTY OF THE CONTRACTOR AND SHALL BE REMOVED AND DISPOSED OF OFF-SITE. INCLUDE COST OF REMOVAL AND DISPOSAL IN OTHER ITEMS OF WHICH THIS WORK IS A COMPONENT PART. NO SEPARATE PAY. THE MATERIAL MUST BE DISPOSED OF IN A SAFE AND LEGAL MANNER.
5. EXISTING WATER VALVES AND MANHOLES SHALL BE ADJUSTED, AS NECESSARY TO MATCH TOP OF PROPOSED PAVEMENT ELEVATION.

C. SANITARY SEWER, STORM SEWER & DRAINAGE

- 1. ADEQUATE DRAINAGE SHALL BE MAINTAINED AT ALL TIMES DURING CONSTRUCTION.
2. ANY CURB DISTURBED DURING CONSTRUCTION SHALL BE RESTORED TO THE SATISFACTION OF THE ENGINEER OR OWNING AUTHORITY.
3. CONTRACTOR'S ACTIVITIES SHALL HAVE NO EFFECT TO FLOWS TO AND FROM OFF SITE AREAS EXISTING SHEET DRAINAGE SHALL NOT BE IMPEDED BY PROPOSED CONSTRUCTION.
4. WHERE MANHOLES ARE LOCATED WITHIN PAVED AREAS, CONTRACTOR SHALL SET RIM ELEVATIONS TO MATCH FINISHED GRADE ELEVATIONS. OUTSIDE OF PAVED AREAS, SET MANHOLE RIMS 3 INCHES (MINIMUM) TO 6 INCHES (MAXIMUM) ABOVE FINISHED GRADE. ADD SLOPE FILL AROUND MANHOLES, SLOPED AWAY AND DOWN FROM MANHOLE RING.
5. NO DUMPING OF EXCAVATION MATERIALS WILL BE ALLOWED ON PAVED AREAS. CONTRACTOR MUST DETERMINE A LOCATION TO TEMPORARILY STOCKPILE STORM SEWER EXCAVATION TO BE USED AS BACK FILL, AS APPROVED.
6. THE CONTRACTOR SHALL USE HDPE PLASTIC PIPE OR RCP PIPE AS SHOWN ON PLANS.

D. STANDARD NOTES FOR CONSTRUCTION DRAWINGS:

- 1. CONTRACTOR SHALL BE RESPONSIBLE FOR PROTECTING, MAINTAINING, AND RESTORING BACKSLOPE DRAINAGE SYSTEMS.
2. ALL DISTURBED AREAS WITHIN THE SUBDIVISION, EXCEPT THE CHANNEL BOTTOM, SHALL BE FERTILIZED SEEDED.
3. ALL BACKFILL SHALL BE STRICTLY ACCORDING TO DETAILS, SPECIFICATION OR GEOTECHNICAL RECOMMENDATIONS, AS APPROVED BY ENGINEER.
4. CONTRACTOR SHALL BE RESPONSIBLE FOR EXCAVATING CHANNEL FLOWLINE TO DESIGN ELEVATIONS AS SHOWN ON PLANS AND DOWNSTREAM AS NECESSARY TO ENSURE NO WATER IN STORM SEWER DURING "DRY" CONDITIONS.
5. CONTRACTOR SHALL BE RESPONSIBLE FOR MAINTAINING FLOW IN CHANNEL DURING CONSTRUCTION AND RESTORING CHANNEL TO ORIGINAL CONDITION.

E. UTILITIES

1. CENTERPOINT ENERGY

WARNING: OVERHEAD ELECTRICAL FACILITIES

A. OVERHEAD LINES MAY EXIST ON THE PROPERTY. WE HAVE ATTEMPTED TO MARK THOSE LINES SINCE THEY ARE CLEARLY VISIBLE, BUT YOU SHOULD LOCATED THEM PRIOR TO BEGINNING ANY CONSTRUCTION. TEXAS LAW, SECTION 752, HEALTH & SAFETY CODE, FORBIDS ALL ACTIVITIES IN WHICH PERSONS OR THINGS MAY COME WITHIN SIX (6) FEET OF LIVE OVERHEAD HIGH VOLTAGE LINES. PARTIES RESPONSIBLE FOR THE WORK, INCLUDING CONTRACTORS, ARE LEGALLY RESPONSIBLE FOR THE SAFETY OF CONSTRUCTION WORKERS UNDER THIS LAW. THIS LAW CARRIES BOTH CRIMINAL AND CIVIL LIABILITY. TO ARRANGE FOR LINES TO BE TURNED OFF OR REMOVED, CALL CENTERPOINT ENERGY, AT (713) 207-7777.

CAUTION: UNDERGROUND GAS FACILITIES

- A. LOCATIONS OF CENTERPOINT ENERGY MAIN LINES, (TO INCLUDE GAS TRANSMISSION, AND/OR INDUSTRIAL GAS SUPPLY CORP. WHERE APPLICABLE), ARE SHOWN IN AN APPROXIMATE LOCATION ONLY. SERVICE LINES ARE USUALLY NOT SHOWN. THE CONTRACTOR SHALL CONTACT THE UTILITY COORDINATING COMMITTEE AT (713) 223-4567 OR 1-800-669-8344 A MINIMUM OF 48 HOURS PRIOR TO CONSTRUCTION TO HAVE MAIN AND SERVICE LINES FIELD LOCATED.
B. WHEN CENTERPOINT ENERGY PIPE LINE MARKINGS ARE NOT VISIBLE, CALL (713)-967-8037 FROM 7:00 AM TO 4:30 PM FOR STATUS OF LINE LOCATION REQUEST BEFORE EXCAVATION BEGINS.
C. WHEN EXCAVATING WITHIN EIGHTEEN INCHES (18") OF THE INDICATED LOCATION OF CENTERPOINT ENERGY FACILITIES, ALL EXCAVATION MUST BE ACCOMPLISHED USING NON-MECHANIZED EXCAVATION PROCEDURES.
D. WHEN CENTERPOINT ENERGY FACILITIES ARE EXPOSED, SUFFICIENT SUPPORT MUST BE PROVIDED TO FACILITIES TO PREVENT EXCESSIVE STRESS ON THE PIPING.
E. THE CONTRACTOR IS FULLY RESPONSIBLE FOR ANY DAMAGES CAUSED BY HIS FAILURE TO EXACTLY LOCATE AND PRESERVE THESE UNDERGROUND FACILITIES.

F. OTHER:

- 1. LOCATION OF ALL EXISTING UNDERGROUND UTILITIES SHOWN ON PLANS IS NOT GUARANTEED TO BE COMPLETE OR DEFINITE. THE APPROXIMATE LOCATIONS OF KNOWN EXISTING UTILITIES ARE SHOWN. CONTRACTOR SHALL DETERMINE THE EXACT SIZE AND HORIZONTAL AND VERTICAL LOCATIONS IN THE FIELD. THE CONTRACTOR SHALL NOTIFY ALL OF THE PROPER GOVERNING AUTHORITIES, (STATE, COUNTY OR CITY) AT LEAST 48 HOURS PRIOR TO COMMENCING WORK.
2. ANY PERMANENT RELOCATION OF AN EXISTING UTILITY NOT SHOWN ON THE DRAWINGS SHALL BE APPROVED BY THE ENGINEER PRIOR TO RELOCATION AND SHALL CONFORM TO THE APPLICABLE STANDARDS OF GOVERNING AUTHORITIES.
3. CONTRACTOR SHALL PROTECT EXISTING UNDERGROUND FACILITIES DURING INSTALLATION OF PROPOSED WORK.
4. IN THE EVENT THAT ANY CONTAMINATED MATERIALS OF SUSPECT CONTAMINATED MATERIALS ARE ENCOUNTERED DURING CONSTRUCTION ACTIVITIES, THE CONTRACTOR SHALL CEASE OPERATIONS IN THAT AREA AND IMMEDIATELY NOTIFY THE ENGINEER.
5. ALL CONSTRUCTION SHALL CONFORM TO THE STANDARDS OF THE GOVERNMENTAL AGENCY HAVING JURISDICTION.
6. ALL PAVEMENT SHALL CONFORM WITH THE STANDARDS OF THE GOVERNMENTAL AGENCY HAVING JURISDICTION.
7. ALL STORM SEWERS SHALL BE CONSTRUCTED OF REINFORCED CONCRETE PIPE (RCP) ASTM C-76, CLASS III, EXCEPT FOR ALUMINIZED STEEL PIPE FOR OUTFALLS. (SEE DETAILS FOR BEDDING).
8. STEEL METAL PIPE SHALL BE ALUMINIZED STEEL AASHTO M274 TYPE 2 MIN. 0.052 THICKNESS.
9. ALL GRAVITY SANITARY SEWERS SHALL BE CONSTRUCTED OF PVC PIPE (ASTM D-3034, SDR 26), UNLESS OTHERWISE NOTED ON THE DRAWINGS.
10. ALL FORCE MAIN SANITARY SEWERS SHALL BE CONSTRUCTED OF PVC PIPE (ASTM D-3034, SDR 26), UNLESS OTHERWISE NOTED ON THE DRAWINGS.
11. ALL SANITARY SEWERS AND WATER MAINS SHALL HAVE SIX (6) INCHES OF SAND BACKFILL BOTH UNDER AND OVER PIPE WITH DETECTOR TAPE (METALLIC) INSTALLED 1.5' BELOW FINISH GRADE.
12. BACKFILL WITH CEMENT STABILIZED SAND WHEN SANITARY SEWER CROSSES OVER STORM SEWER (SPACE BETWEEN STORM AND SANITARY SEWERS).
13. ALL SEWERS UNDER OR WITHIN ONE (1) FOOT OF PROPOSED OR FUTURE PAVEMENT SHALL BE BACKFILLED WITH 1 1/2 SACK CEMENT STABILIZED SAND TO WITHIN ONE (1) FOOT OF SUBGRADE.
14. COST OF SPECIAL BACKFILL AND BEDDING IS INCIDENTAL TO THE UNIT PRICE BID PER LINEAR FOOT, NO EXTRA PAY.
15. WATER MAINS SHALL BE C-900 PVC PIPE BEARING THE NSF-PWSEAL AND FITTINGS SHALL BE DUCTILE IRON MECHANICAL JOINT WITH NON-CORRODING HARDWARE INCLUDING MEGA-LUG RESTRAINTS CONFORMING TO AWWA CL-110 OR C-153.
16. FIRE HYDRANTS SHALL BE "MUELLER IMPROVED" OR APPROVED EQUAL.
17. MINIMUM OF SIX (6) INCHES OF CLEARANCE SHALL BE MAINTAINED BETWEEN WATER MAIN CROSSING OF OTHER UTILITIES.
18. ALL PROPOSED PIPE STUB-OUTS FROM STORM MANHOLES OR INLETS ARE TO BE PLUGGED WITH EIGHT (8) INCH BRICK WALLS UNLESS OTHERWISE NOTED.
19. THE CONTRACTOR SHALL NOTIFY THE CITY OR GOVERNMENTAL AGENCY HAVING JURISDICTION, 48 HOURS IN ADVANCE OF COMMENCING CONSTRUCTION.
20. GUIDELINES SET FORTH IN THE MANUAL ON UNIFORM TRAFFIC CONTROL DEVICES SHALL BE OBSERVED.
21. ALL SANITARY SEWERS SHALL BE CONSTRUCTED IN ACCORDANCE WITH TCEQ "RULES AND REGULATIONS FOR PUBLIC WATER SYSTEMS".
22. CONTRACTOR SHALL OBTAIN ALL CONSTRUCTION PERMITS REQUIRED TO THE STANDARDS OF THE GOVERNMENTAL AGENCY HAVING JURISDICTION.
23. SANITARY MANHOLES WITHIN THE FLOOD PLAIN SHALL BE WATERPROOFED AND VENTED WITH RISER ABOVE FLOOD PLAIN OR RIMS SET ABOVE THE 100 YEAR FLOOD ELEVATION.
24. WHERE A NEW POTABLE WATERLINE CROSSES A NEW, NON-PRESSURE RATED WASTEWATER MAIN OR LATERAL AND A STANDARD LENGTH OF THE WASTEWATER PIPE IS LESS THAN 18 FEET IN LENGTH, THE POTABLE WATER PIPE SEGMENT SHALL BE CENTERED OVER THE WASTEWATER LINE. THE MATERIALS AND METHOD OF INSTALLATION SHALL CONFORM WITH ONE OF THE FOLLOWING OPTIONS.

(II) WHEN A NEW WATERLINE CROSSES UNDER A WASTEWATER MAIN OR LATERAL, THE WATERLINE SHALL BE ENCASED AS DESCRIBED FOR WASTEWATER MAINS OR LATERALS IN SUBCLASS (II) OF THIS CLAUSE OR CONSTRUCTED OF DUCTILE IRON OR STEEL PIPE WITH MECHANICAL OR WELDED JOINTS AS APPROPRIATE. AN ABSOLUTE MINIMUM SEPARATION DISTANCE OF ONE FOOT BETWEEN THE WATERLINE AND THE WASTEWATER MAIN OR LATERAL SHALL BE PROVIDED. BOTH THE WATERLINE AND WASTEWATER MAIN OR LATERAL MUST PASS A PRESSURE AND LEAKAGE TEST AS SPECIFIED IN AWWA C600 STANDARDS.

- 25. COST OF TRENCH SAFETY SYSTEMS AS REQUIRED BY OSHA FOR DEPTHS OVER FIVE (5) FEET IS INCIDENTAL TO THE PROJECT.
26. WATER LINES ARE TO BE CONSTRUCTED TYPICALLY 4 FEET DEEP TO THE TOP OF THE LINE FROM THE FINISHED CURB ELEVATION OR NATURAL GROUND. LINES MAY BE SAGGED OR RAISED WITHIN THE RANGE OF 3-6 FEET TO AVOID UTILITY CONFLICTS WATER LINE DEFLECTIONS SHALL NOT EXCEED THE PIPE MANUFACTURES RECOMMENDATIONS.
27. ALL SLEEVES TO BE FOUR (4) INCH SCHEDULE 40 PVC SLEEVES TO BE EIGHTEEN (18) INCHES BELOW THE BOTTOM OF THE PAVEMENT BASE MATERIAL. STUB OUT THREE (3) FEET BEYOND CURB AND MARK SLEEVES LOCATIONS ON CURB.
28. THERE SHALL BE A MINIMUM HORIZONTAL DISTANCE OF FOUR (4) FEET CLEARANCE BETWEEN ALL WATER LINES AND SANITARY SEWER LINES THAT ARE SDR 26, AND A NINE (9) FOOT CLEARANCE BETWEEN ALL WATER LINES AND SANITARY SEWER LINES THAT ARE SDR 35. (SEE DETAIL)
29. ALL JOINTS OF DUCTILE IRON PIPE BELOW GROUND WILL BE M.J. WITH PIPE RESTRAINTS.
30. ALL SIGNAGE AND/OR TRAFFIC CONTROL DEVICES SHALL BE APPROVED BY HARRIS COUNTY PRIOR TO CONSTRUCTION.

NOTE:
IT SHALL BE THE RESPONSIBILITY OF THE CONTRACTOR TO LOCATE ALL UTILITIES IN THE ROAD R.O.W. PRIOR TO CONSTRUCTION. (TEXAS ONE CALL 1-800-545-6005)

NOTE:
CONTRACTOR SHALL ADJUST ALL WATER VALVES AND STORM SEWER MANHOLES TO MATCH FINAL GRADES. SEE ALL GRADING PLANS SHEETS.

NOTE:
CONTRACTOR SHALL VERIFY ALL WATER, SANITARY SEWER AND STORM SEWER LINES PRIOR TO WORKING IN ANY AREA. SEE TOPO MAP AND REFERENCE DRAWINGS.

NOTE:
THIS DEVELOPMENT HAS BEEN DESIGNED TO NOT IMPEDE, IMPOUND, OR BLOCK THE NATURAL FLOW OF DRAINAGE FROM OR ACROSS ADJACENT AND CONTIGUOUS PROPERTIES.

NOTE:
ALL FUTURE SITE AND BUILDINGS PROJECTS WILL REQUIRE CIVIL/SITE DRAWING APPROVAL AND CHANGES TO THE PLATS MAY BE REQUIRED AS A PART OF THE REVIEW PROCESS.


ALL PIPE PLACEMENT AND JOINTING WILL BE CONSTRUCTED STRICTLY IN ACCORDANCE WITH THE MANUFACTURES' REQUIREMENTS AND SPECIFICATIONS.

STORM SEWER PIPE — HDPE N-12, PVC SDR35 OR RCP CLASS III (RUBBER GASKET)— EXCEPT IF NOTED OTHERWISE
POTABLE WATER — 3" AND SMALLER — SCH 80 PVC
4" AND LARGER — C-900, DR 18- 150 PSI
SANITARY SEWER — GRAVITY , PVC SDR 26
CULVERT PIPE — RCP CLASS IV 18"

THE OWNER WILL SET UP THE NECESSARY WATER ACCOUNTS AND PURCHASE THE WATER METERS AND METER BOXES.
THE CONTRACTOR WILL PICK UP THE METERS AND BOXES AT THE CITY AND DELIVER THEM TO THE JOBSITE.
THE CONTRACTOR WILL MAKE THE NECESSARY TAPS AND INSTALL THE METERS AS REQUIRED BY HARRIS COUNTY.

ONE- CALL NOTIFICATION SYSTM
CALL BEFORE YOU DIG!!
(713) 223-4567 (In Houston, TX)
(New Statewide Number Outside Houston)
1-800-545-6005

KEY PLAN (NOT TO SCALE)

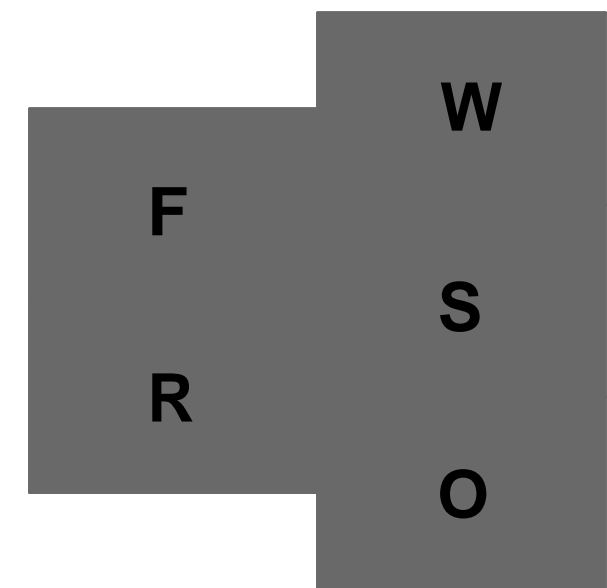

REVISION HISTORY
ADDENDUM NO. 3 10-07-2020

REVISION DESCRIPTION DATE
PROFESSIONAL SEALS









GENERAL NOTES

Table with columns: DRAWN BY (JDM), CHECKED BY (JDM), PROJECT NUMBER (418198), PROJECT ABBREVIATION (GC-R&B), ORIGINAL ISSUE DATE, ISSUE FOR PERMIT DATE (07 OCT 2020)

C7.0-PH3
SHEET NUMBER




Galveston County
Road & Bridge Department Facilities PH3
5115 Texas Highway 3
Dickinson, TX

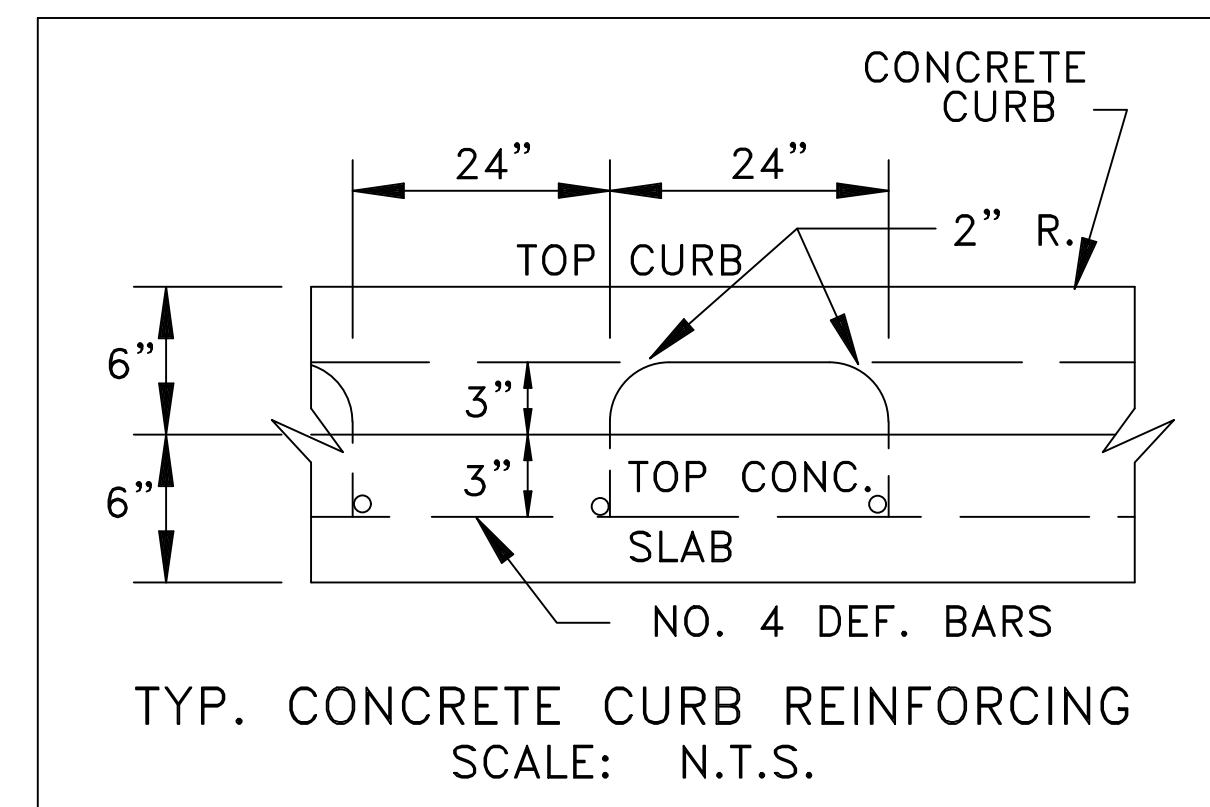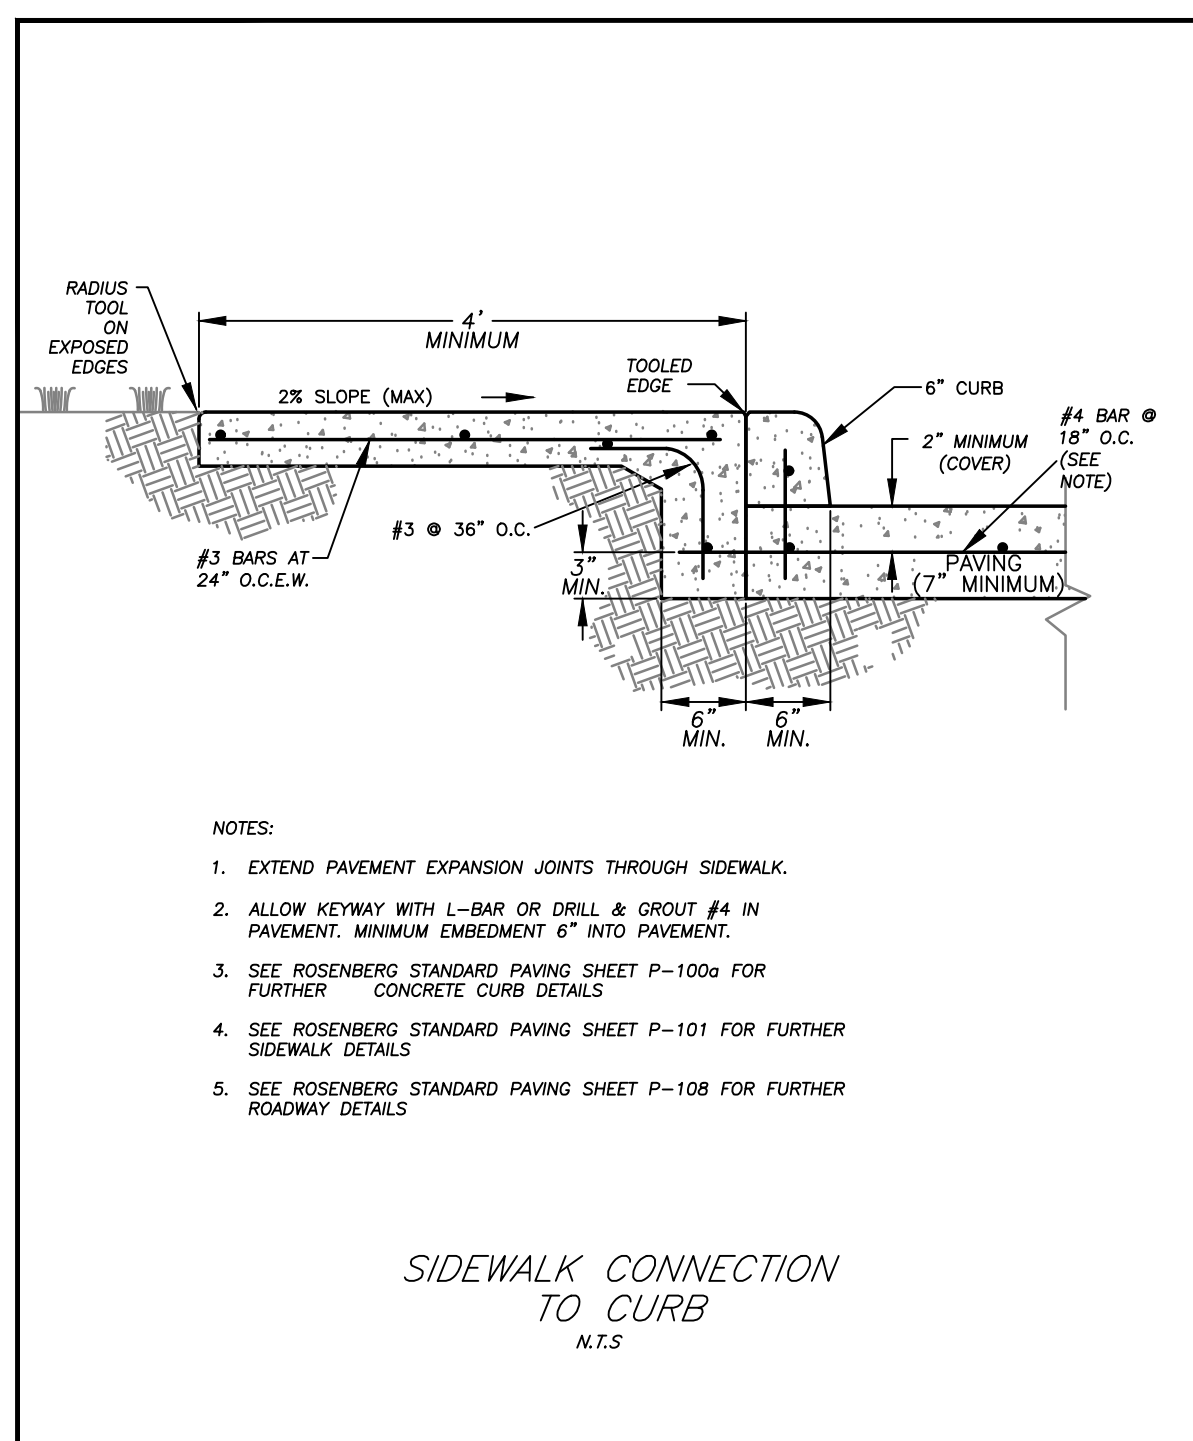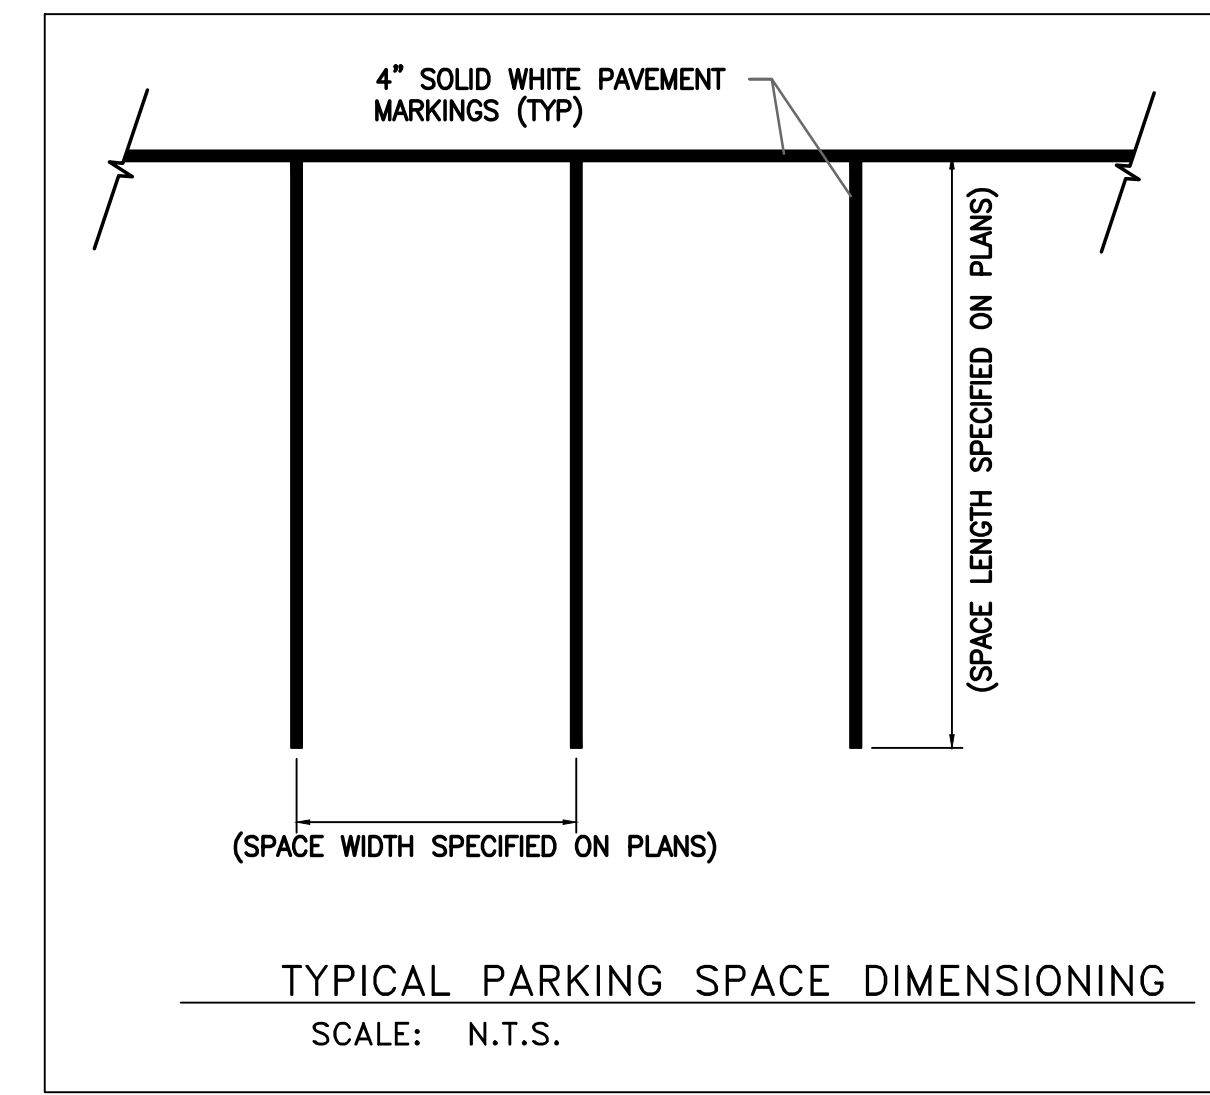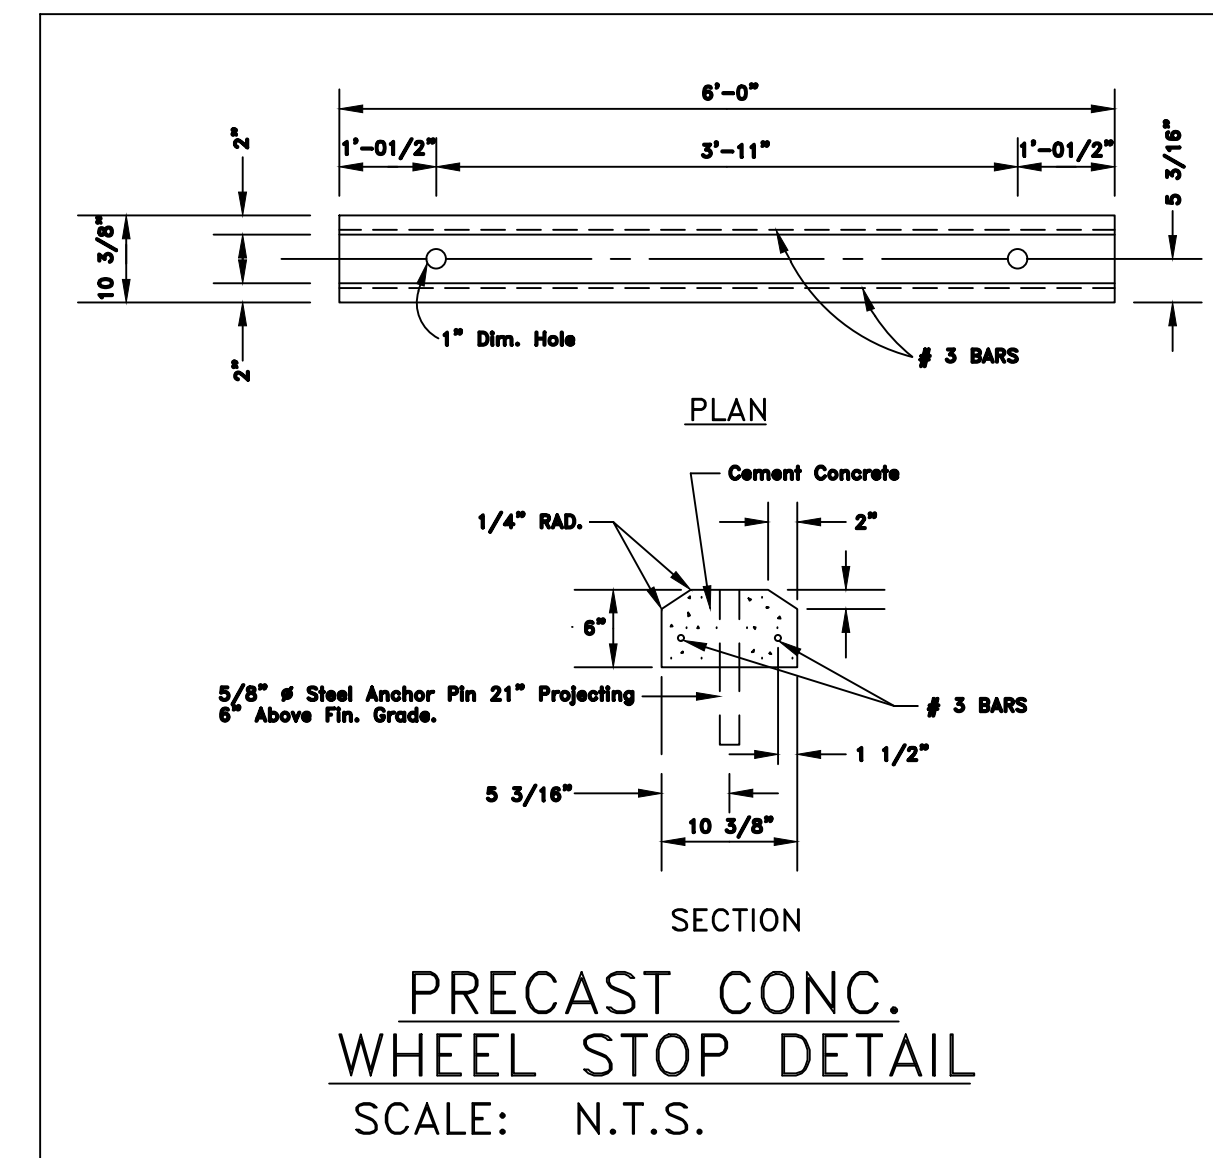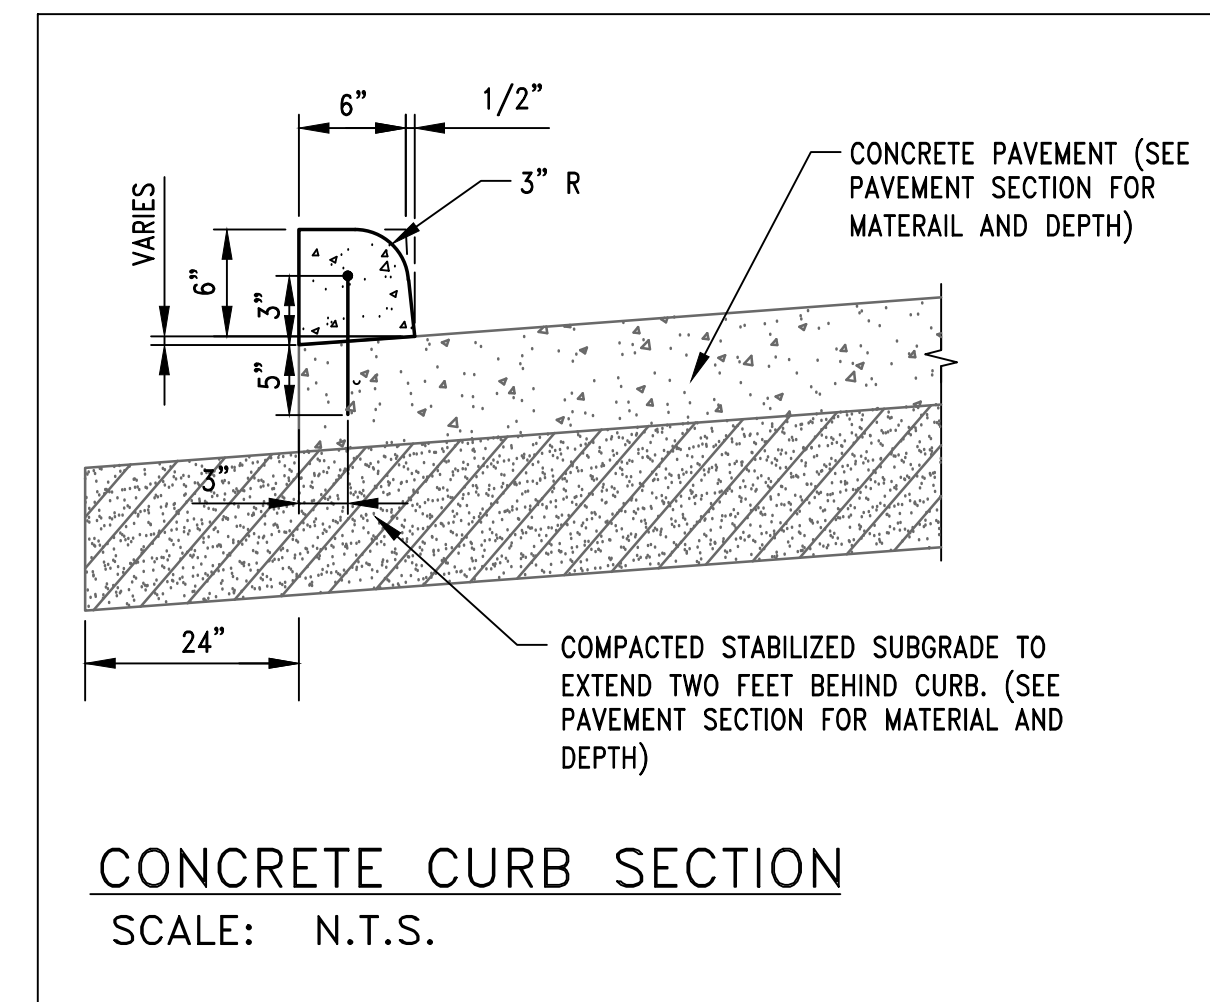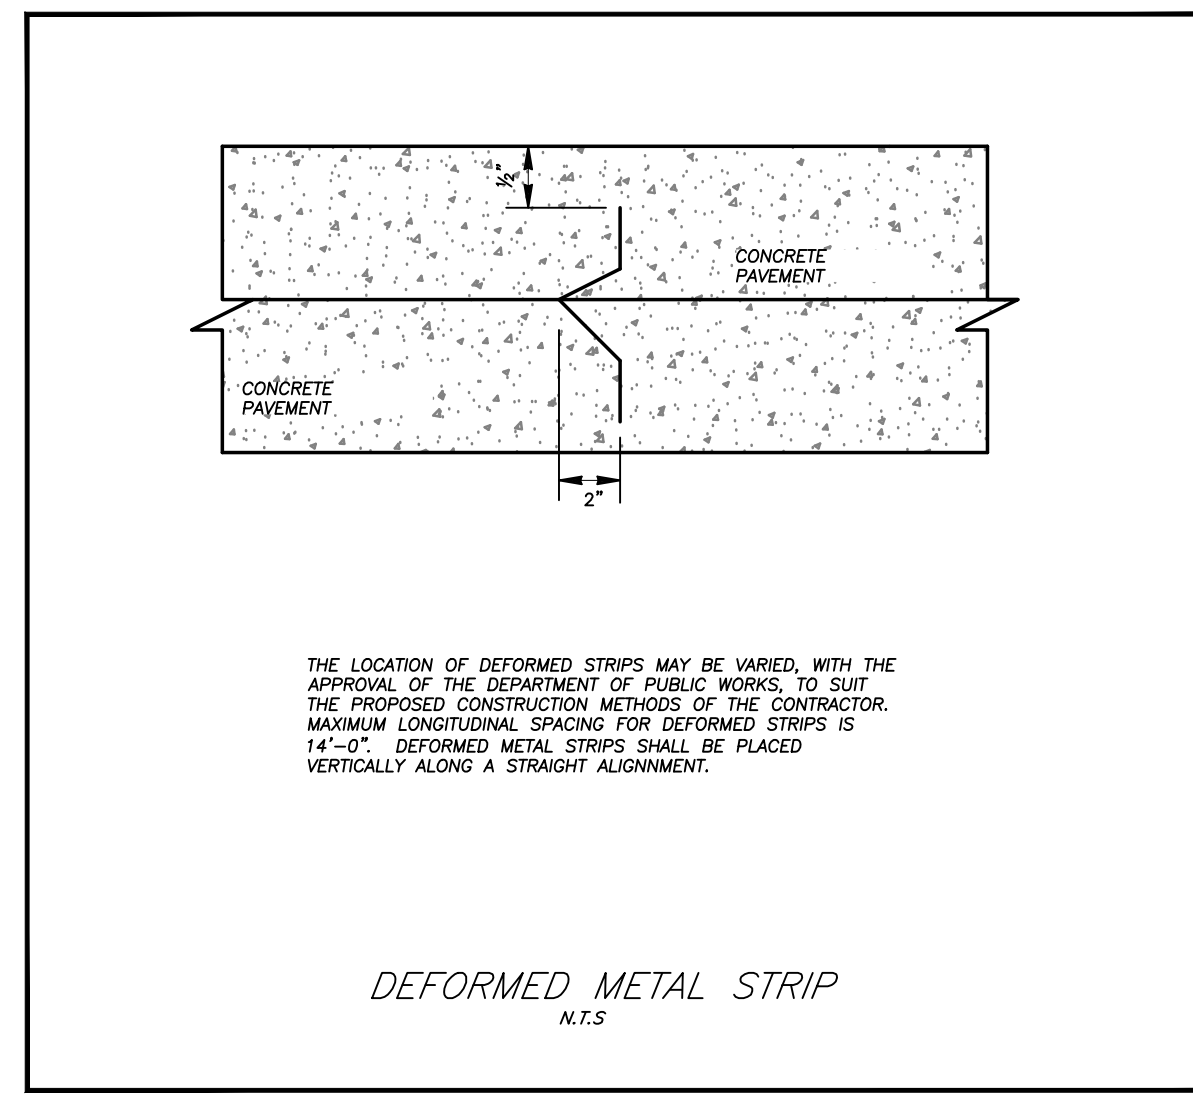

CEMENT STABILIZED SAND SUB-BASE	
RESIDENTIAL	4" MINIMUM
COMMERCIAL	6" MINIMUM
INDUSTRIAL	8" MINIMUM
REINFORCED CONCRETE PAVEMENT	
3,500 PSI MIN.	
RESIDENTIAL	4" MINIMUM
COMMERCIAL	6" MINIMUM
INDUSTRIAL	8" MINIMUM

DRIVEWAY PAVEMENT CONSTRUCTION TABLE

STANDARD DRIVEWAY CONSTRUCTION TABLE & NOTES
N.T.S.

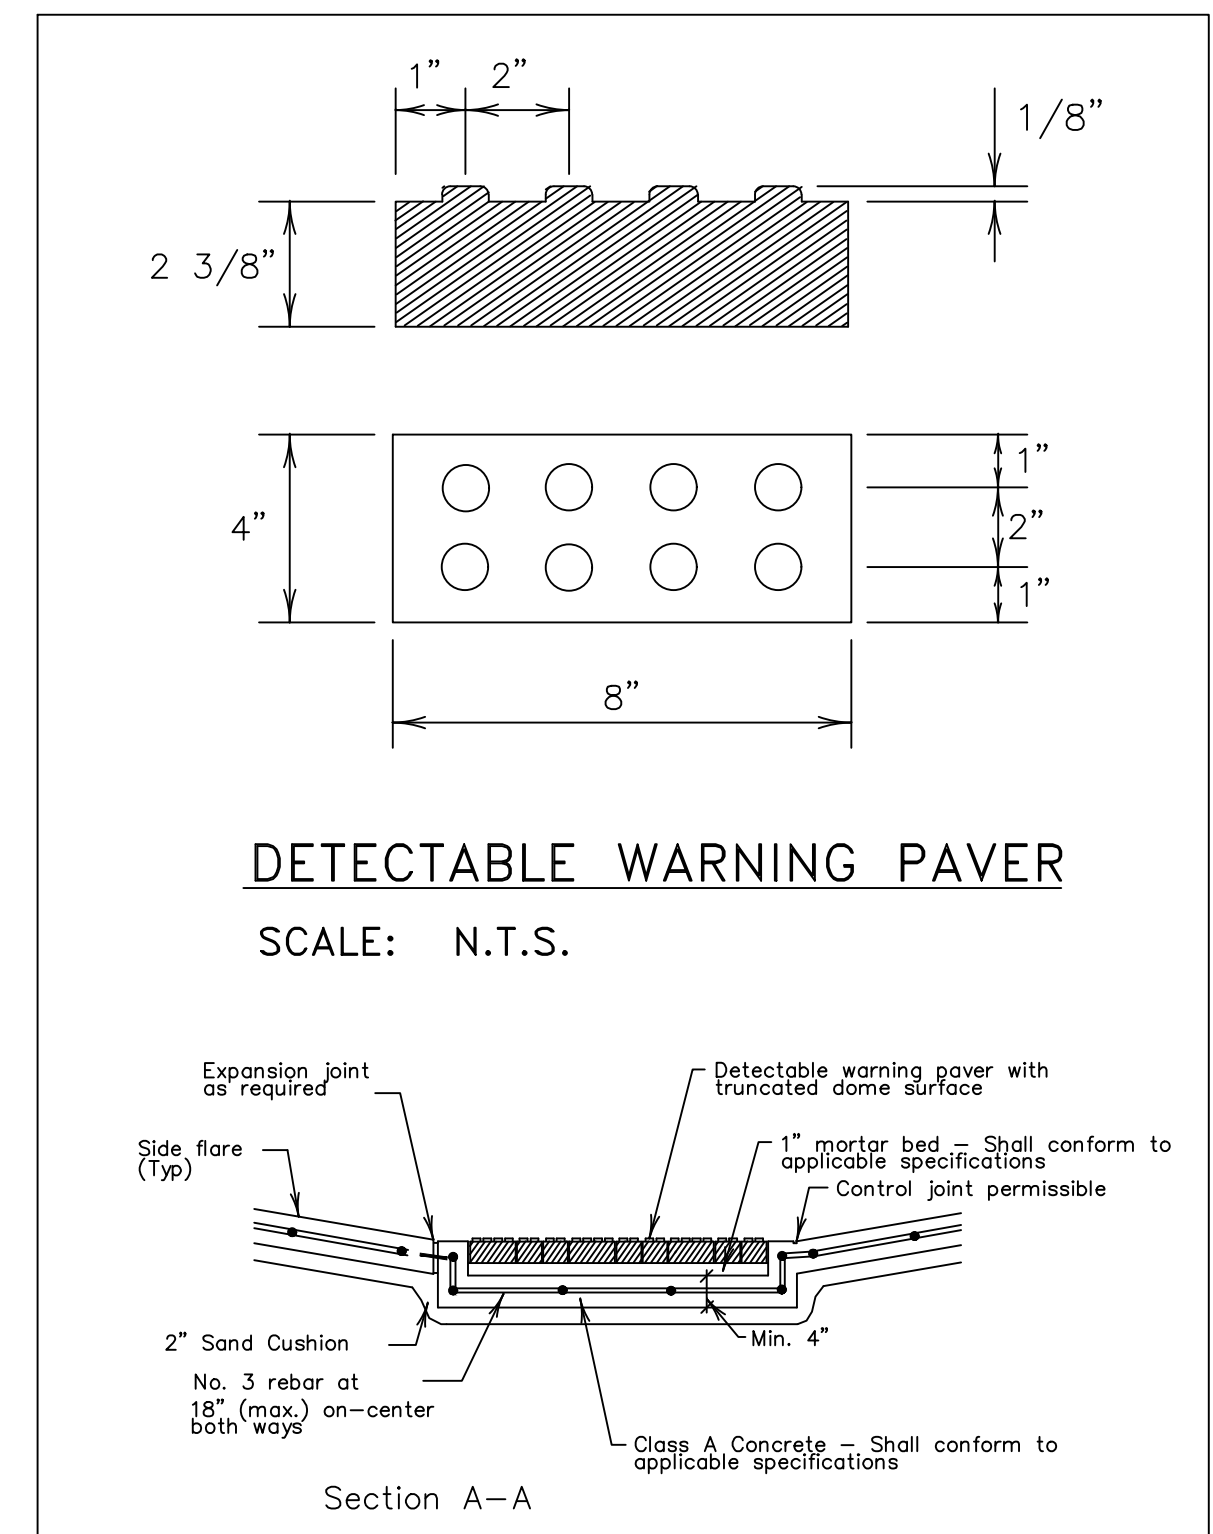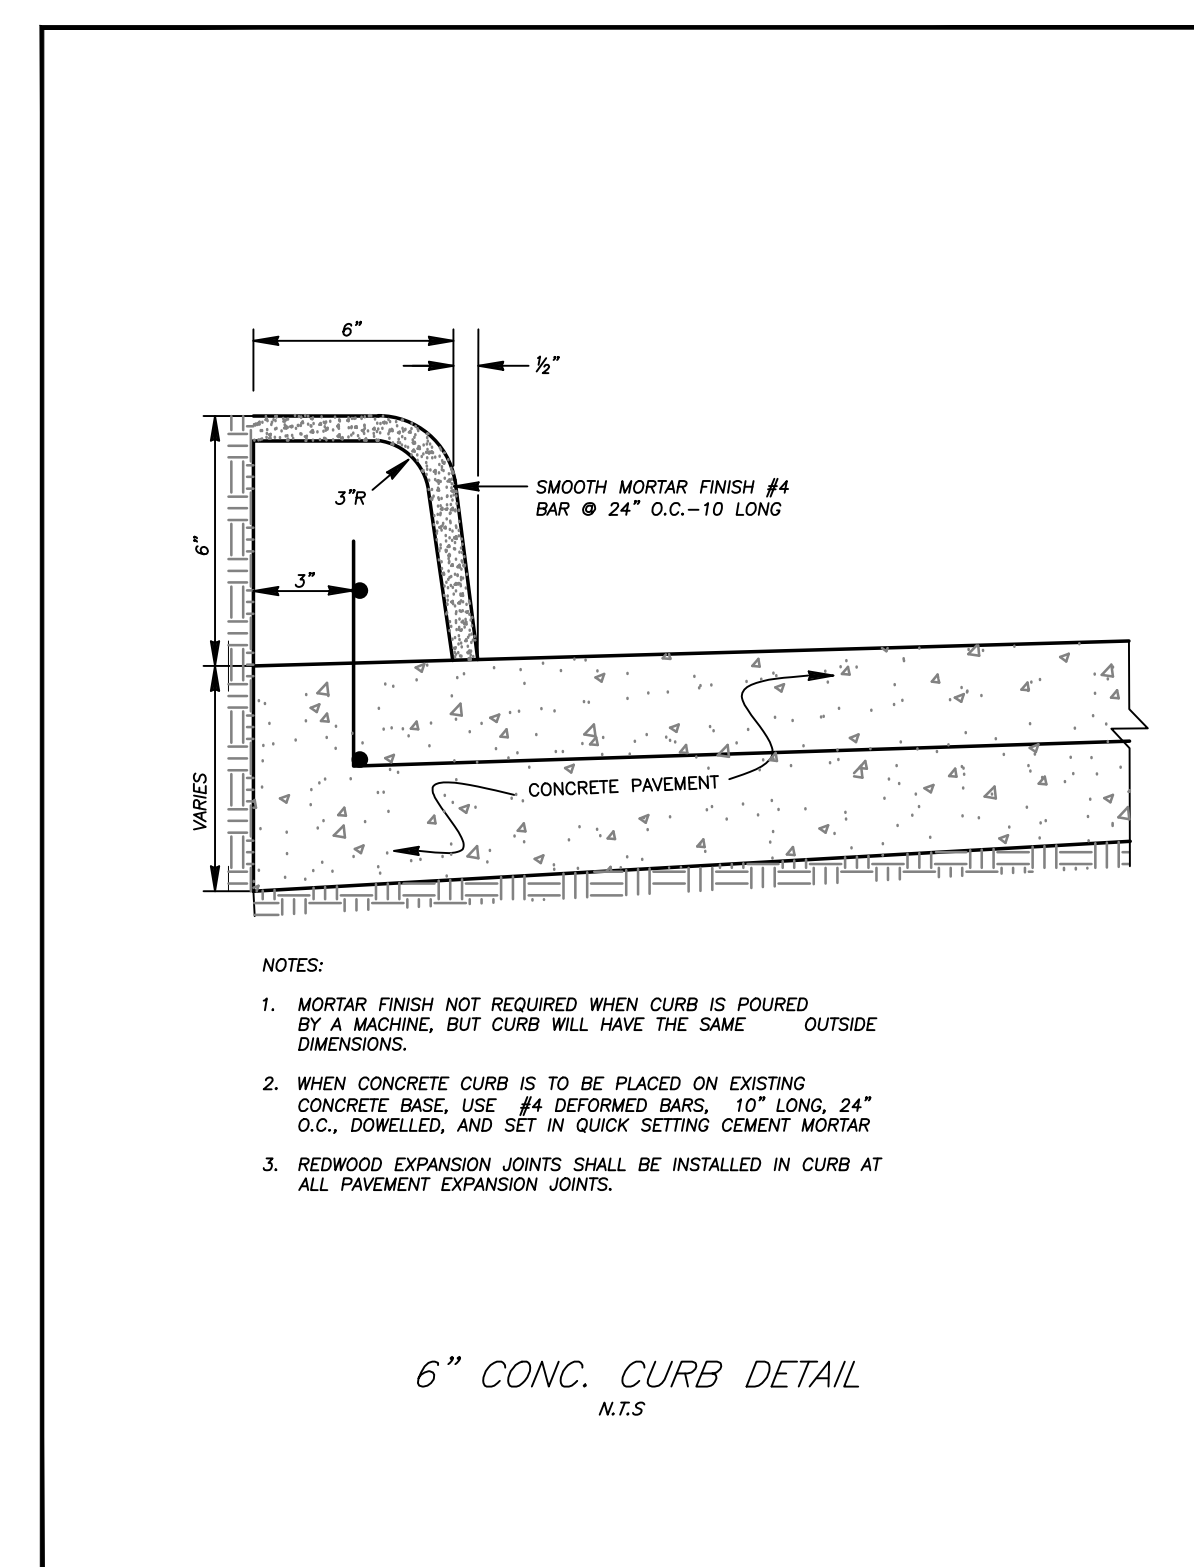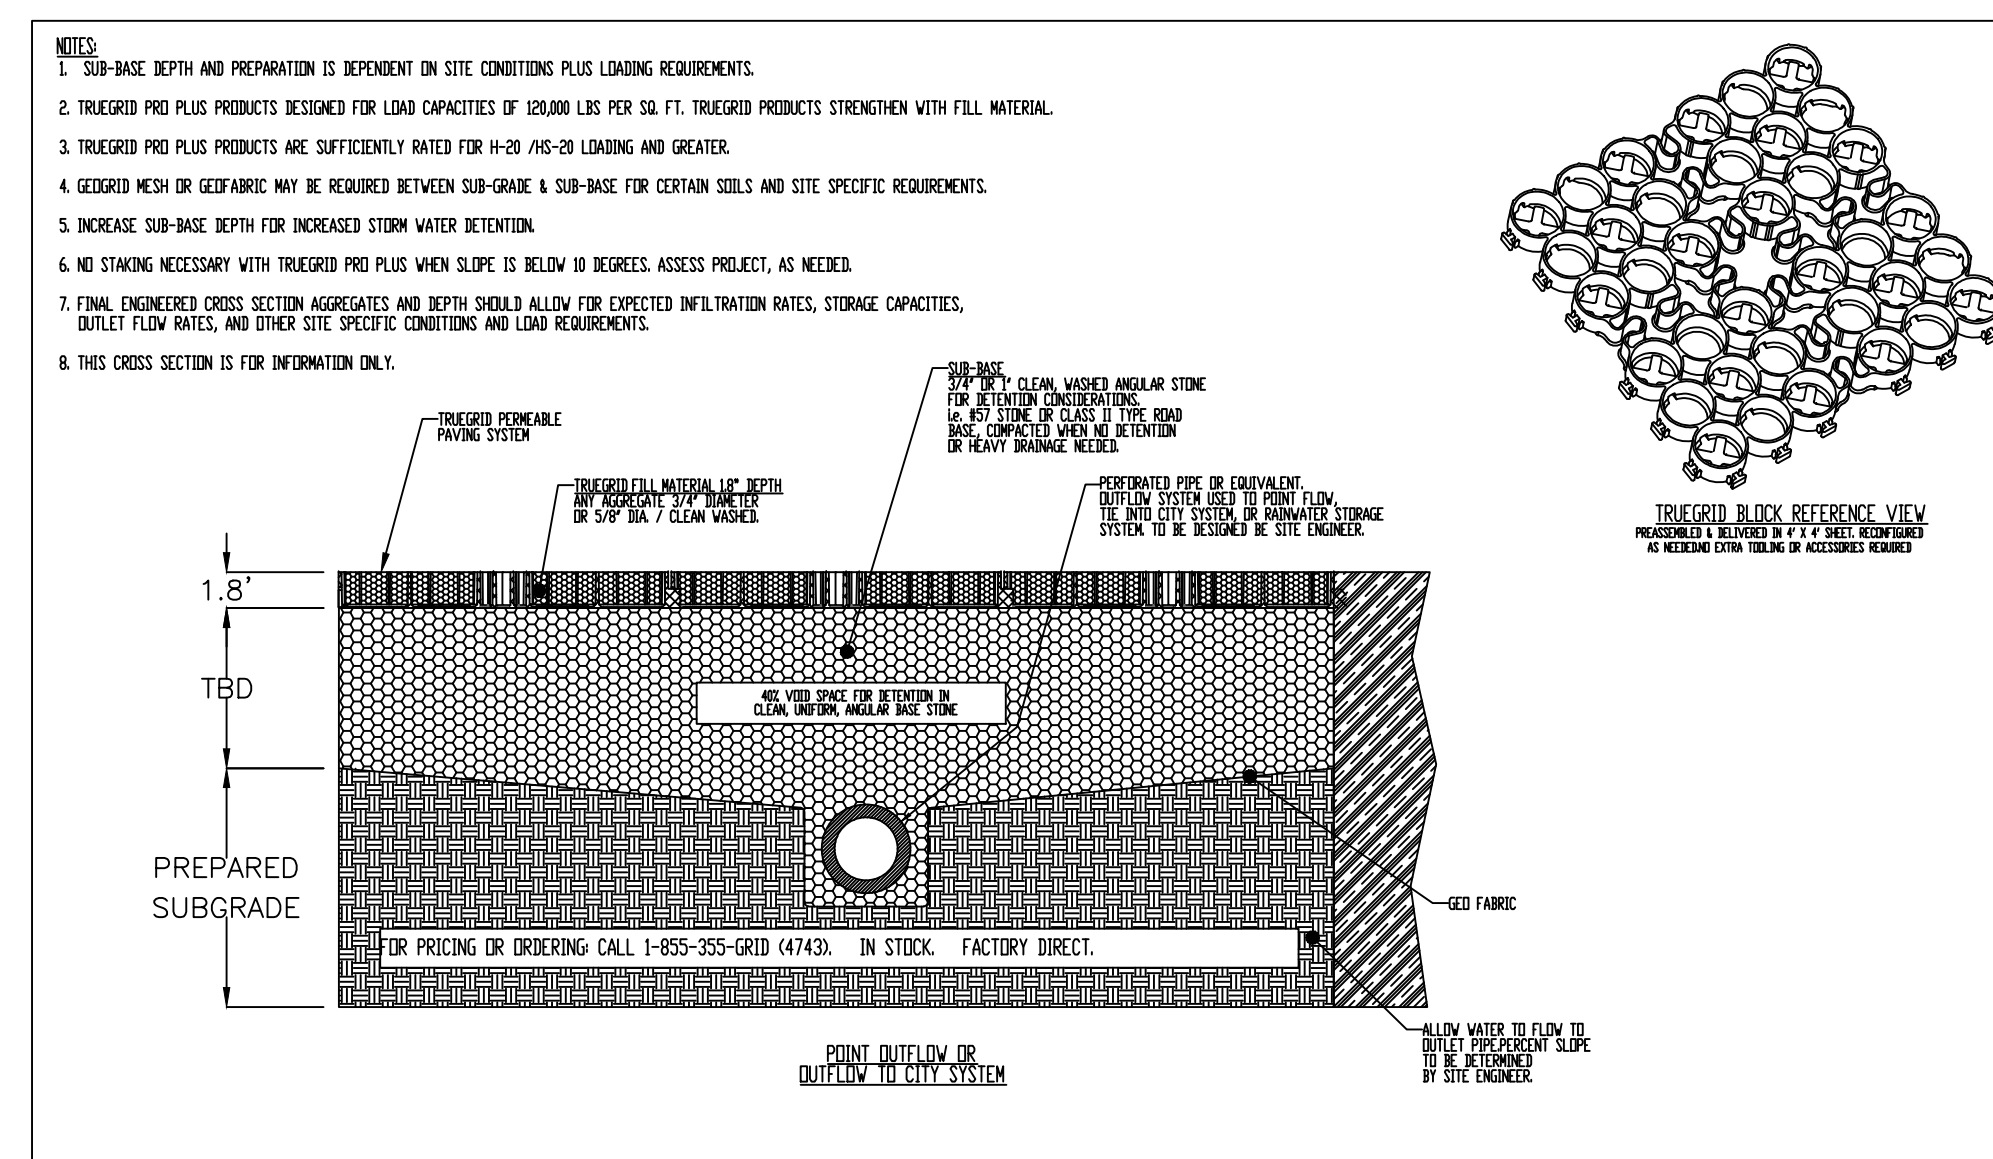

ONE- CALL NOTIFICATION SYSTEM
CALL BEFORE YOU DIG!!!
(713) 223-4567 (In Houston, TX)
(New Statewide Number Outside Houston)
1-800-545-6005

KEY PLAN (NOT TO SCALE)

W
F
S
O
R

REVISION HISTORY		
ADDENDUM NO. 3	10-07-2020	

REVISION DESCRIPTION DATE

PROFESSIONAL SEALS

FRED DALLY
90904
LICENSED PROFESSIONAL ENGINEER
10/07/2020



PAVEMENT DETAILS

DRAWN BY JDM CHECKED BY JDM

PROJECT NUMBER 418198 PROJECT ABBREVIATION GC-R&B

ORIGINAL ISSUE DATE 07 OCT 2020

C8.0-PH3
SHEET NUMBER

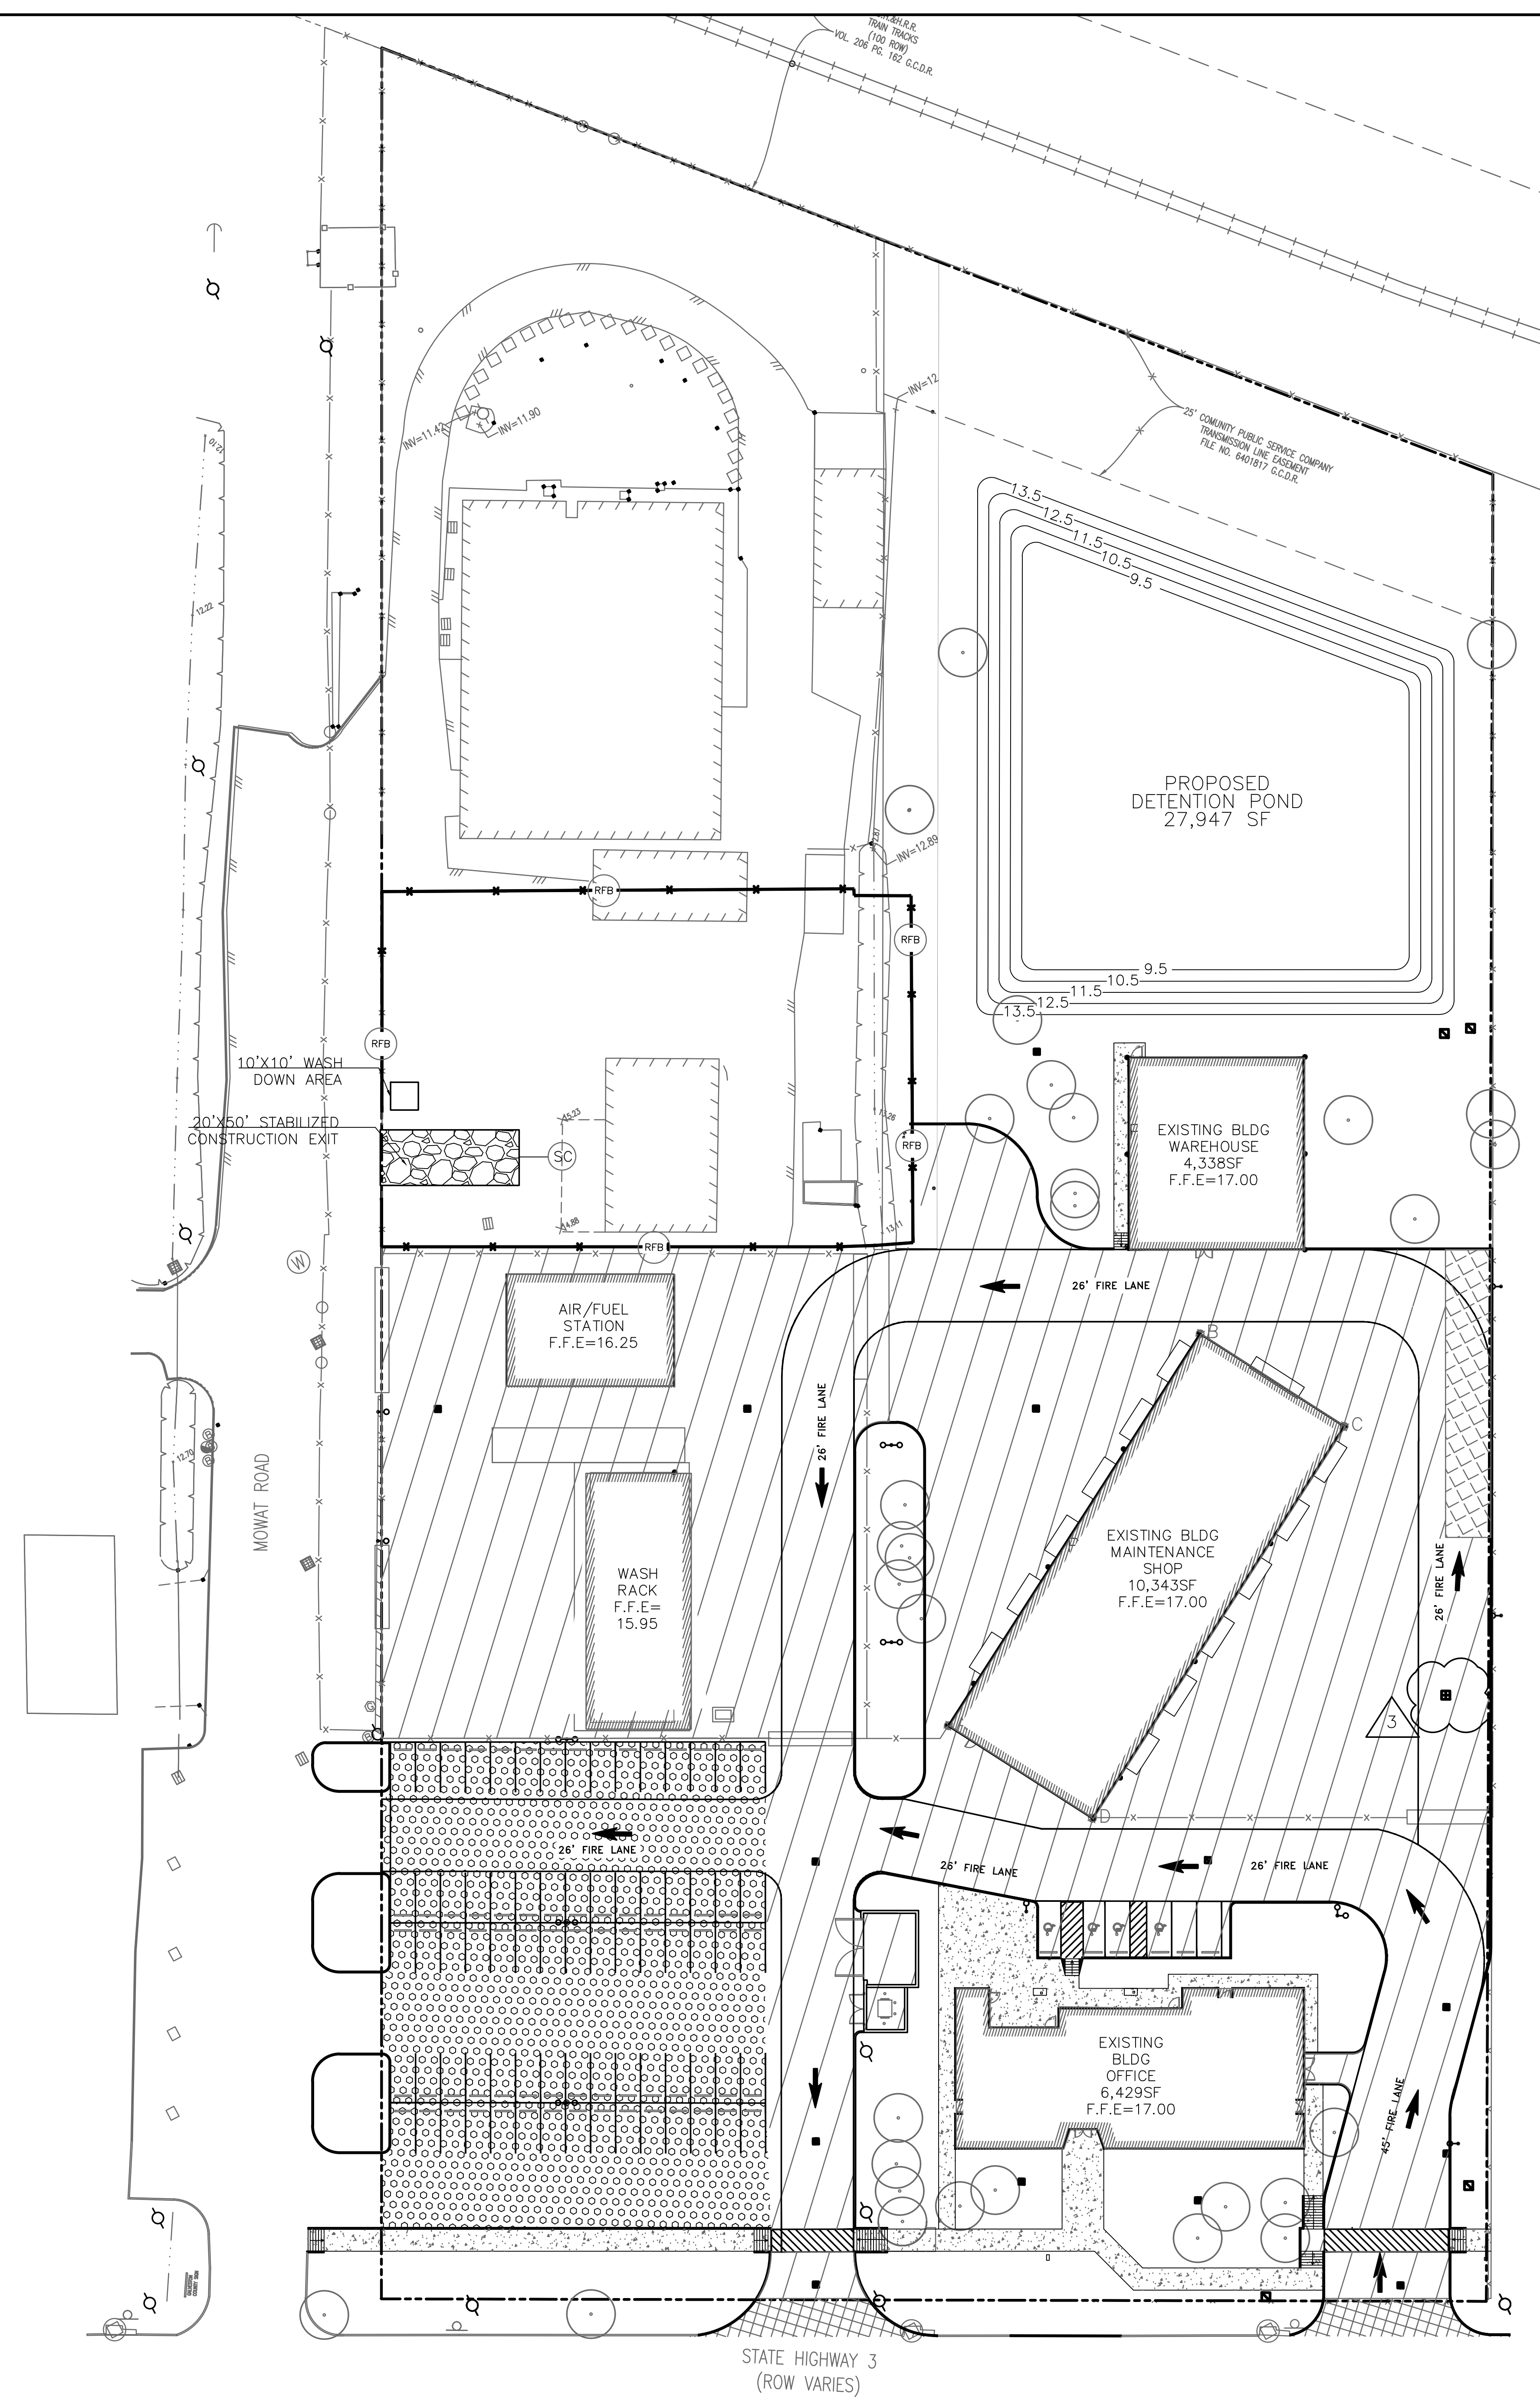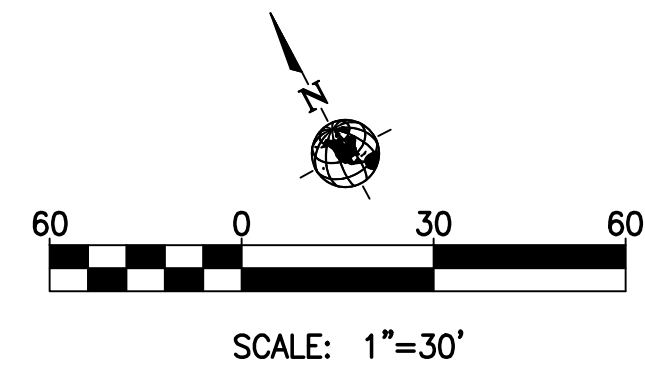

SWPPP LEGEND

- REINFORCED FILTER FABRIC BARRIER AT LEAST 2' BEHIND BACK OF CURB/PAVEMENT
- STABILIZED CONSTRUCTION EXIT.
- INLET PROTECTION BARRIER (IPB).
- WASH DOWN AREA.

SWPPP CONSTRUCTION NOTES


1. CONTRACTOR SHALL IMPLEMENT INLET PROTECTION DEVICES AND REINFORCED FILTER FABRIC BARRIER ALONG ROAD AND SIDE DITCHES AT LOCATION SHOWN ON THE TYPICAL STORM WATER POLLUTION PREVENTION (SWPPP) PLANS TO KEEP SILT AND /OR EXCAVATED MATERIALS FROM ENTERING INTO THE STORM WATER INLETS AND DITCHES EVENTUALLY POLLUTING THE RECEIVING STORM.
2. DURING THE EXCAVATION PHASE OF THE PROJECT, CONTRACTOR SHALL SCHEDULE THE WORK IN SHORT SEGMENTS SO THAT EXCAVATED MATERIAL CAN BE QUICKLY HAULED AWAY FROM THE SITE AND TO PREVENT IT FROM STAYING UNCOLLECTED ON THE EXISTING PAVEMENT. ANY LOOSE EXCAVATED MATERIAL WHICH FALLS ON PAVEMENTS OR DRIVEWAYS SHALL BE SWEEPED BACK INTO THE EXCAVATED AREA.
3. CONTRACTOR SHALL CLEAN UP THE EXISTING STREET INTERSECTIONS AND DRIVEWAYS DAILY, AS NECESSARY, TO REMOVE ANY EXCESS MUD, SILT OR ROCK TRACKED FROM THE EXCAVATED AREA.
4. CONTRACTOR SHALL FOLLOW GOOD HOUSEKEEPING PRACTICES DURING THE CONSTRUCTION OF THE PROJECT ALWAYS CLEANING UP DIRT AND LOOSE MATERIAL AS CONSTRUCTION PROGRESSES.
5. CONTRACTOR TO INSPECT AND MAINTAIN THE AREAS LISTED BELOW AT LEAST ONCE EVERY FOURTEEN (14) CALENDAR DAYS AND WITHIN 24 HOURS OF THE END OF A STORM EVENT OF 0.5 INCHES OR GREATER.
 - DISTURBED AREAS OF THE CONSTRUCTION SITE THAT HAVE NOT BEEN FINALLY STABILIZED.
 - AREAS USED FOR STORAGE OF MATERIALS THAT ARE EXPOSED TO PRECIPITATION.
 - STRUCTURAL CONTROL MEASURES.
 - LOCATIONS WHERE VEHICLES ENTER OR EXIT THE SITE.
6. CONTRACTOR TO BE RESPONSIBLE TO MAINTAIN EXISTING DITCHES AND/OR CULVERTS FOR UNOBSTRUCTED DRAINAGE AT ALL TIMES. WHERE SODDING IS DISTURBED BY EXCAVATION OR BACKFILLING OPERATIONS, SUCH AREAS SHALL BE REPLACED BY SEEDING OR SODDING. SLOPES 4:1 OR STEPPER SHALL BE REPLACED BY CLOCK SODDING.

CONCRETE TRUCK/EQUIPMENT WASH OUT

1. CONTRACTOR(S) SHALL NOT WASH OUT CONCRETE TRUCKS OR EQUIPMENT INTO STREET DEAD ENDS, RIGHT-OF-WAYS, GUTTERS, STORM SEWER INLETS, WATERWAYS, CREEKS OR ANY LOCATION WHERE THE MATERIALS COULD REACH THE STORM SEWER (MS4) SYSTEM. ROCKED CUL-DE-SACS ARE NOT APPROVED WASH OUT AREAS. ALL DEPOSITED MATERIALS SHALL BE REMOVED AND PROPERLY DISPOSED OF AT THE COMPLETION OF WORK.
2. WASH OUT CONCRETE TRUCKS AND/OR EQUIPMENT ONLY IN A DESIGNATED, CONFINED WASHOUT AREA WHERE THE WATER WILL FLOW INTO A TEMPORARY PIT IN A DIRT AREA OR ONTO STOCKPILES OF AGGREGATE BASE OR SAND. THIS AREA MUST BE AN IDENTIFIED LOCATION.
3. COLLECT AND RETURN SWEEPINGS FROM EXPOSED AGGREGATE CONCRETE TO A STOCKPILE OR DISPOSE OF THE WASTE IN A TRASH CONTAINER.

**ONE- CALL NOTIFICATION SYSTEM
CALL BEFORE YOU DIG!!!**
(713) 223-4567 (In Houston, TX)
(New Statewide Number Outside Houston)
1-800-545-6005

KEY PLAN (NOT TO SCALE)

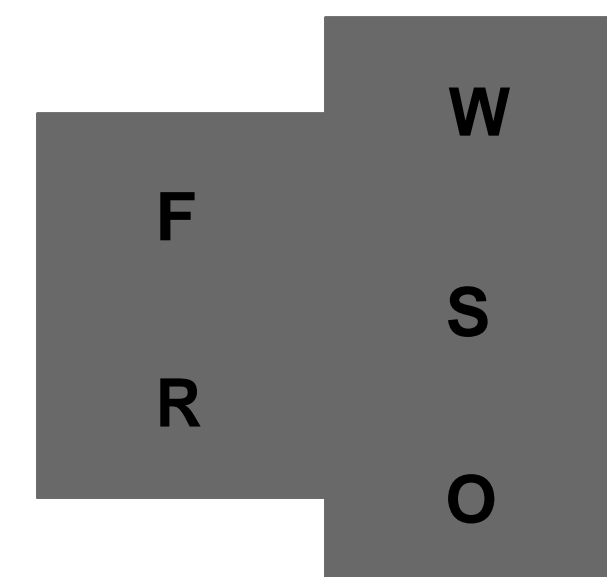

**Galveston County
Road & Bridge Department Facilities PH3**
 5115 Texas Highway 3
 Dickinson, TX


REVISION HISTORY		
ADDENDUM NO. 3		10-07-2020

REVISION DESCRIPTION DATE
PROFESSIONAL SEALS

SWPPP PLAN

DRAWN BY JDM	CHECKED BY JDM
PROJECT NUMBER 418198	PROJECT ABBREVIATION GC-R&B
ORIGINAL ISSUE DATE 07 OCT 2020	ISSUE FOR PERMIT



C9.0-PH3
SHEET NUMBER

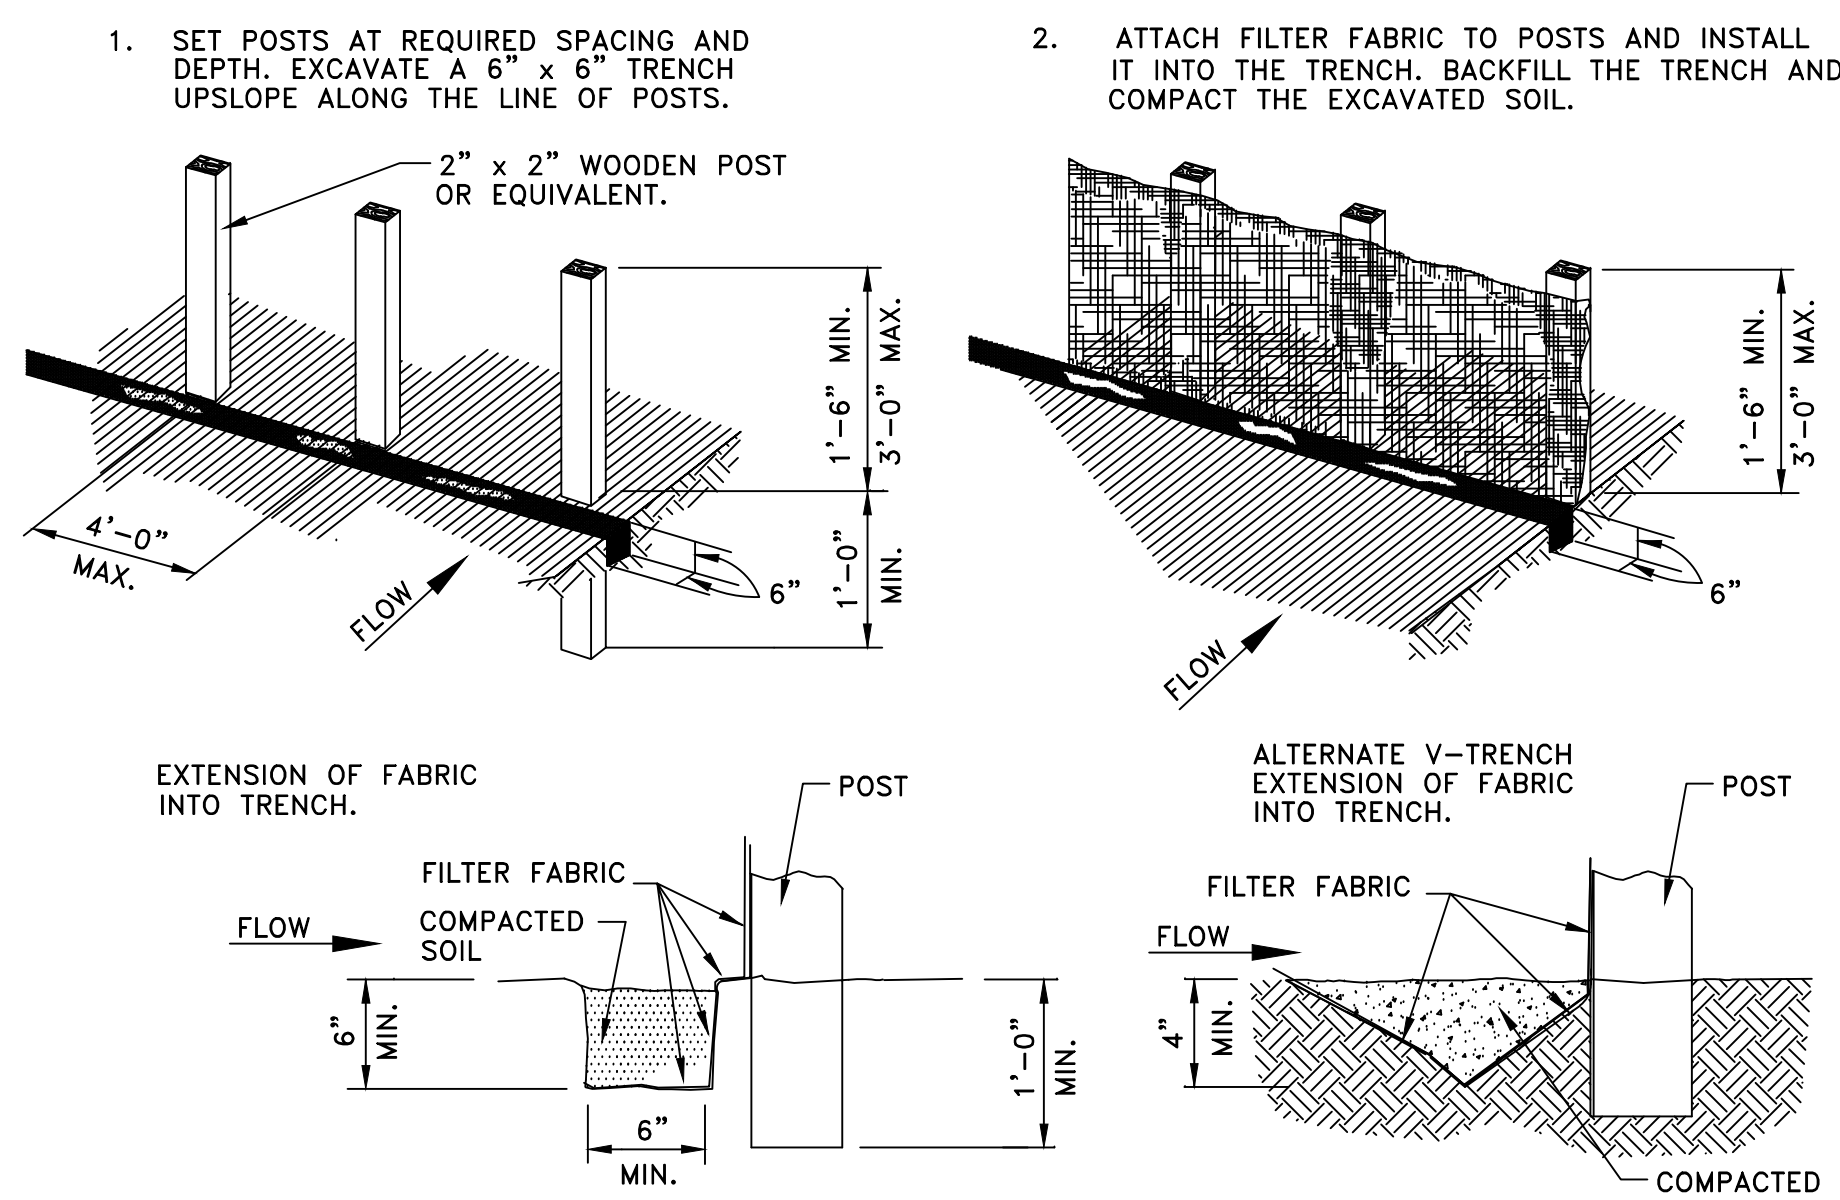

GENERAL NOTES:

1. SET POSTS AT 4- FEET MAXIMUM SPACING. IF FACTORY PREASSEMBLED FENCE WITH SUPPORT NETTING IS USED, SPACING OF POST MAY BE INCREASED TO 8 FEET MAXIMUM.
2. WHEN TWO SECTIONS OF FILTER FABRIC ADJOIN EACH OTHER, OVERLAP 6 INCHES AT THE POST, FOLD TOGETHER, AND ATTACH TO THE POSTS.
3. REMOVE SEDIMENT DEPOSITS WHEN SILT DEPTH REACHES ONE-THIRD OF THE HEIGHT OF THE FENCE.



FILTER FABRIC FENCE

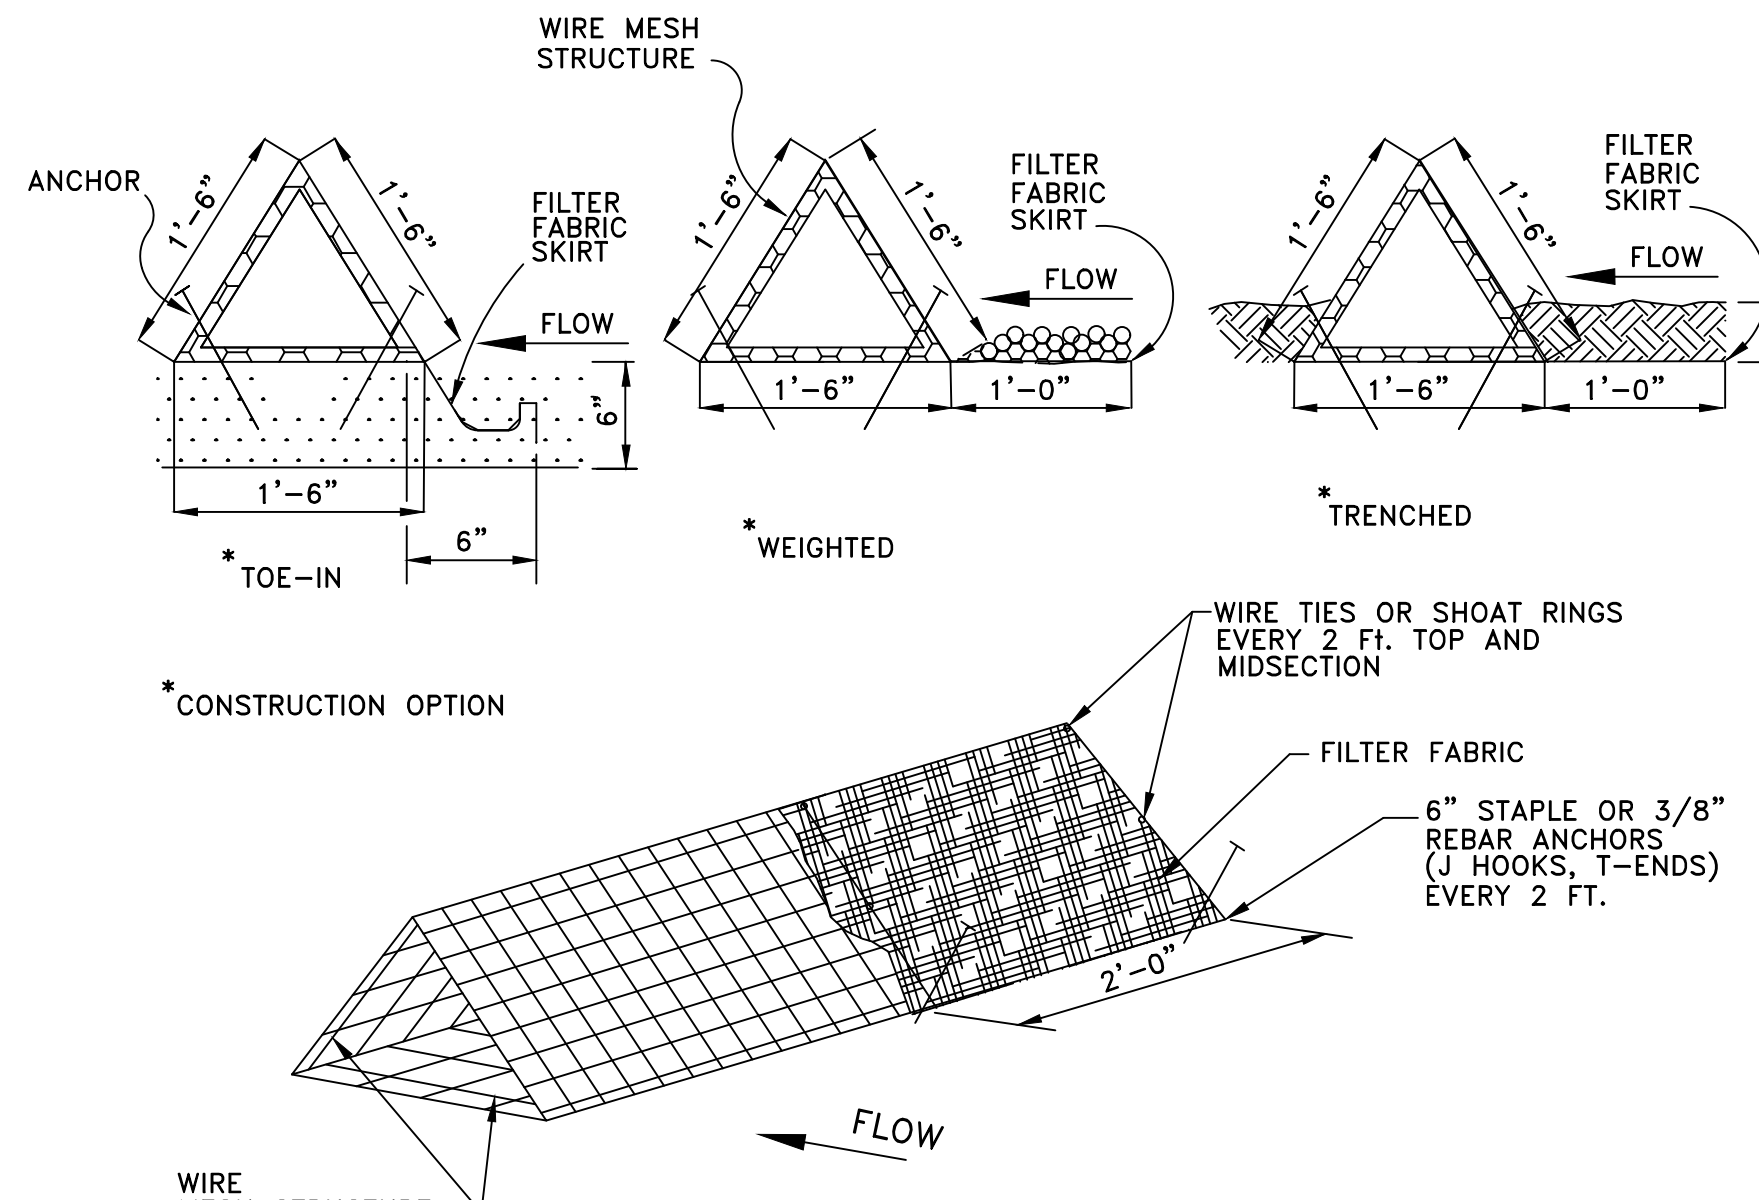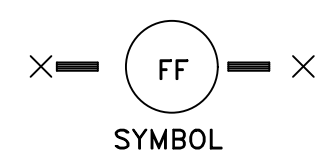

GENERAL NOTES:

1. PLACE BARRIER IN A ROW WITH ENDS TIGHTLY ABUTTING THE ADJACENT BARRIER.
2. USING ONE CONTINUOUS SECTION OF FILTER FABRIC, WRAP FABRIC AROUND WIRE MESH AND EXTEND FABRIC TO FORM SKIRT ON THE UPSTREAM SIDE.
3. WEIGHT SKIRT WITH A CONTINUOUS LAYER OF 3-INCH TO 5-INCH OPEN GRADED ROCK, OR TOE IN SKIRT WITH SIX INCHES WITH MECHANICALLY COMPACTED MATERIAL.
4. SECURELY ANCHOR BARRIER AND SKIRT IN PLACE USING 6-INCH WIRE STAPLES ON 2-FOOT CENTERS ON BOTH EDGES, OR STAKE USING 18-INCH BY 3/8 INCH REBARS (T-ENDS, J-HOOKS).
5. FILTER FABRIC SHALL BE LAPPED OVER ENDS 6 INCHES TO COVER SEGMENT JOINTS. FASTEN JOINTS WITH GALVANIZED SHOAT RINGS OR EQUIVALENT.
6. THE BARRIER STRUCTURE SHALL BE WELDED WIRE MESH, 18 INCHES ON EACH SIDE.



TRIANGULAR FILTER FABRIC FENCE

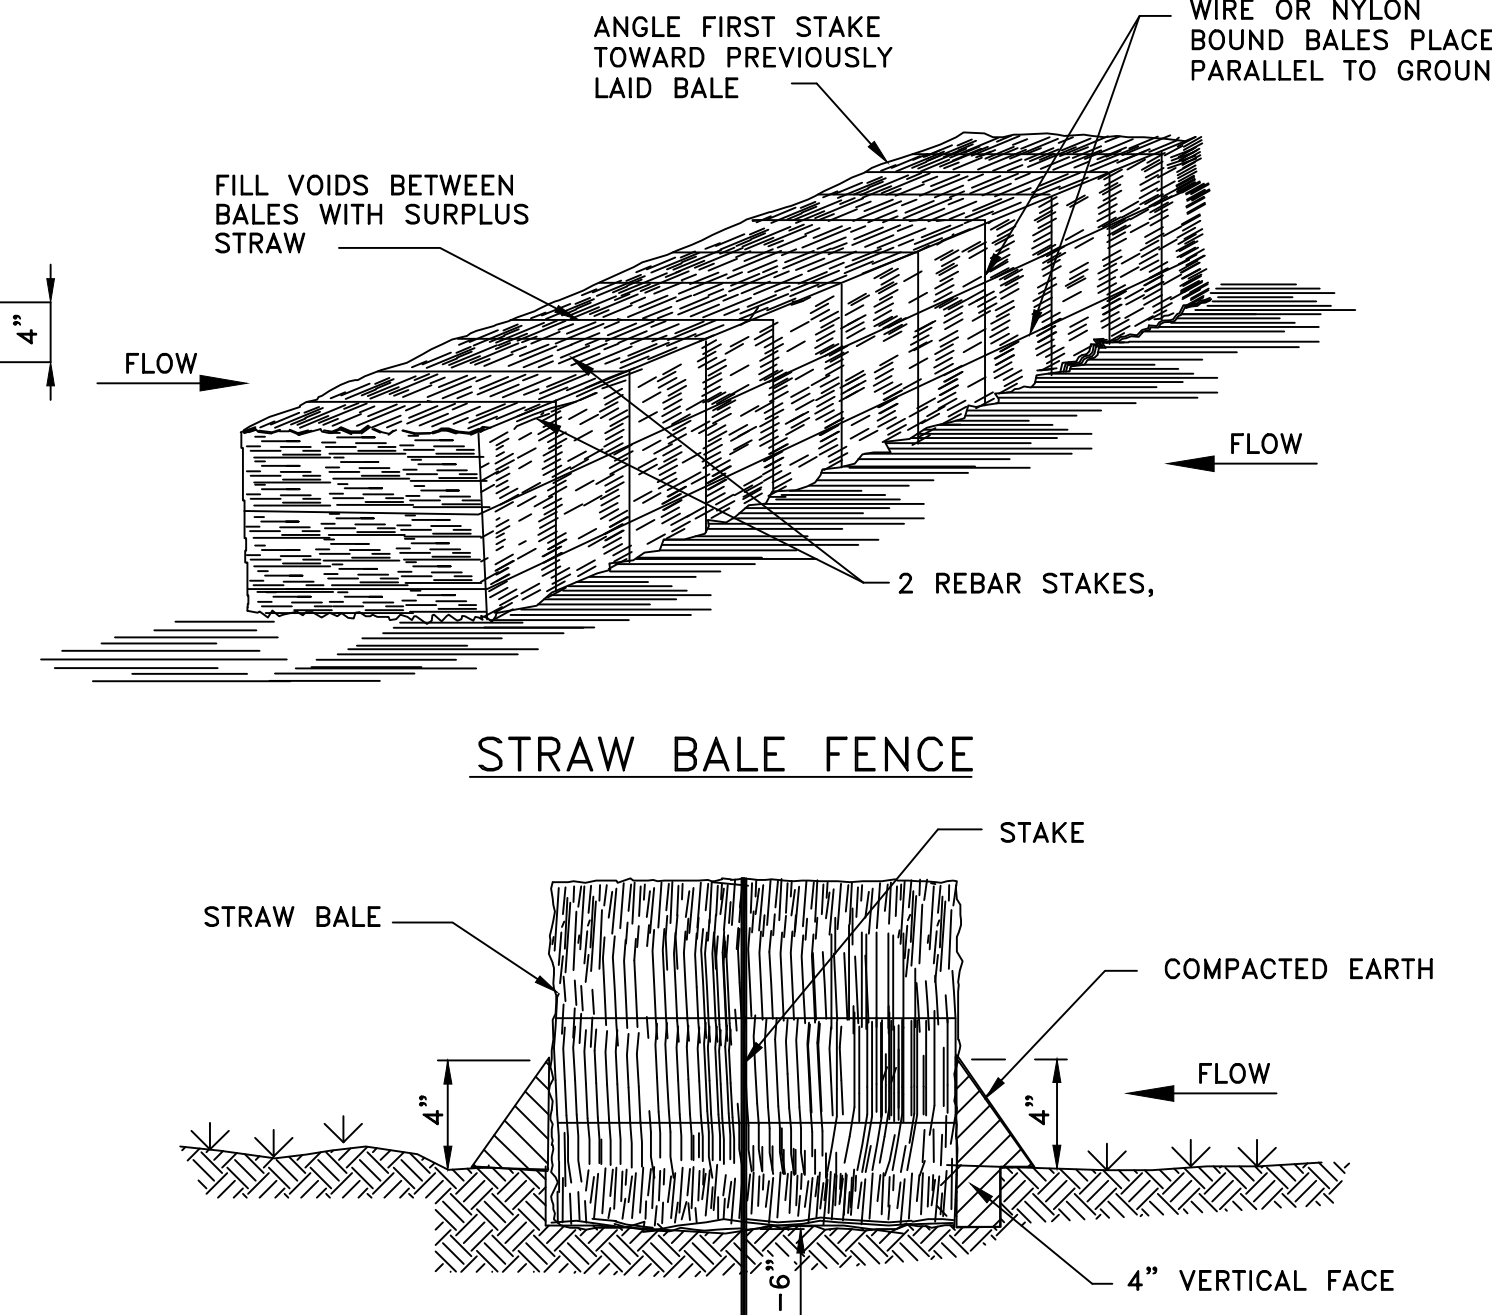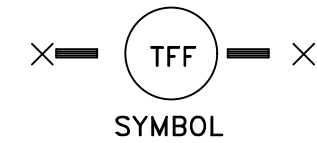

GENERAL NOTES:

1. LIMIT USE TO ONSITE SWALES FOR PURPOSES OF LOW FLOW VELOCITY DISSIPATION FOR EROSION CONTROL. USE STRAW BALE FENCES TO TREAT OVERLAND FLOW ONLY. DO NOT USE STRAW BALE FENCES TO TREAT FLOW IN CHANNELS.
2. PLACE BALES IN A ROW WITH ENDS TIGHTLY ABUTTING ADJACENT BALES. FILL THE VOIDS BETWEEN BALES WITH SURPLUS STRAW. PLACE BALES WITH BINDING PARALLEL TO GROUND SURFACE.
3. IMBED EACH BALE AT LEAST 4 INCHES IN THE SOIL.
4. SECURELY ANCHOR BALES IN PLACE BY REBAR STAKES. DRIVE STAKES THROUGH THE BALES AND AT LEAST 18 INCHES INTO THE GROUND. ANGLE THE STAKE IN EACH BALE TOWARD THE PREVIOUS BALE TO FORCE THE BALES TOGETHER.
5. BIND BALES WITH WIRE OR NYLON ROPE TIED ACROSS THE STRAW BALES.
6. REPLACE WITH NEW STRAW BALE FENCE EVERY TWO MONTHS.
7. WATTLES STAKED INTO THE GROUND ARE A PREFERRED SUBSTITUTE FOR STRAW BALE FENCES.


STRAW BALE FENCE

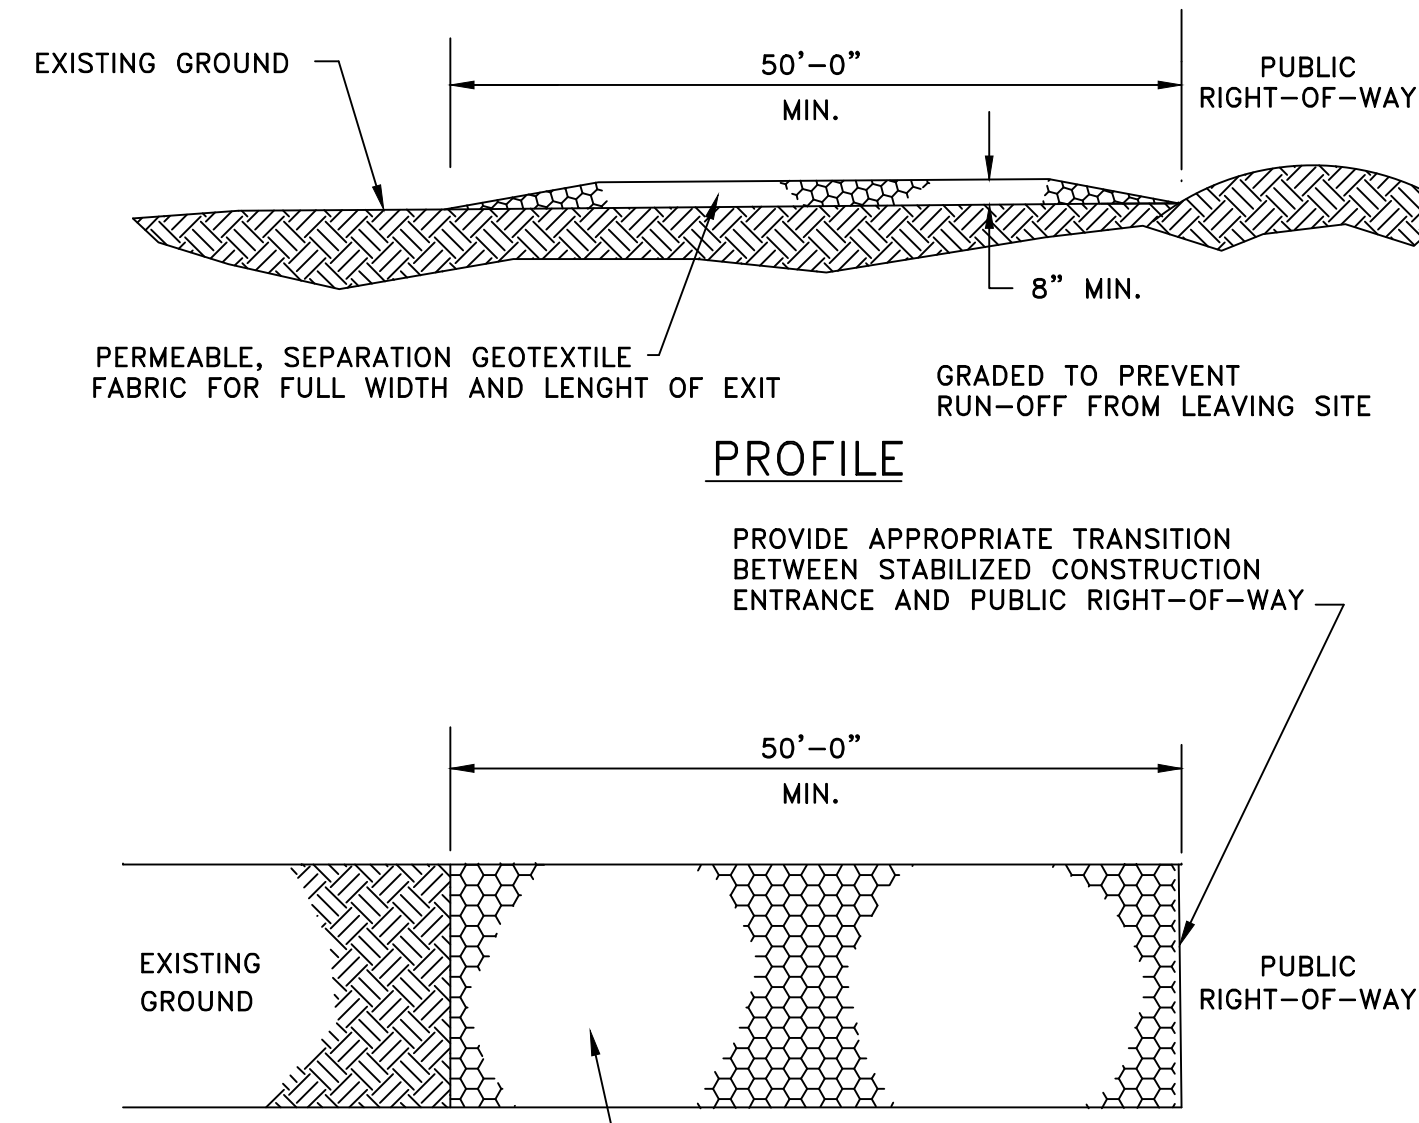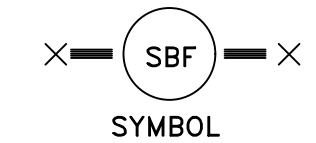



GENERAL NOTES:

1. MINIMUM LENGTH IS AS SHOWN ON CONSTRUCTION DRAWINGS OR 50 FEET, WHICHEVER IS MORE.
2. CONSTRUCT AND MAINTAIN CONSTRUCTION EXIT WITH CONSTANT WIDTH ACROSS ITS LENGTH, INCLUDING ALL POINTS OF INGRESS OR EGRESS.
3. UNLESS SHOWN ON THE CONSTRUCTION DRAWINGS, STABILIZATION FOR OTHER AREAS WILL HAVE THE SAME AGGREGATE THICKNESS AND WIDTH REQUIREMENTS AS THE STABILIZED CONSTRUCTION EXIT.
4. WHEN SHOWN ON THE CONSTRUCTION DRAWINGS, WIDEN OR LENGTHEN STABILIZED AREA TO ACCOMMODATE A TRUCK WASHING AREA. PROVIDE OUTLET SEDIMENT TRAP FOR THE TRUCK WASHING AREA.
5. PROVIDE PERIODIC TOP DRESSING WITH ADDITIONAL COARSE AGGREGATE TO MAINTAIN THE REQUIRED DEPTH OR WHEN SURFACE BECOMES PACKED WITH MUD.
6. PERIODICALLY TURN AGGREGATE TO EXPOSE A CLEAN DRIVING SURFACE.
7. ALTERNATIVE METHODS OF CONSTRUCTION INCLUDE:
-CEMENT STABILIZED SOIL: COMPACTED CEMENT STABILIZED SOIL, LIMESTONE AGGREGATE, OR OTHER FILL MATERIAL IN AN APPLICATION OF THICKNESS OF 8 INCHES.
-WOOD MATS: OAK OR OTHER HARDWOOD TIMBERS PLACED EDGE TO EDGE AND ACROSS SUPPORT WOODEN BEAMS WHICH ARE PLACED ON TOP OF EXISTING SOIL IN AN APPLICATION THICKNESS OF 6 INCHES.
-STEEL MATS: PERFORATED MATS PLACED ACROSS PERPENDICULAR SUPPORT MEMBERS.

STABILIZED CONSTRUCTION ACCESS

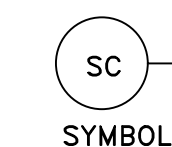



INLET PROTECTION BARRIERS FOR STAGE II INLETS

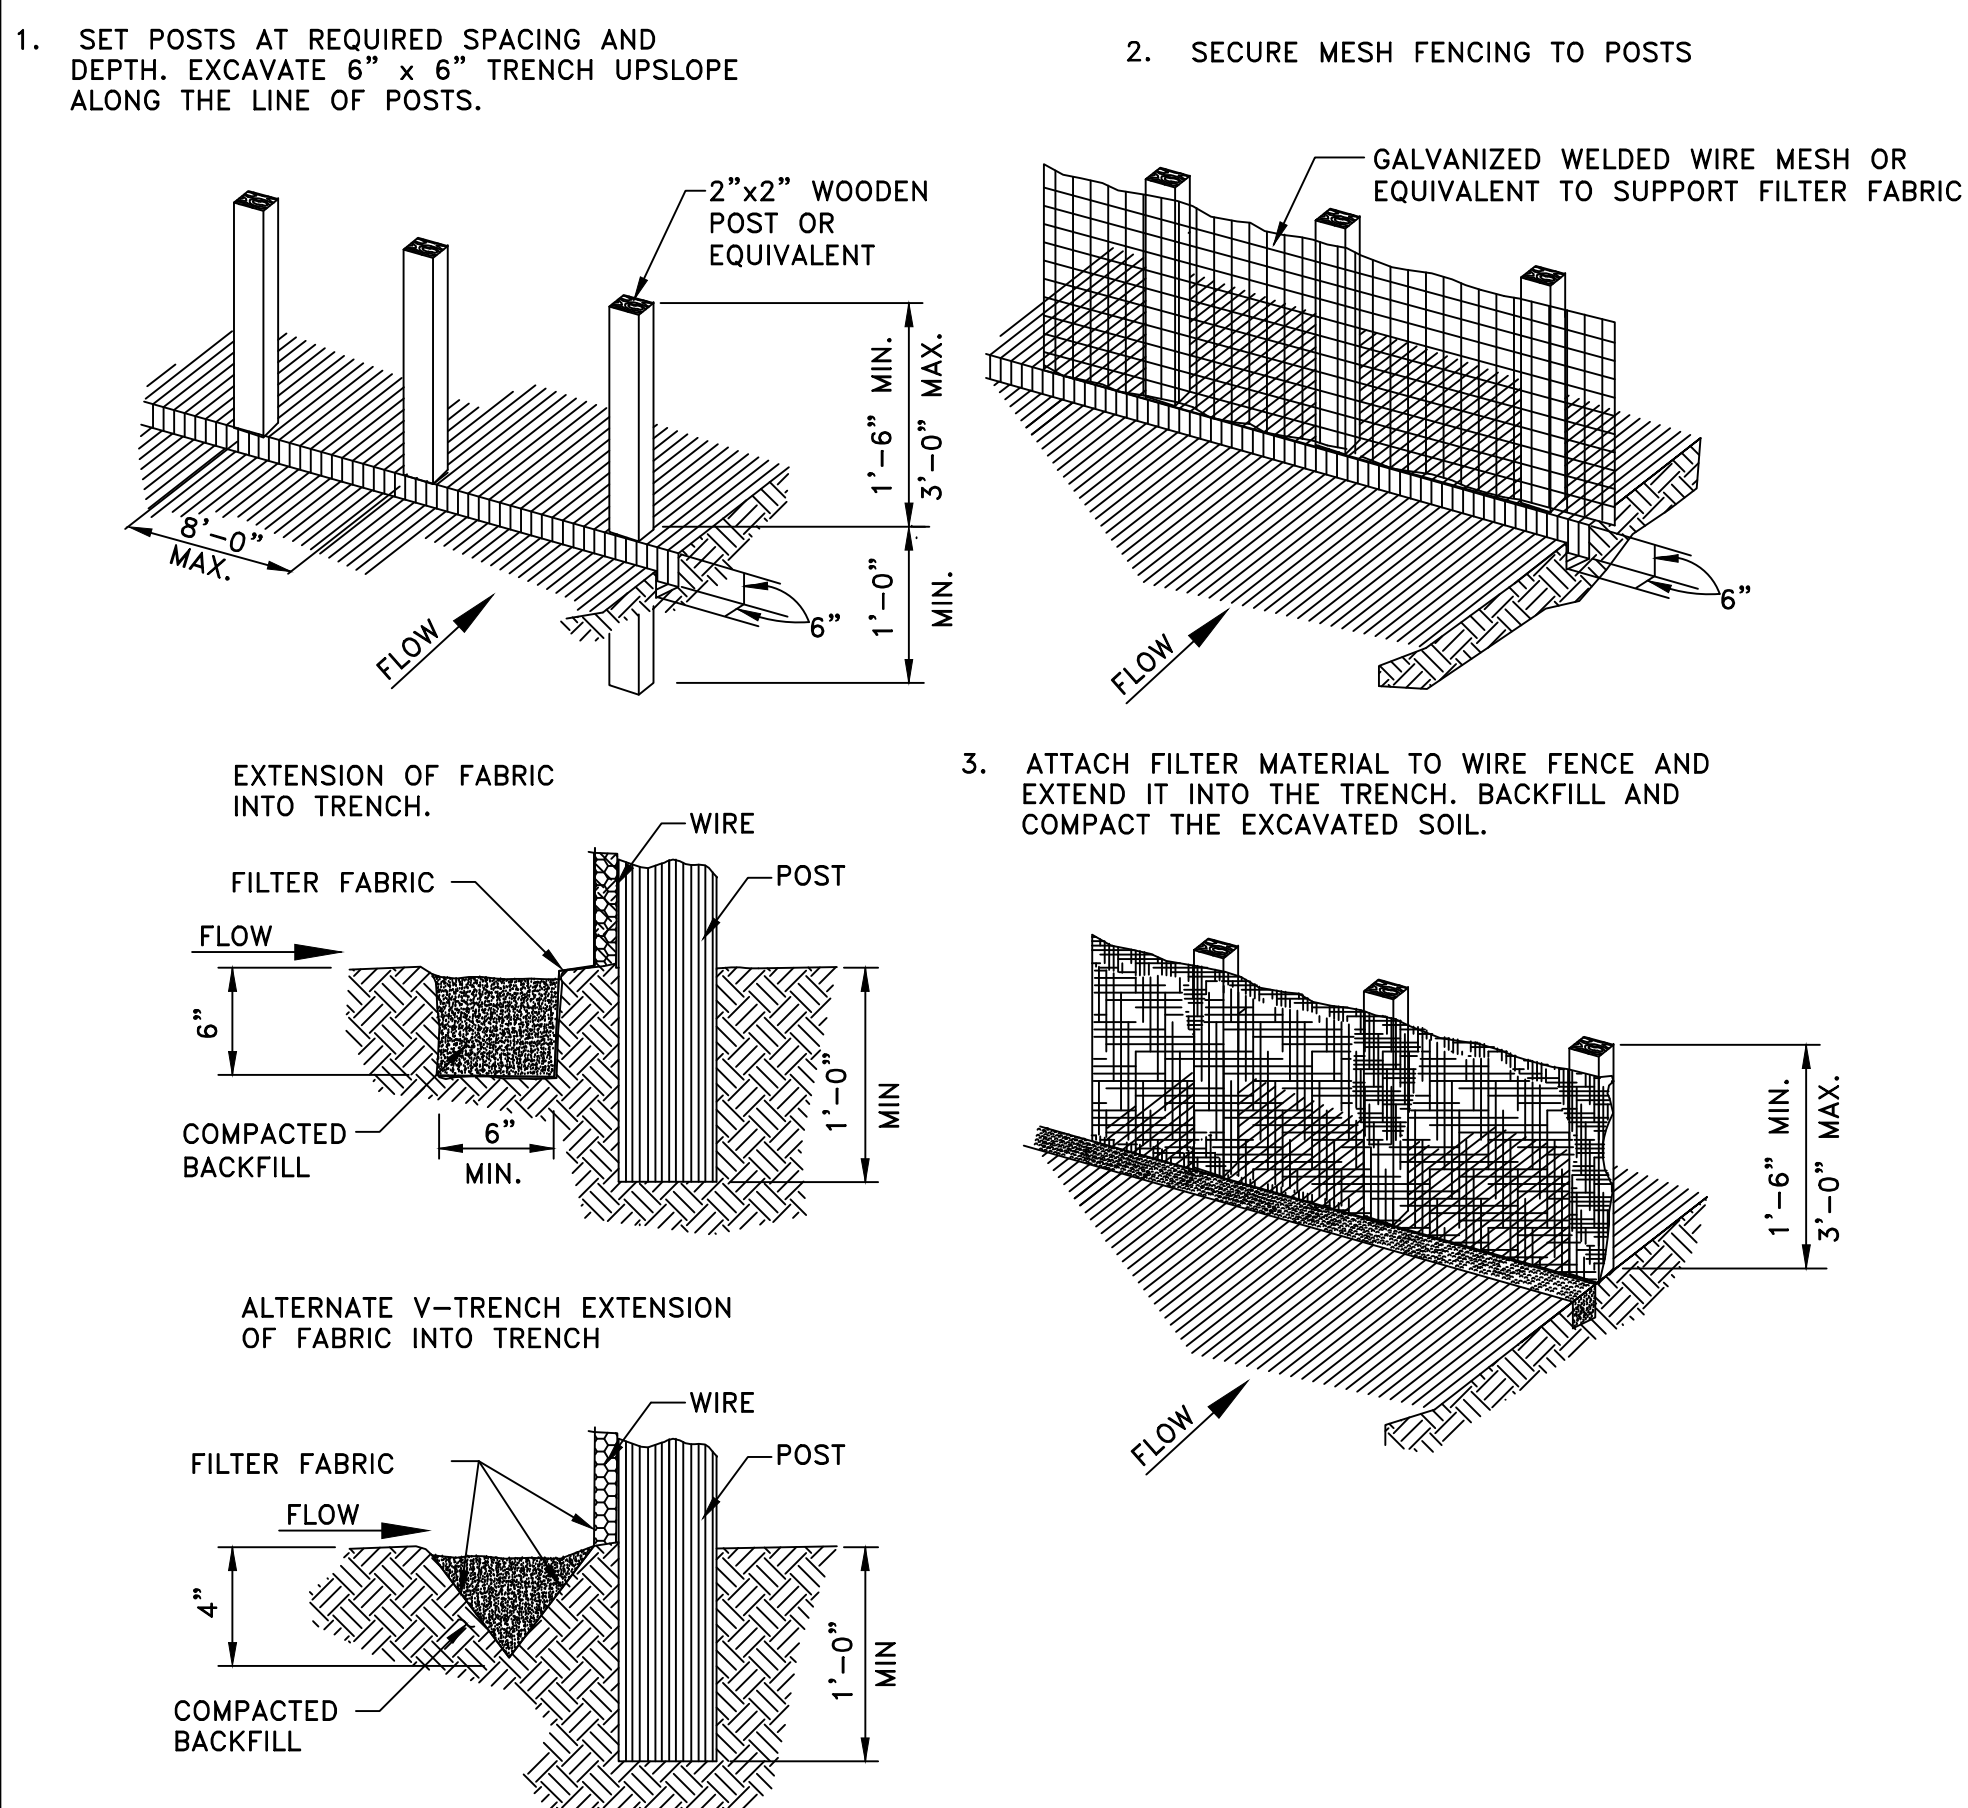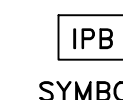

GENERAL NOTES:


1. SECURELY FASTEN MESH FENCING TO POSTS WITH STAPLES OR TIE WIRES.
2. SECURELY FASTEN FILTER FABRIC TO MESH FENCING.
3. WHEN TWO SECTIONS OF FILTER FABRIC ADJOIN EACH OTHER, OVERLAP 6 INCHES AT A POST, FOLD TOGETHER, AND ATTACH TO A POST.
4. REMOVE SEDIMENT DEPOSITS WHEN SILT REACHES ONE-THIRD OF THE HEIGHT OF THE FENCE IN DEPTH.

REINFORCED FILTER FABRIC BARRIER

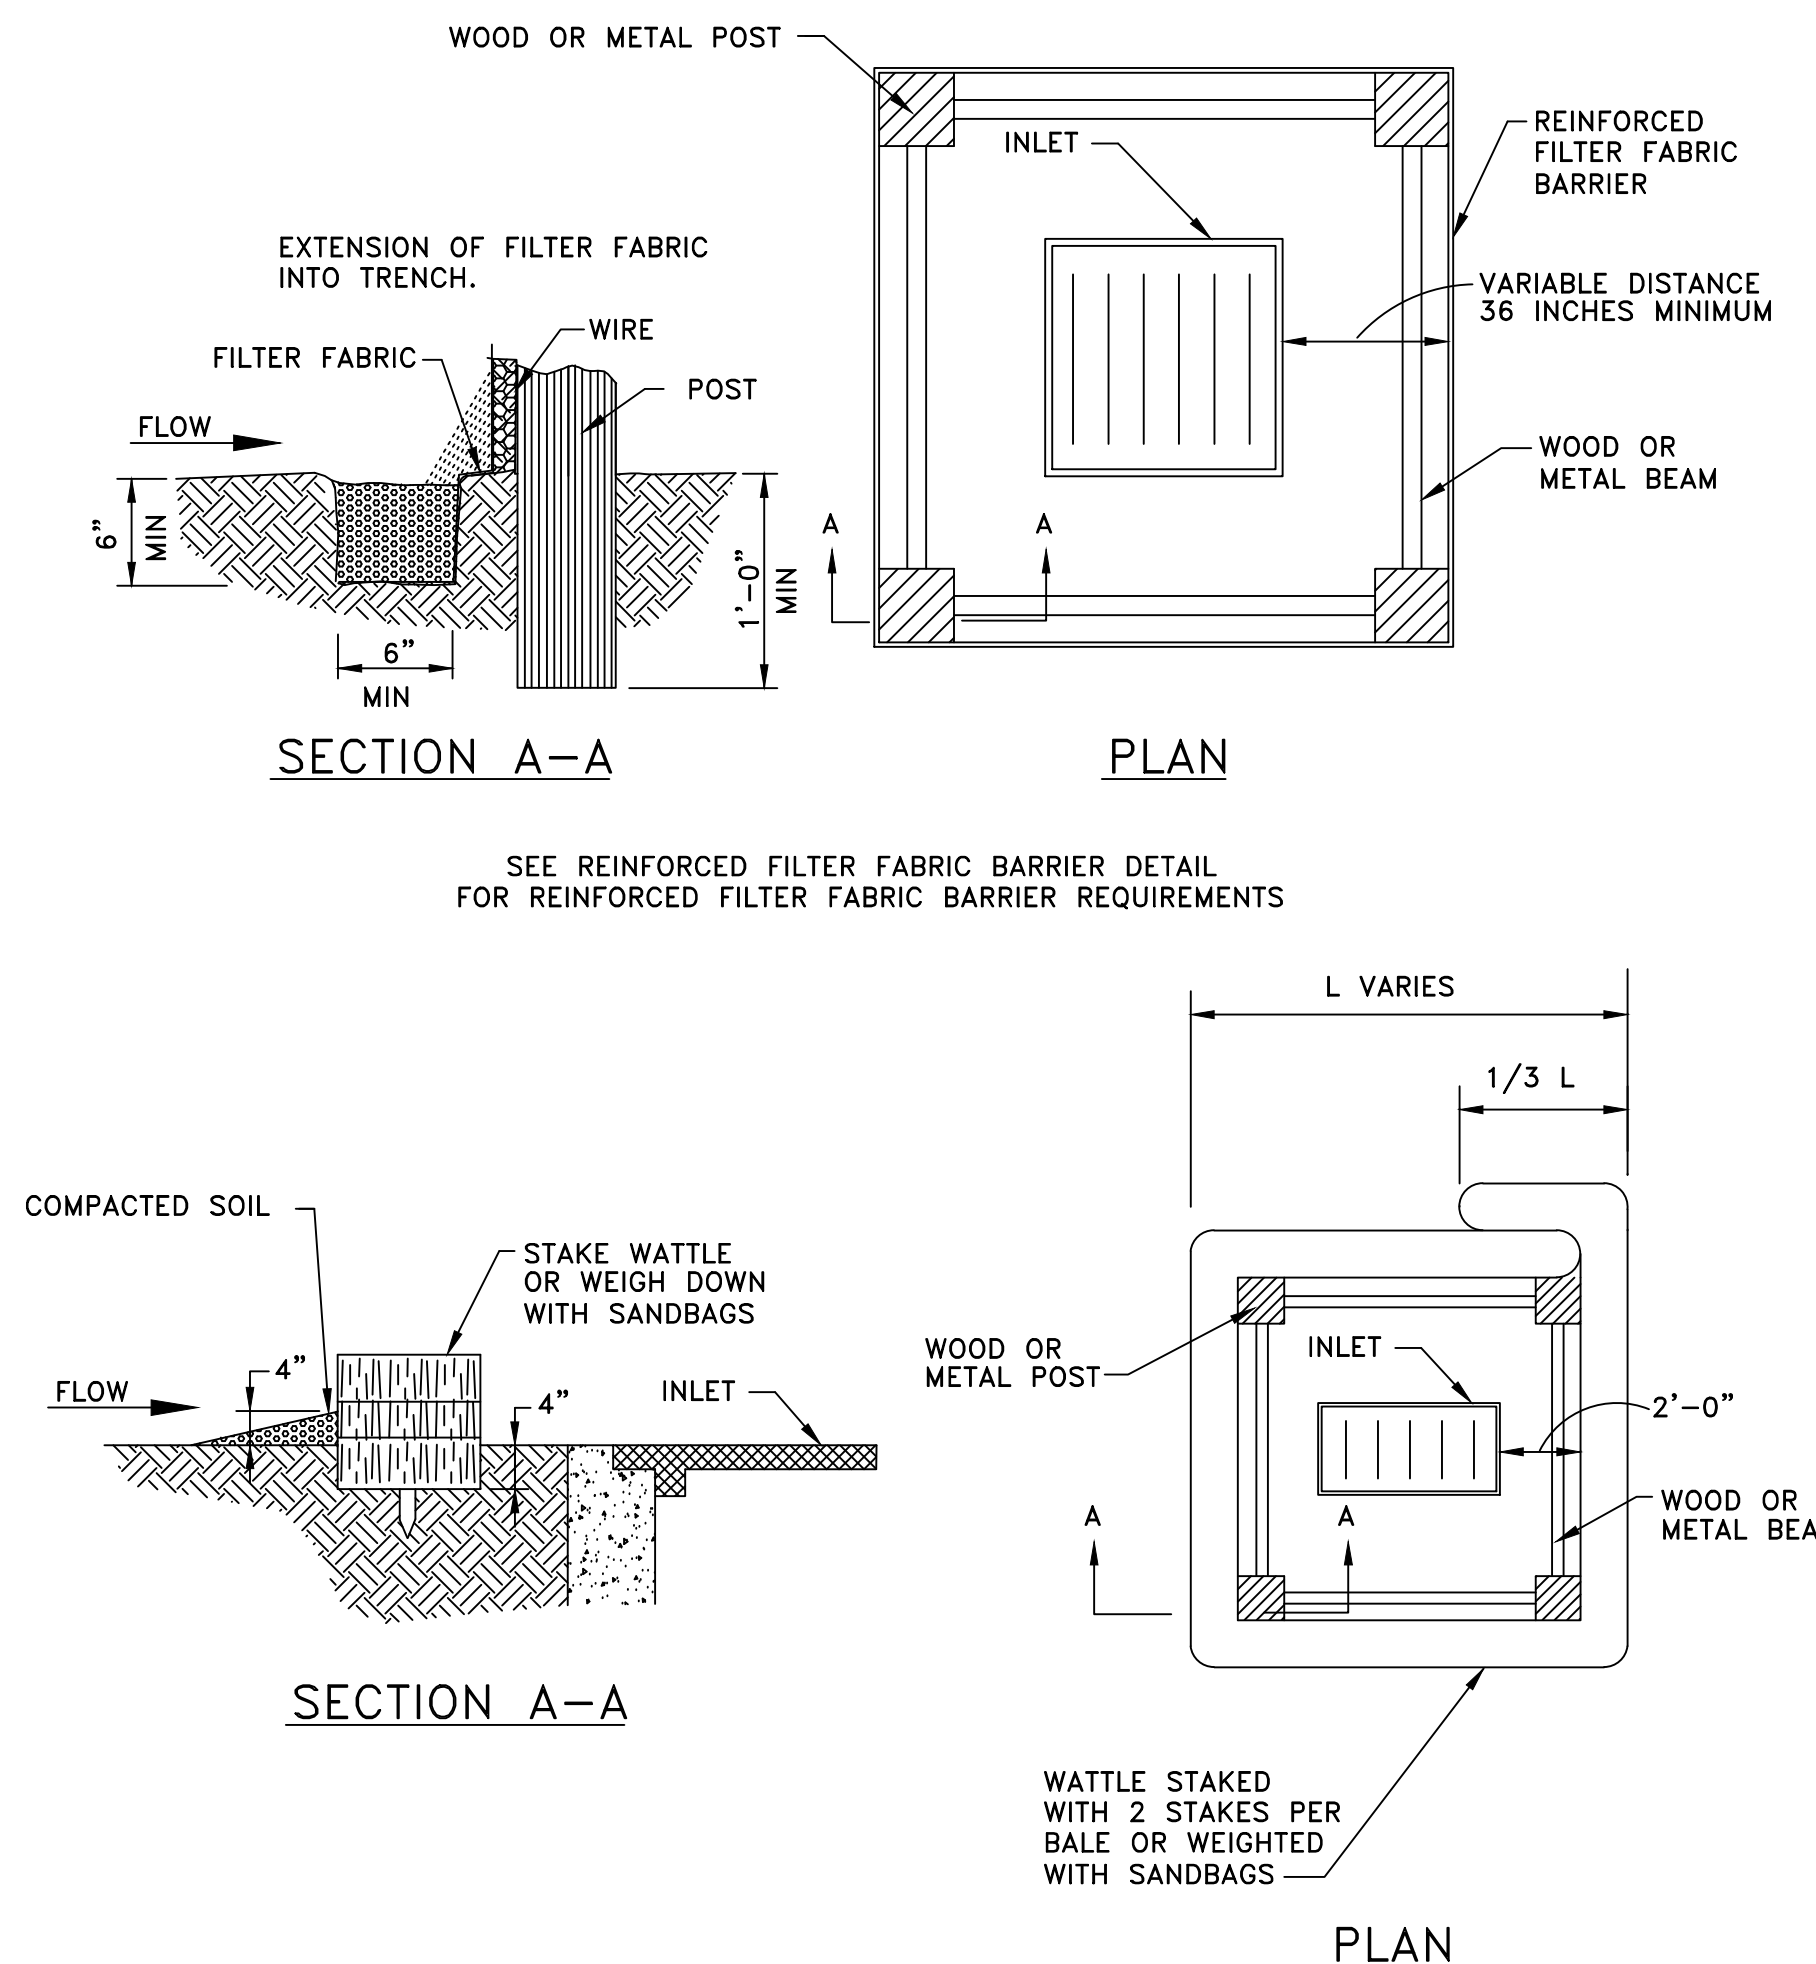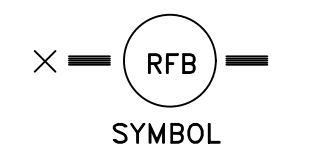


NOTE: TYPICALLY STRAW BALES ARE NOT RECOMMENDED FOR INLET PROTECTION BARRIERS.

INLET PROTECTION BARRIERS FOR STAGE I INLETS

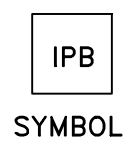


REVISION HISTORY		
NO.	DESCRIPTION	DATE
1	ADDENDUM NO. 3	10-07-2020

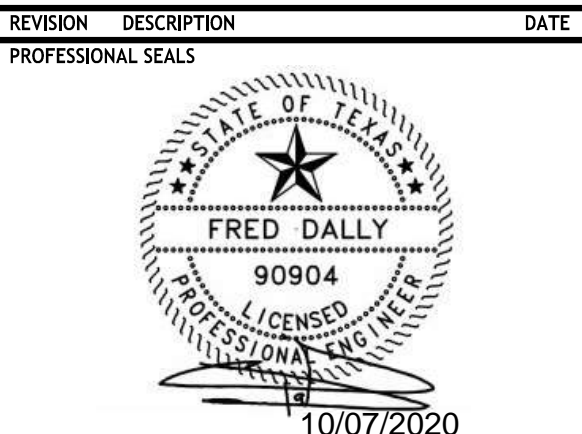

SWPPP DETAILS

DRAWN BY JDM	CHECKED BY JDM
PROJECT NUMBER 418198	PROJECT ABBREVIATION GC-REB
ORIGINAL ISSUE DATE 07 OCT 2020	ISSUE FOR PERMIT

C10.0-PH3
SHEET NUMBER

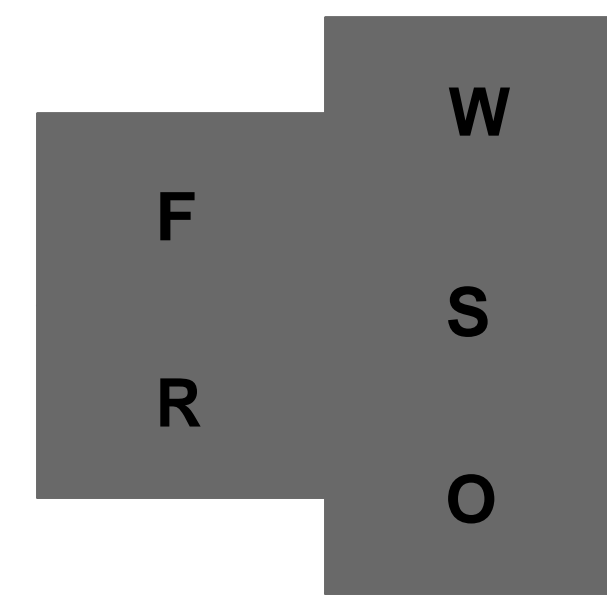

Page Southerland Page, Inc.
 1100 Louisiana, Suite One
 Houston, TX 77002
 pagetink.com
 Tel: 713 871 8484
 Fax: 713 871 8440

ARCHITECTURE / ARCHITECTURE INTERIORS / PLANNING / CONSULTING
 Austin / Dallas / Denver / Dubai / Houston / Mexico City /
 San Francisco / Washington DC / International Affiliate Offices

Civil Engineering
 Daily & Associates
 9800 Richmond Avenue
 Suite 400
 Houston, TX 77042
 713 337 8881

MEP Engineering
 Page
 1100 Louisiana
 Suite One
 Houston, TX 77002
 713 871 8484

Low Voltage & Security
 4b Technology Group, LLC
 390 Glenborough Dr.
 Suite 290
 Houston, TX 77067
 832 249 9379

Landscape Architecture
 Knudson, LP
 8588 Katy Freeway
 Suite 441
 Houston, TX 77024
 713 463 8200

Galveston County Road & Bridge Department Facilities

5115 TX-3
 Dickinson, Texas 77539

KEYED NOTES

NUMBER	DESCRIPTION
1	PEMB STRUCTURE
2	PEMB GUTTER ASSEMBLY
3	PEMB DOWNSPOUT ASSEMBLY WITH DAYLIGHT
4	PEMB STRUT
5	PEMB SHEAR BRACE
6	INSULATED PEMB WALL ASSEMBLY WITH METAL PANEL FINISH
7	SURFACE-MOUNTED LIGHTING FIXTURE. RE: ELECTRICAL
8	WIND-DRIVEN RAIN-RESISTANT LOUVER ASSEMBLY. 50% MIN. FREE AREA. MIAMI-DADE APPROVED. B.O.D. IS RUSKIN ELF6375DXD. RE: MECHANICAL
9	PEMB TRIM
10	SLAB-ON-GRADE. RE: STRUCTURAL
11	OH COILING DOOR. RE: DOOR SCHEDULE
12	8" DIAMETER 42" HIGH PAINTED GALVANIZED STEEL CRASH BOLLARD WITH CONCRETE FILL AND DOME TOP MECHANICAL ASSEMBLY. RE: MECHANICAL
13	INSULATED PEMB ROOFING ASSEMBLY
14	6" CAST-IN-PLACE CONCRETE PAD. FRAMED AT PERIMETER WITH STEEL ISLAND FORMS BY RED-E-FORM
15	GALVANIZED PAINTED HSS TUBE OVERHEAD FAN. RE: MECHANICAL
16	CRANE RAIL BEAM
17	CRANE RAIL BEAM SUPPORT. ANCHORED TO PEMB STRUCTURE ABOVE.
18	CHAIN-HUNG RADIANT HEATER. RE: MECHANICAL
19	COMPRESSED AIR LINE
20	INSULATED GLAZED EXTERIOR STOREFRONT
21	TAS-COMPLIANT STAINLESS STEEL SINK ASSEMBLY
22	10" DIAMETER STAINLESS STEEL GROMMET SOLID SURFACE COUNTERTOP
23	STAINLESS STEEL HAND WASHING SINK. RE: PLUMBING
24	STAINLESS STEEL EYE WASHING STATION. RE: PLUMBING
25	MOP SINK. RE: PLUMBING
26	INSULATED LIGHT-WALL ASSEMBLY
27	PEMB METAL PANEL INTERIOR WALL WAISNCOT TO 8" QUICK-CONNECT COMPRESSED AIR TERMINUS. RE: PLUMBING
28	PROVIDE MANUAL ROLLER SHADE AT WINDOW HEAD
29	PROVIDE TUBE STEEL FRAMING TO SUPPORT FLOATING COUNTERTOP ASSEMBLY. PROVIDE SUPPORTS AT WALLS AT EITHER END
30	PEMB TRIM
31	CORD CHASE AND WHIP
32	2" CORD GROMMET WITH PASS-THRU COVER
33	UNINSULATED PEMB ROOFING ASSEMBLY
34	COMPRESSED FLUID LINES. RE: PLUMBING
35	DAYLIT GUTTER DISCHARGE
36	UTILITY TRENCH
37	HOSE REEL STAND. RE: PLUMBING AND ELECTRICAL
38	VAPOR BARRIER
39	GALVANIZED INCH-NICHOLS TRAFFIC-RATED BAR-STOCK PANEL. 3" LENGTHS
40	GALVANIZED EMBED ANGLE
41	GALVANIZED SUPPORT ANGLE
42	LINE OF PEMB STRUCTURE ADJACENT
43	PROVIDE MEDIUM BROOM FINISH AT EXTERIOR CONCRETE PATIO
44	POWER & DATA J-BOX HOSTED UNDER HOSE REEL COLUMN. RE: ELECTRICAL & TELECOM
45	DUPLEX DATA TERMINAL IN STEEL HOUSING MOUNTED TO HOSE-REEL STAND. RE: TELECOM
46	PREFINISHED SHEETMETAL FLASHING
47	PEMB WEATHER BARRIER
48	PEEL-N-STICK MASTIC
49	PEMB WALL PANEL
50	RETICULATED DOUBLE SEALANT JOINT WITH BACKER-ROD AND WEEP DAPPLERS
51	INTERIOR WALL FINISH. RE: FINISH PLAN
52	CMU WALL. RE: STRUCTURAL
53	1" THICK COMPRESSIBLE FILLER
54	3/4" FIRE-TREATED PLYWOOD
55	TREATED BLOCKING


GENERAL NOTES

- RE: G-110 FOR DOOR, HARDWARE, EQUIPMENT AND FINISH SCHEDULES.
- RE: G-100 FOR CODE AND LIFE-SAFETY ANALYSIS.
- RE: A-101S FOR SITE PLAN.
- RE: MECHANICAL, ELECTRICAL AND PLUMBING DRAWINGS FOR ADDITIONAL DATA.
- EQM3 (MOBILE COLUMN LIFT) NOT SHOWN IN DRAWINGS.
- WALLS TO RECEIVE PT-3 FINISH WITH B-1 BASE U.N.O.
- PROVIDE SCHLUTER STRIP IN ANNOZIED ALUMINUM AT ALL TILE OUTSIDE CORNERS AND ALL OPEN TILE WALL EDGES.
- ALL EXPOSED PEMB RISERS AND EXPOSED STRUCTURAL STEEL TO RECEIVE PT-3 FINISH.
- M-8 WALLS TO RECEIVE PT-3 FINISH U.N.O.
- MAINTENANCE SHOP FLOOR TO RECEIVE SC-3 FINISH.


LEGEND

A	COLUMN GRID DESIGNATIONS
1	KEYED NOTE
A-301	KEYED NOTES ONLY APPLY TO THIS SHEET
1	SECTION TAG
A-201	ELEVATION TAG
ROOM NAME	ROOM NAME
ROOM NUMBER	ROOM NUMBER
S1	DOOR TAG
SC-2	FLOOR OR CEILING FINISH TAG
SS-1	MATERIAL FINISH TAG
PT-2	FLOOR FINISH TAG
X	FLOOR FINISH TRANSITION


KEY PLAN (NOT TO SCALE)

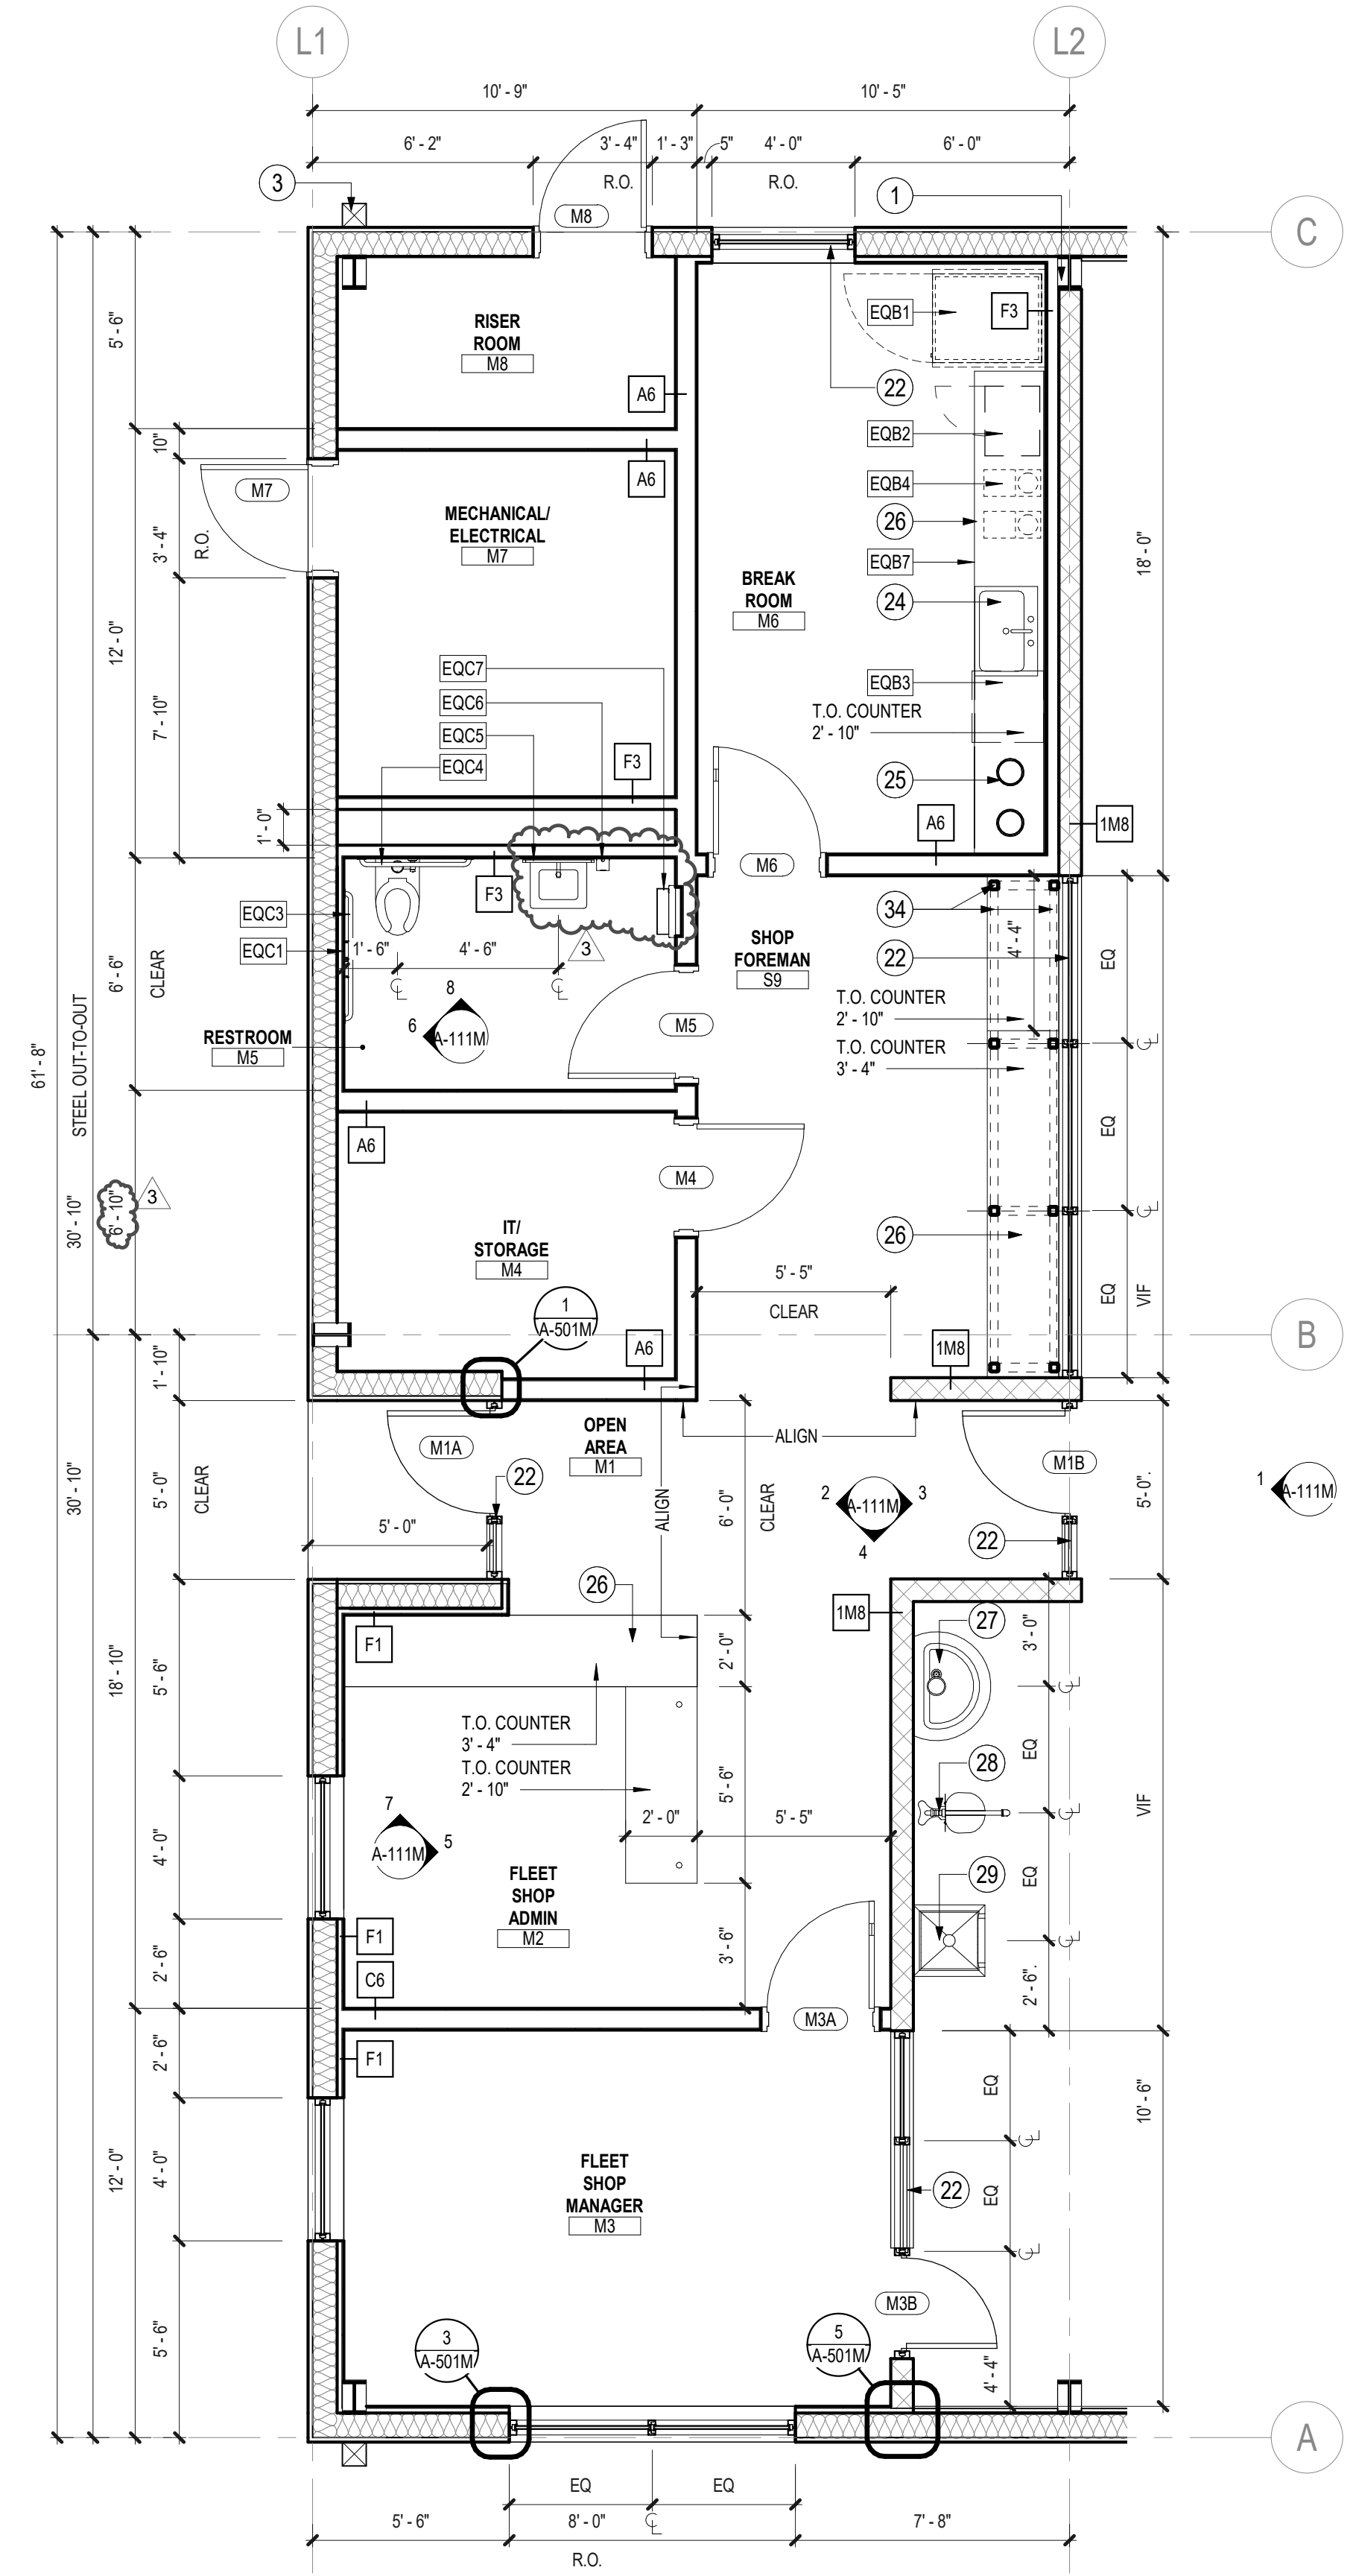

1 CONSTRUCTION PLAN
 SCALE: 1/4" = 1'-0"

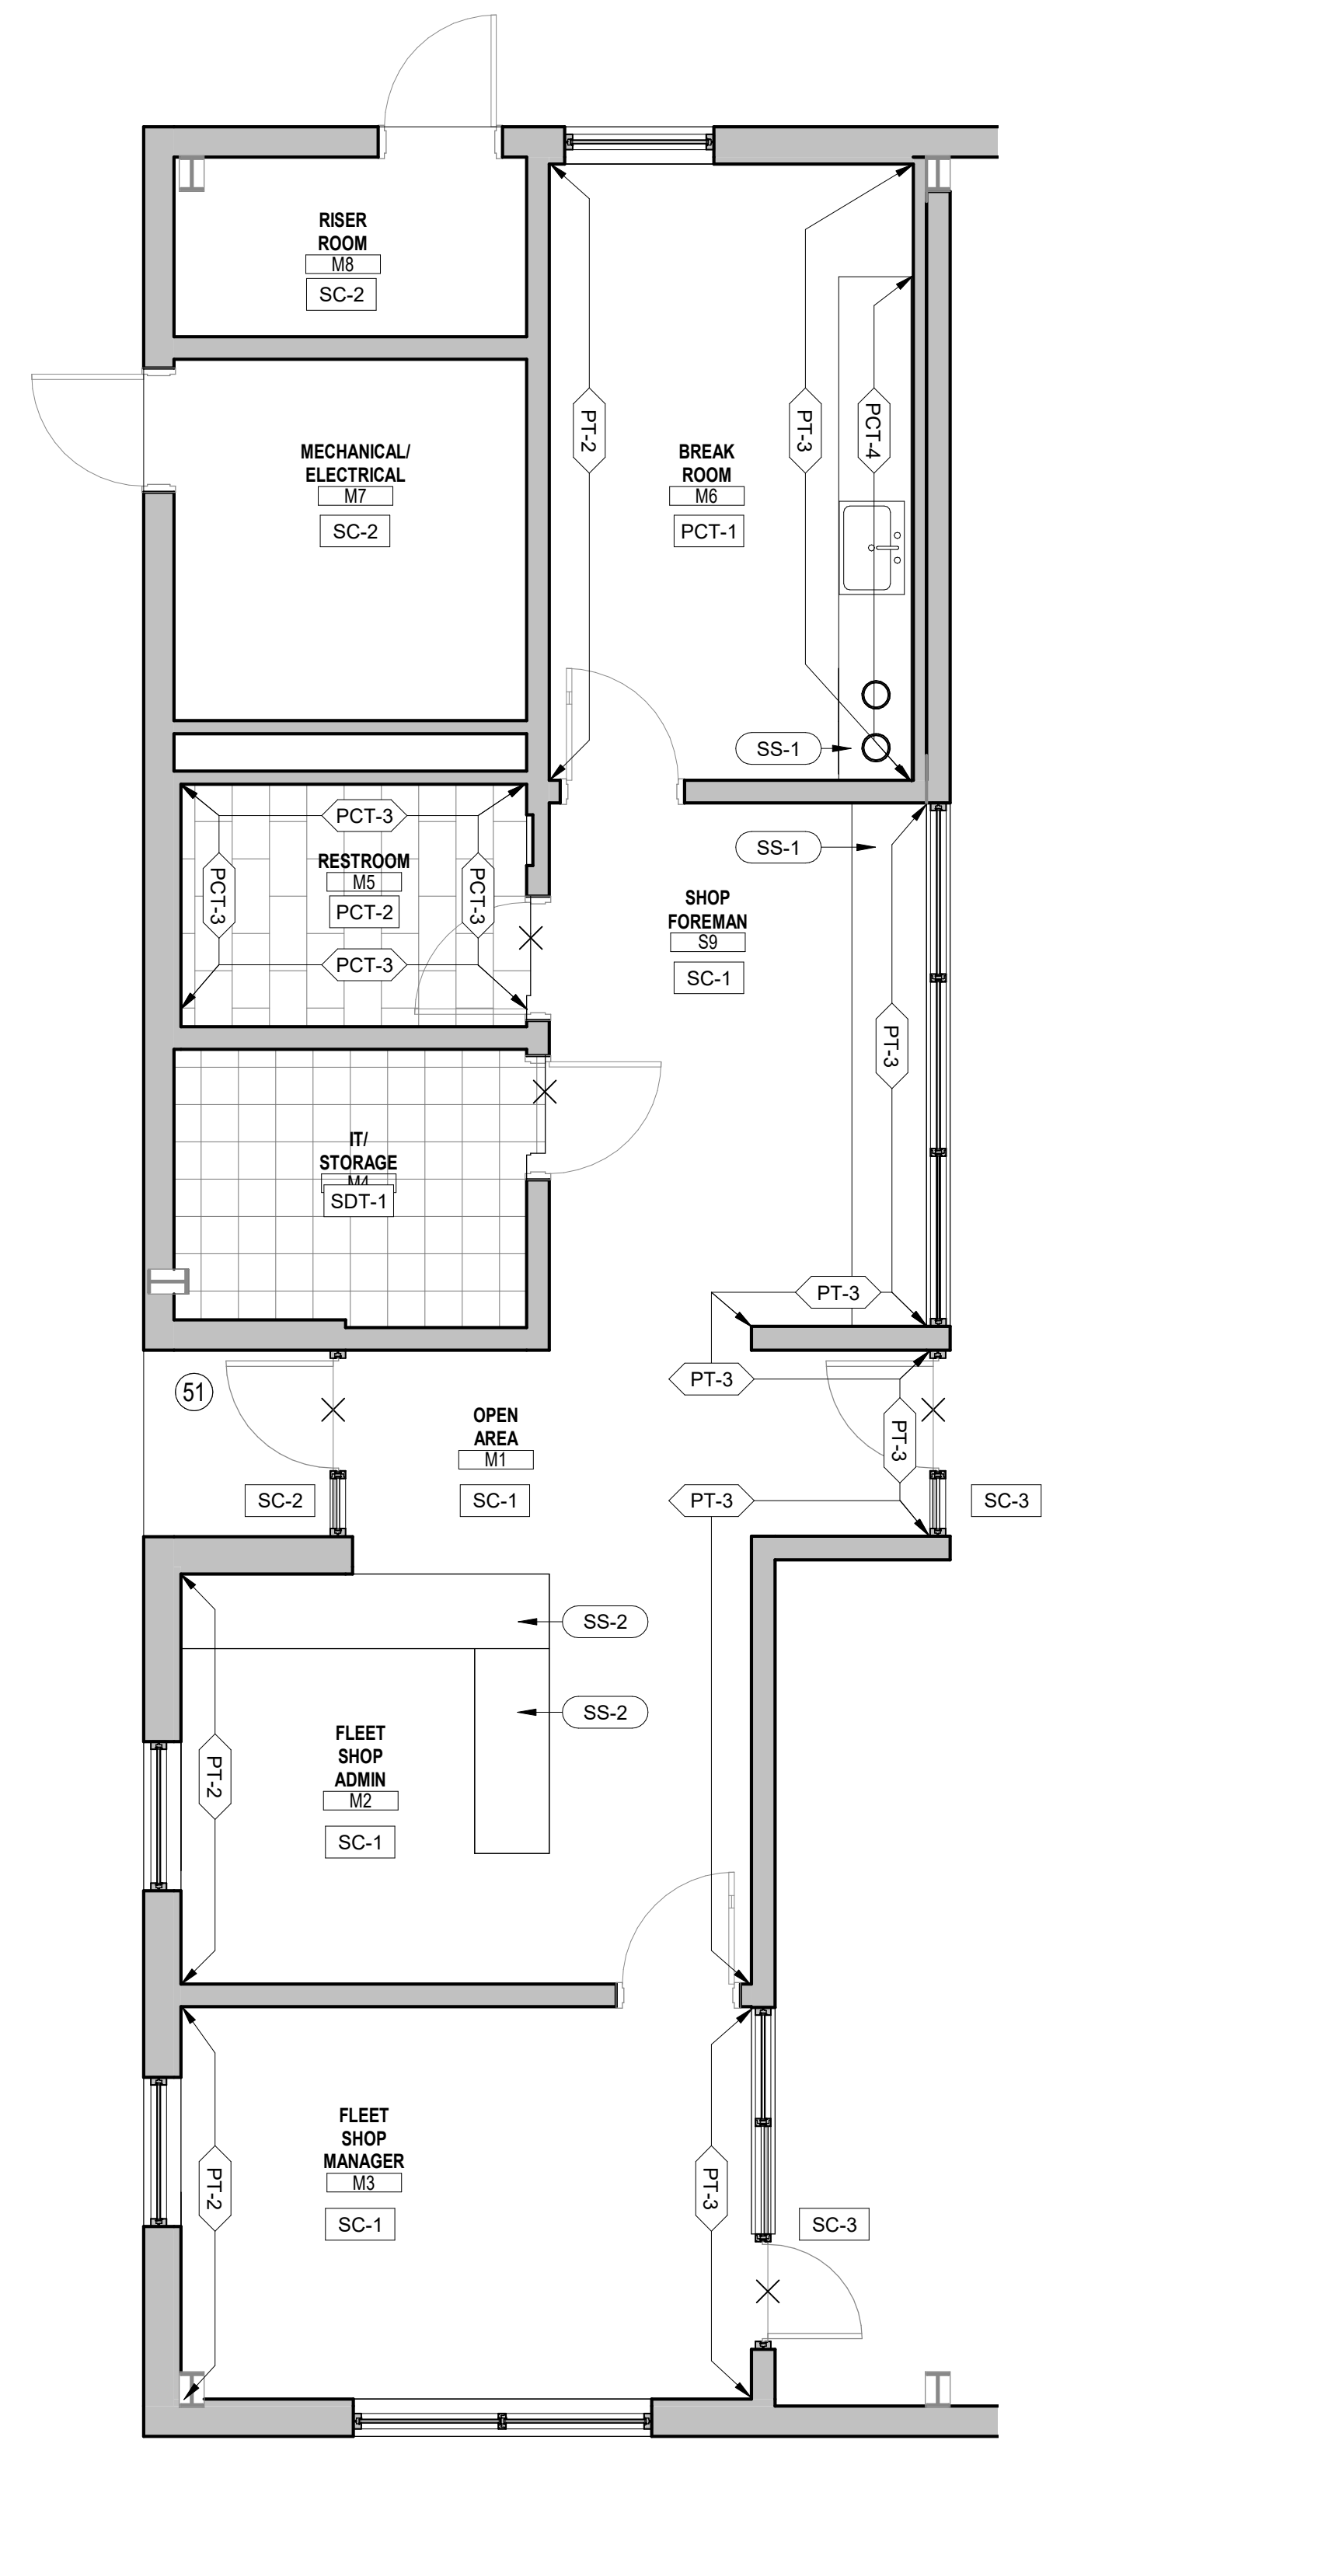

2 FINISH PLAN
 SCALE: 1/4" = 1'-0"
 RE: INTERIOR ELEVATIONS FOR ADDITIONAL FINISH DATA

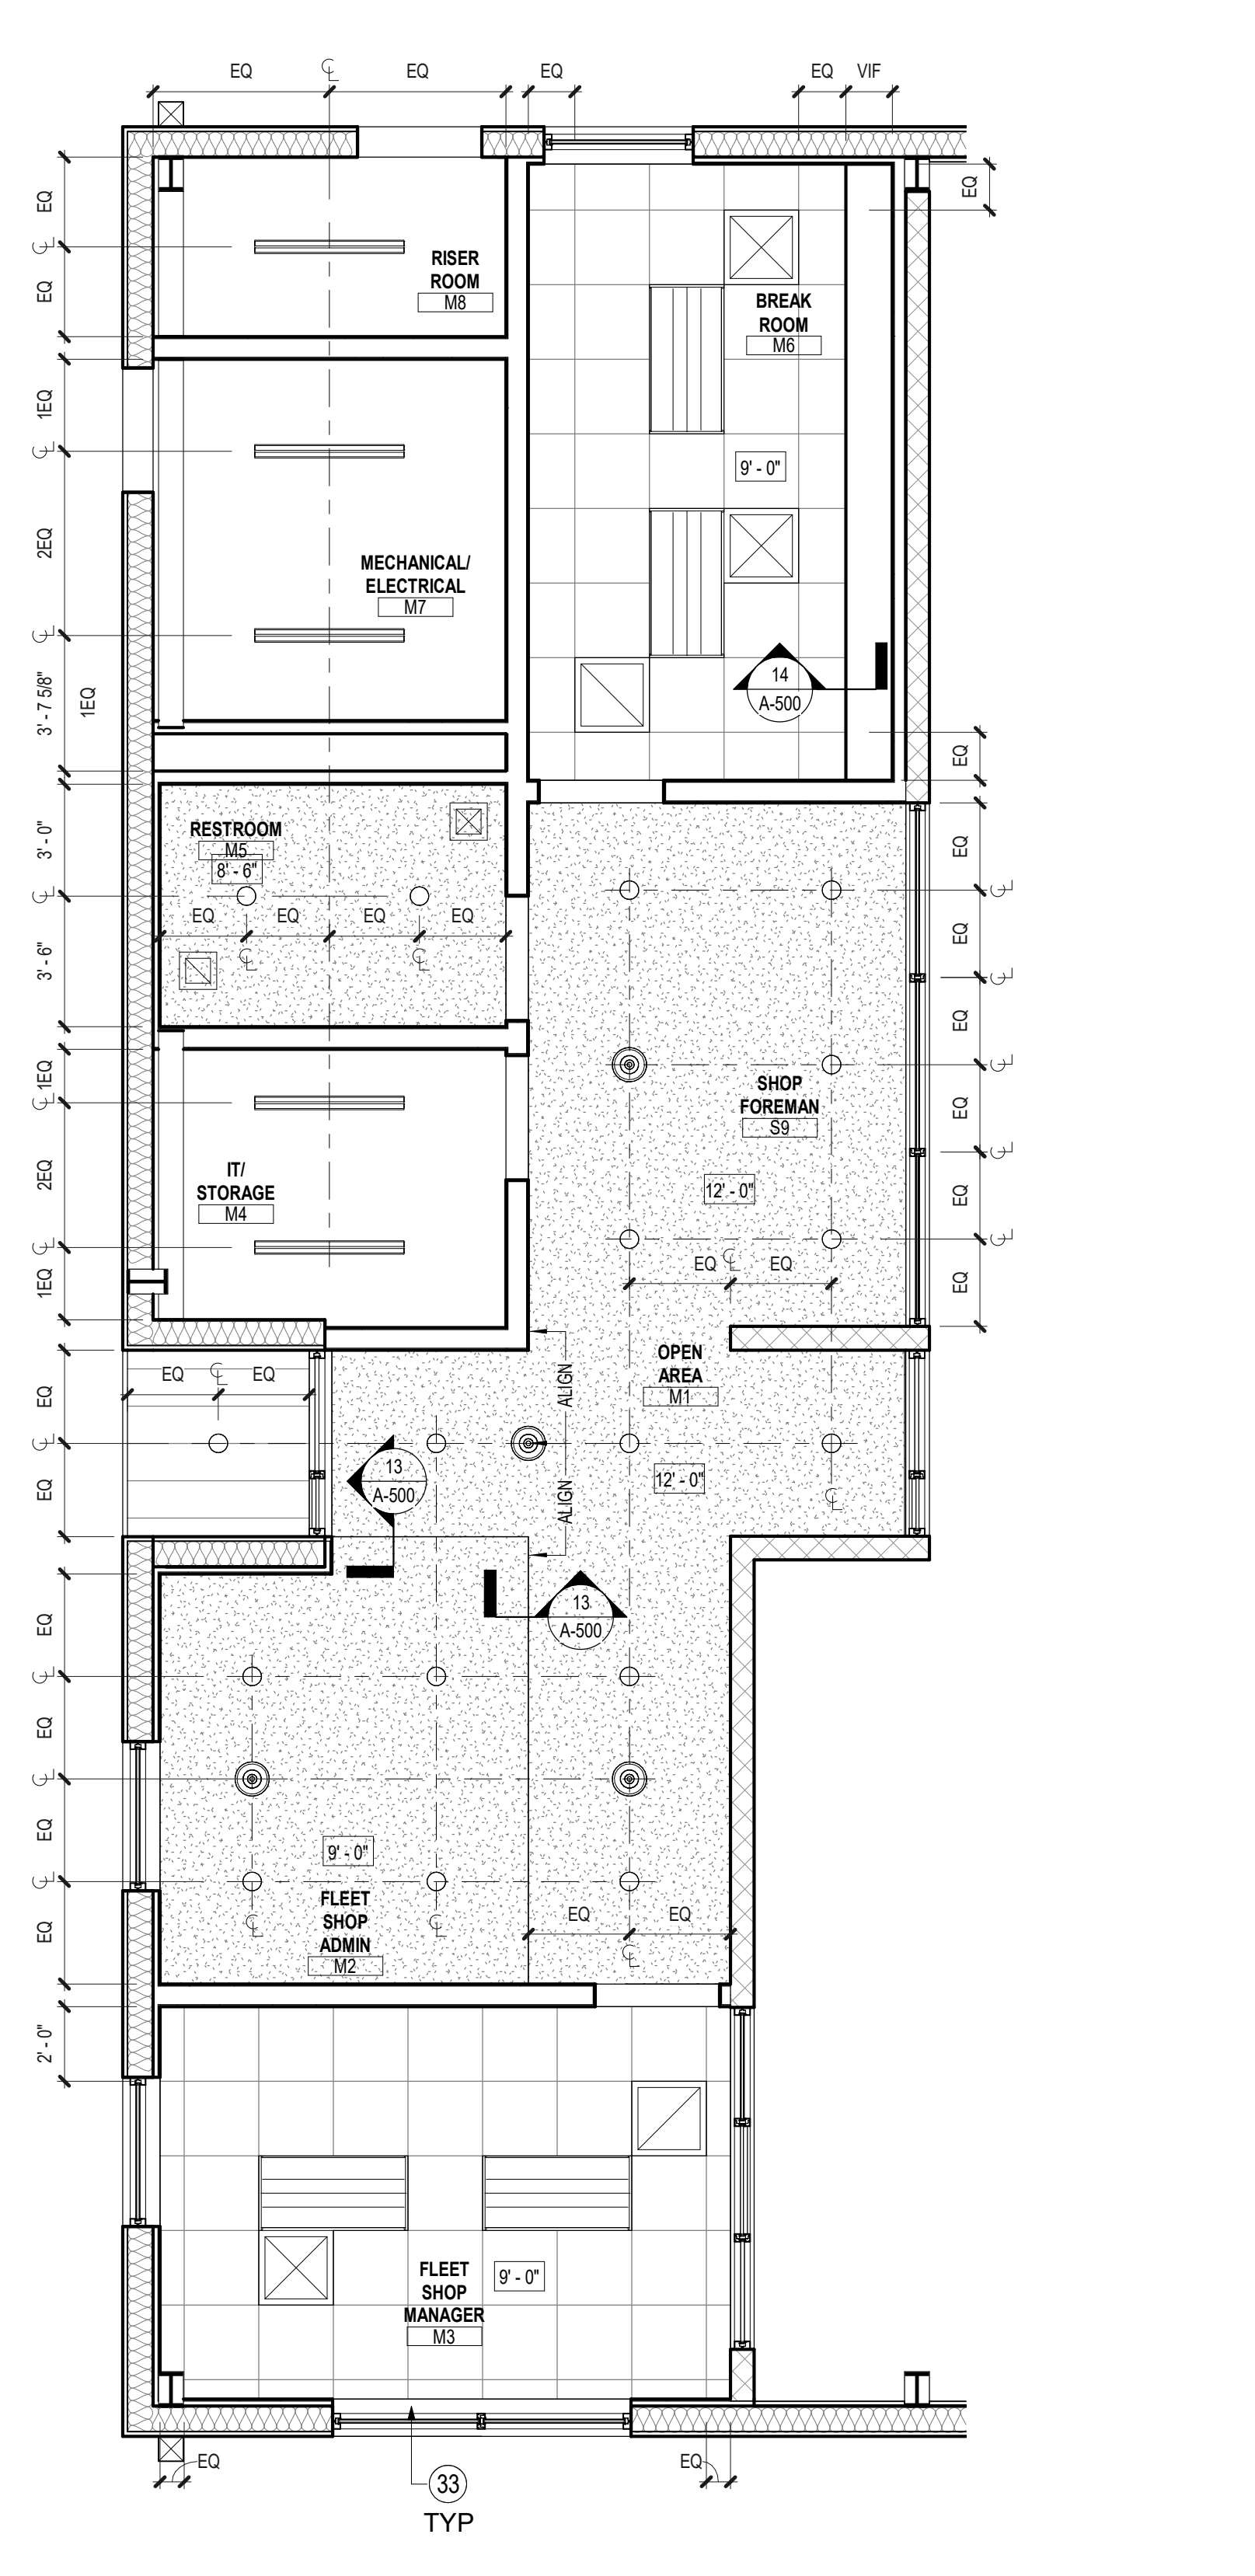

3 REFLECTED CEILING PLAN
 SCALE: 1/4" = 1'-0"

PLOT FILE: C:\Users\vgandhi\Documents\418198-A-R19-CENTRAL-SHOP_vgandhi\3\3P_rvt
 USER NAME: vgandhi
 DATE/TIME: 10/7/2020 6:34:16 PM

REVISION HISTORY

REVISION	DESCRIPTION	DATE
3	Addendum No. 03	07 OCT 2020

PROFESSIONAL SEAL

Firm Registration No. 15868
 Page Southerland Page, Inc.

ARCHITECTURAL - ENLARGED PLANS

DRAWN BY WJC	CHECKED BY ST
PROJECT NUMBER 418198	PROJECT ABBREVIATION GCRB
ORIGINAL ISSUE	DATE 26 JUNE 2020
ISSUE FOR PERMIT	

A-110M
 SHEET NUMBER

KEYED NOTES

NUMBER	DESCRIPTION
1	PEMB STRUCTURE
2	PEMB GUTTER ASSEMBLY
3	PEMB DOWNSPOUT ASSEMBLY WITH DAYLIGHT
4	PEMB STRUT
5	PEMB SHEAR BRACE
6	INSULATED PEMB WALL ASSEMBLY WITH METAL PANEL FINISH
7	SURFACE-MOUNTED LIGHTING FIXTURE. RE: ELECTRICAL
8	WIND-DRIVEN RAIN-RESISTANT LOUVER ASSEMBLY. 50% MIN. FREE AREA. MIAMI-DADE APPROVED. B.O.D. IS RUSKIN ELF6375DXD. RE: MECHANICAL
PEMB TRIM	
9	SLAB-ON-GRADE. RE: STRUCTURAL
10	OH COILING DOOR. RE: DOOR SCHEDULE
11	8" DIAMETER 42" HIGH PAINTED GALVANIZED STEEL CRASH BOLLARD WITH CONCRETE FILL AND DOME TOP MECHANICAL ASSEMBLY. RE: MECHANICAL
12	INSULATED PEMB ROOFING ASSEMBLY
13	6" CAST-IN-PLACE CONCRETE PAD. FRAMED AT PERIMETER WITH STEEL ISLAND FORMS BY RED-E-FORM
14	GALVANIZED PAINTED HSS TUBE
15	OVERHEAD FAN. RE: MECHANICAL
16	CRANE RAIL BEAM
17	CRANE RAIL BEAM SUPPORT. ANCHORED TO PEMB STRUCTURE ABOVE
18	CHAIN-HUNG RADIANT HEATER. RE: MECHANICAL
19	COMPRESSED AIR LINE
20	INSULATED GLAZED EXTERIOR STOREFRONT
21	TAS-COMPLIANT STAINLESS STEEL SINK ASSEMBLY
22	10" DIAMETER STAINLESS STEEL GROMMET
23	SOLID SURFACE COUNTERTOP
24	STAINLESS STEEL HAND WASHING SINK. RE: PLUMBING
25	STAINLESS STEEL EYE WASHING STATION. RE: PLUMBING
26	MOP SINK. RE: PLUMBING
27	INSULATED LIGHT/WALL ASSEMBLY
28	PEMB METAL PANEL INTERIOR WALL WAISNCOT TO 8" QUICK-CONNECT COMPRESSED AIR TERMINUS. RE: PLUMBING
29	PROVIDE MANUAL ROLLER SHADE AT WINDOW HEAD
30	PROVIDE TUBE STEEL FRAMING TO SUPPORT FLOATING COUNTERTOP ASSEMBLY. PROVIDE SUPPORTS AT WALLS AT EITHER END
31	PEMB TRIM
32	CORD CHASE AND WHIP
33	2" CORD GROMMET WITH PASS-THRU COVER
34	UNINSULATED PEMB ROOFING ASSEMBLY
35	COMPRESSED FLUID LINES. RE: PLUMBING
36	DAYLIT GUTTER DISCHARGE
37	UTILITY TRENCH
38	HOSE REEL STAND. RE: PLUMBING AND ELECTRICAL
39	VAPOR BARRIER
40	GALVANIZED MICHNICHOLS TRAFFIC-RATED BAR-STOCK PANEL. 3" LENGTHS
41	GALVANIZED EMBED ANGLE
42	GALVANIZED SUPPORT ANGLE
43	LINE OF PEMB STRUCTURE ADJACENT
44	PROVIDE MEDIUM BROOM FINISH AT EXTERIOR CONCRETE PATIO
45	POWER & DATA J-BOX HOSTED UNDER HOSE REEL COLUMN. RE: ELECTRICAL & TELECOM
46	DUPLEX DATA TERMINAL IN STEEL HOUSING MOUNTED TO HOSE-REEL STAND. RE: TELECOM
47	PREFINISHED SHEETMETAL FLASHING
48	PEMB WEATHER BARRIER
49	PEEL-N-STICK MASTIC
50	PEMB WALL PANEL
51	RETICULATED DOUBLE SEALANT JOINT WITH BACKER-ROD AND WEEP DRAFFLES
52	INTERIOR WALL FINISH. RE: FINISH PLAN
53	CMU WALL. RE: STRUCTURAL
54	1" THICK COMPRESSIBLE FILLER
55	3/4" FIRE-TREATED PLYWOOD
56	TREATED BLOCKING



GENERAL NOTES

- RE: G-110 FOR DOOR, HARDWARE, EQUIPMENT AND FINISH SCHEDULES.
- RE: G-110 FOR CODE AND LIFE-SAFETY ANALYSIS.
- RE: A-101S FOR SITE PLAN.
- RE: MECHANICAL, ELECTRICAL AND PLUMBING DRAWINGS FOR ADDITIONAL DATA.
- EQUIV. MOBILE COLUMN (IF) NOT SHOWN IN DRAWINGS.
- WALLS TO RECEIVE PT-1 FINISH WITH B-1 BASE U.N.O.
- PROVIDE SCHLUTER STRIP IN ANNOZED ALUMINUM AT ALL TILE OUTSIDE CORNERS AND ALL OPEN TILE WALL EDGES.
- ALL EXPOSED PEMB RISERS AND EXPOSED STRUCTURAL STEEL TO RECEIVE PT-3 FINISH.
- M3 WALLS TO RECEIVE PT-3 FINISH U.N.O.
- MAINTENANCE SHOP FLOOR TO RECEIVE SC-3 FINISH.


LEGEND

	COLUMN GRID DESIGNATIONS
	KEYED NOTE KEYED NOTES ONLY APPLY TO THIS SHEET
	SECTION TAG
	ELEVATION TAG
	ROOM NAME ROOM NUMBER
	DOOR TAG
	FLOOR OR CEILING FINISH TAG
	MATERIAL FINISH TAG
	WALL FINISH TAG
	FLOOR FINISH TRANSITION


KEY PLAN (NOT TO SCALE)

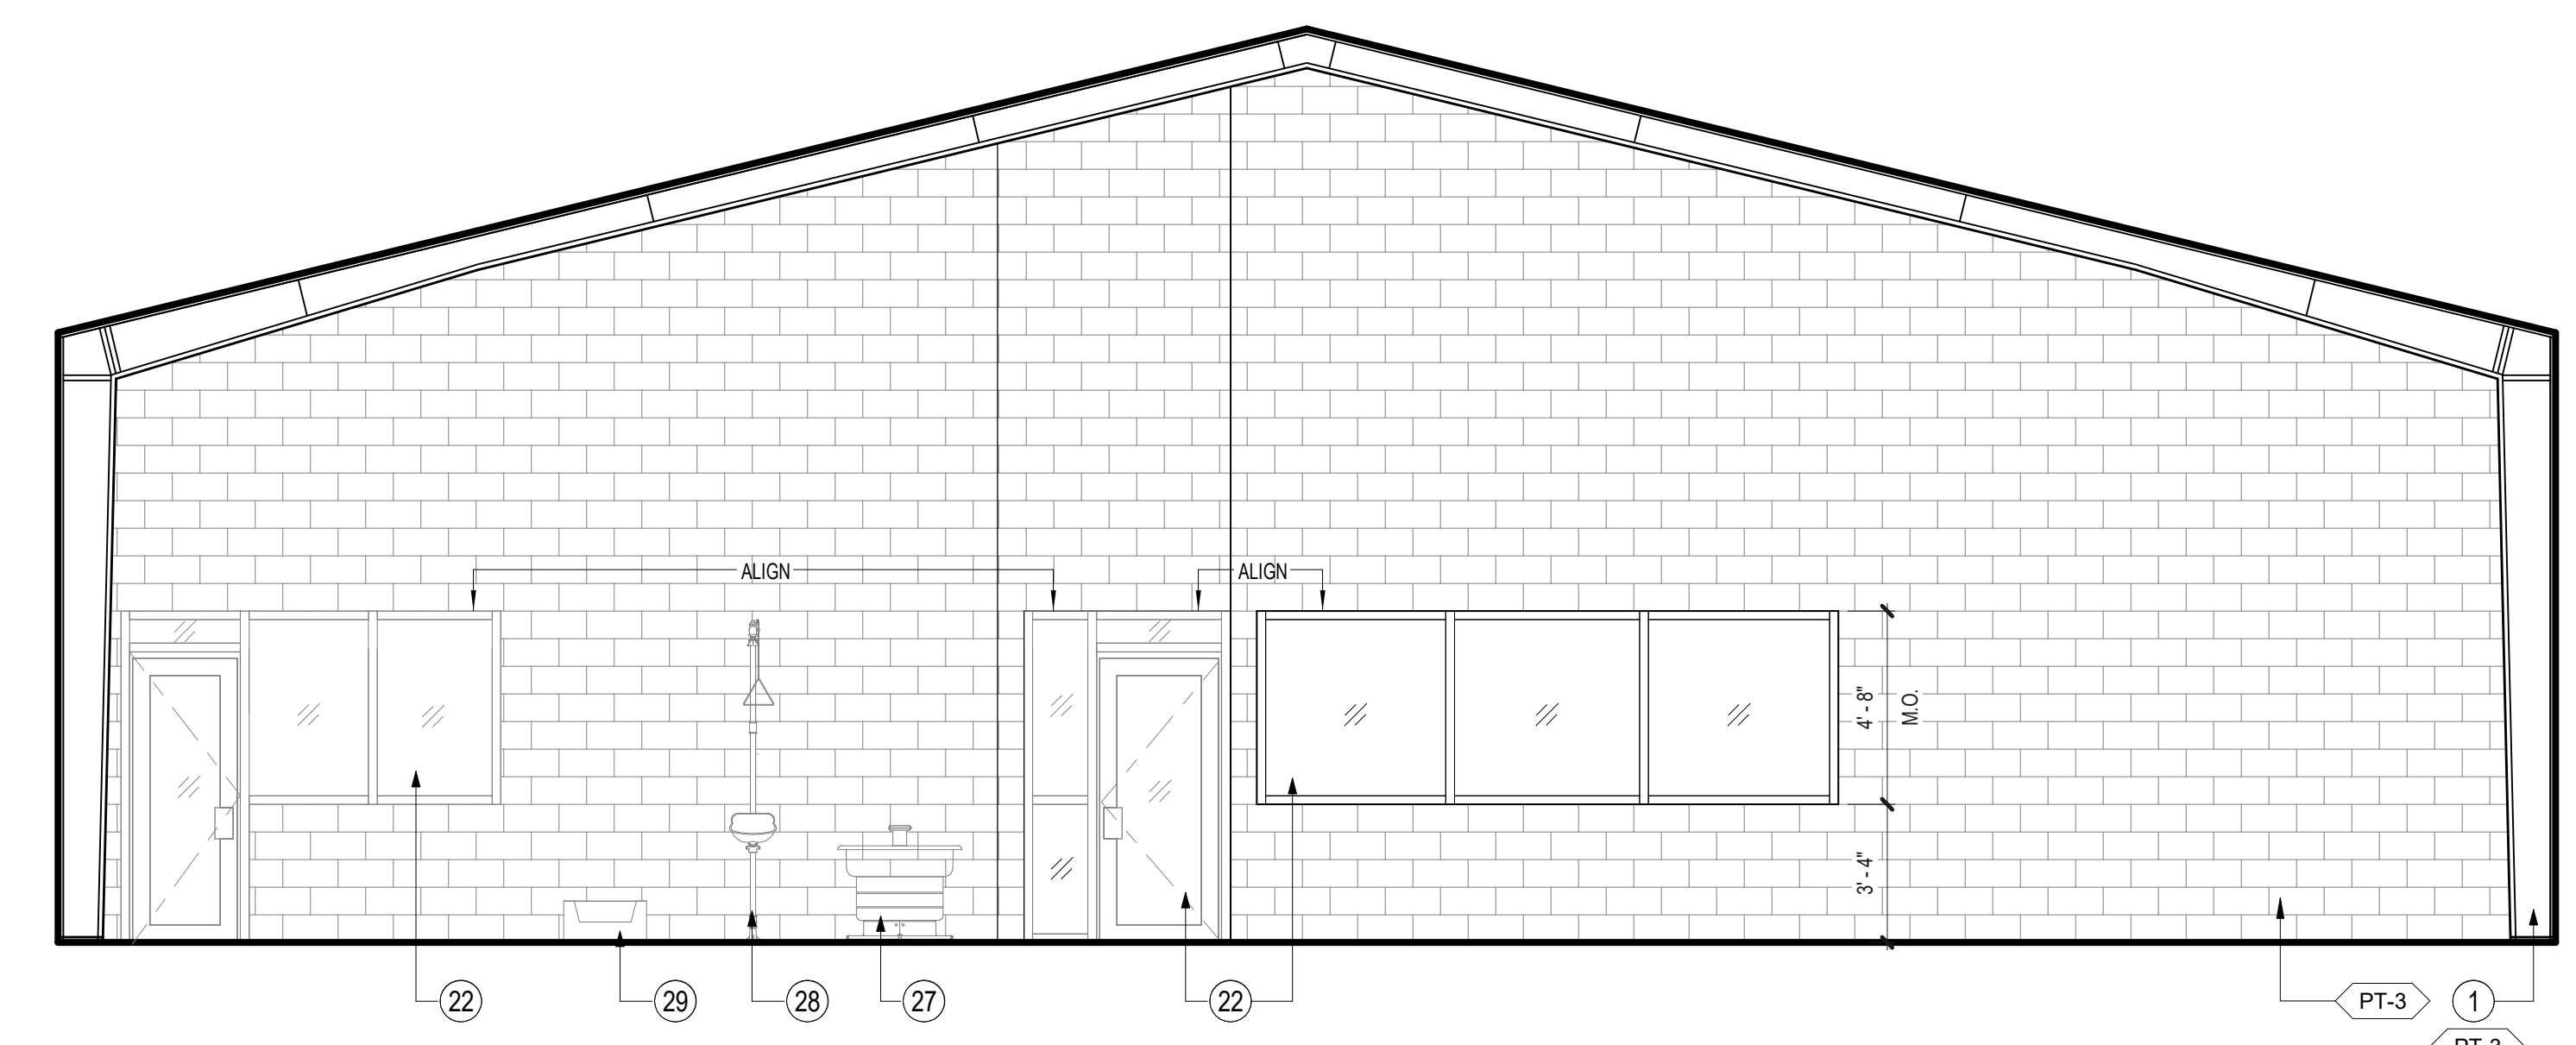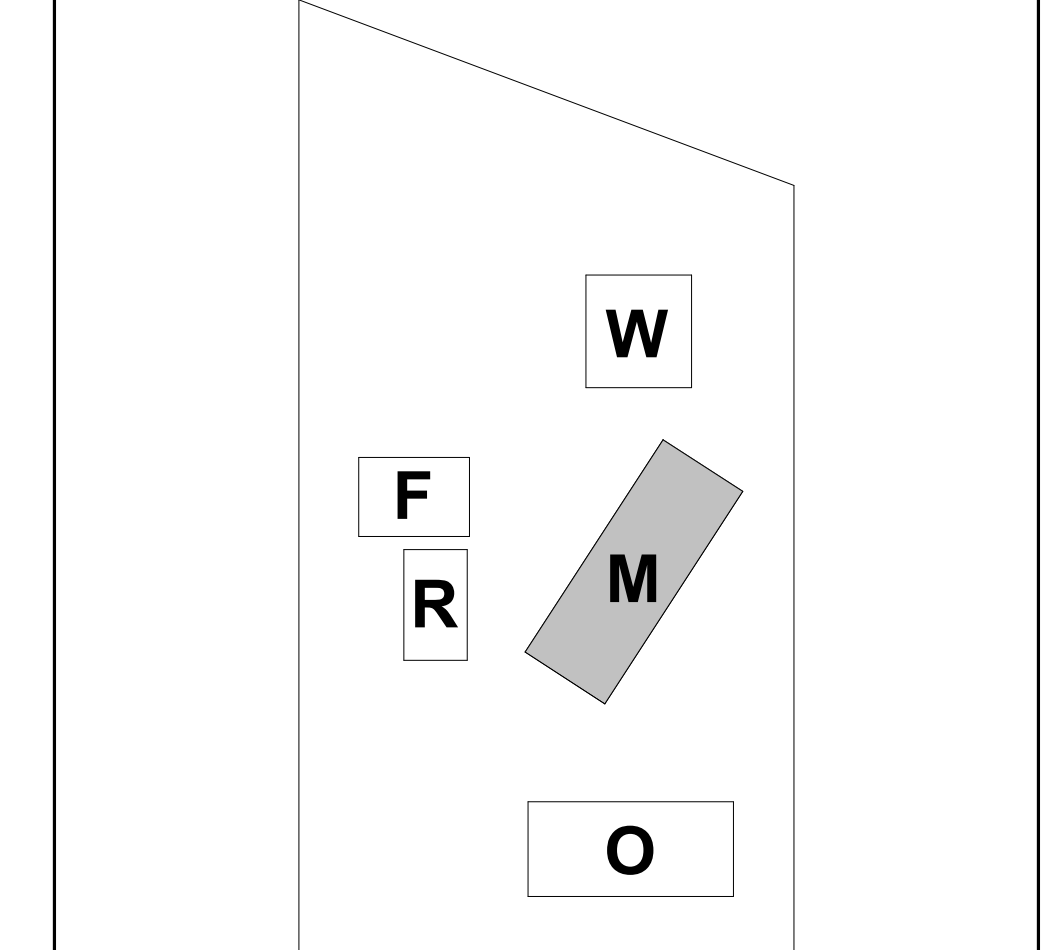


1 ELEVATION
SCALE: 1/4" = 1'-0"

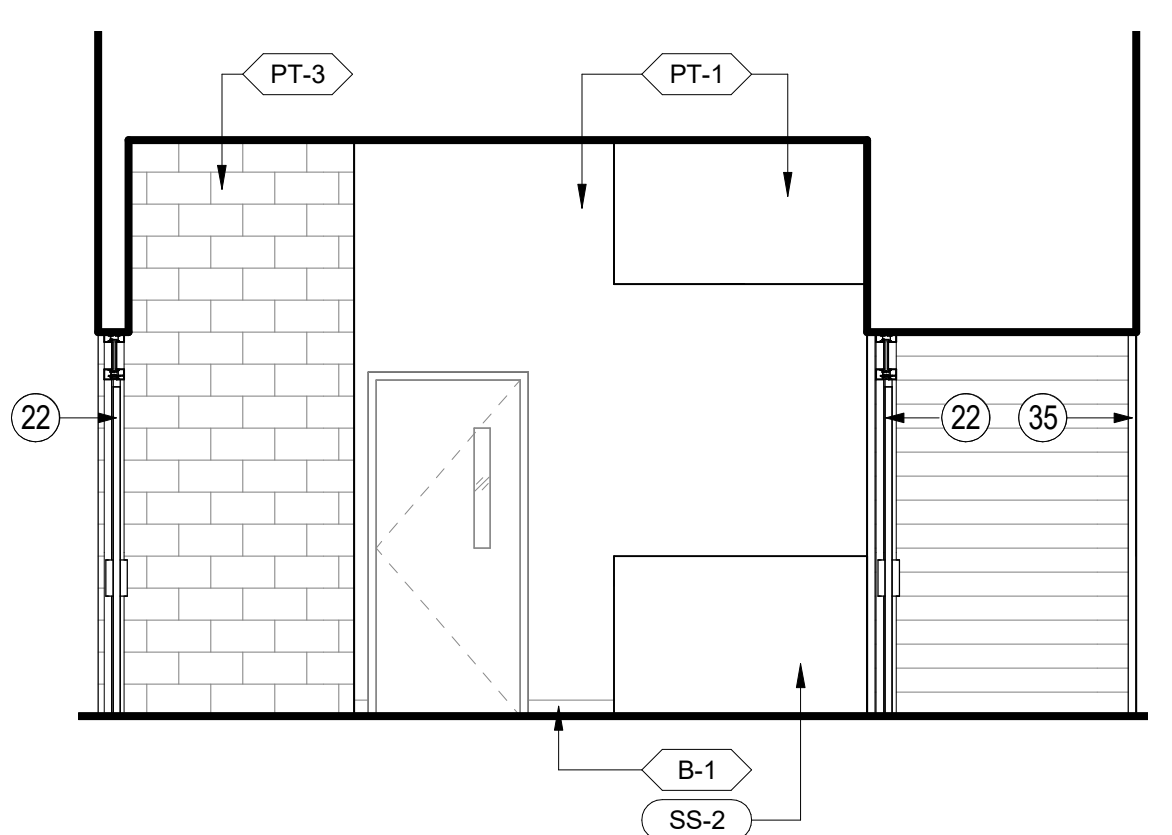


4 ELEVATION
SCALE: 1/4" = 1'-0"

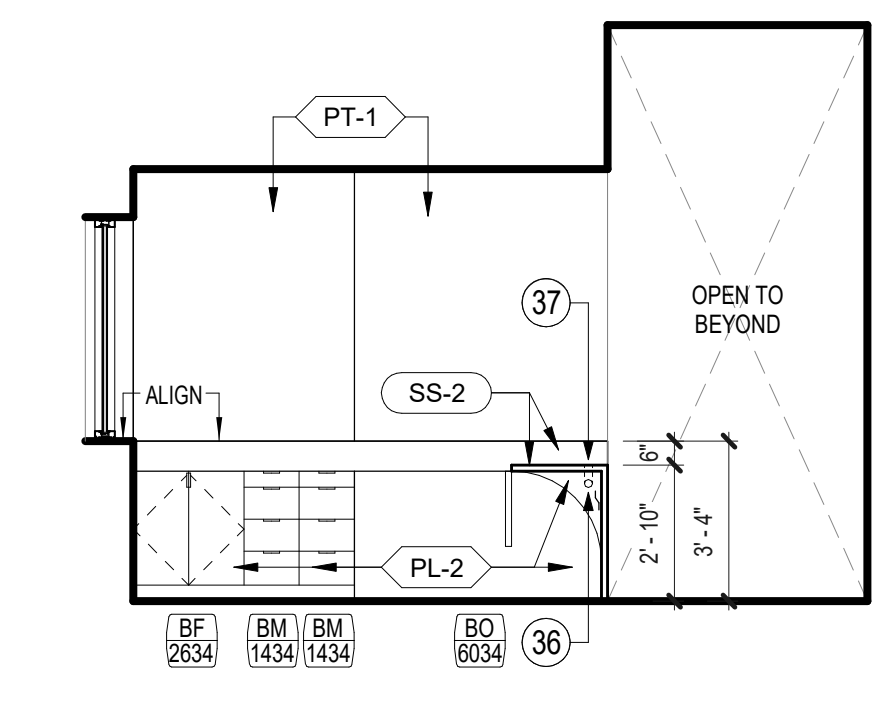


7 ELEVATION
SCALE: 1/4" = 1'-0"

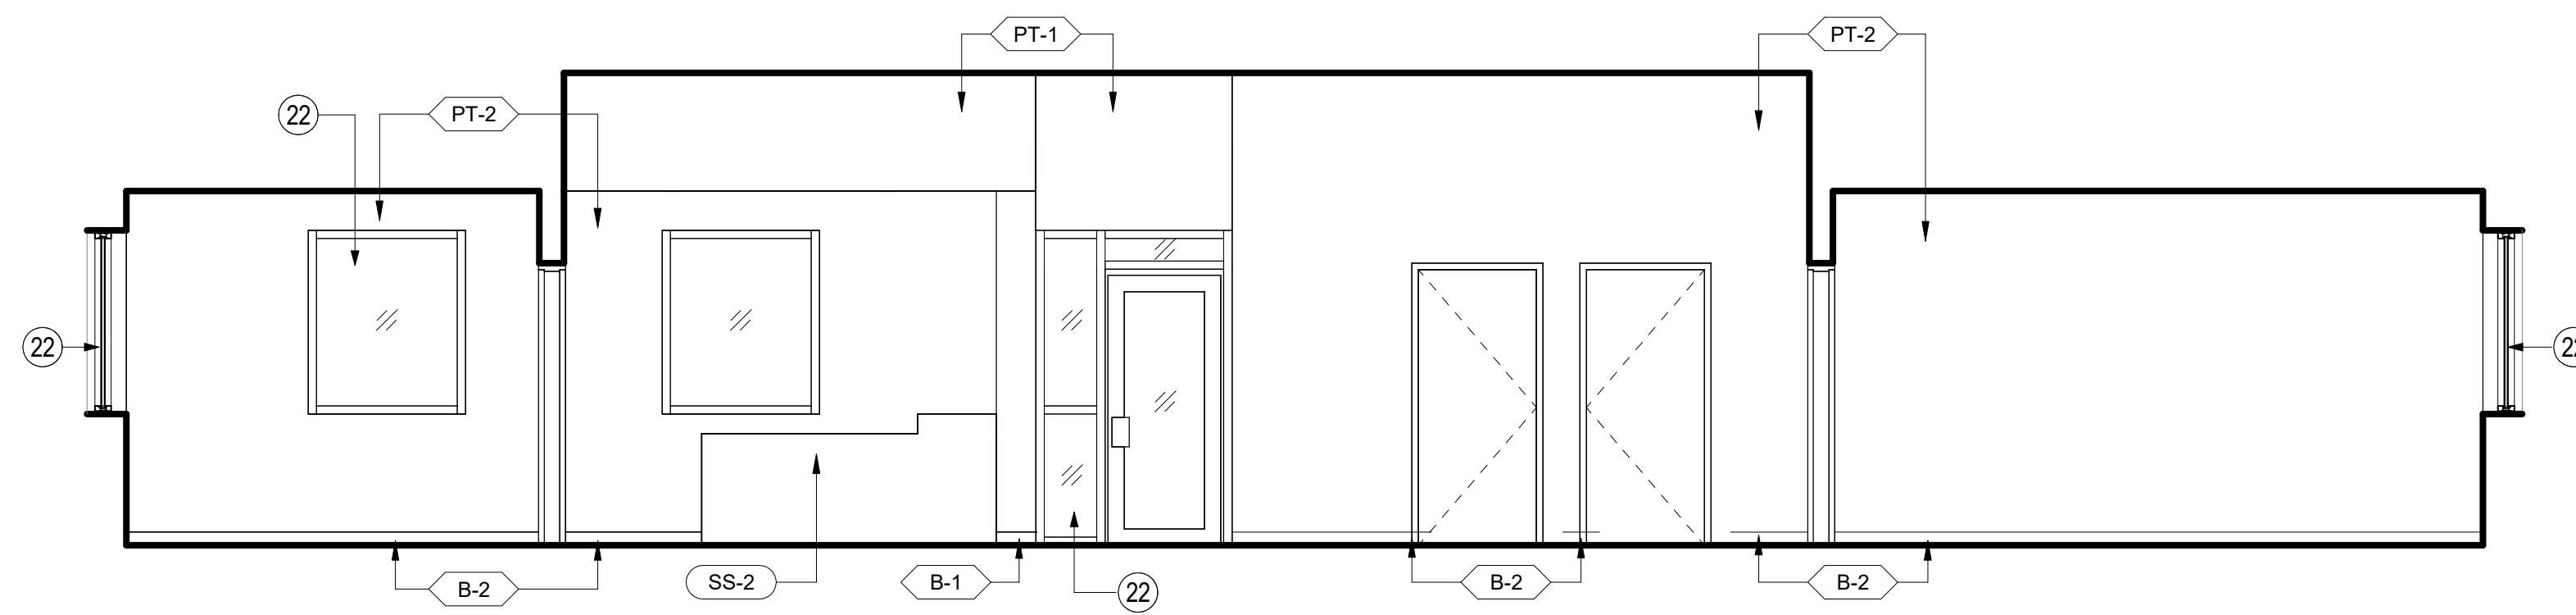


2 ELEVATION
SCALE: 1/4" = 1'-0"

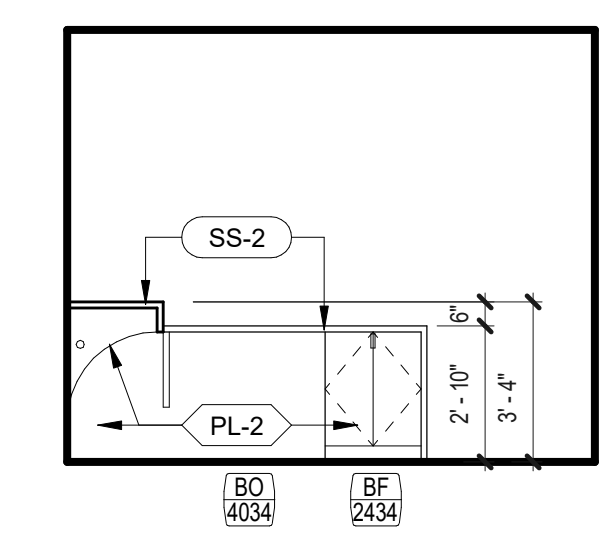


5 ELEVATION
SCALE: 1/4" = 1'-0"

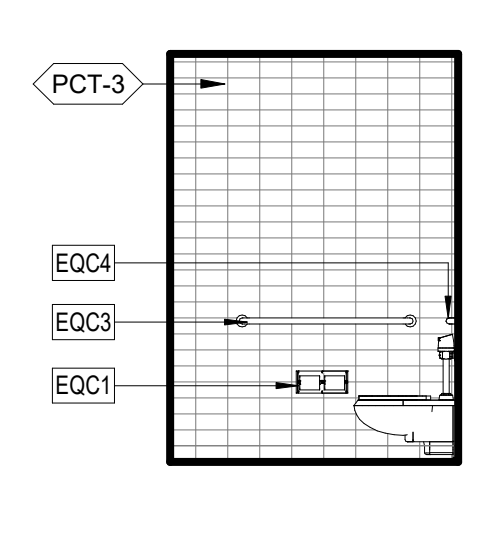

6 ELEVATION
SCALE: 1/4" = 1'-0"

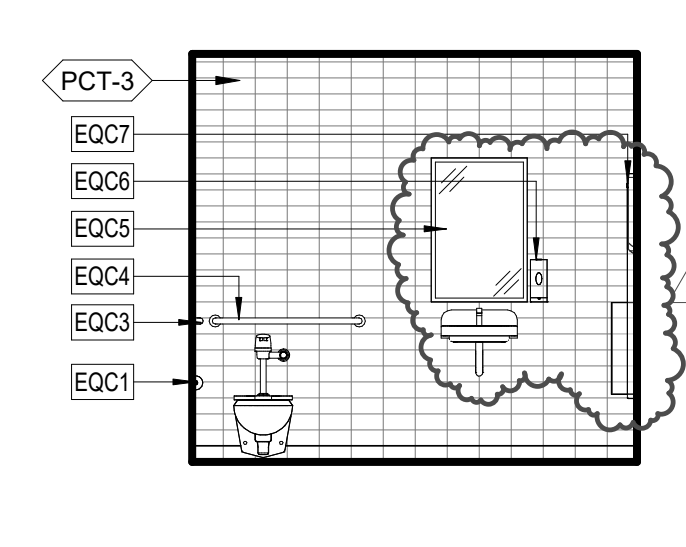

8 ELEVATION
SCALE: 1/4" = 1'-0"

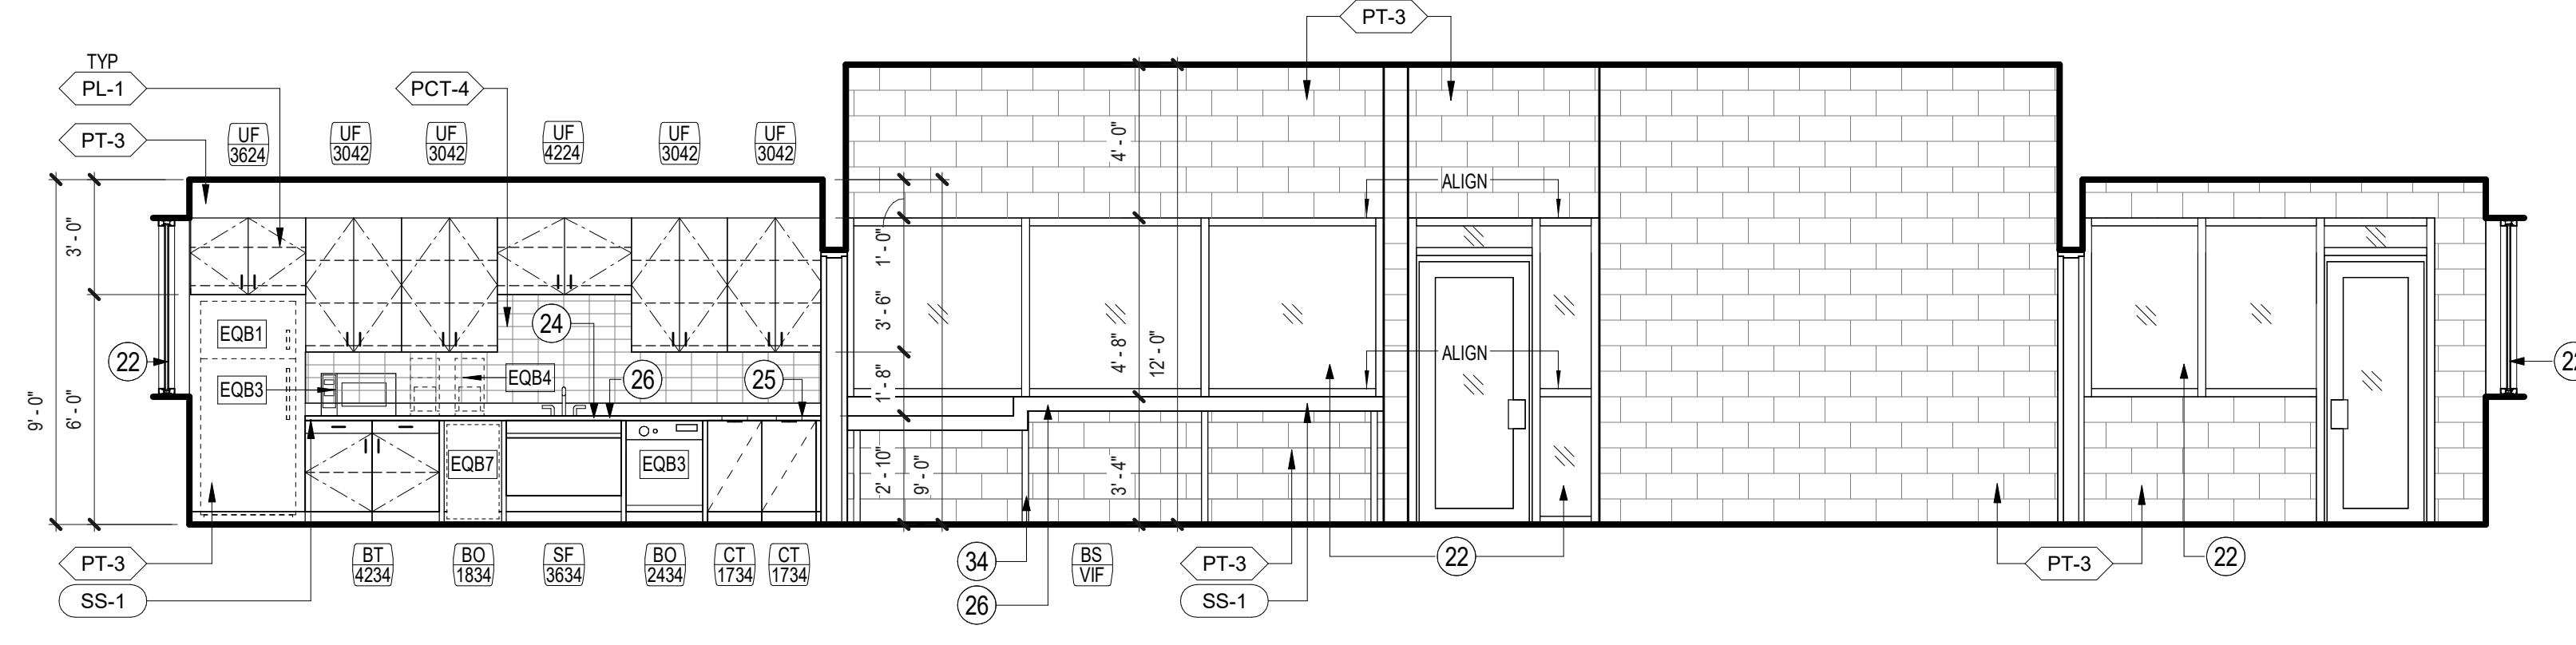

3 ELEVATION
SCALE: 1/4" = 1'-0"

REVISION HISTORY

REVISION	DESCRIPTION	DATE
3	Addendum No. 03	07 OCT 2020

PROFESSIONAL SEAL

Firm Registration No. 15868
Page Southerland Page, Inc.

10/07/2020


ARCHITECTURAL - INTERIOR ELEVATIONS

DRAWN BY: WJC
PROJECT NUMBER: 418198
ORIGINAL ISSUE FOR PERMIT


CHECKED BY: ST
PROJECT ABBREVIATION: GCRB
DATE: 26 JUNE 2020

A-111M
SHEET NUMBER


Galveston County
Road & Bridge Department Facilities
5115 TX-3
Dickinson, Texas 77539

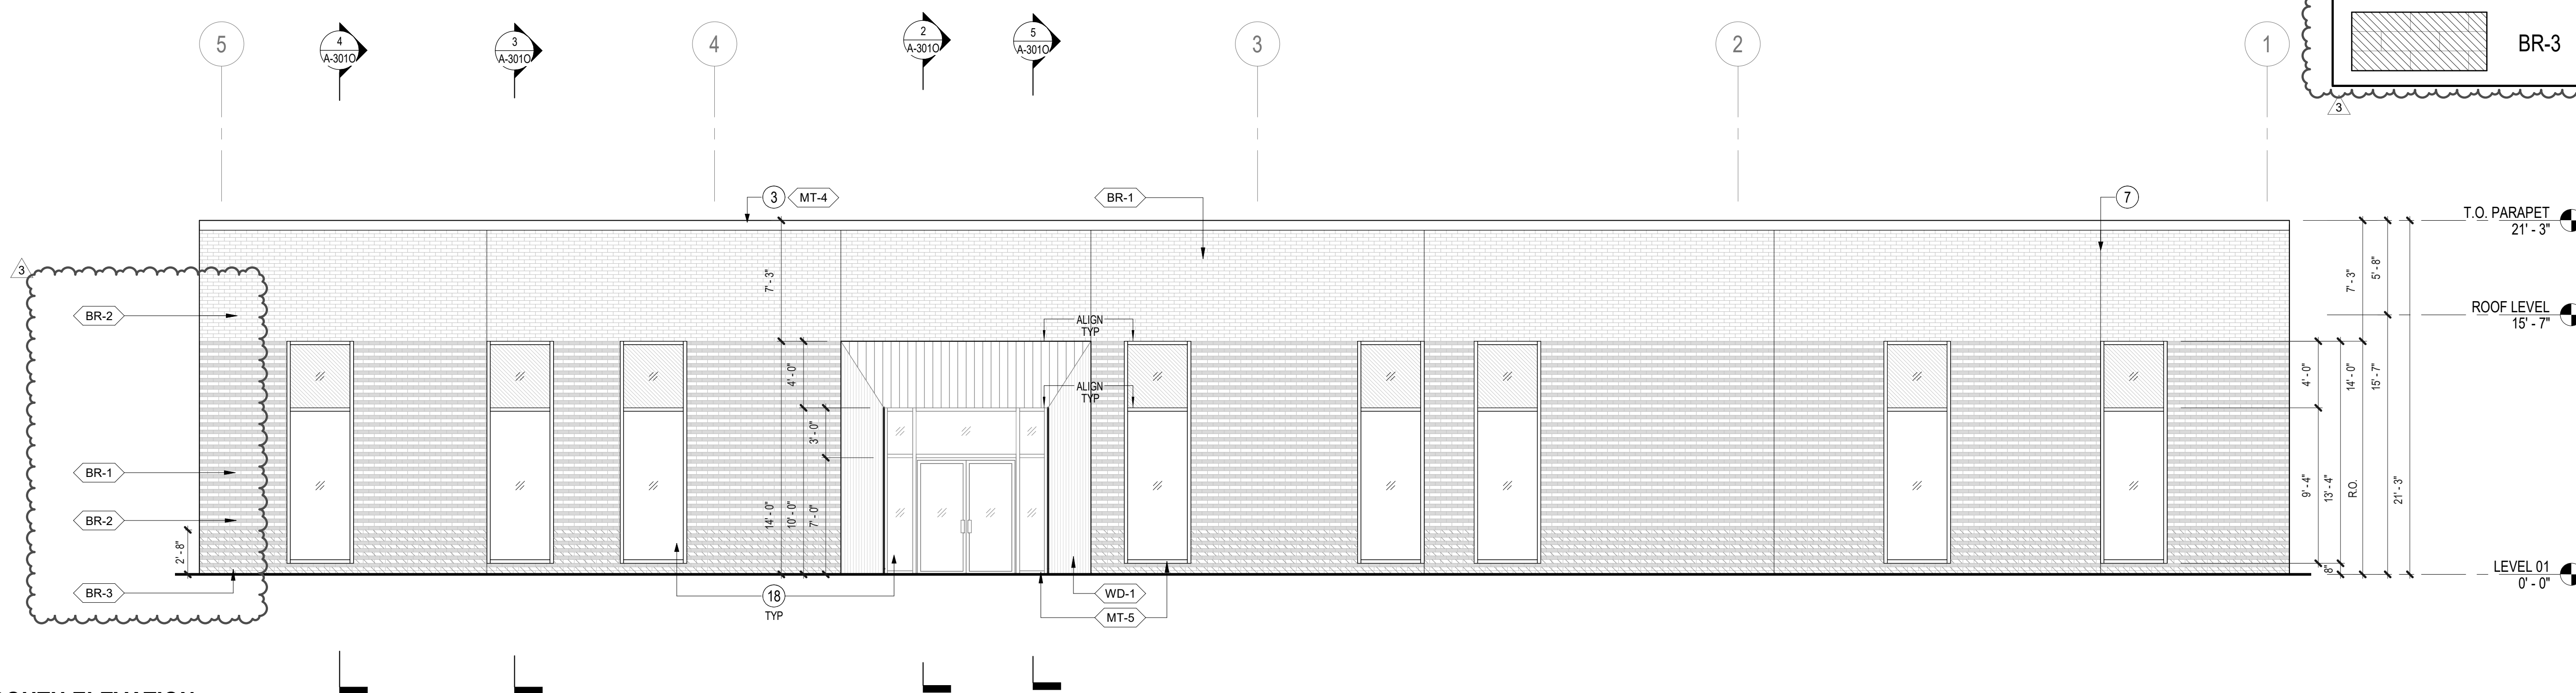

1 SOUTH ELEVATION
SCALE: 3/16" = 1'-0"

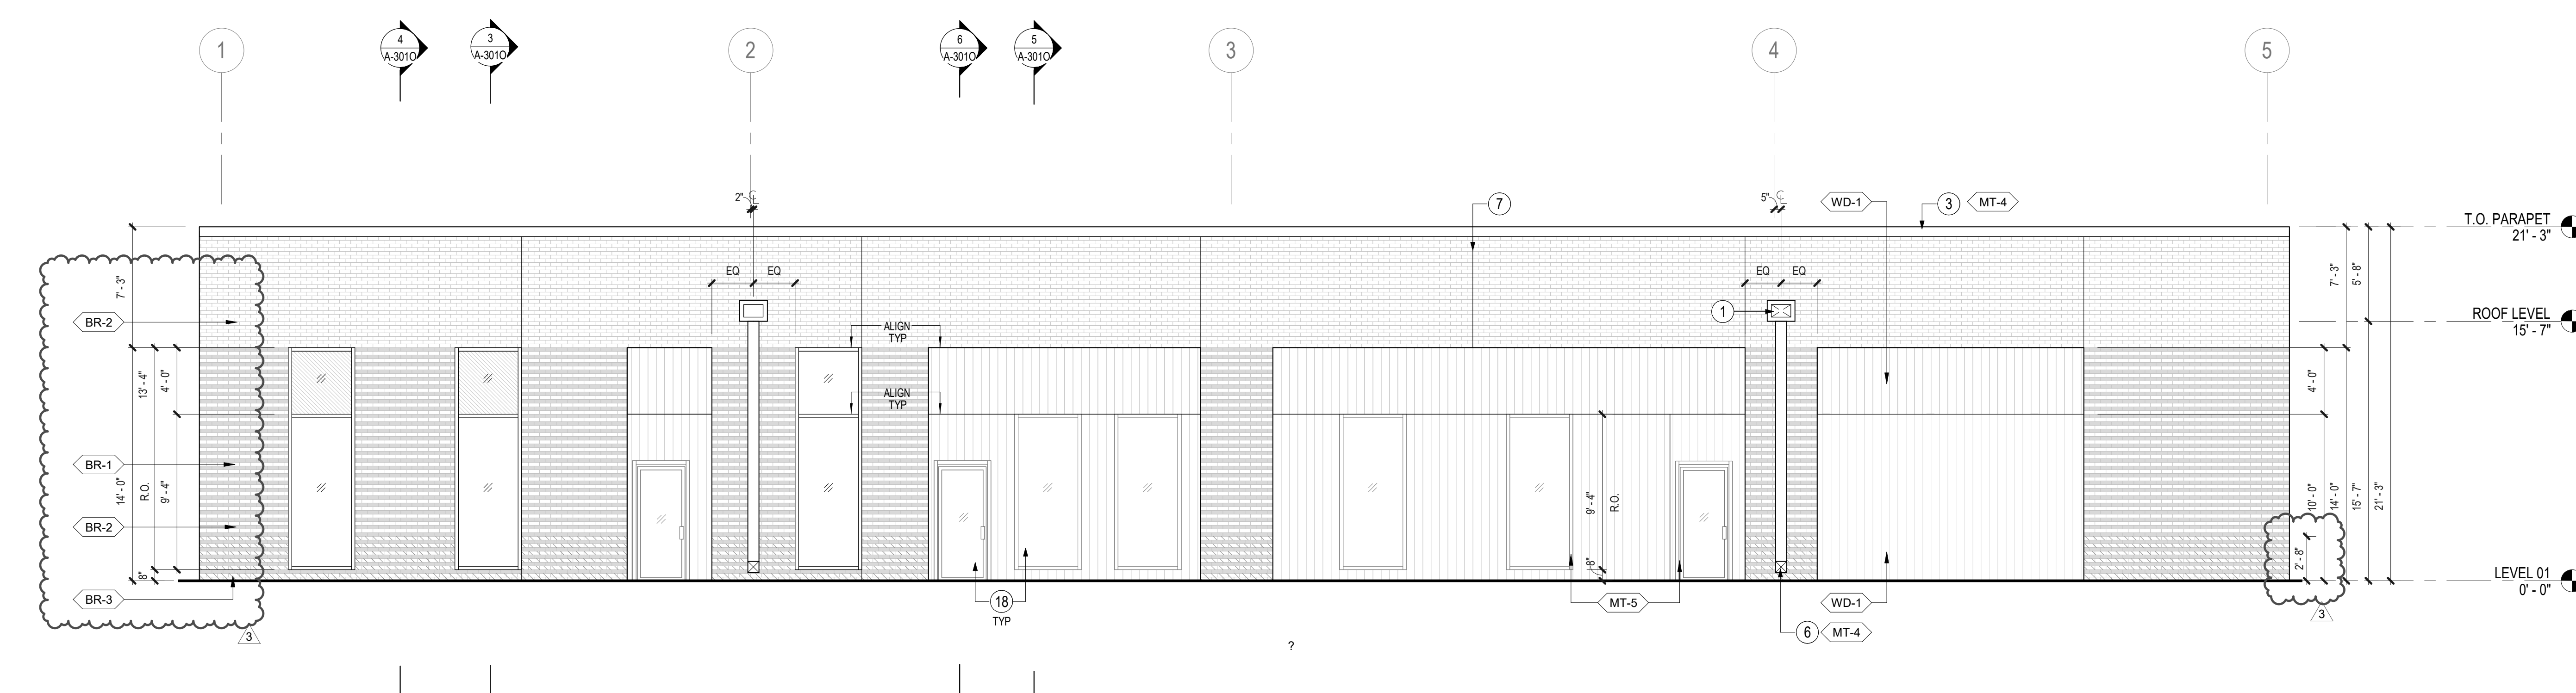

2 NORTH ELEVATION
SCALE: 3/16" = 1'-0"

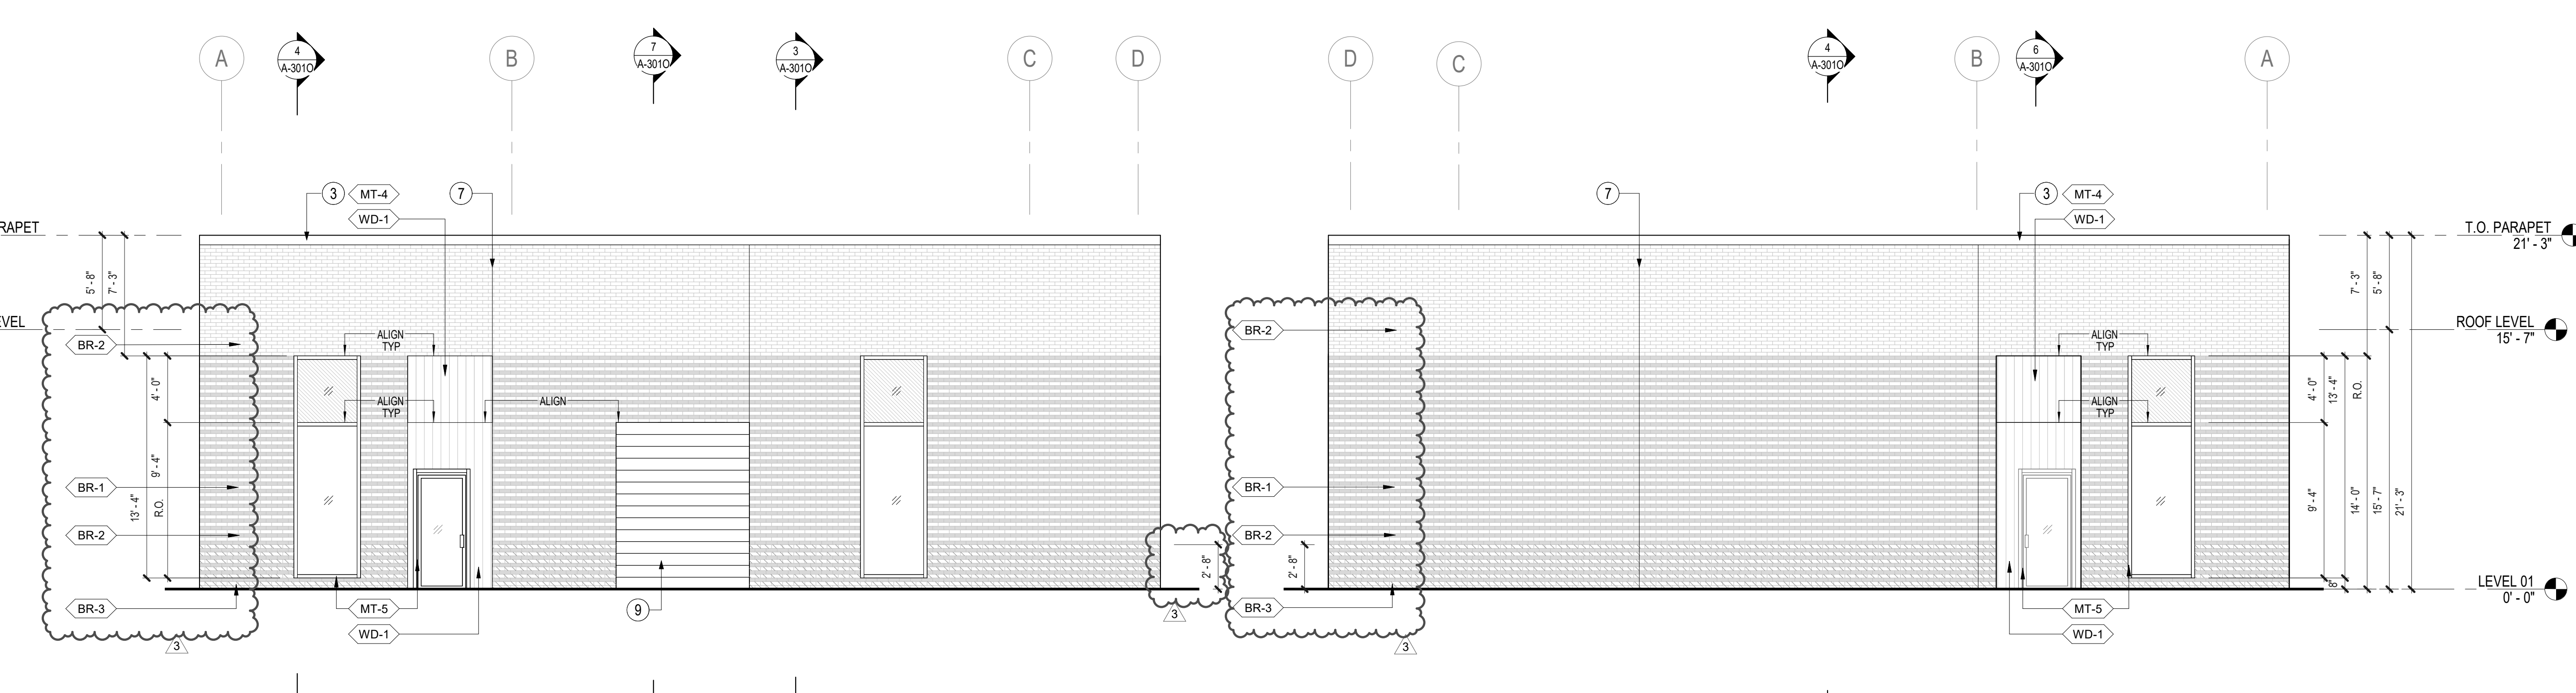

4 EAST ELEVATION
SCALE: 3/16" = 1'-0"

3 WEST ELEVATION
SCALE: 3/16" = 1'-0"

MASONRY LEGEND

	BR-1
	BR-2
	BR-3

KEYED NOTES

NUMBER	DESCRIPTION
1	CATCHMENT BOX WITH SPILLOVER AND DOWNSPOUT
2	THRU-WALL SCUPPER OPENING
3	PREFINISHED SHEETMETAL COPING
4	ROOF CRICKETING
5	INSULATED ROOF HATCH
6	PREFINISHED SHEETMETAL DOWNSPOUT
7	VERTICAL BRICK CONTROL JOINTS, TYPICAL
8	MANUAL ROLLER WINDOW SHADES AT ALL EXTERIOR WINDOWS, U.I.A.C.
9	INSULATED OVERHEAD COILING DOOR ASSEMBLY, RE: DOOR SCHEDULE
10	PROVIDE SCHLUTTER STRIP
11	WALL-MOUNTED LIGHTING FIXTURE, RE: ELECTRICAL
12	FLOOR-MOUNTED CEILING-BRACED TOILET PARTITION
13	WALL-HUNG URINAL PARTITION
14	SOLID PHENOLIC Z-LOCKERS, 12"Wx18"Dx72"H
15	TAS-COMPLIANT LOCKER BENCH, 12"Wx18"Dx42"W
16	STEEL ACCESS HATCH, FIELD PAINT TO MATCH FT-3. COORDINATE FINAL HEIGHT AND SIZE WITH PLUMBING ROUGH-IN BEHIND
17	OSHA-COMPLIANT STEEL SAFETY LADDER LEADING TO ROOF HATCH ABOVE, SUPPORTED BY STEEL TUBES IN WALL, RE: STRUCTURAL
18	INSULATED GLAZED EXTERIOR STOREFRONT
19	TAS-COMPLIANT STAINLESS STEEL SINK ASSEMBLY
20	10" DIAMETER STAINLESS STEEL GROMMET
21	SOLID SURFACE COUNTERTOP
22	VENT HOOD, RE: MECHANICAL
23	INSULATED MODIFIED BITUMEN ROOFING ASSEMBLY
24	ANCHORED BRICK VENEER MASONRY ASSEMBLY
25	INSULATED SPANDREL GLAZING PANEL
26	VISION GLAZING PANEL
27	VAPOR BARRIER
28	SLAB-ON-GRADE, RE: STRUCTURAL
29	ADJACENT PAVING, RE: CIVIL
30	CHICKEN-WIRE FENCING PROTECTING INSULATION WHERE NO GYP IS PRESENT, TYPICAL
31	STEEL STRUCTURE, RE: STRUCTURAL
32	FLUID APPLIED WEATHER BARRIER
33	CONTINUOUS BOARD INSULATION
34	SHEATHING
35	COLD-FORMED METAL FRAMING WALL WITH BATT INSULATION
36	PREFINISHED SHEETMETAL FLASHING
37	INTERIOR CEILING, RE: RCP
38	COLD-FORMED FRAMING
39	NATURALLY VENTILATED EXTERIOR SOFFIT, ALL STEEL WITHIN SOFFIT TO BE HOT-DIP GALVANIZED, RE: STRUCTURAL
40	COMPOSITE WOOD EXTERIOR LAP PLANKING
41	PROVIDE MEDIUM BROOM FINISH AT EXTERIOR CONCRETE PATIOS
42	INTERIOR GYP FINISH
43	UNINSULATED INTERIOR STOREFRONT ASSEMBLY
44	OPERABLE PARTITION ASSEMBLY
45	PROVIDE SUPPORTING STEEL FOR OPERABLE PARTITION
46	MASONRY DRAIN MATERIAL
47	WEEP
48	NONSHRINK GROUT
49	COMPRESSIBLE FILLER
50	TRACK RUNNER SET IN CONTINUOUS BED OF SEALANT
51	FLEXIBLE FLASHING
52	TREATED 2BY BLOCKING
53	RETICULATED DOUBLE SEALANT JOINT WITH BACKER ROD AND WEEP BAFFLES
54	MODIFIED BITUMEN WALL AND PARAPET FLASHING
55	PARAPET WALL SHEATHING
56	CARBON FIBER Z-CLIPS
57	INSECT SCREEN
58	PLYWOOD SUBSTRATE
59	INTERIOR STUD FRAMING
60	PROVIDE ARCHITECTURALLY RECESSED KNOX BOX
61	MASONRY ANCHOR
62	COMPOSITE WOOD CORNER TRIM
63	END-DAM WITH INTEGRAL BASE FLASHING


GENERAL NOTES

- RE: G-110 FOR DOOR, HARDWARE, EQUIPMENT AND FINISH SCHEDULES.
- RE: G-100 FOR CODE AND LIFE-SAFETY ANALYSIS.
- RE: A-101S FOR SITE PLAN.

LEGEND

	COLUMN GRID DESIGNATIONS
	KEYED NOTE (KEYED NOTES ONLY APPLY TO THIS SHEET)
	SECTION TAG
	ELEVATION TAG
	ROOM NAME
	ROOM NUMBER
	DOOR TAG
	FLOOR OR CEILING FINISH TAG
	MATERIAL FINISH TAG
	WALL FINISH TAG
	FLOOR FINISH TRANSITION

KEY PLAN (NOT TO SCALE)

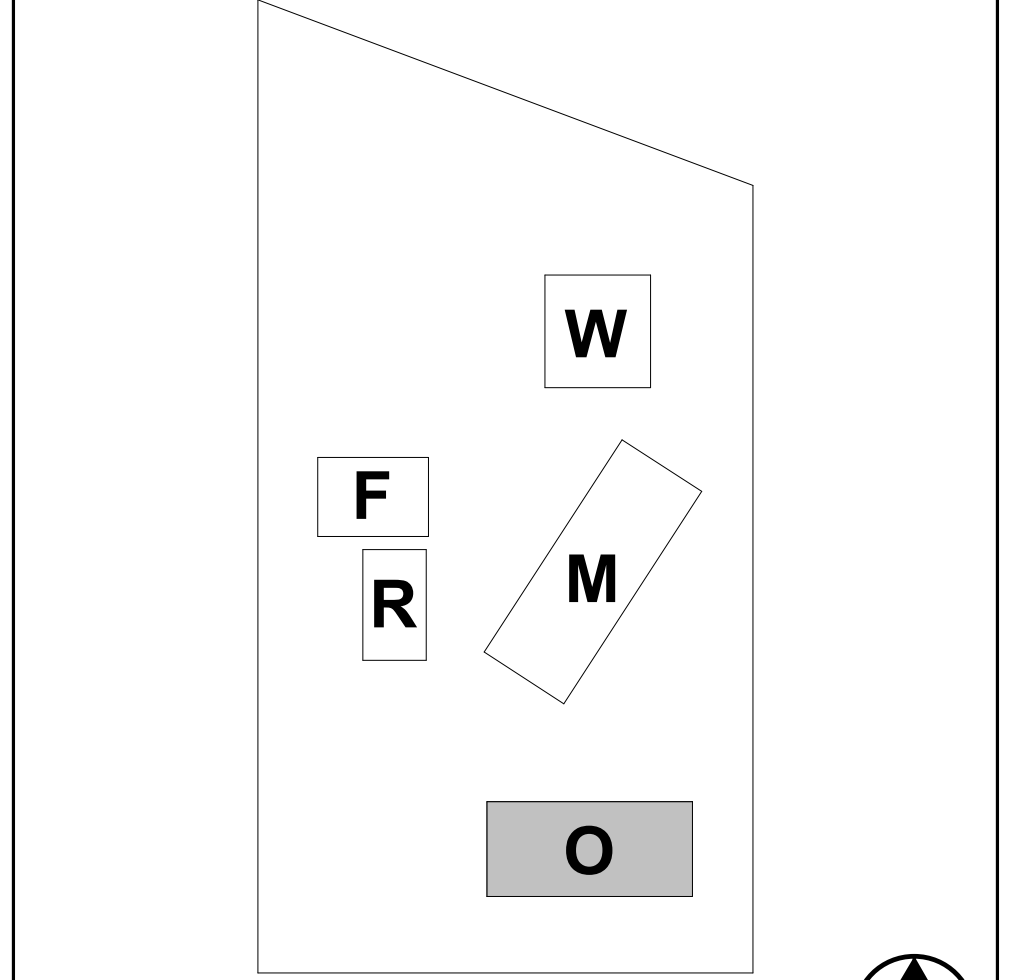

REVISION HISTORY

NO.	DESCRIPTION	DATE

3 Addendum No. 03 07 OCT 2020
REVISION DESCRIPTION DATE
PROFESSIONAL SEAL
Firm Registration No. 15868
Page Southerland Page, Inc.

10/01/2020

ARCHITECTURAL - EXTERIOR ELEVATIONS

DRAWN BY WJC	CHECKED BY ST
PROJECT NUMBER 418198	PROJECT ABBREVIATION GCR&B
ORIGINAL ISSUE ISSUE FOR PERMIT	DATE 26 JUNE 2020

PLOT FILE: C:\Users\vgandhi\Documents\418198-A-R19-CENTRAL-OFFICE_vgandhiV3VP.rvt
 USER NAME: vgandhi
 DATE/TIME: 10/7/2020 6:30:07 PM